


DOUGLAS COUNTY, OREGON
 PLANS FOR PROPOSED PROJECT
 GRADING & SURFACING

NEWTON CREEK, COUNTY ROAD NO.84
 MILE POINT 1.22 TO MILE POINT

FILED
 RECEIVED
 JUL 10 1973
 COUNTY SURVEYOR
 DOUGLAS COUNTY, ORE.

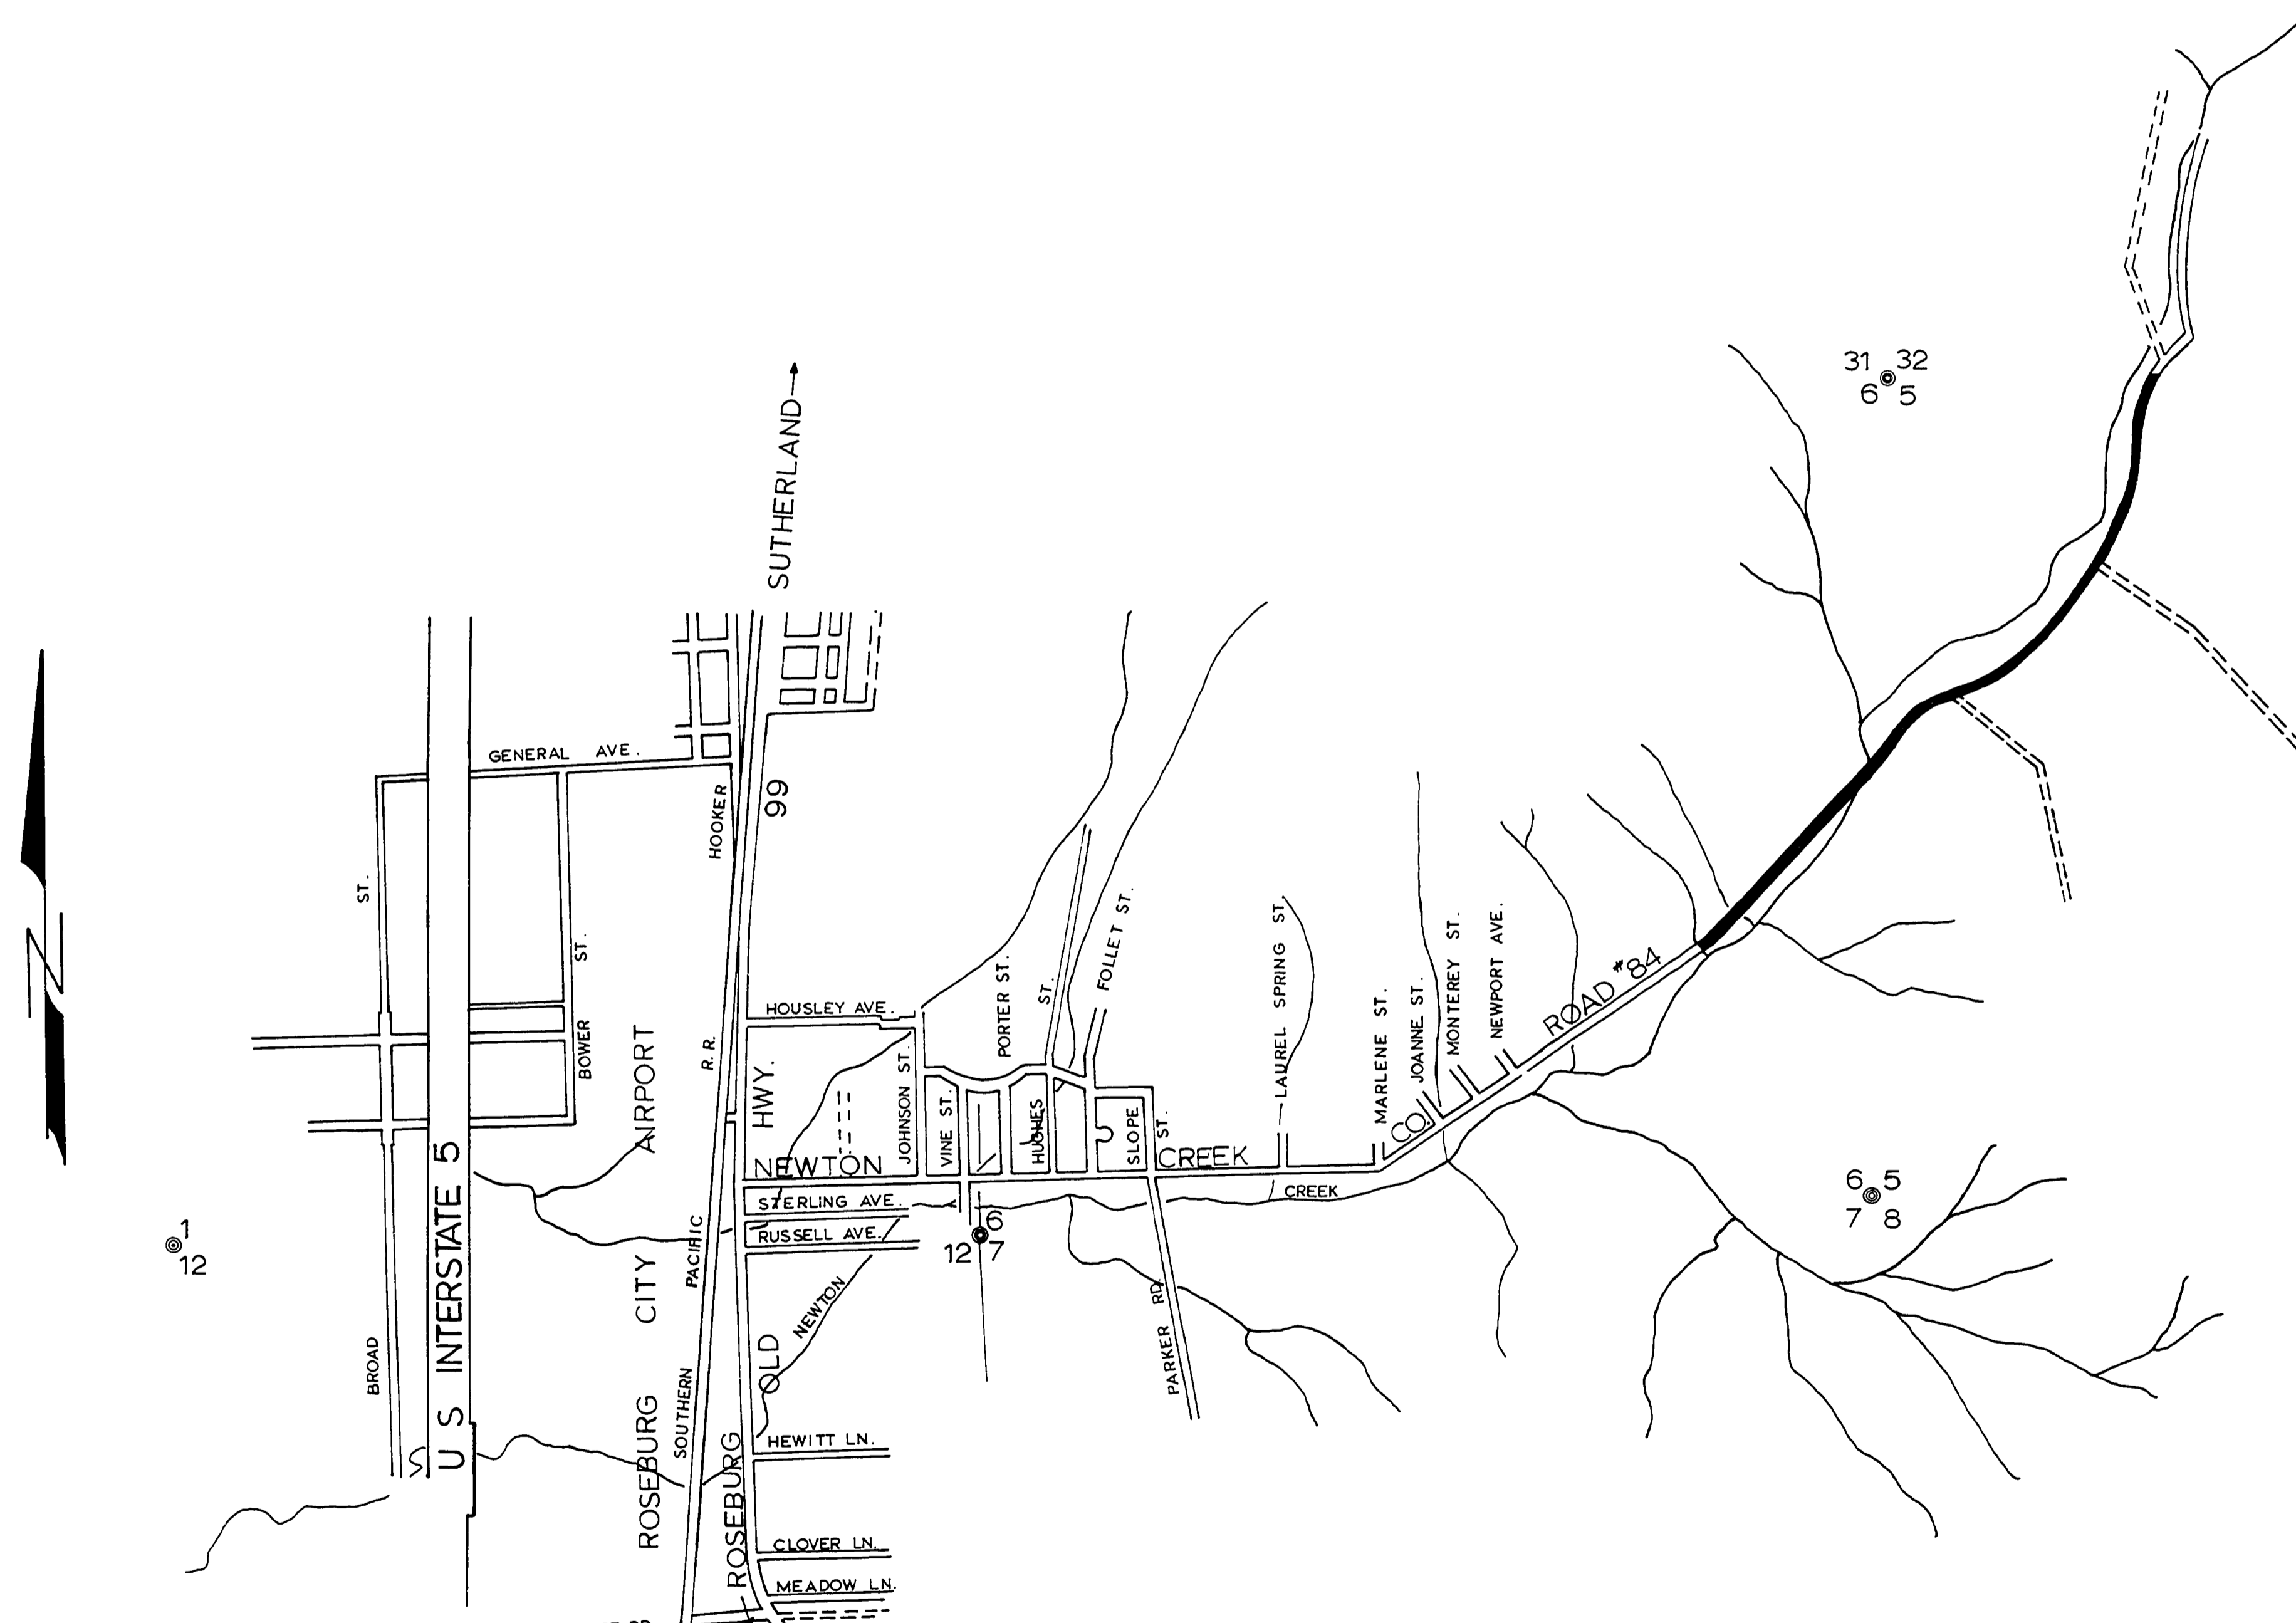

NOT REVISED
 AS CONSTRUCTED

DOUGLAS COUNTY ROAD DEPT.
 NEWTON CREEK ROAD NO. 84
 1973 (1972) SHT 1
 GEORGE E. GRUBB COUNTY ENGR.

0122021C

1972
 Co. Rd. # 84 -ht. 1 (56)

