



S 7 T 22 S R 12 W W.M.

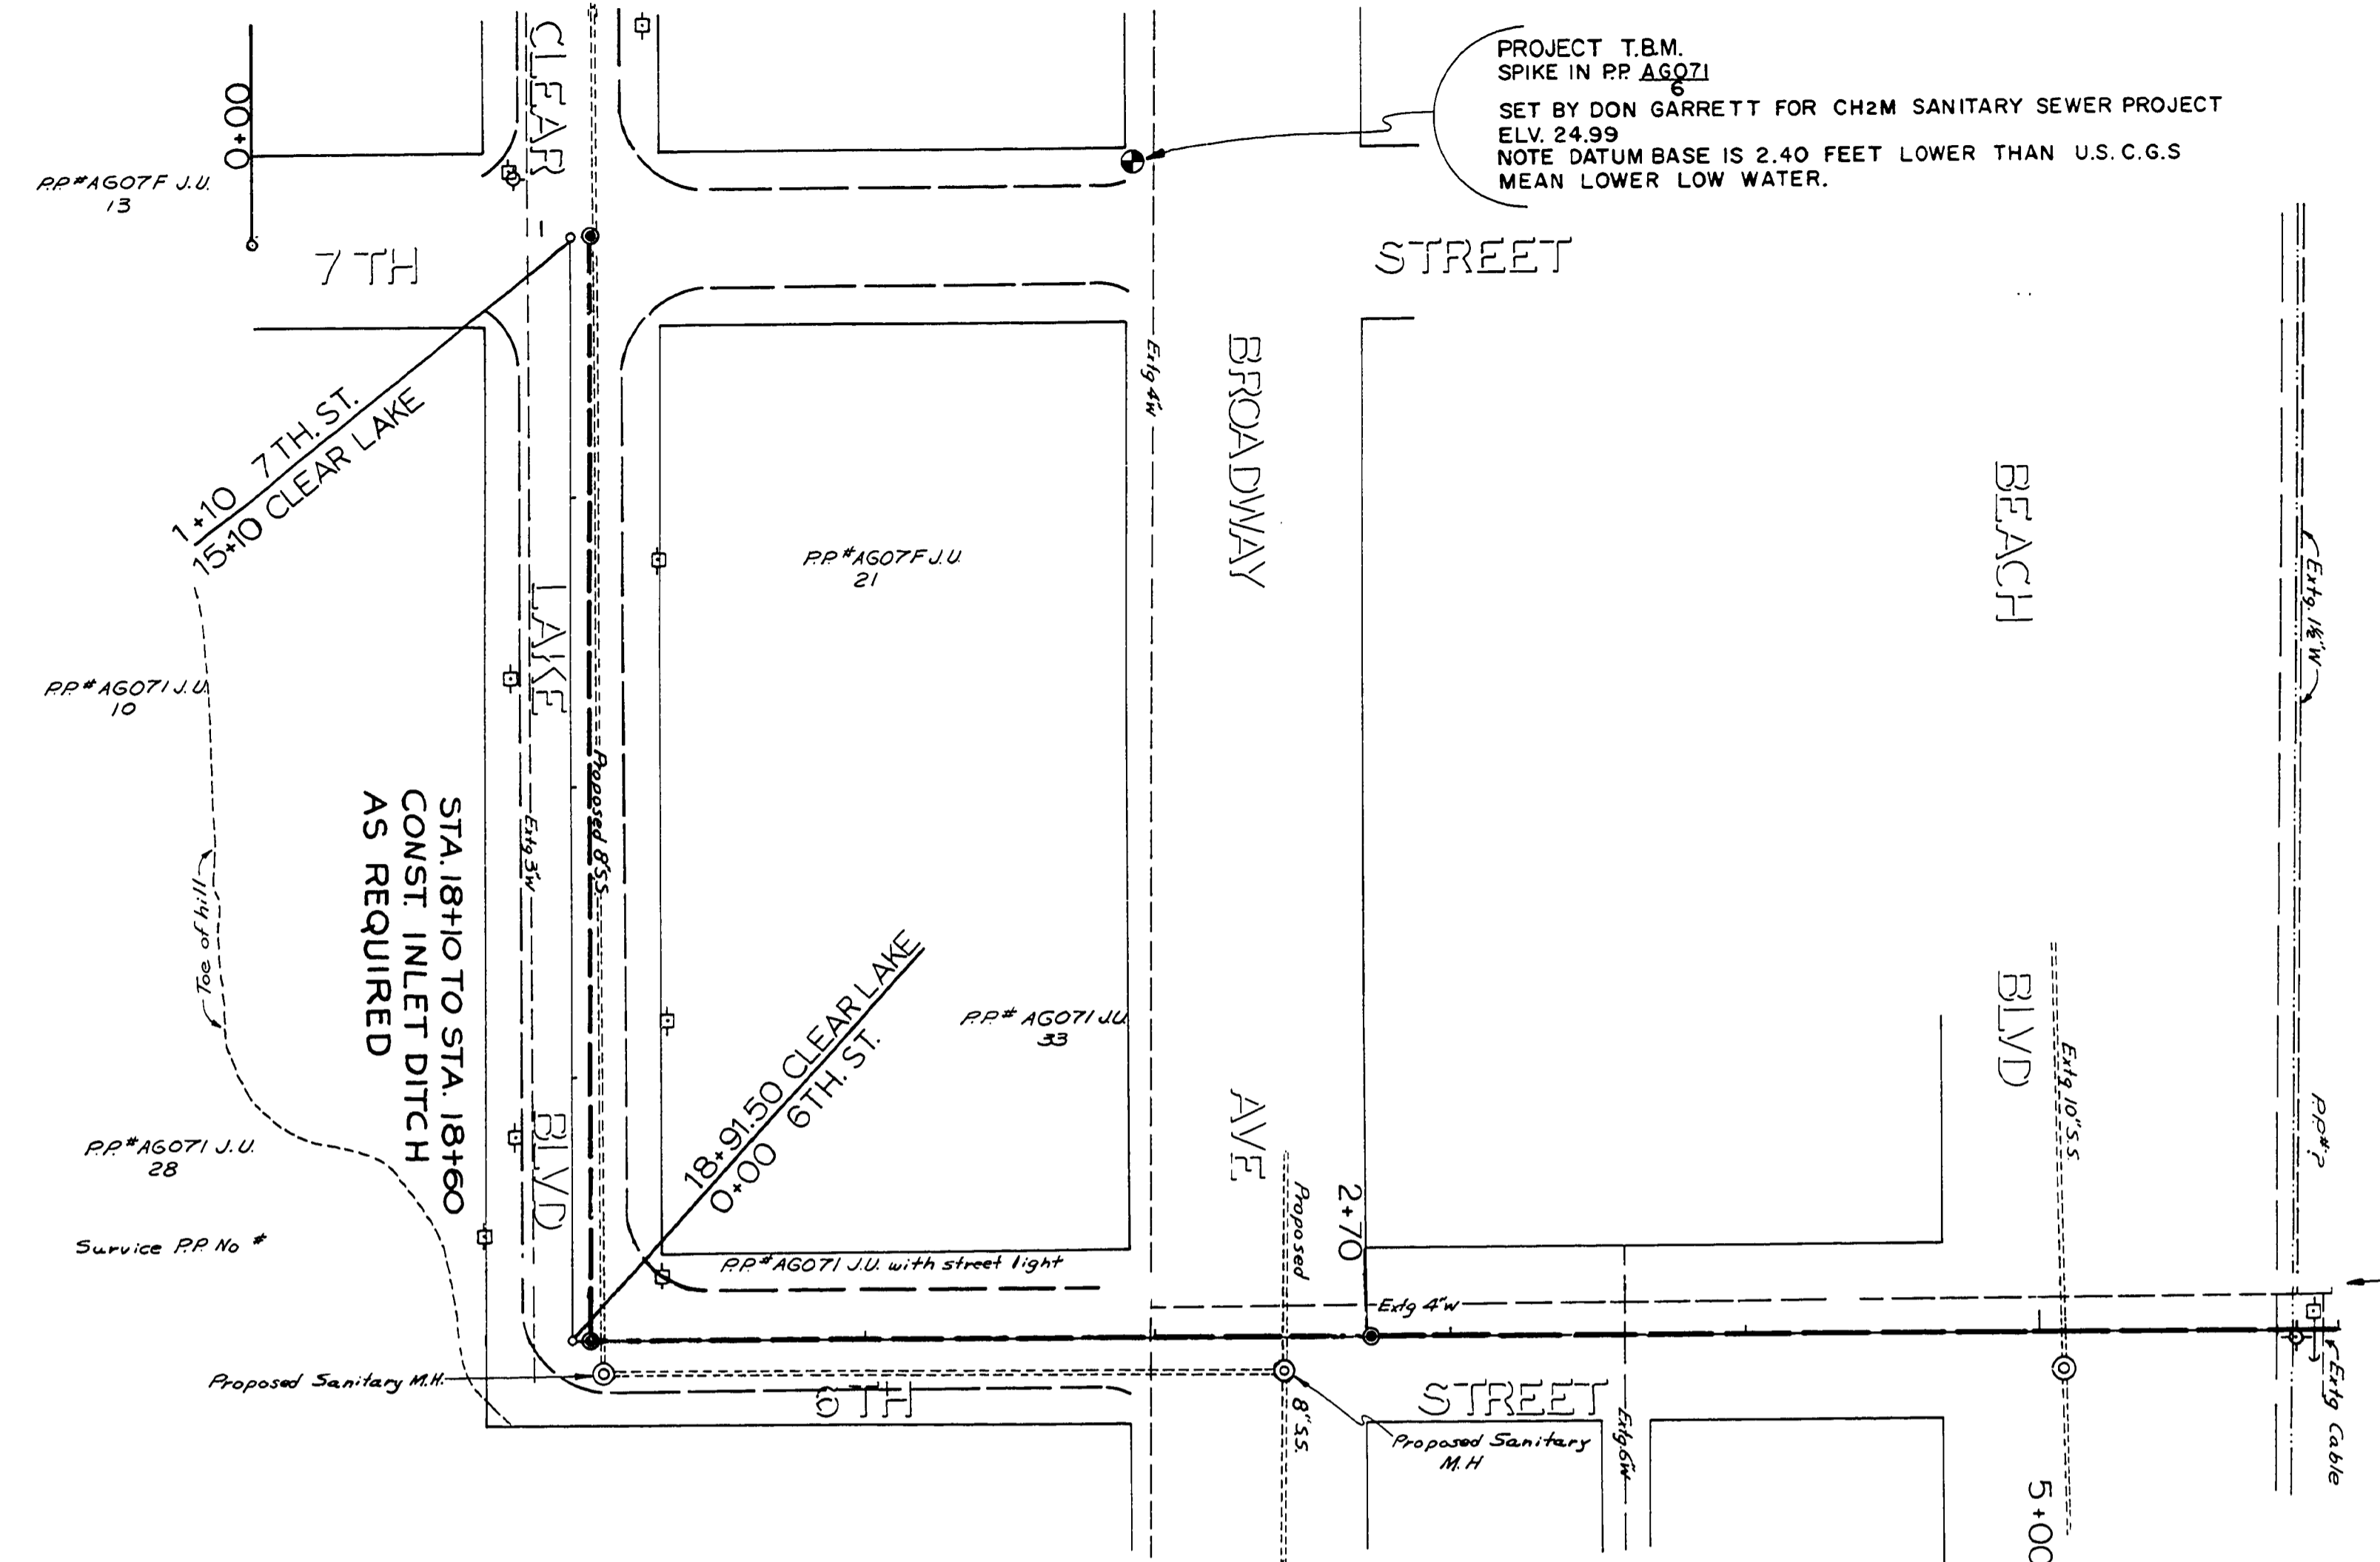


NOTE: STA. 5+00 TO 6+00 DEFLECT PIPE TO MISS DOCK ACCESS

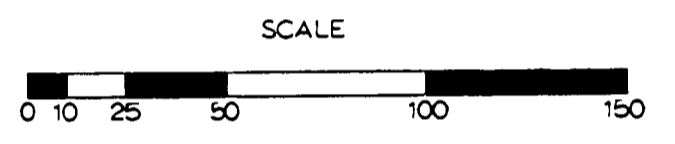

NOTE: IF STORM SEWER IS INSTALLED IN CONJUNCTION WITH CH2M SAN. SEWER A 15 FOOT MIN. PIPE OPERATION MUST BE MAINTAINED

PROFILE
HORZ SCALE 1" = 50'
VERT SCALE 1" = 5'

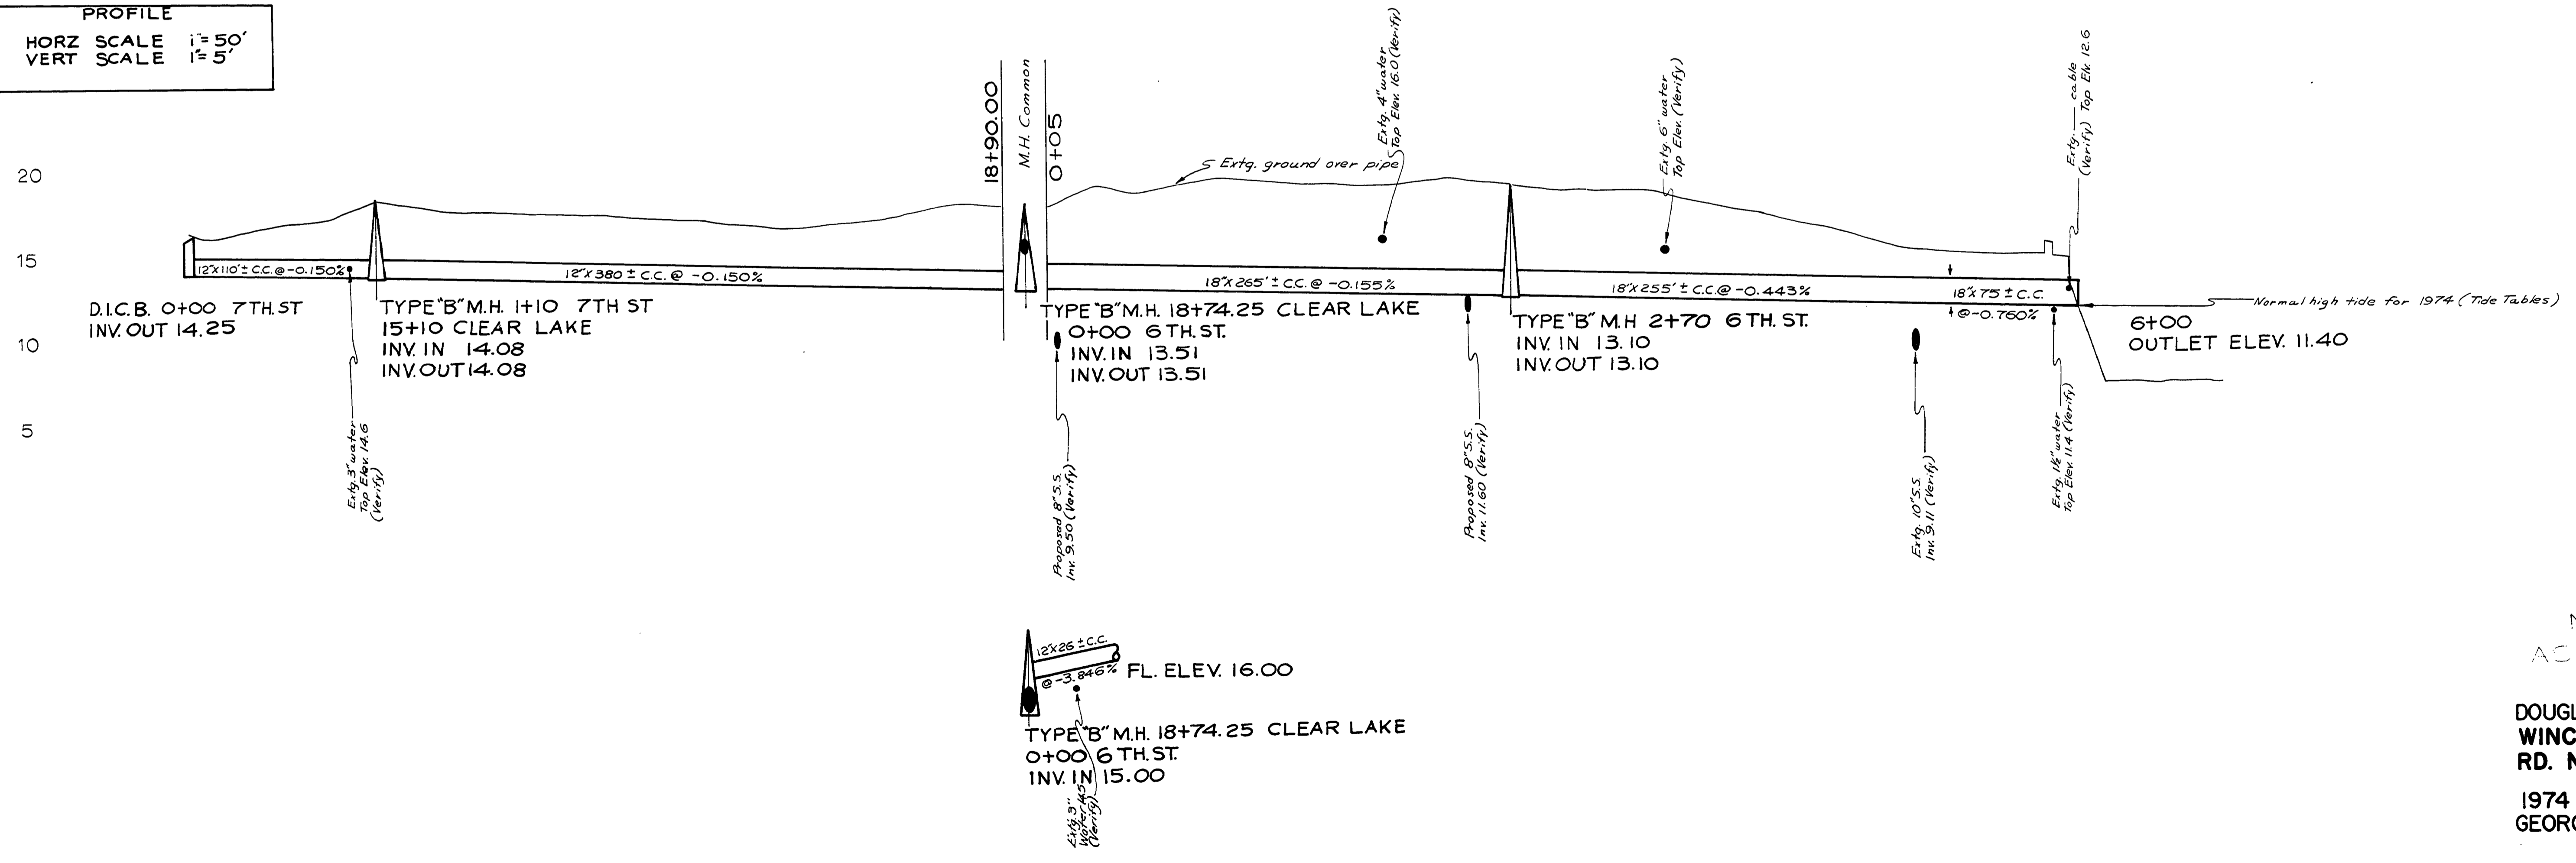

37E M.P. 0.00-0.11 37C M.P. 0.19-0.26

NOT REVISED
AS CONSTRUCTED

DOUGLAS COUNTY ROAD DEPT.
WINCHESTER BAY STREETS
RD. NO. 87A

1974 SHT. I
GEORGE E. GRUBB COUNTY ENG.

C. Rd. # 87A 1974 SHT. 1 (61)

00180026