

VICINITY MAP

# DOUGLAS COUNTY OREGON

AS CONSTRUCTED

## Grading and Surfacing

### COLE ROAD Co. Rd. No. 91

Adopted by Resolution of  
The County Court this 15<sup>th</sup>  
day of April 1963


*V. T. Johnson*  
JUDGE

*E. R. Metcalf*  
COMMISSIONER


*Paul C. Johnson*  
COMMISSIONER



approved *Al H. May* Date 4/10/63  
COUNTY ENGINEER

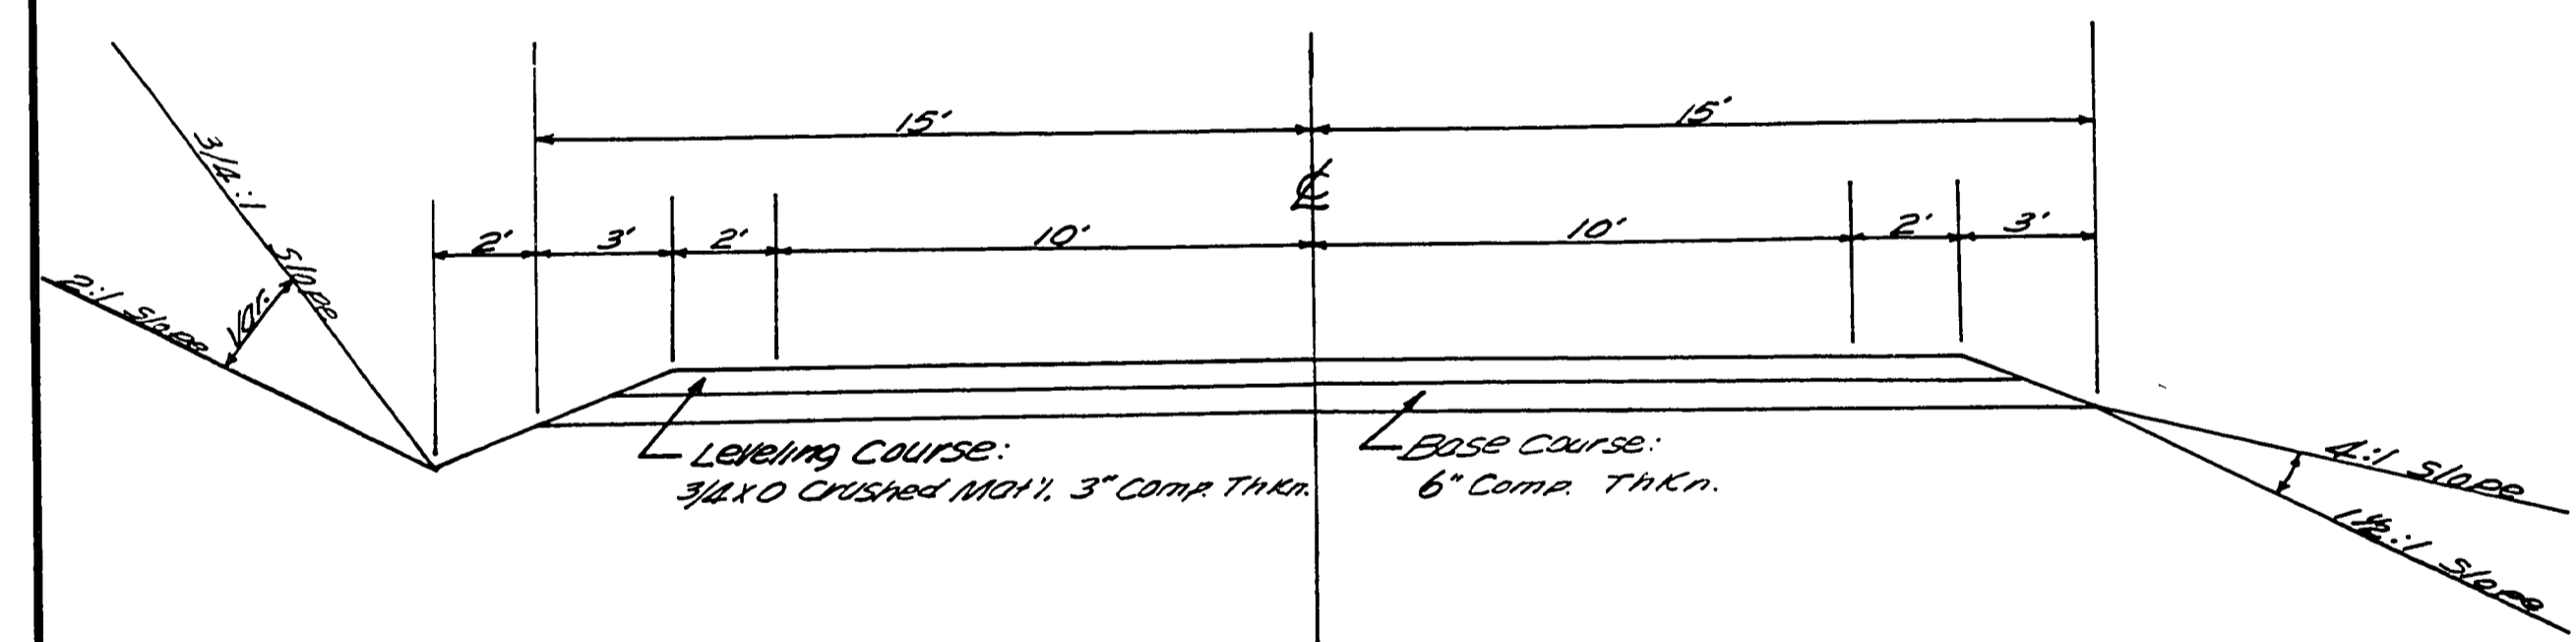

TYPICAL SECTION

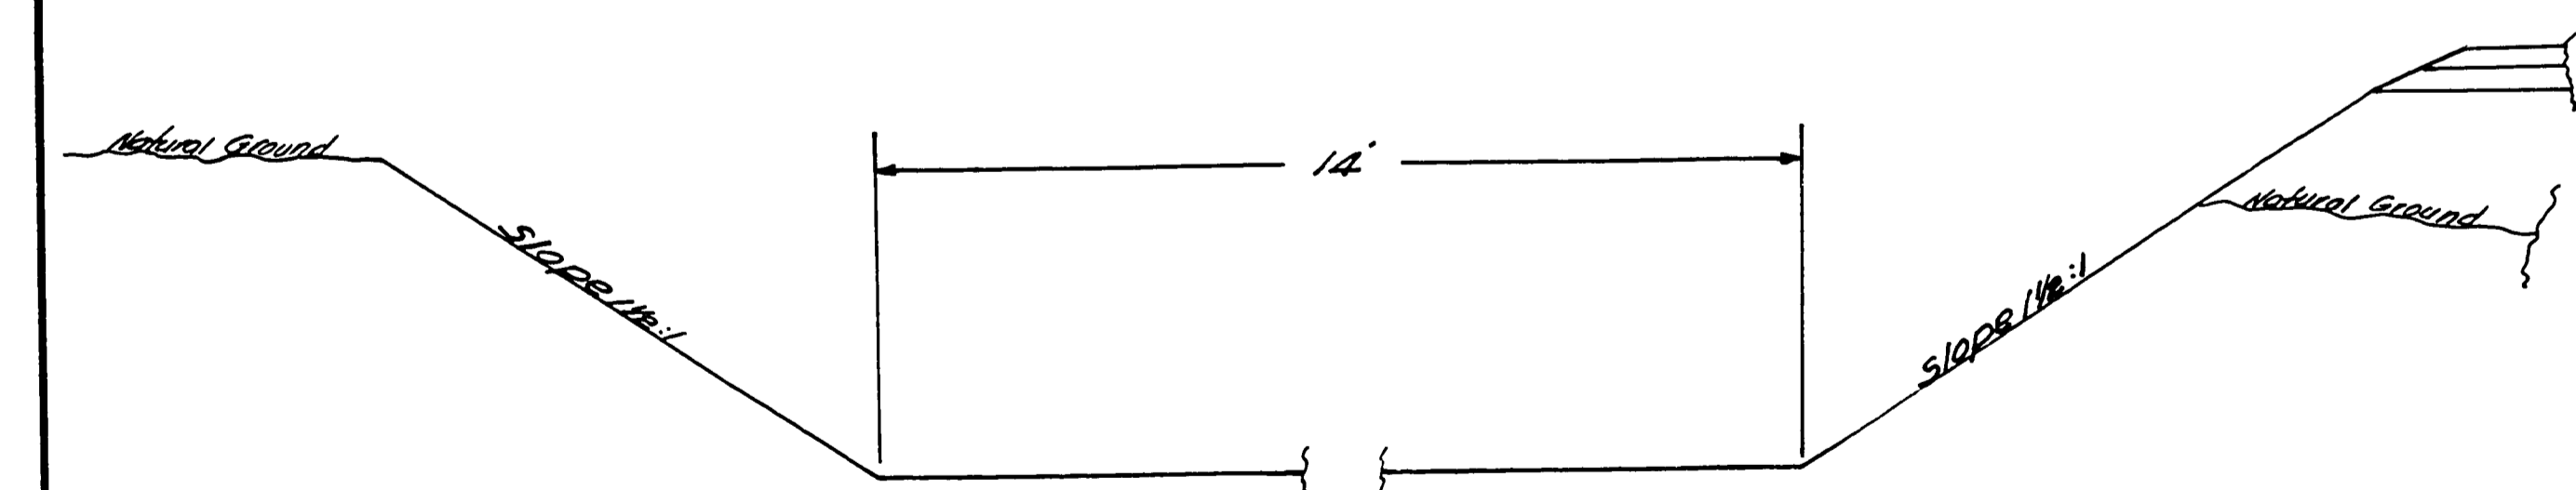

Channel Changes  
Sta. 21+00 to Sta. 23+00  
Sta. 29+00 to Sta. 31+00  
Sta. 71+50 to Sta. 73+00

FILED  
RECEIVED  
DEC 8 1963  
COUNTY ENGINEER  
1-22-63

0000022C