


DOUGLAS COUNTY, OREGON
 PLANS FOR PROPOSED PROJECT
 AS CONSTRUCTED
BEALS CREEK ROAD
 COUNTY RD. No. 94
 JANUARY 1961



TYPICAL SECTIONS

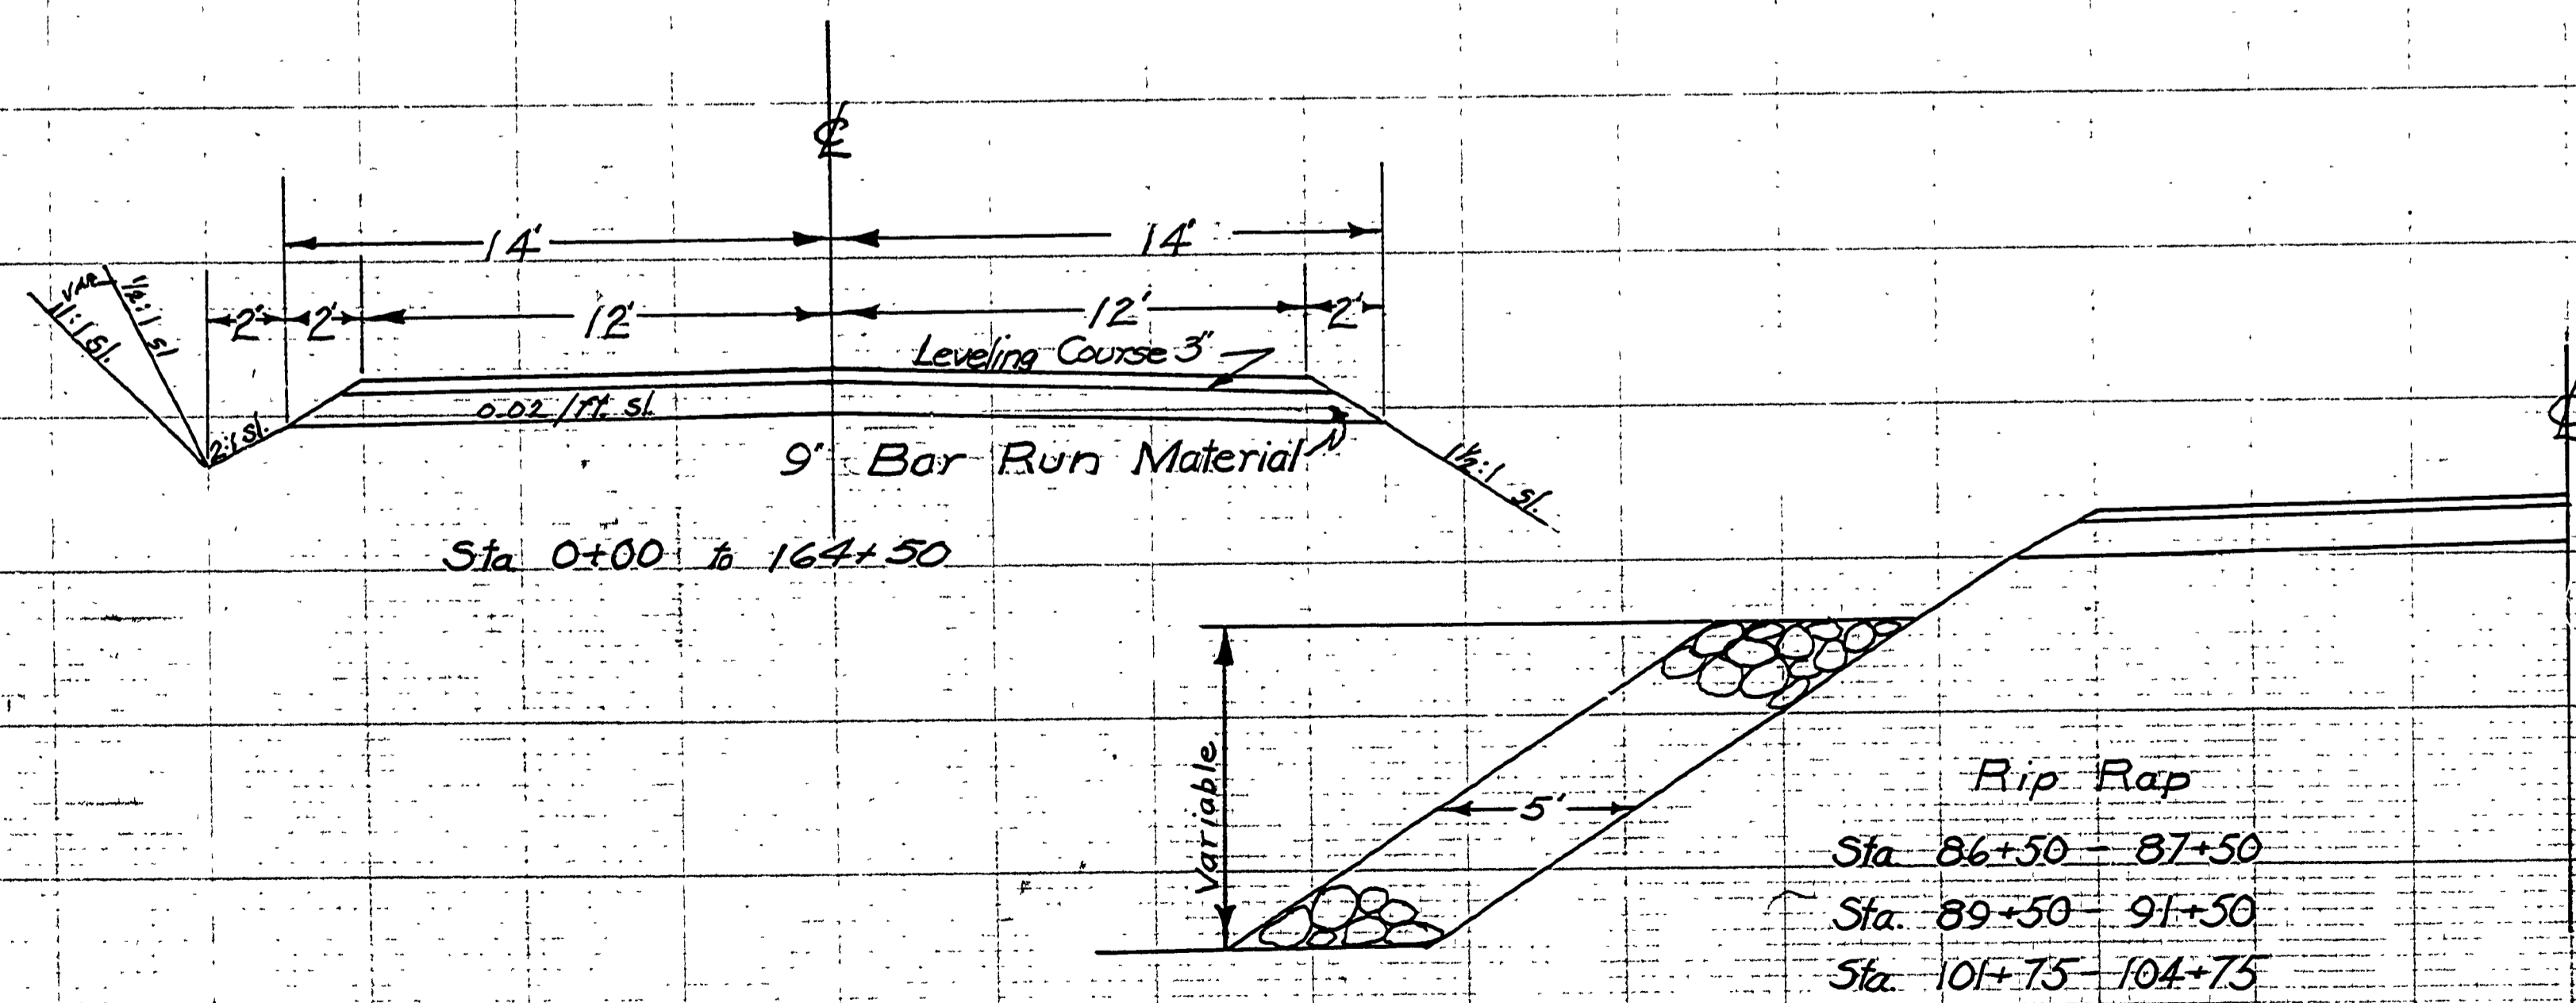

FILED *SL*
 RECEIVED
 #07 U.S.C.
 COUNTY SURVEYOR
 DOUGLAS COUNTY, ORE.

Sheet 1 of 7

Co. Rd. #94
 Jan 1961
 Sht. 7 of 7

100000310