



DOUGLAS COUNTY, OREGON  
 PLANS FOR PROPOSED PROJECT  
 GRADING & SURFACING  
**KENT CREEK ROAD NO. 100**  
 MILE POINT 0.00 TO MILE POINT 2.24  
**1972**

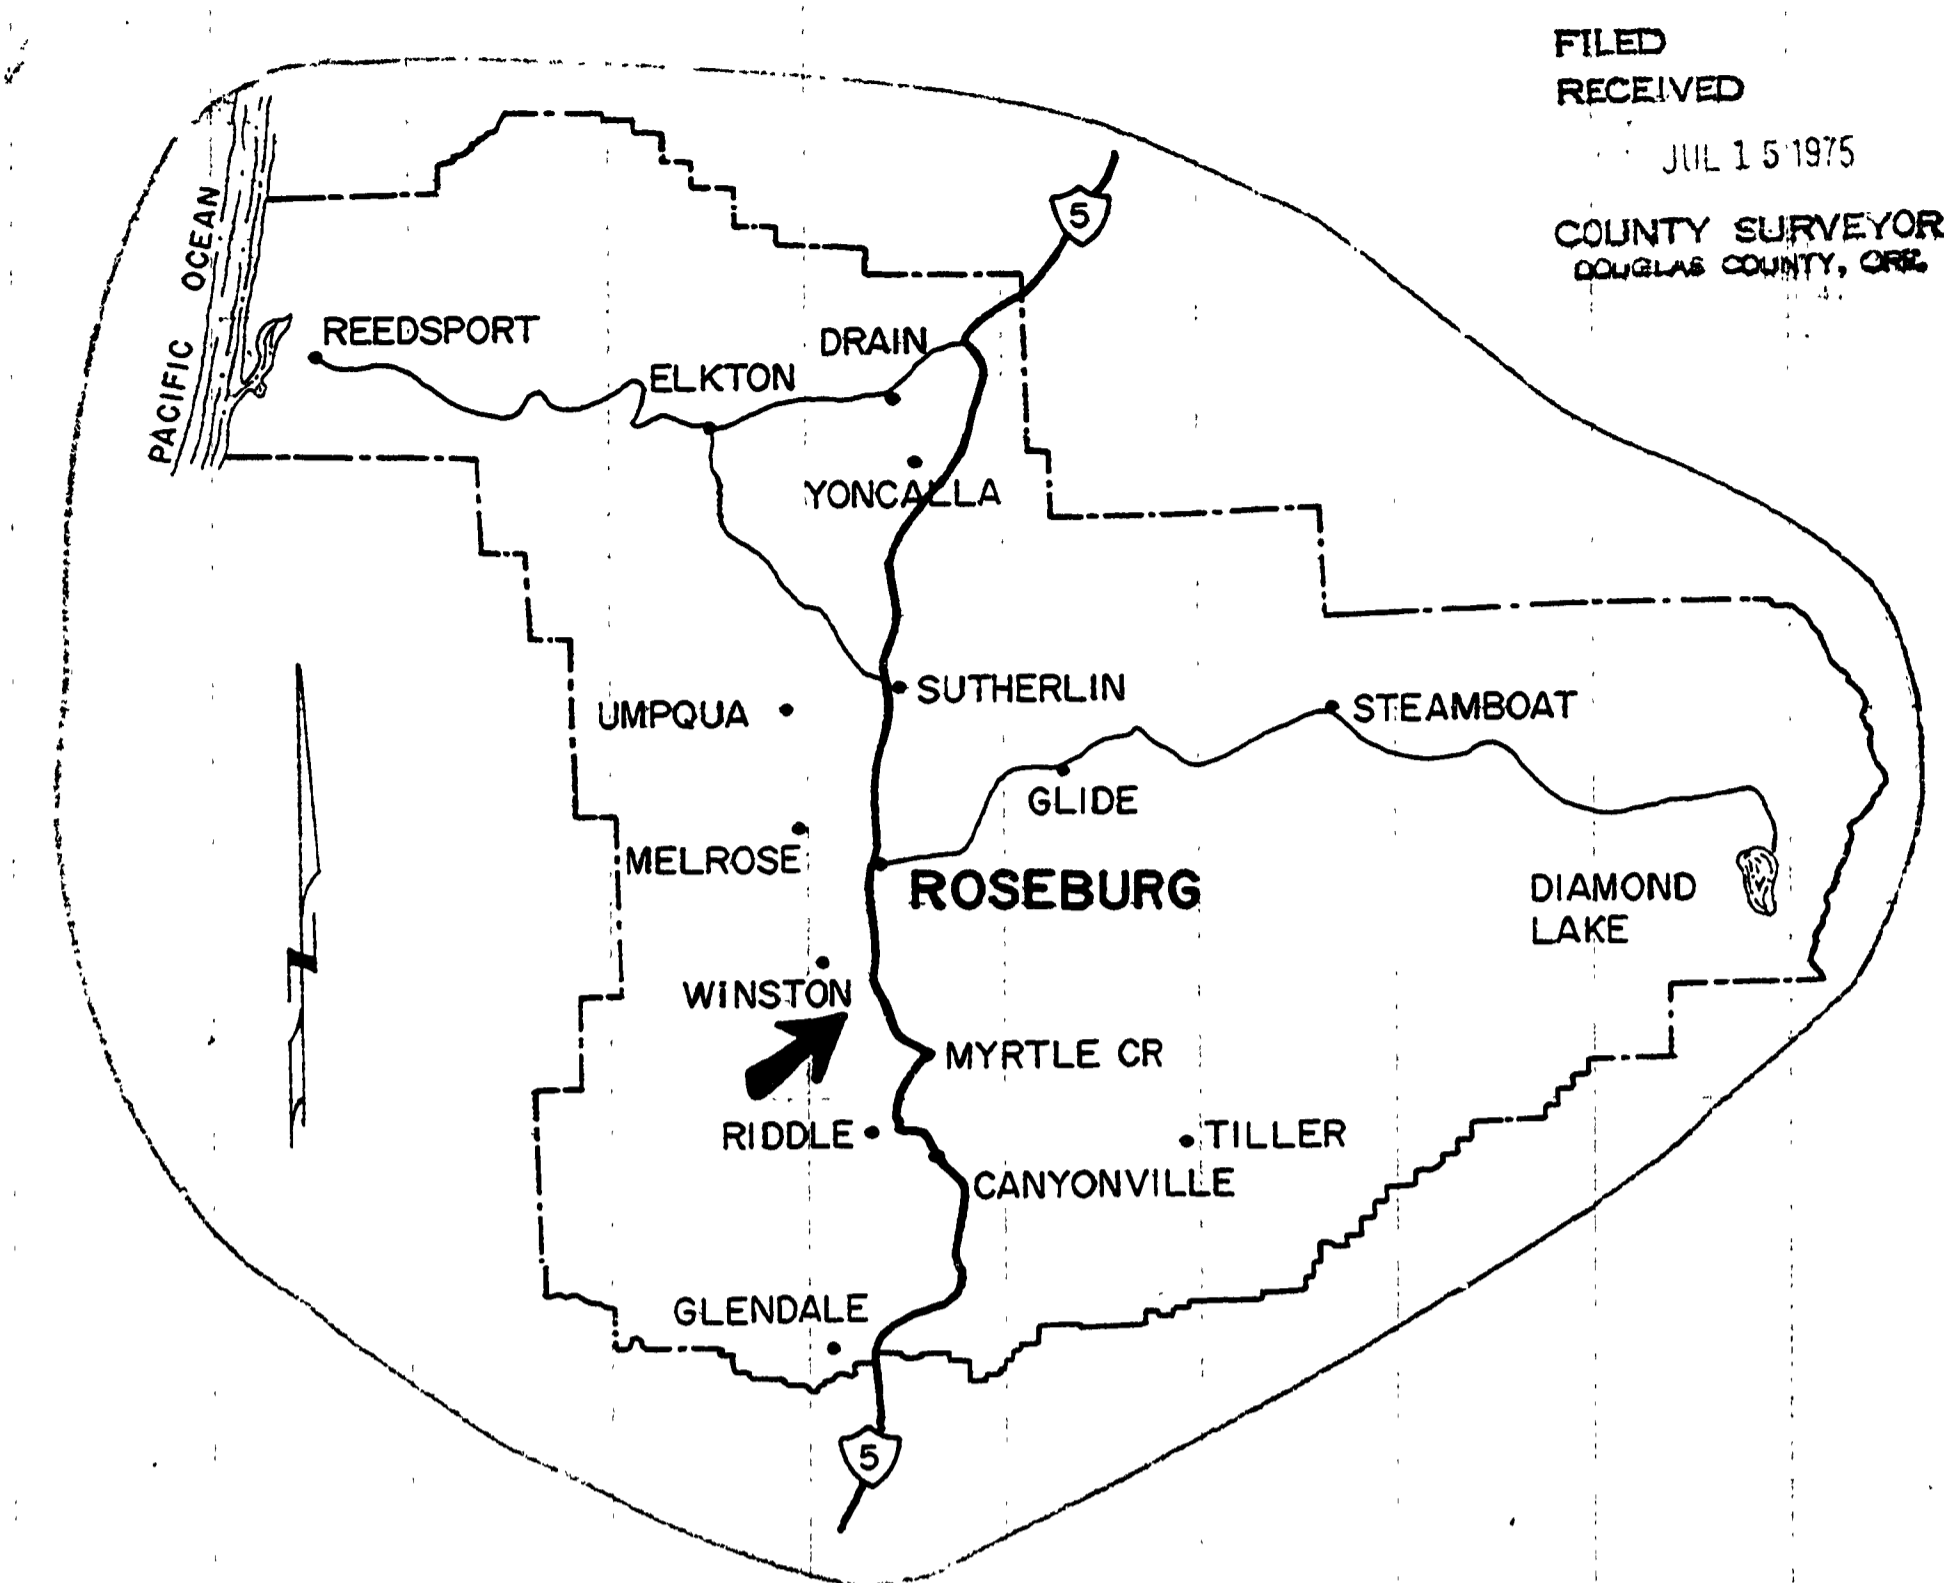

FILED  
 RECEIVED  
 JUL 15 1975  
 COUNTY SURVEYOR  
 DOUGLAS COUNTY, ORE.

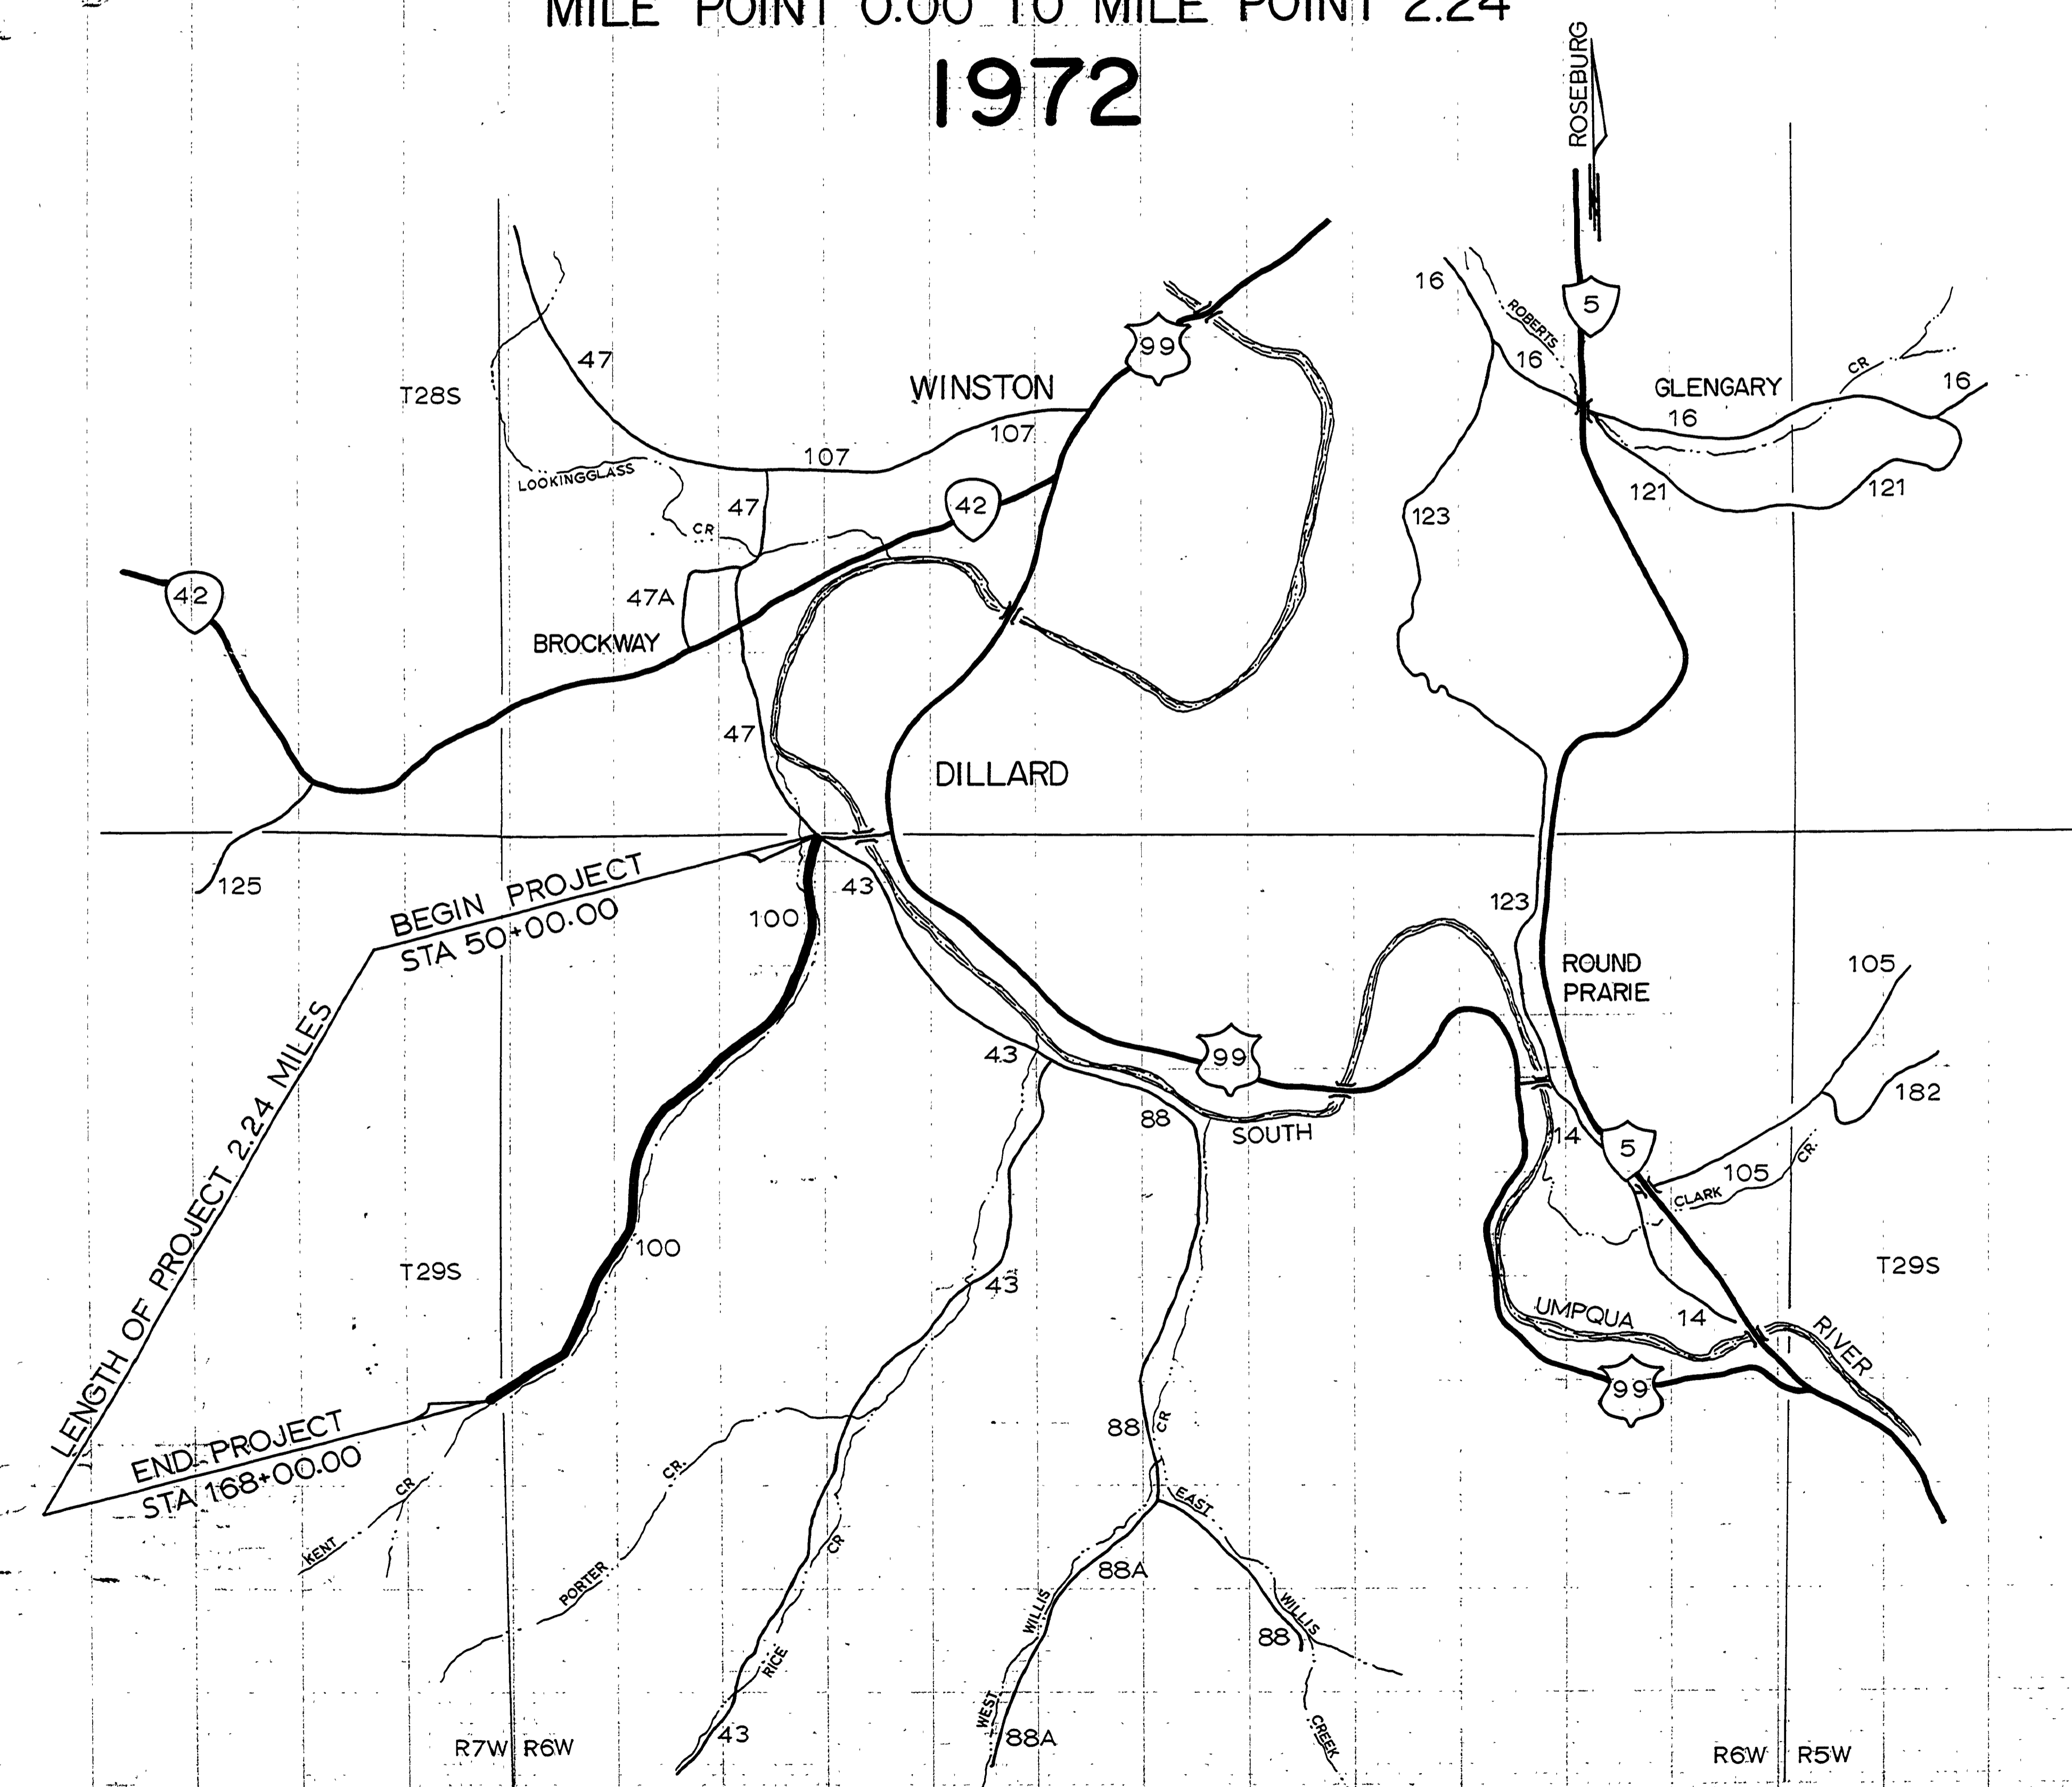

**INDEX OF DRAWINGS**

SHEET NUMBER	TITLE SHEET
1	TITLE SHEET
2	QUANTITY SUMMARY
3	TYPICAL SECTIONS
4	PIPE LIST
5 THRU 9	ROAD PLANS

STANDARD DRAWINGS  
 5, 6 & 9

TOTAL OF 12 SHEETS

NOT REVISED  
 AS CONSTRUCTED



DOUGLAS COUNTY ROAD DEPT.  
**KENT CREEK ROAD NO. 100**  
 1972      SH. 1  
 GEORGE E. GRUBB COUNTY ENGR.

1972  
 Co. Rd. #100      SH. 1      13