



KENT CREEK ROAD  
SHEET No 3

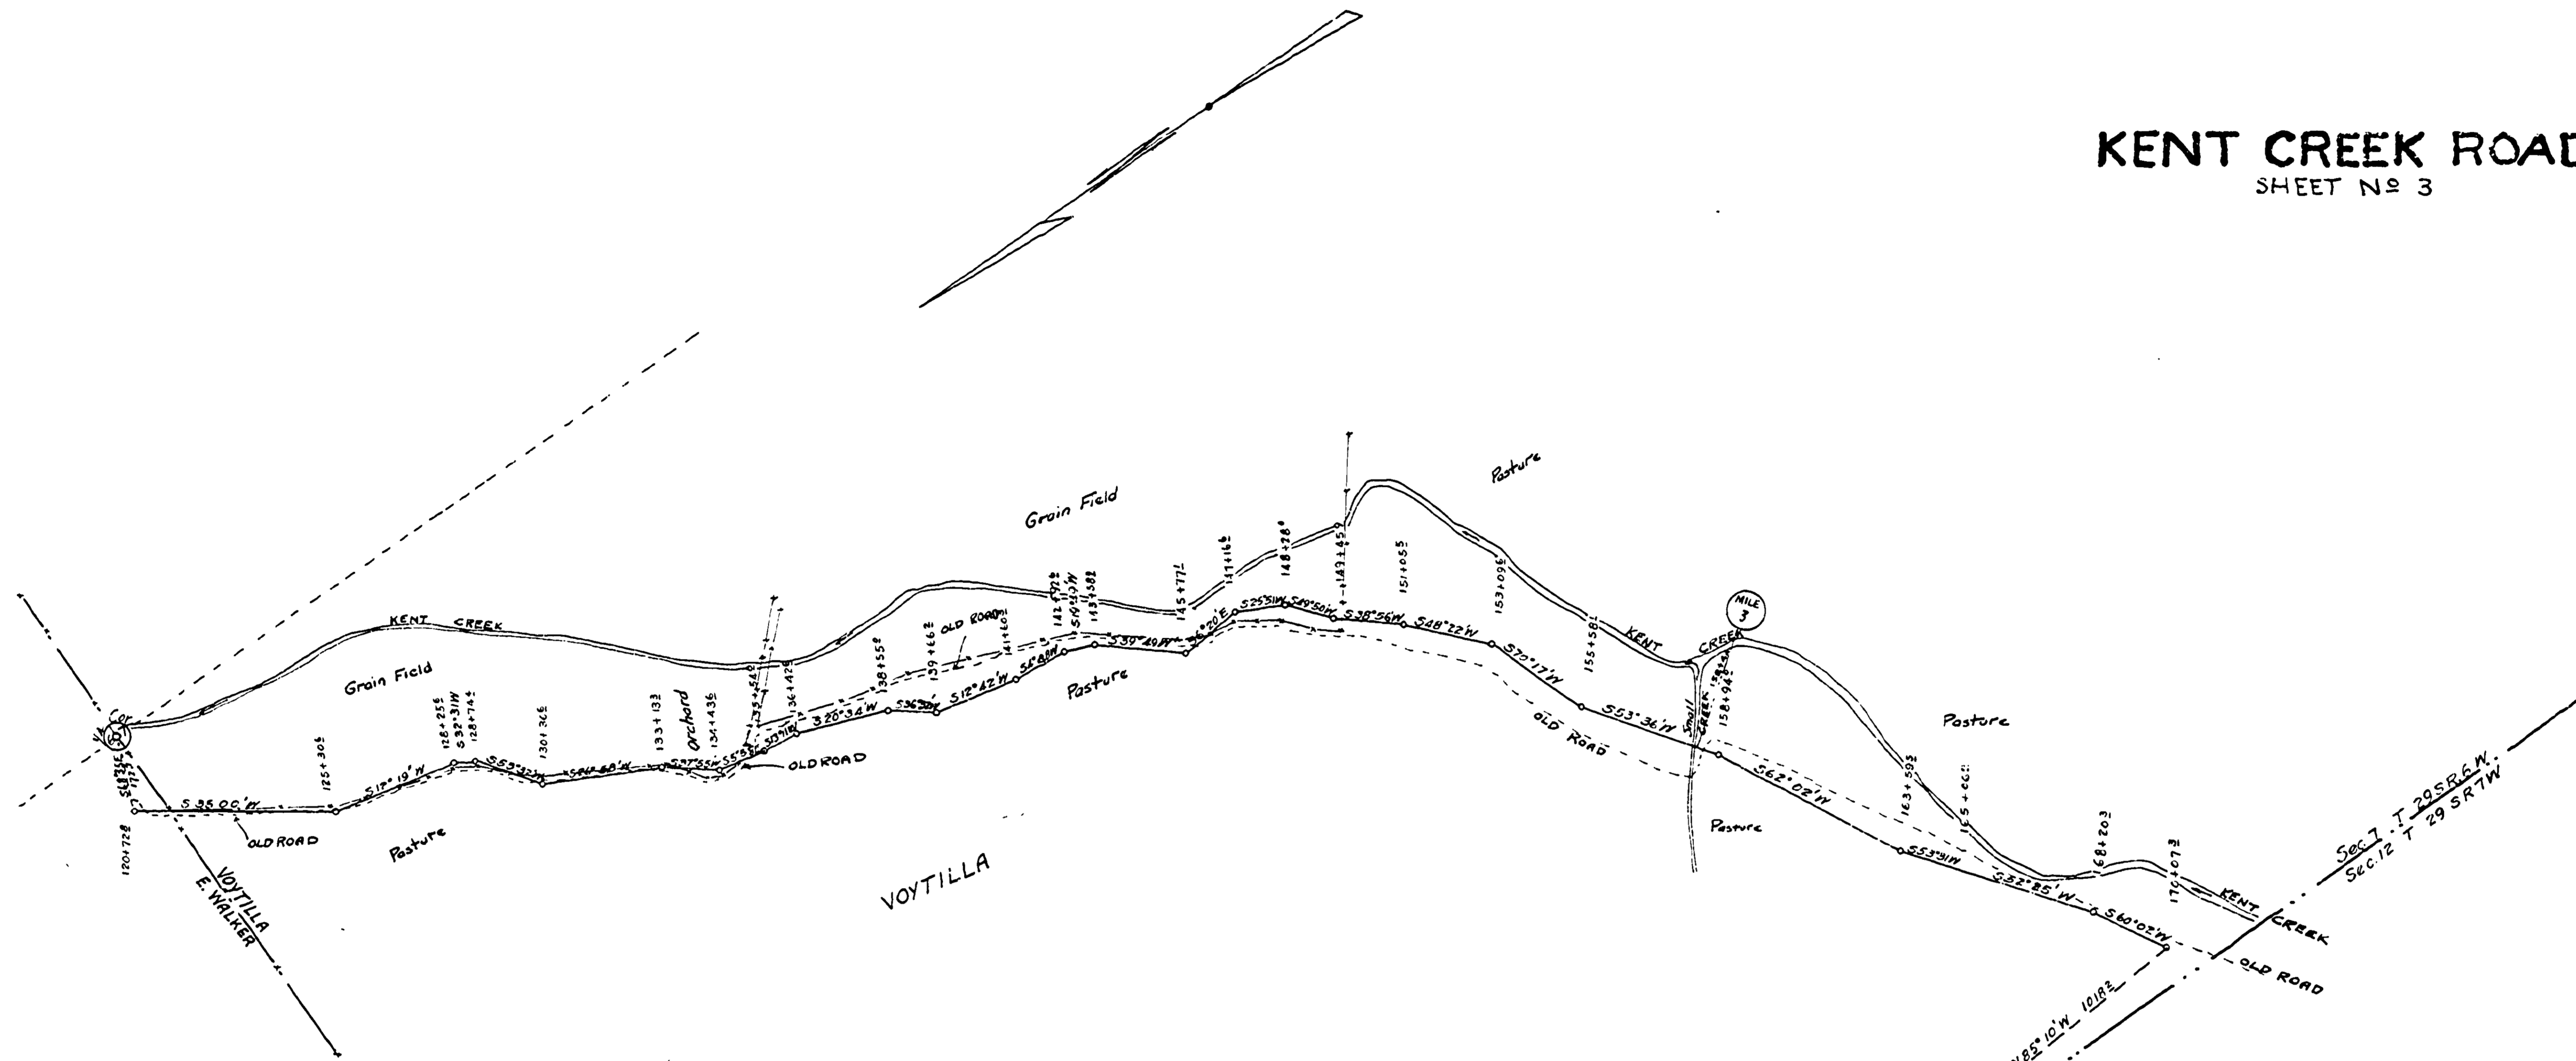

Mile	Station	Monument	Reference	Bearing
3	126+25.6		26" Cedar	N44°15'W 32.4 ft
			16" Alder	S31°35'E 124.7 ft
3	134+43.6		26" Cedar	N74°30'W 142.2 ft
			12" Maple	N26°W 154.6 ft
3	139+66.2		24" Fir	N58°20'W 21.5 ft
			15" Fir	S42°W 46.2 ft
3	143+58.4		14" Fir	S86°50'W 42.5 ft
			16" Fir	N26°20'W 83.0 ft
3	151+05.5		32" Maple	N75°05'E 178.7 ft
			12" Maple	S47°30'W 141.6 ft
3	158+40		12" Maple	N22°20'W 81.6 ft
			7" Maple	N75°E 81.8 ft
4	165+06		8" Maple	N4°15'W 89.2 ft
			16" Maple	S31°E 89.1 ft
4	170+07.3	Iron Pin	5" Pine	N81°W 69.2 ft
			12" x 24" Rock Wood	N21°W 20.0 ft

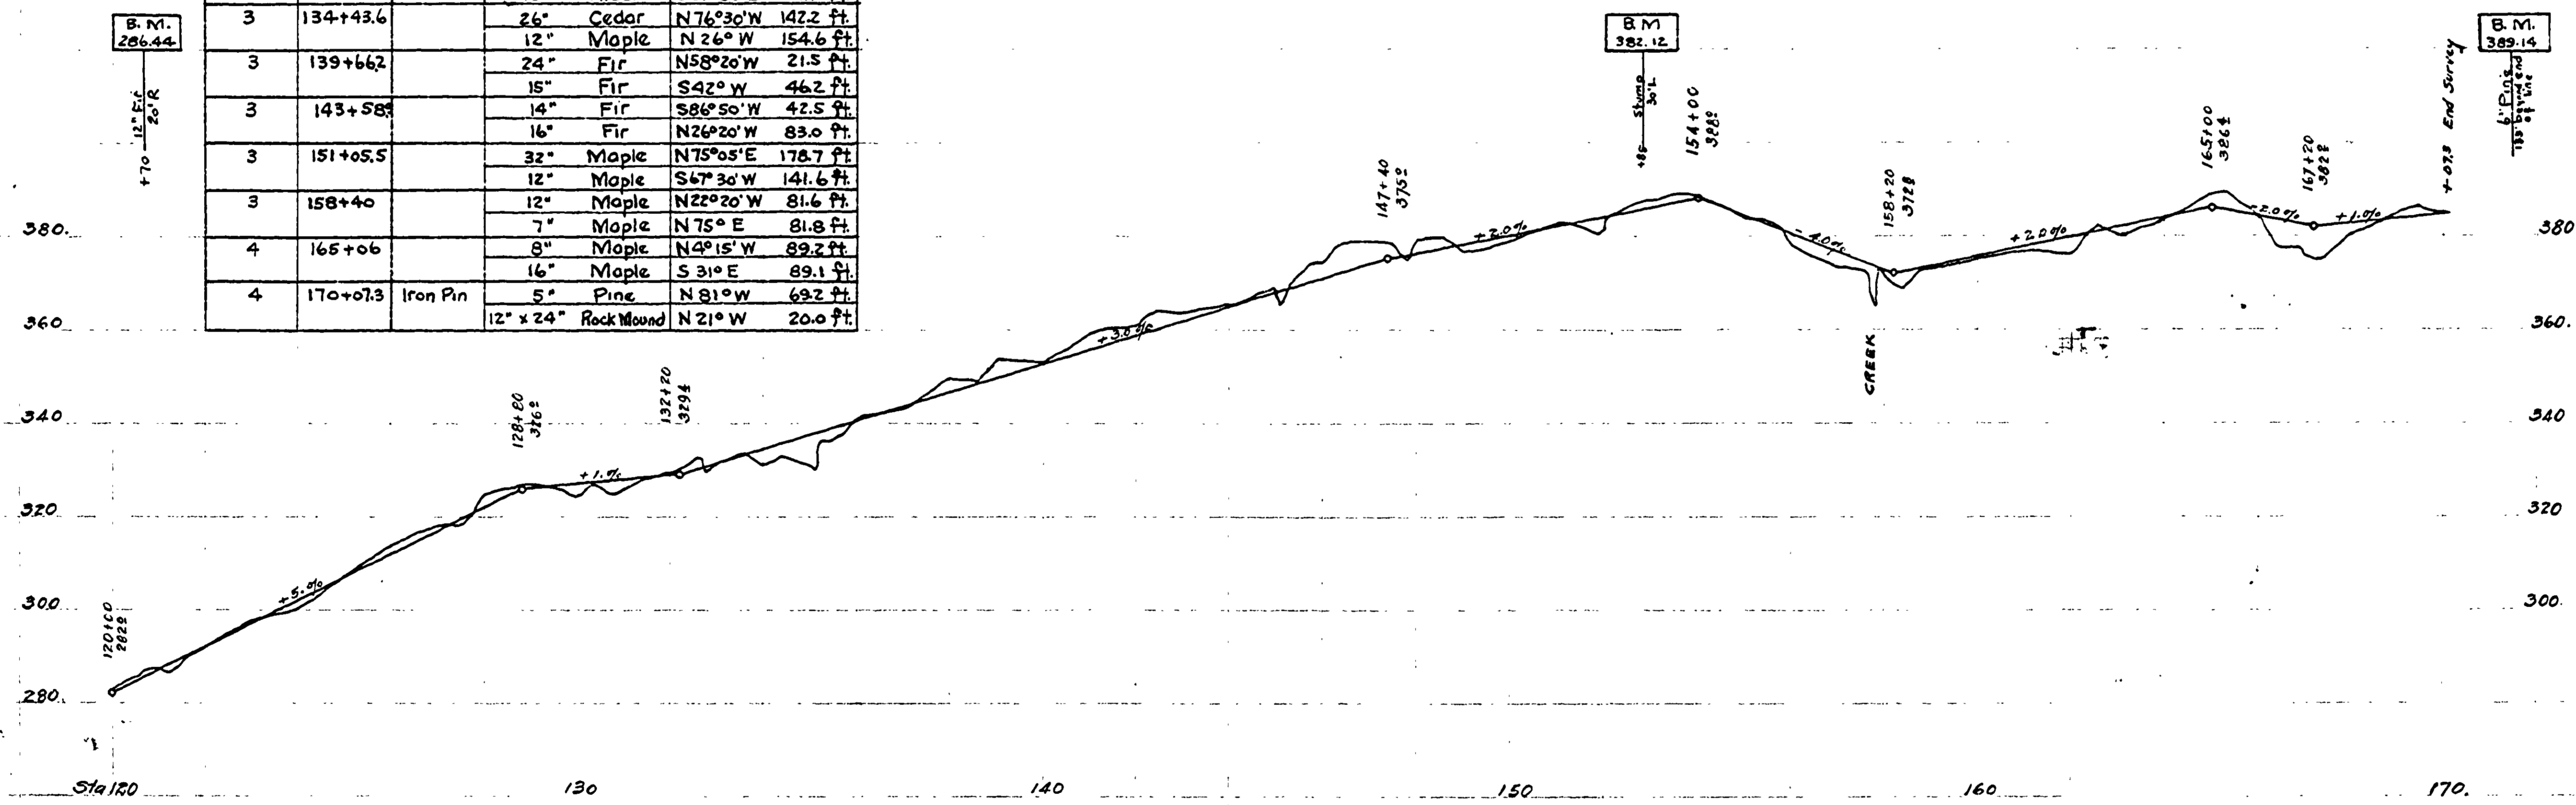

KENT CRK  
SHEET No 3

02290322

100

30 X

