

DOUGLAS COUNTY, OREGON

PLANS FOR PROPOSED PROJECT


GRADING & SURFACING

CLARKS BRANCH 105

1975

MILE POINT 0.11 TO MILE POINT 2.25

FILED
RECEIVED
AUG 1 1979
COUNTY SURVEYOR
DOUGLAS COUNTY, ORE.

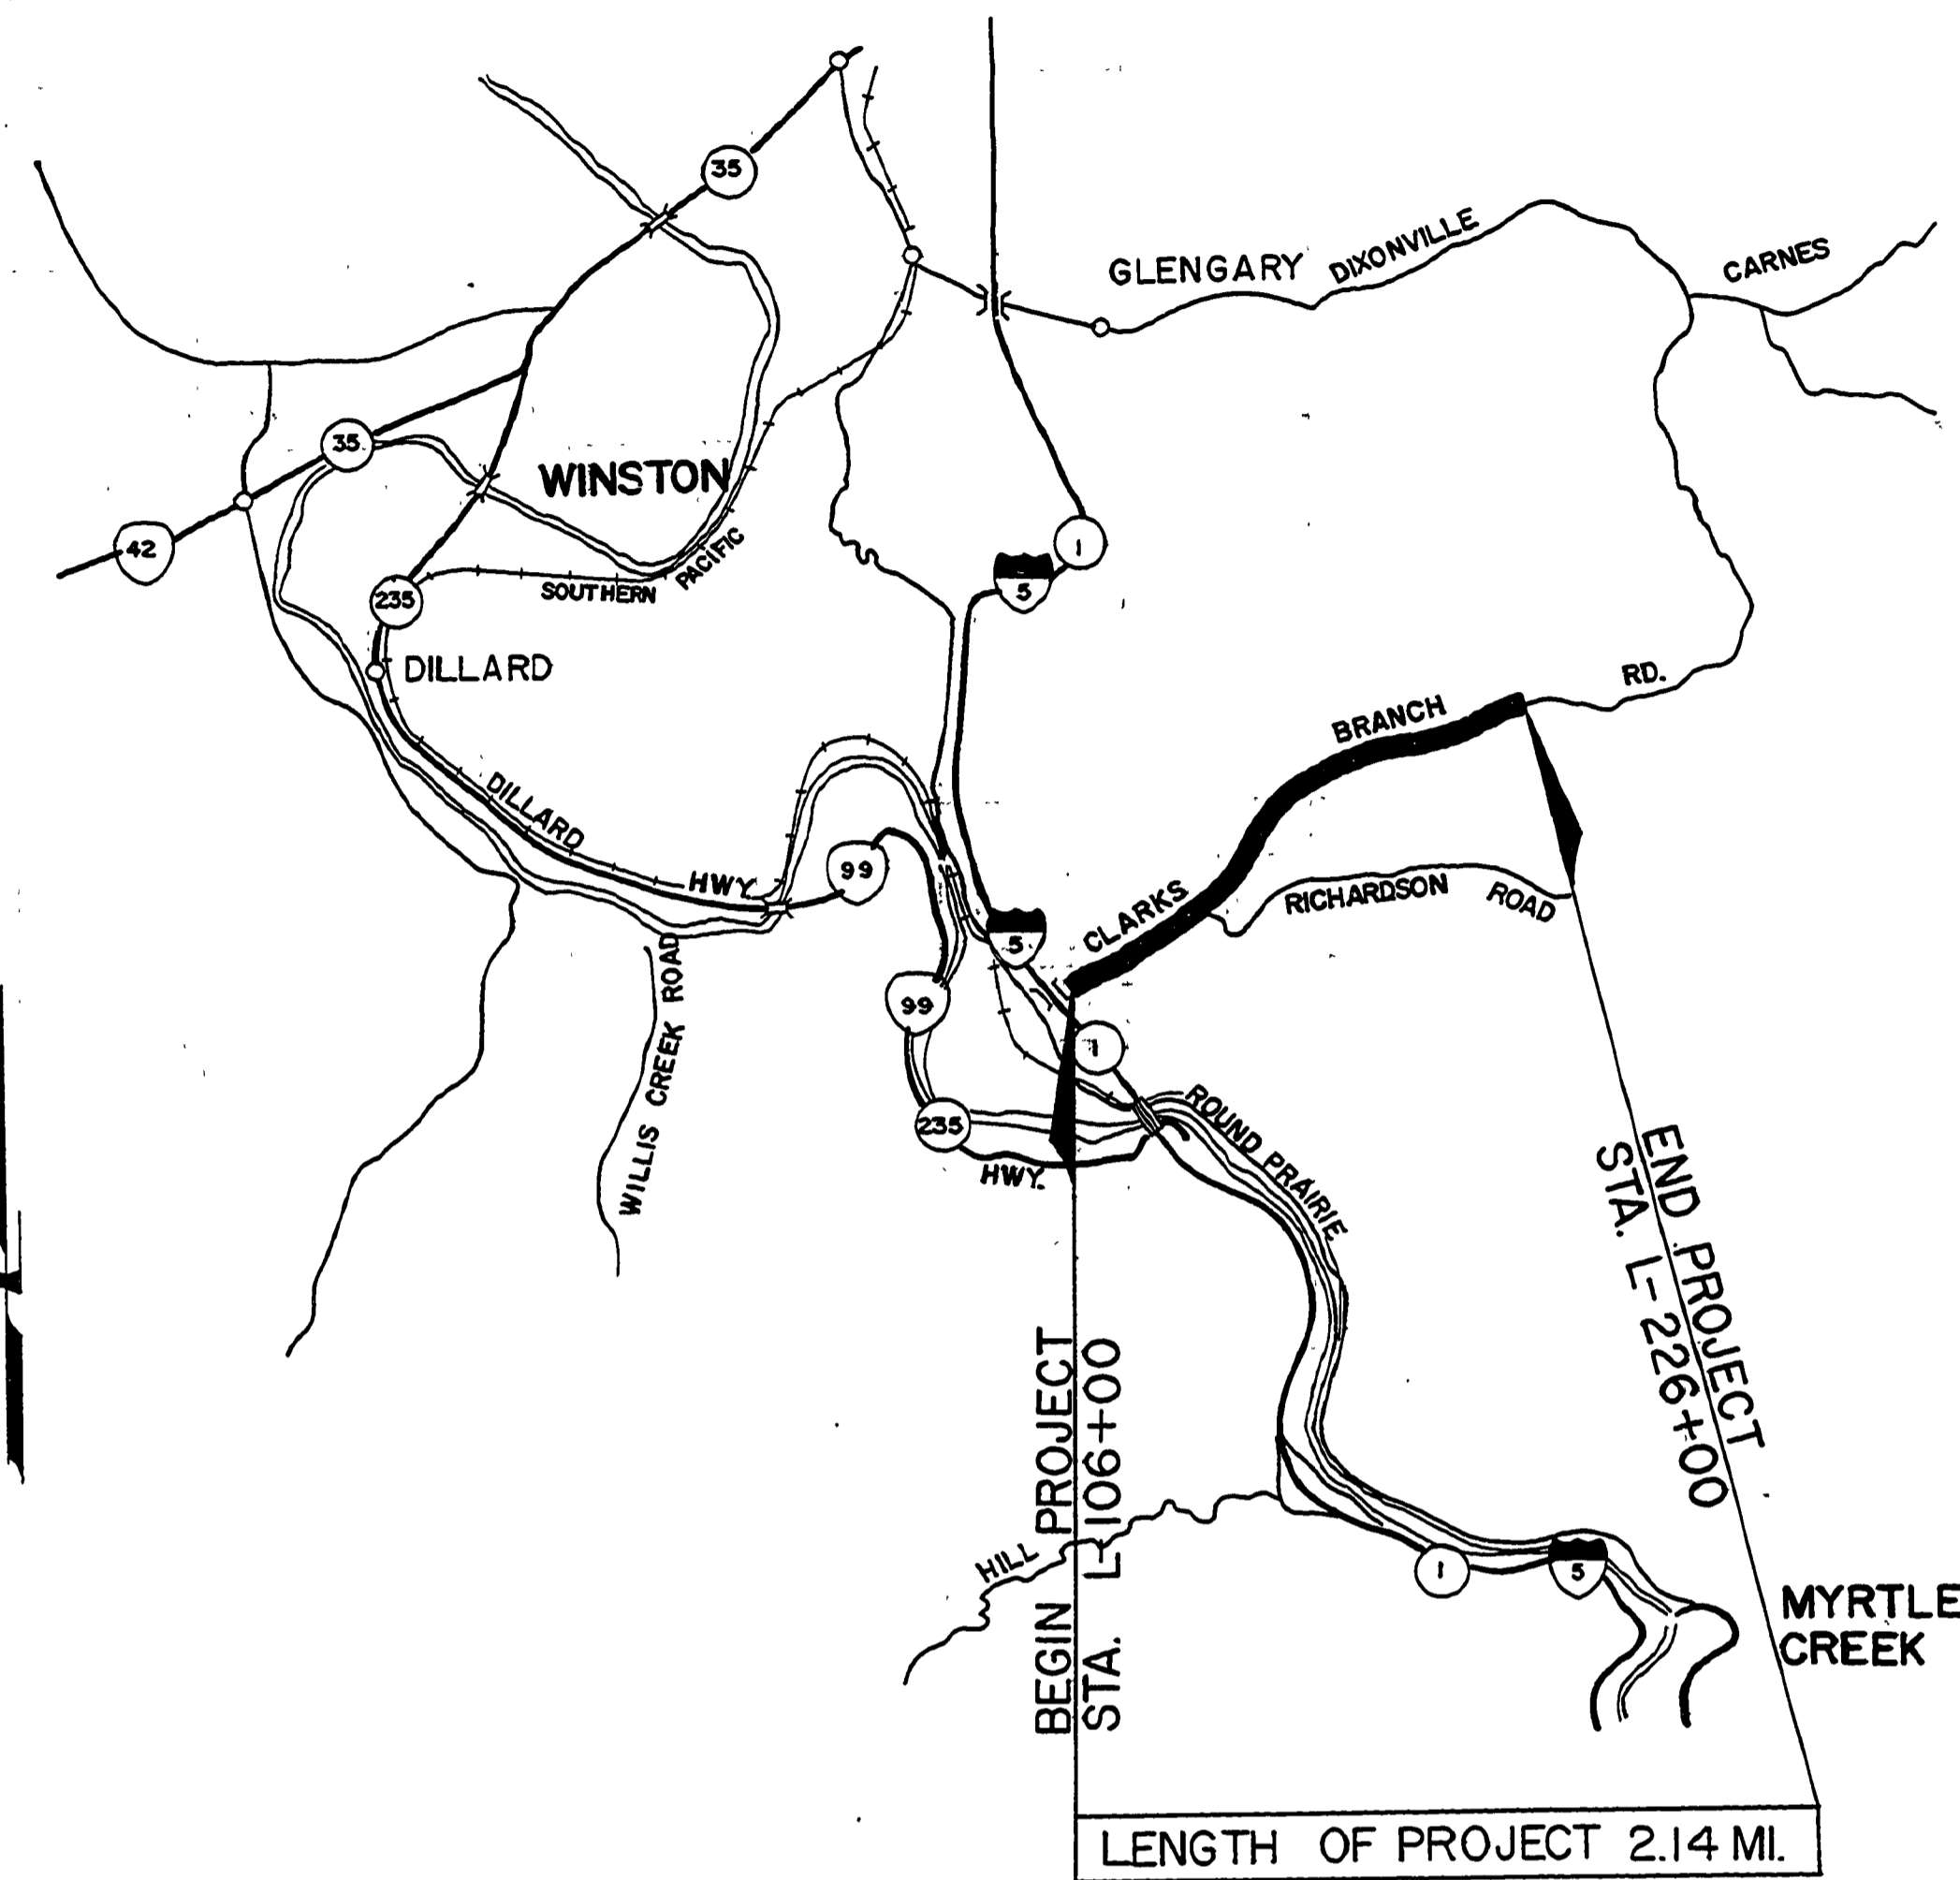

INDEX OF DRAWINGS

SHEET NUMBER

- 1. TITLE SHEET
- 2. QUANTITY SUMMARY
- 3. TYPICAL SECTIONS
- 4. PIPE LIST, MAIL BOX STANDARD, DRIVEWAY TYPICALS & SLOPE STAKE EXAMPLE
- 5-8 ROAD PLANS

STANDARD DRAWINGS

- 9.
- TOTAL OF 9 SHEETS



AS BUILT - 7/13/79 L.L.
DOUGLAS COUNTY
PUBLIC WORKS DEPARTMENT
CLARKS BRANCH ROAD 105
1975 SHT. 1
GEORGE E. GRUBB, DIRECTOR

1975
Co. Rd. #105 Sht. 1 (22)

00110240