
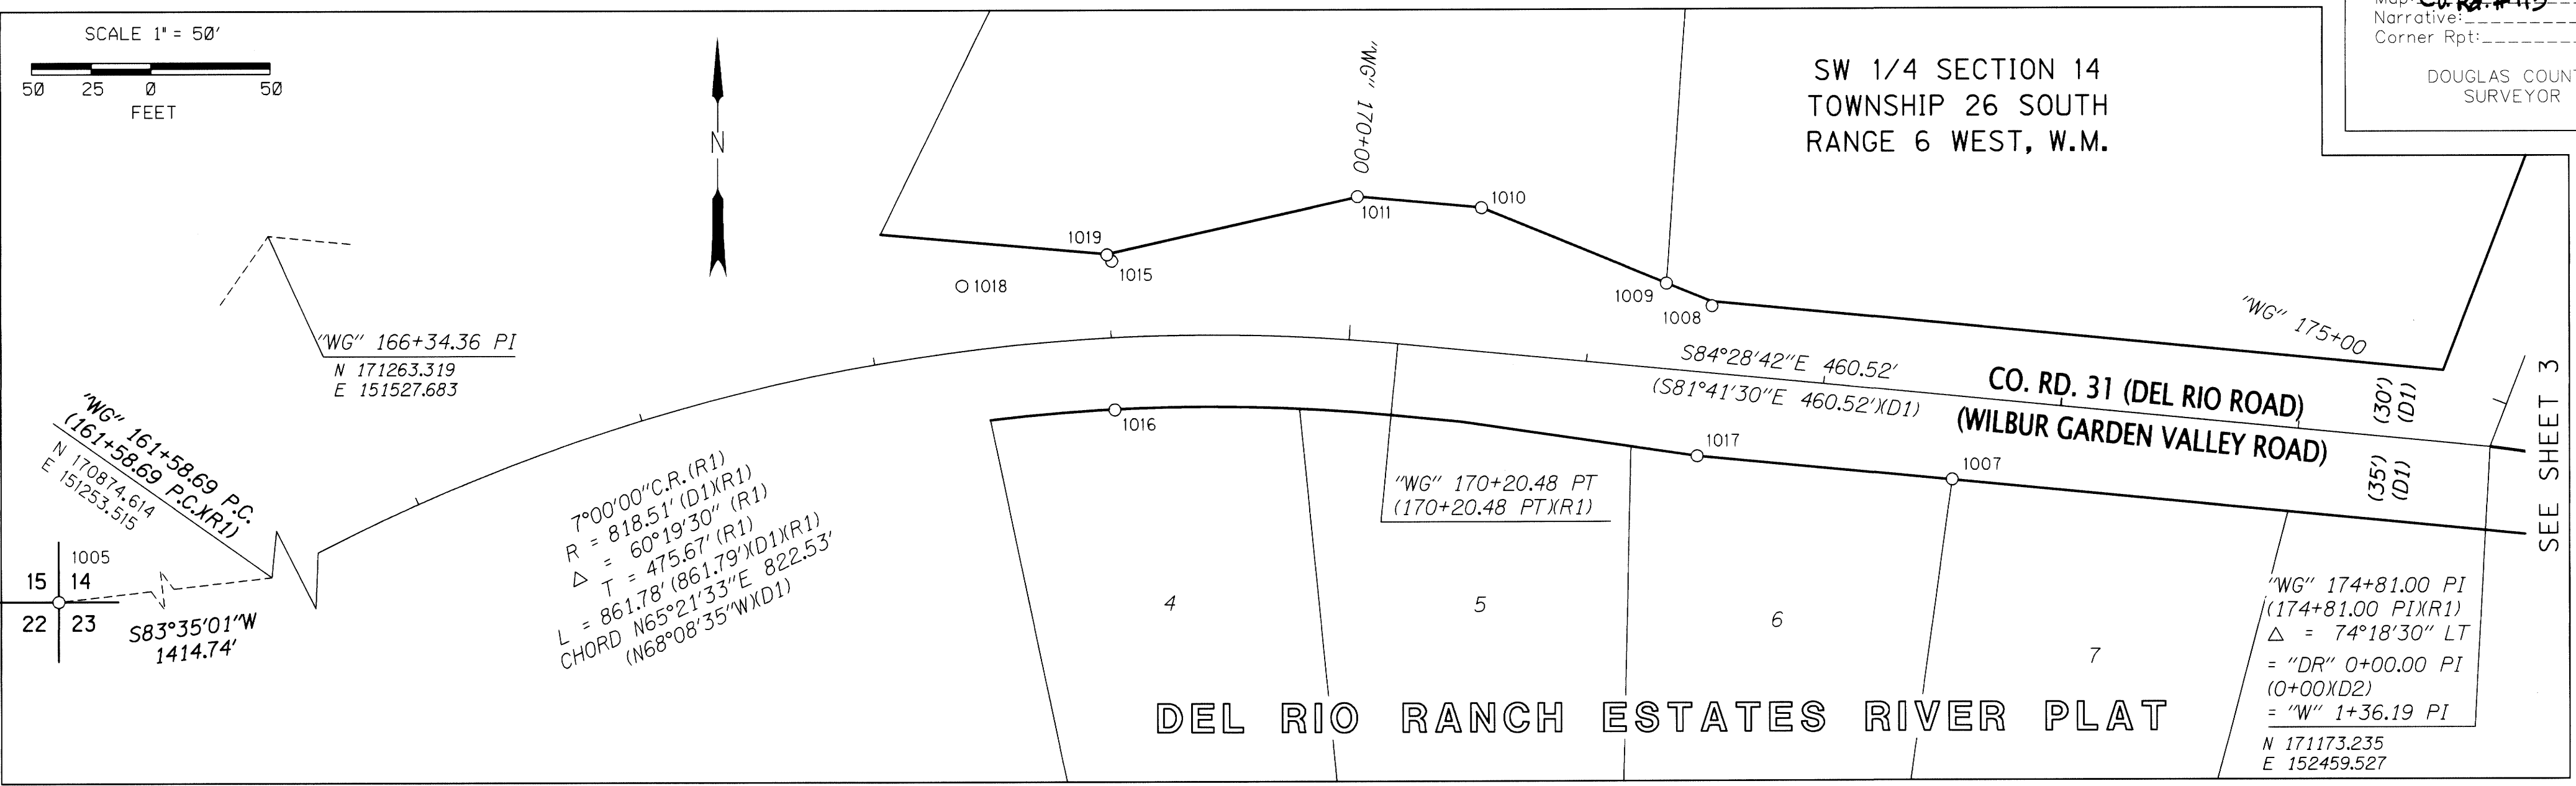




FILED
 Date: 1-5-2021 By: [Signature]
 This survey consists of:
 Map: Co. Rd. #115 5 pgs
 Narrative:
 Corner Rpt:
 DOUGLAS COUNTY SURVEYOR

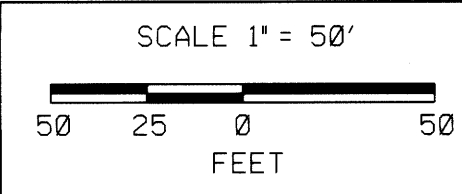

LEGEND

- FOUND MONUMENT NOTED IN TABLE
- RIGHT-OF-WAY
- PROPERTY LINE
- APPROXIMATE SECTION LINE
- (XX) RECORD DATA PER REFERENCE ON SHEET 2

BC = BRASS CAP
 COND = CONDITION
 DN = DOWN
 FD = FOUND
 IR = IRON ROD
 W/ = WITH
 OCRS = OREGON COORDINATE REFERENCE SYSTEM

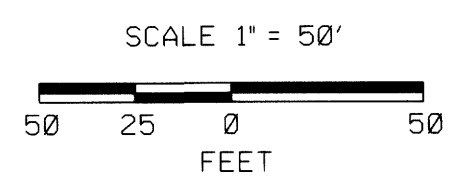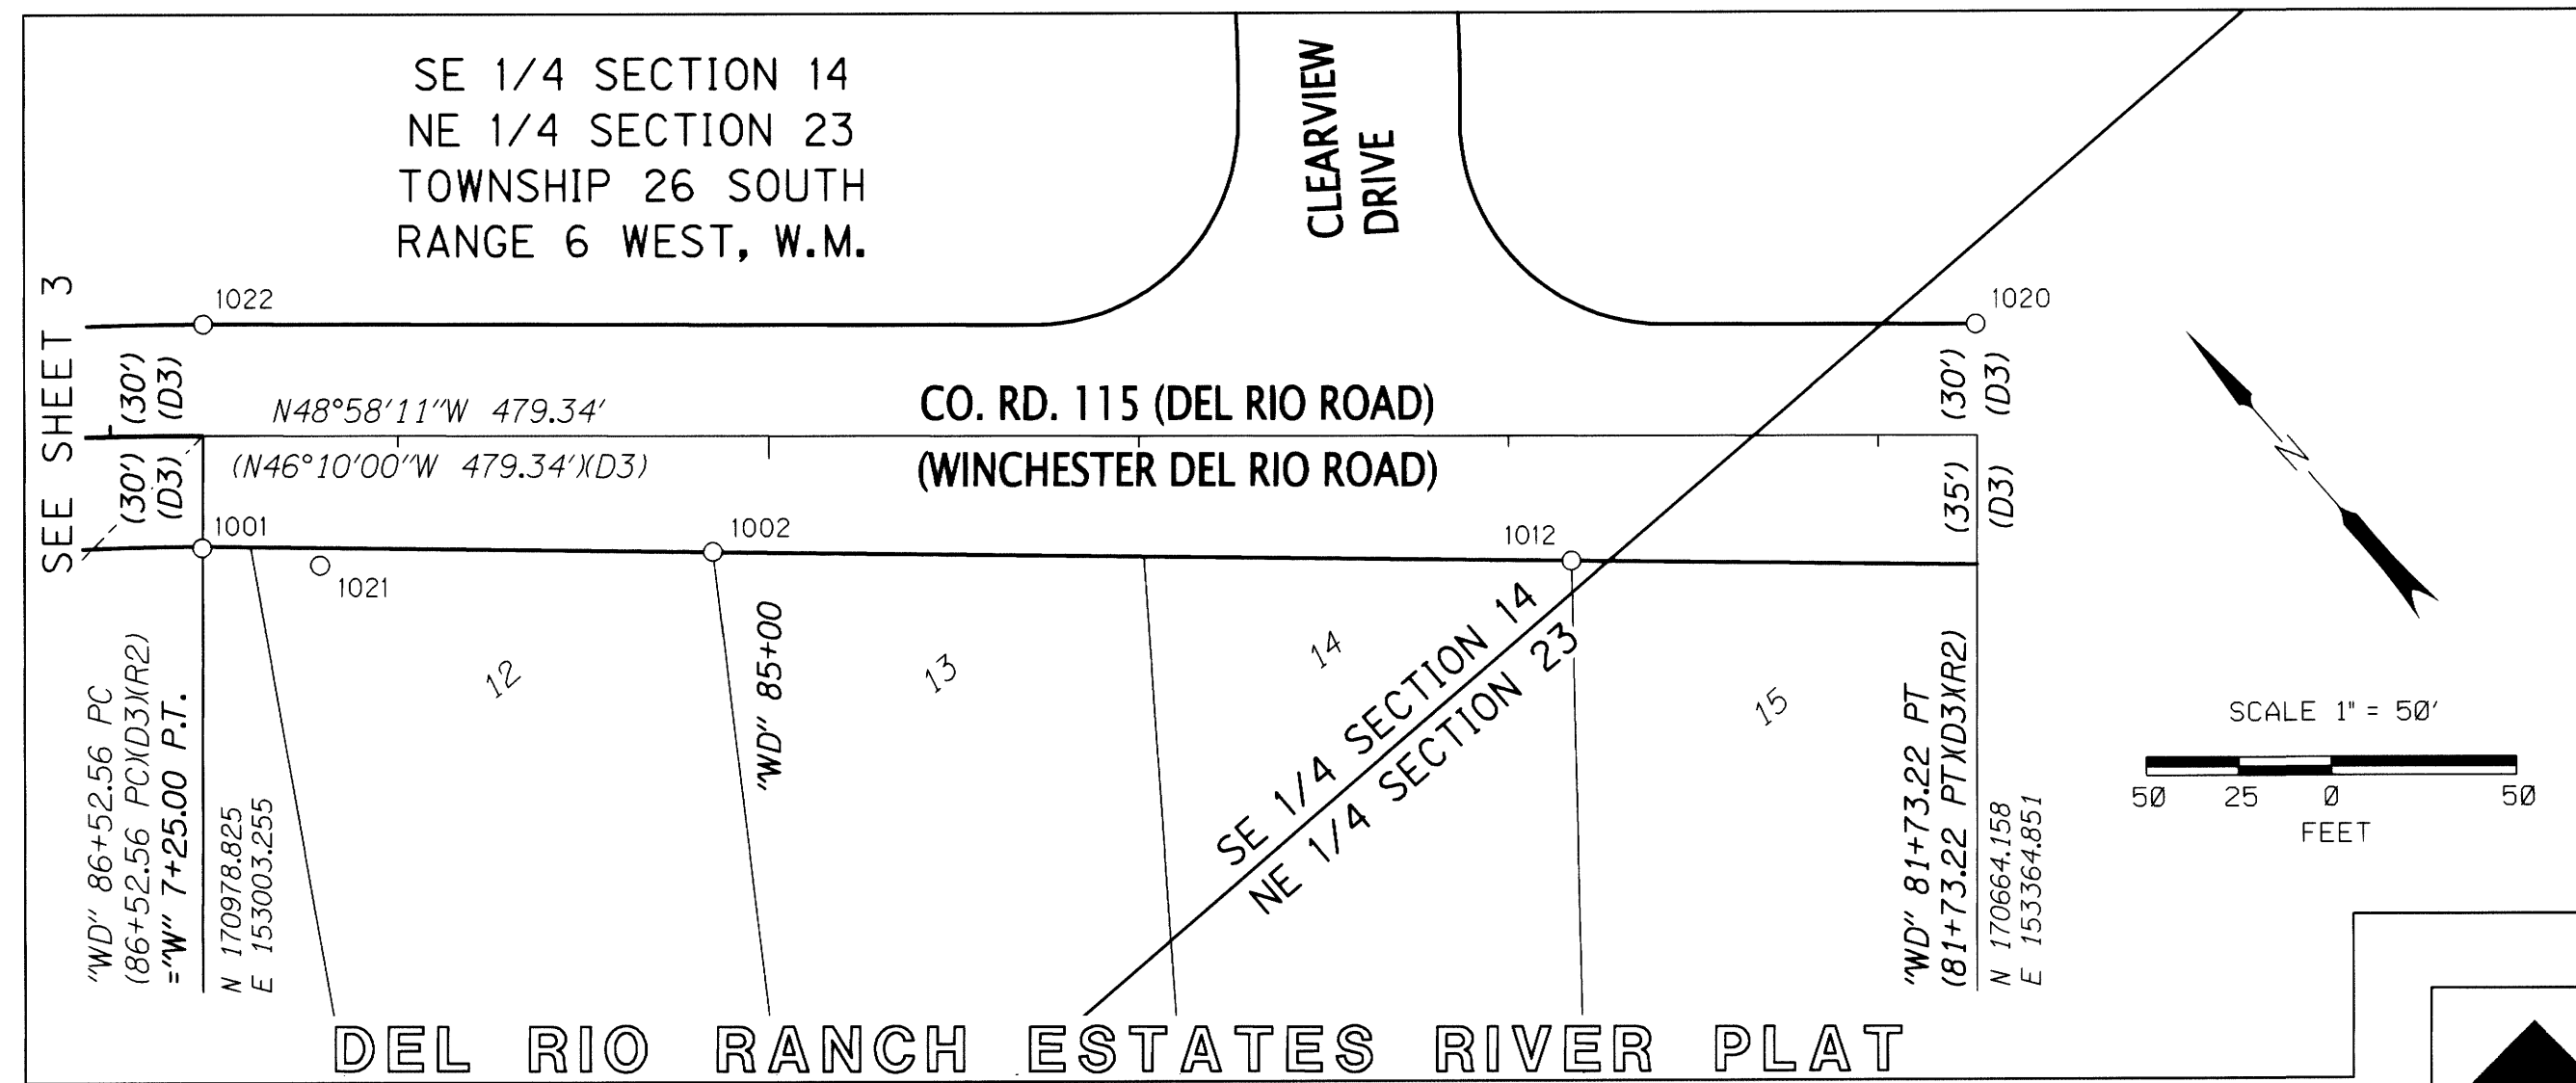

REGISTERED PROFESSIONAL LAND SURVEYOR
 [Signature]
 OREGON
 MAY 12, 2011
 ANDREW JOSEPH SILBERNAGEL
 #79198
 RENEWS: JUNE 30, 2022
 SIGNED: 12/23/2010

RECOVERED MONUMENT TABLE

PT ID	OCRS NORTHING	OCRS EASTING	STATION	OFFSET	DATE	DESCRIPTION & REFERENCE DOCUMENTS
1002	170864.97	153086.39	"WD" 85+15.10	31.31 LT	1/14/2020	FD 3/4" IR, GOOD COND, UP 0.2 FT, PER DEL RIO RANCH ESTATES RIVER PLAT (R3)
1005	170716.51	149847.64	N/A	N/A	1/14/2020	FD 2-1/2" BC "COUNTY SURVEYORS OFFICE T26 SR 6W S15 S14 S22 S23 1959", GOOD COND, UP 0.7 FT (R8)
1010	171274.36	152036.35	"WG" 170+50.06	59.94 LT	1/15/2020	FD 3/4" IR, GOOD COND, UP 0.3 FT, PER M-33-74 (R4)
1011	171279.13	151984.28	"WG" 169+99.32	59.97 LT	1/15/2020	FD 3/4" IR, BENT(TIED IN PLACE), UP 1.1 FT, PER M-33-74 (R4)
1012	170710.65	153259.86	"WD" 82+82.94	33.85 LT	1/15/2020	FD 3/4" IR, GOOD COND, UP 0.1 FT, PER DEL RIO RANCH ESTATES RIVER PLAT (R3)
1015	171252.39	151881.04	"WG" 169+01.80	32.05 LT	3/05/2020	FD 2-1/2" BC "DOUGLAS COUNTY SURVEYORS OFFICE NU6 1972 RMI 1981", GOOD COND, UP 0.3 FT (R10)
1016	171190.15	151882.33	"WG" 169+00.00	30.18 RT	3/05/2020	FD 3/4" IR, BENT(TIED SPIN POINT), UP 0.3 FT, PER COUNTY ROAD 31 PLAN AND PROFILE MAP (R1)
1018	171242.17	151818.30	"WG" 168+40.61	27.25 LT	3/06/2020	FD 2-1/2" BC "DOUGLAS COUNTY SURVEYORS OFFICE NU6 1972", GOOD COND, FLUSH IN ROCK (R10)
1019	171255.02	151879.09	"WG" 169+00.05	34.77 LT	3/06/2020	FD 3/4" IR, GOOD COND, DN 0.1 FT, PER COUNTY ROAD 31 PLAN AND PROFILE MAP (R1)
1020	170687.07	153384.29	"WD" 81+73.60	30.04 RT	3/06/2020	FD 3/4" IR, BENT (TIED SPIN POINT) POOR COND, DN 0.5 FT, PER COUNTY ROAD 115 PLAN AND PROFILE MAP (R2)

SEE MONUMENT TABLE ON SHEET 3 FOR MONUMENTS 1007, 1008, 1009, AND 1017.

FILE NAME: S_K21296_crr_01_Site 13.dgn

DOWL
 920 COUNTRY CLUB ROAD, SUITE 100B
 EUGENE, OREGON 97401
 541-683-6090

OREGON DEPARTMENT OF TRANSPORTATION
 HORIZONTAL CONTROL,
 RECOVERY AND RETRACEMENT SURVEY
 SOUTHERN OREGON SEISMIC BRIDGE RETROFIT
 (PHASE 2) PROJECT
 SUTHERLIN CREEK SITE
 ODOT REGION 3 DOUGLAS COUNTY DECEMBER 2020
 3500 NW STEWART PARKWAY 1" = 50'
 ROSEBURG, OR 97470 KEY NO. 22290 SHEET 4 OF 5

DESIGNED: R. BEAUDUY PROJ. NO. 0019-0593
 DRAWN: SMG CHK'D: J. COLTON

01660160