


PLAN
 SURVEYED
 PLOTTED
 CHECKED
 BY
 DATE

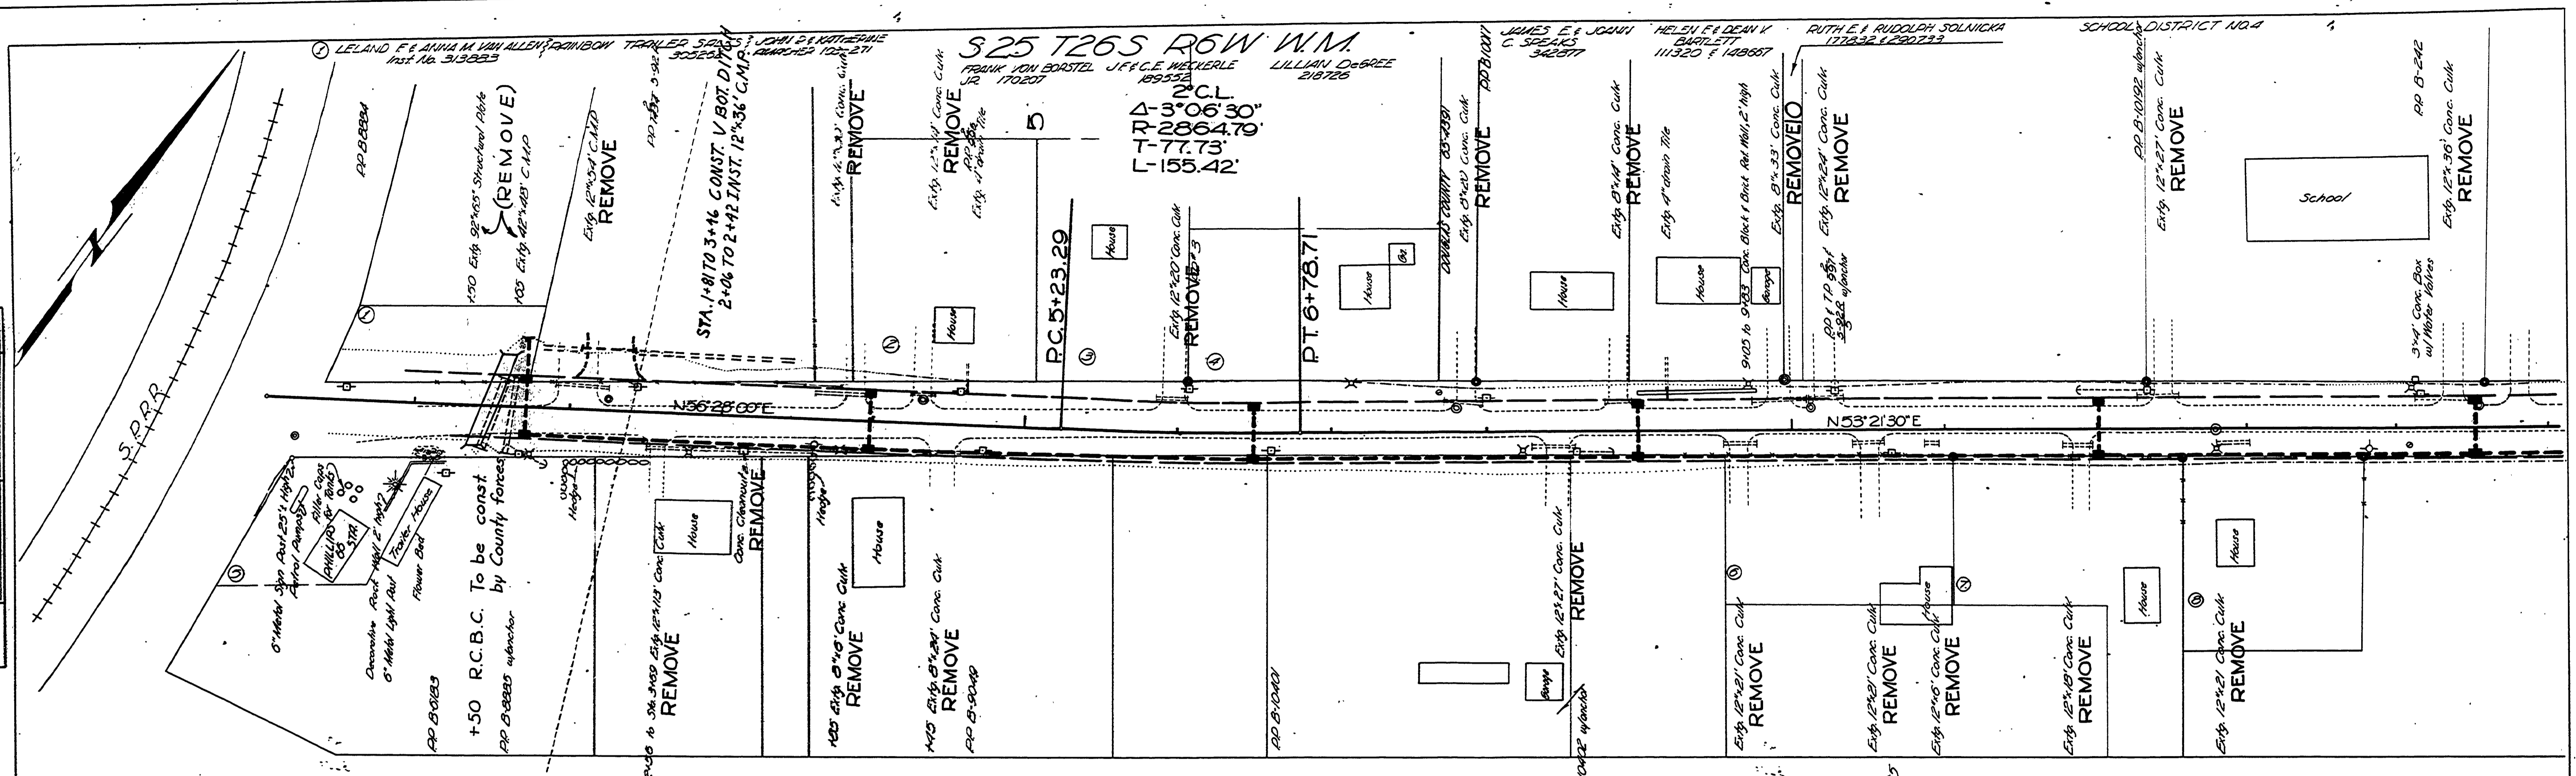

Loose to: TIDENWATER OIL CO 265541
 Assigned to PHILLIPS PETROLEUM CO. 65-8283

CHARLES W. HELEN B. McDERMOTT Inst. No. 255532

ROLAND E. & BEATRICE GREENE WATER CO. CO. L. THUNDERBOLT Inst. No. 65-6223 350857

ARTHUR E. & WINNIFRED & TRAVIS 176985

EDGAR A. MILLER 271365 & 271368

JACOB L. & LAURIE A. BROWN 335220 & 65-10300


LEONARD & FOSTER 161.98 P.325 & 161.97

LEONARD & MARTHA & FOSTER 161.103 P.325 & 161.180

GEORGE & ELADIS McCARTY 87252

L. & H. LUMBER CO. 333569

PROFILE
 DATE

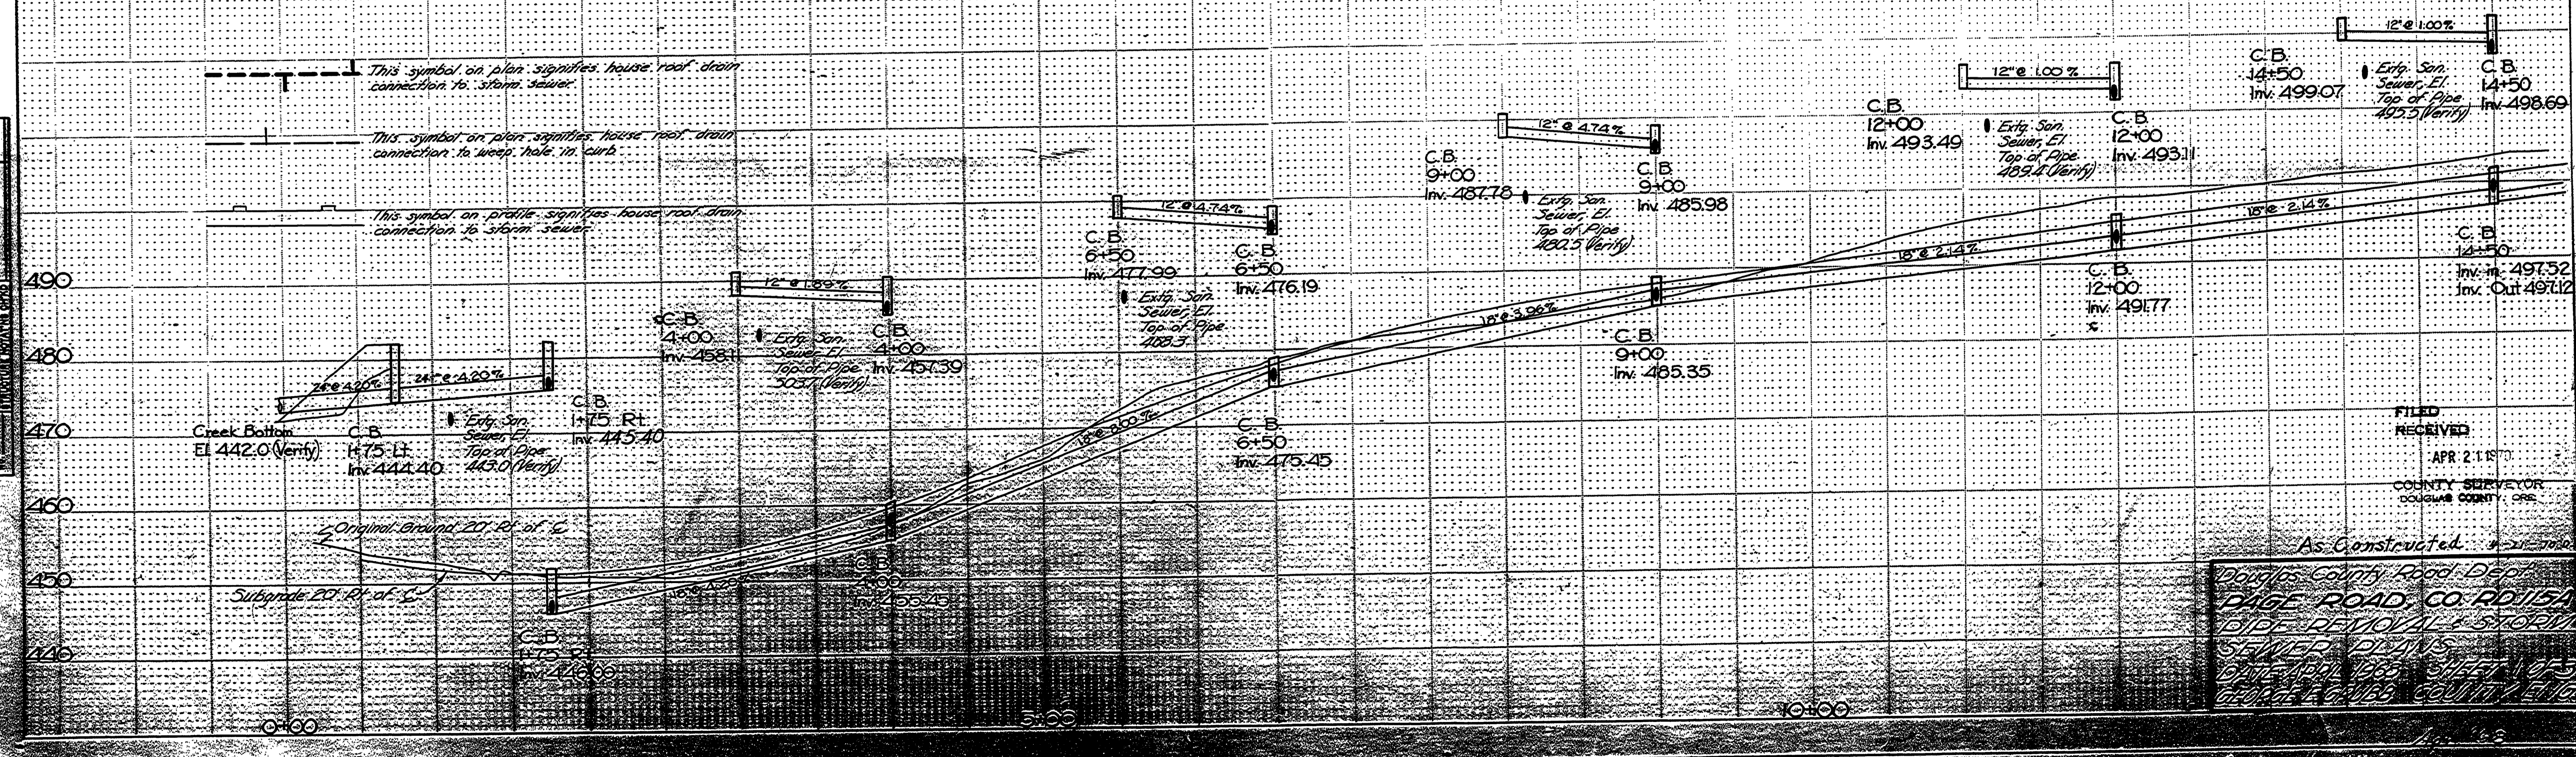

FILED
 RECEIVED
 APR 2 1985
 COUNTY SURVEYOR
 DOUGLAS COUNTY, ORG.

As Constructed

Douglas County Road Dept.
 PAGE ROAD CO. RD115A
 PIPE REMOVAL & STORM
 SEWER PLANS
 DATE APR 1985 SHEET 025
 GEORGE E. GIBBS COUNTY ENG.

00000029