
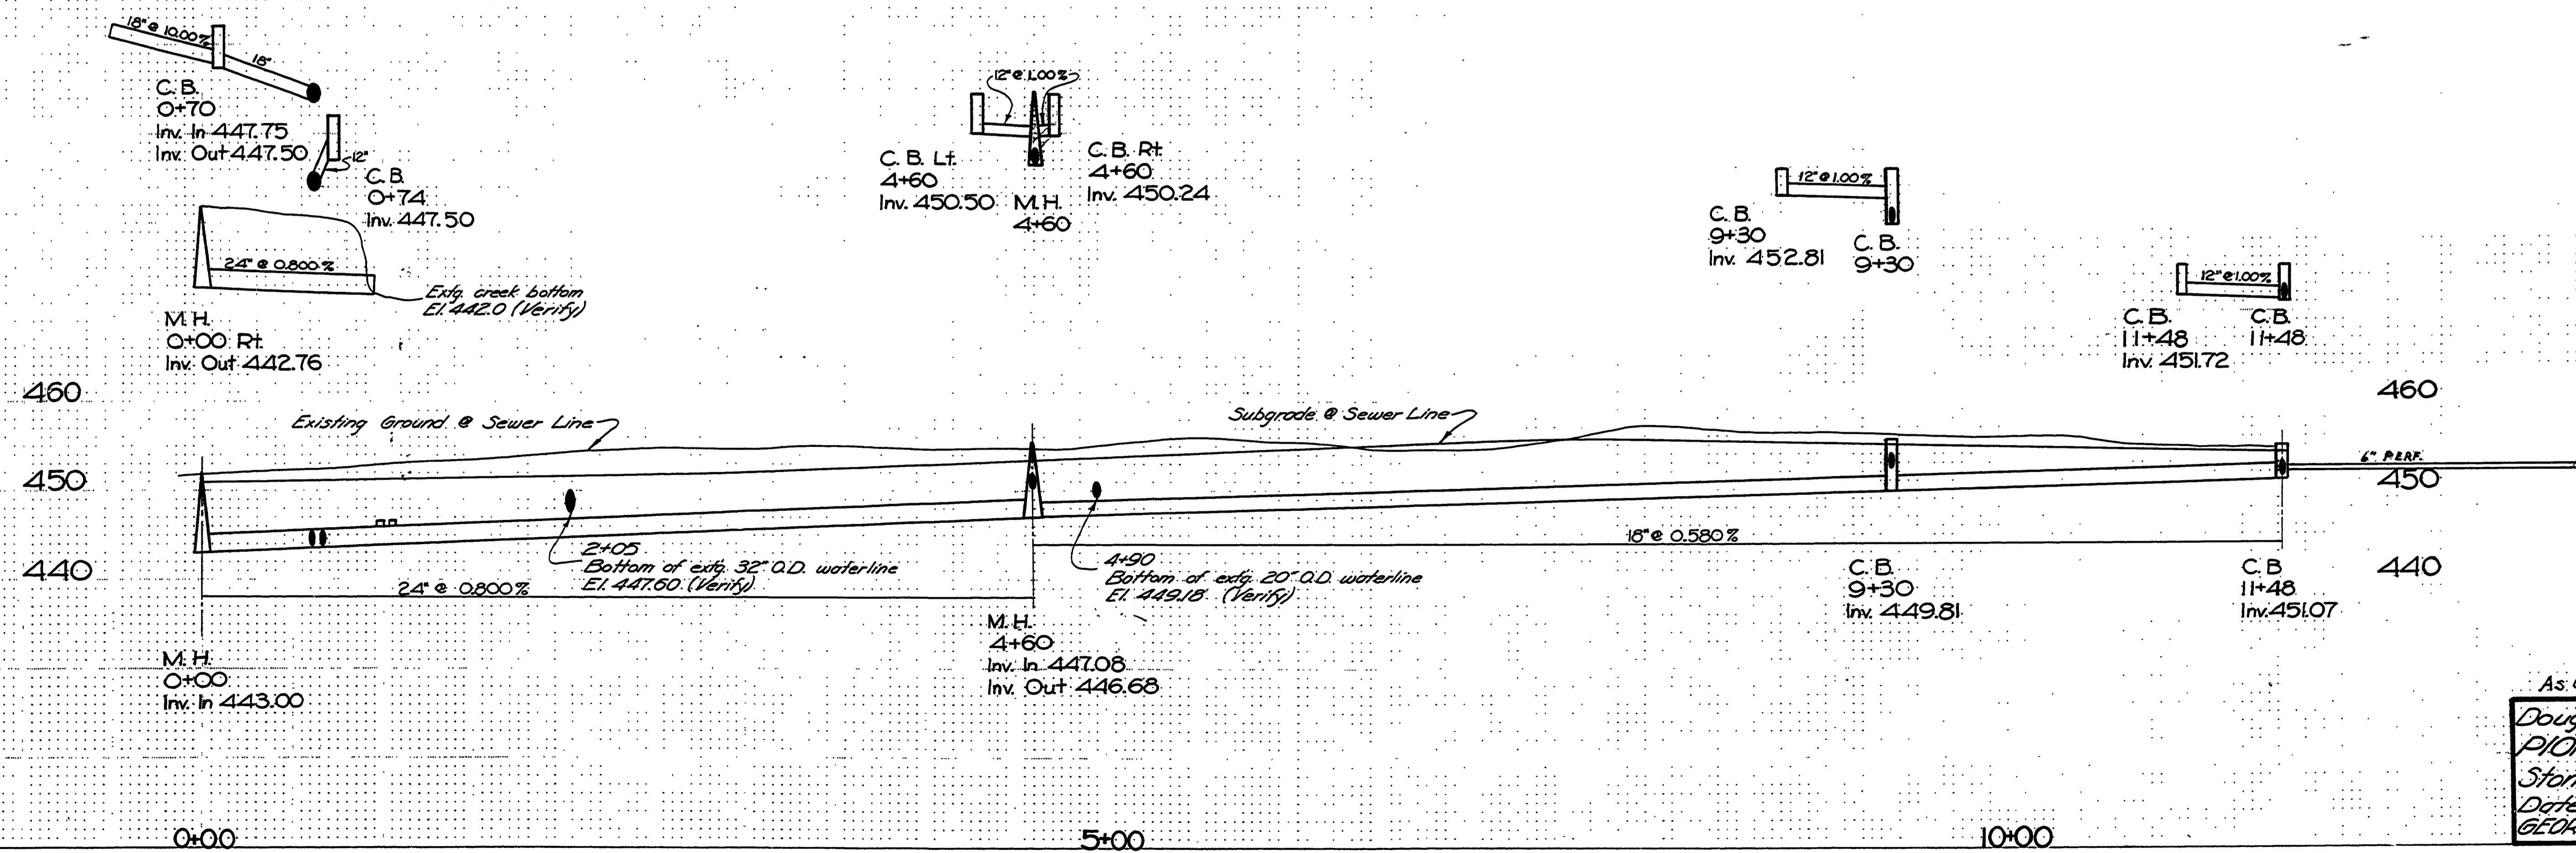


PLAN	DATE
SURVEYED	BY
GRADES CHECKED	ALIGNED
NOTE BOOK	RT. OF WAY CHECKED
No.	

PROFILE	DATE
SURVEYED	BY
GRADES CHECKED	ALIGNED
NOTE BOOK	RT. OF WAY CHECKED
No.	

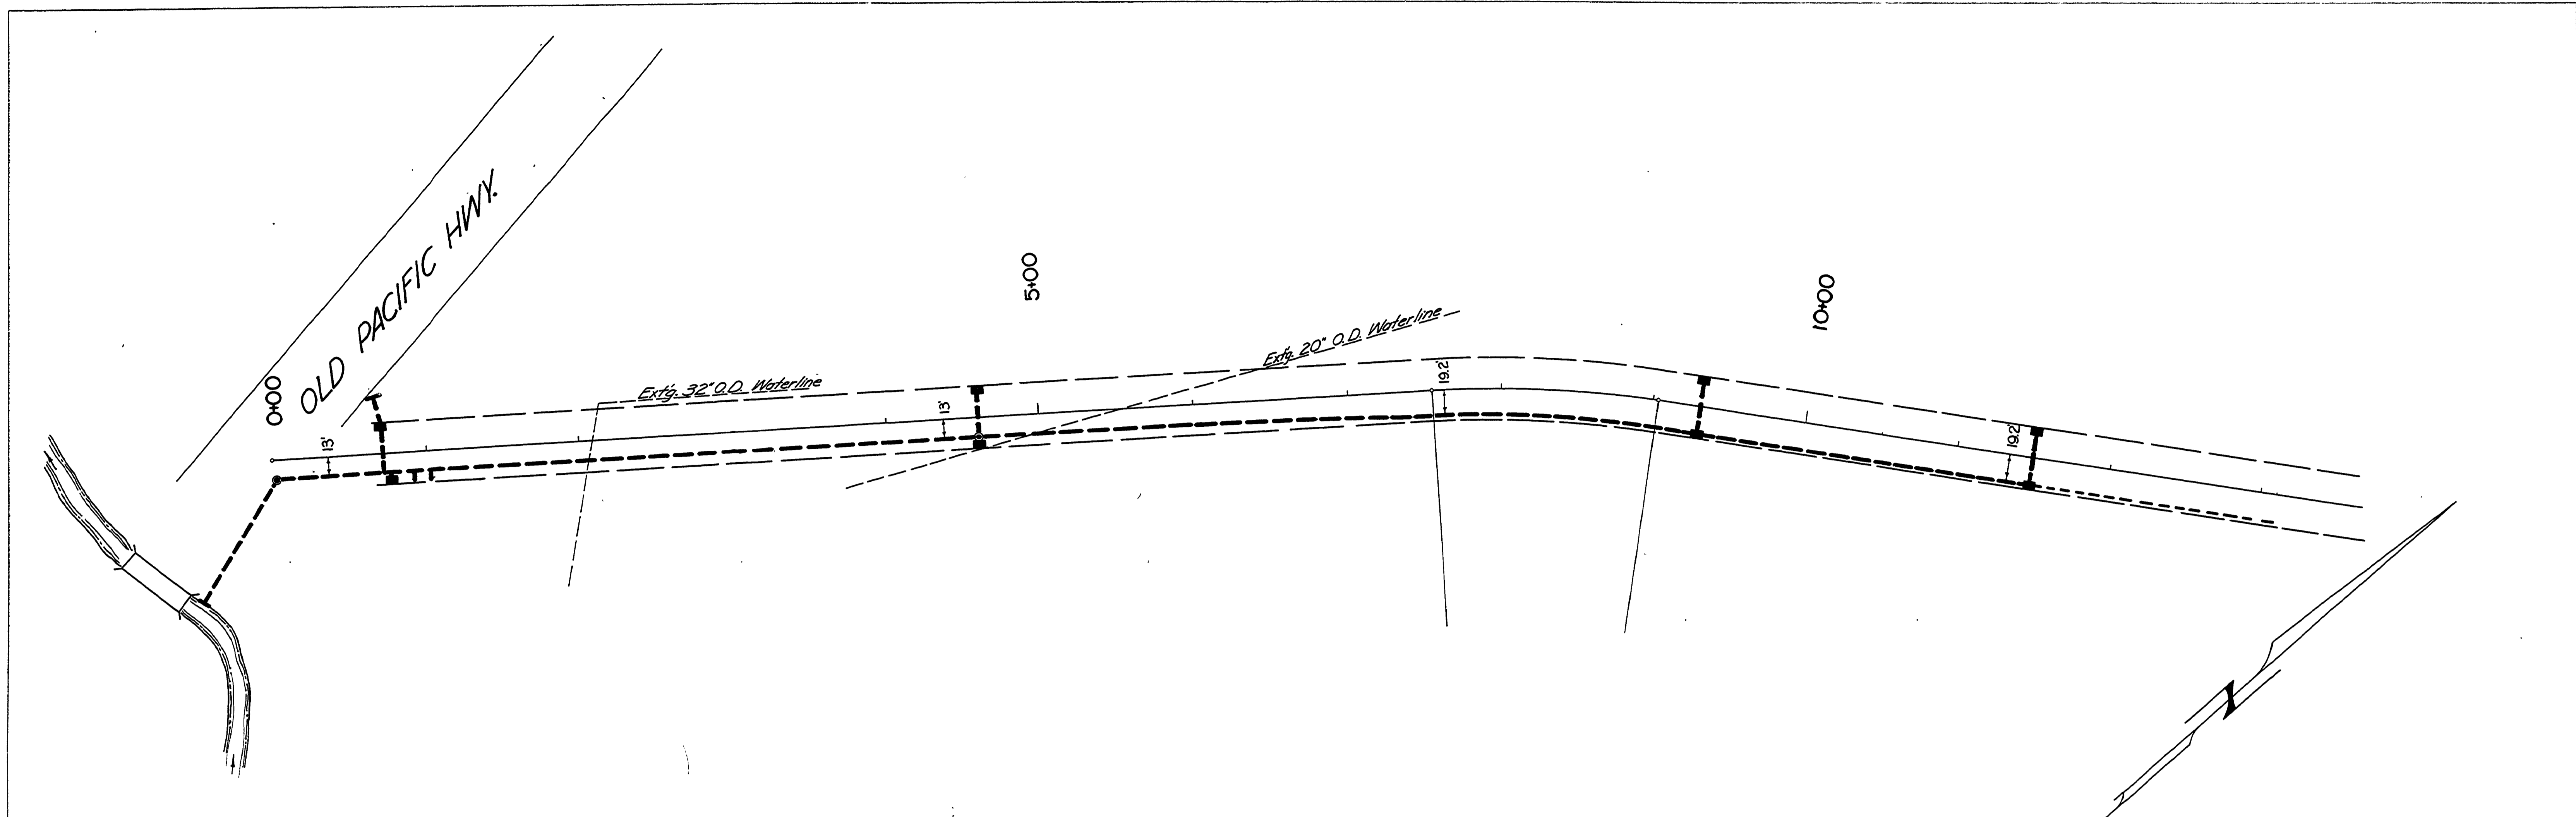

As Constructed
 Douglas County Road Dept.
PIONEER WAY RD. 115B
 Storm Sewer Plans
 Date: APRIL 1968 Sheet 1 of 1
 GEORGE E. GRUBB County Engineer

00000025