




DOUGLAS COUNTY OREGON

PLANS FOR PROPOSED PROJECT

AS CONSTRUCTED

SOUTH SIDE ROAD

COUNTY ROAD NO. 120

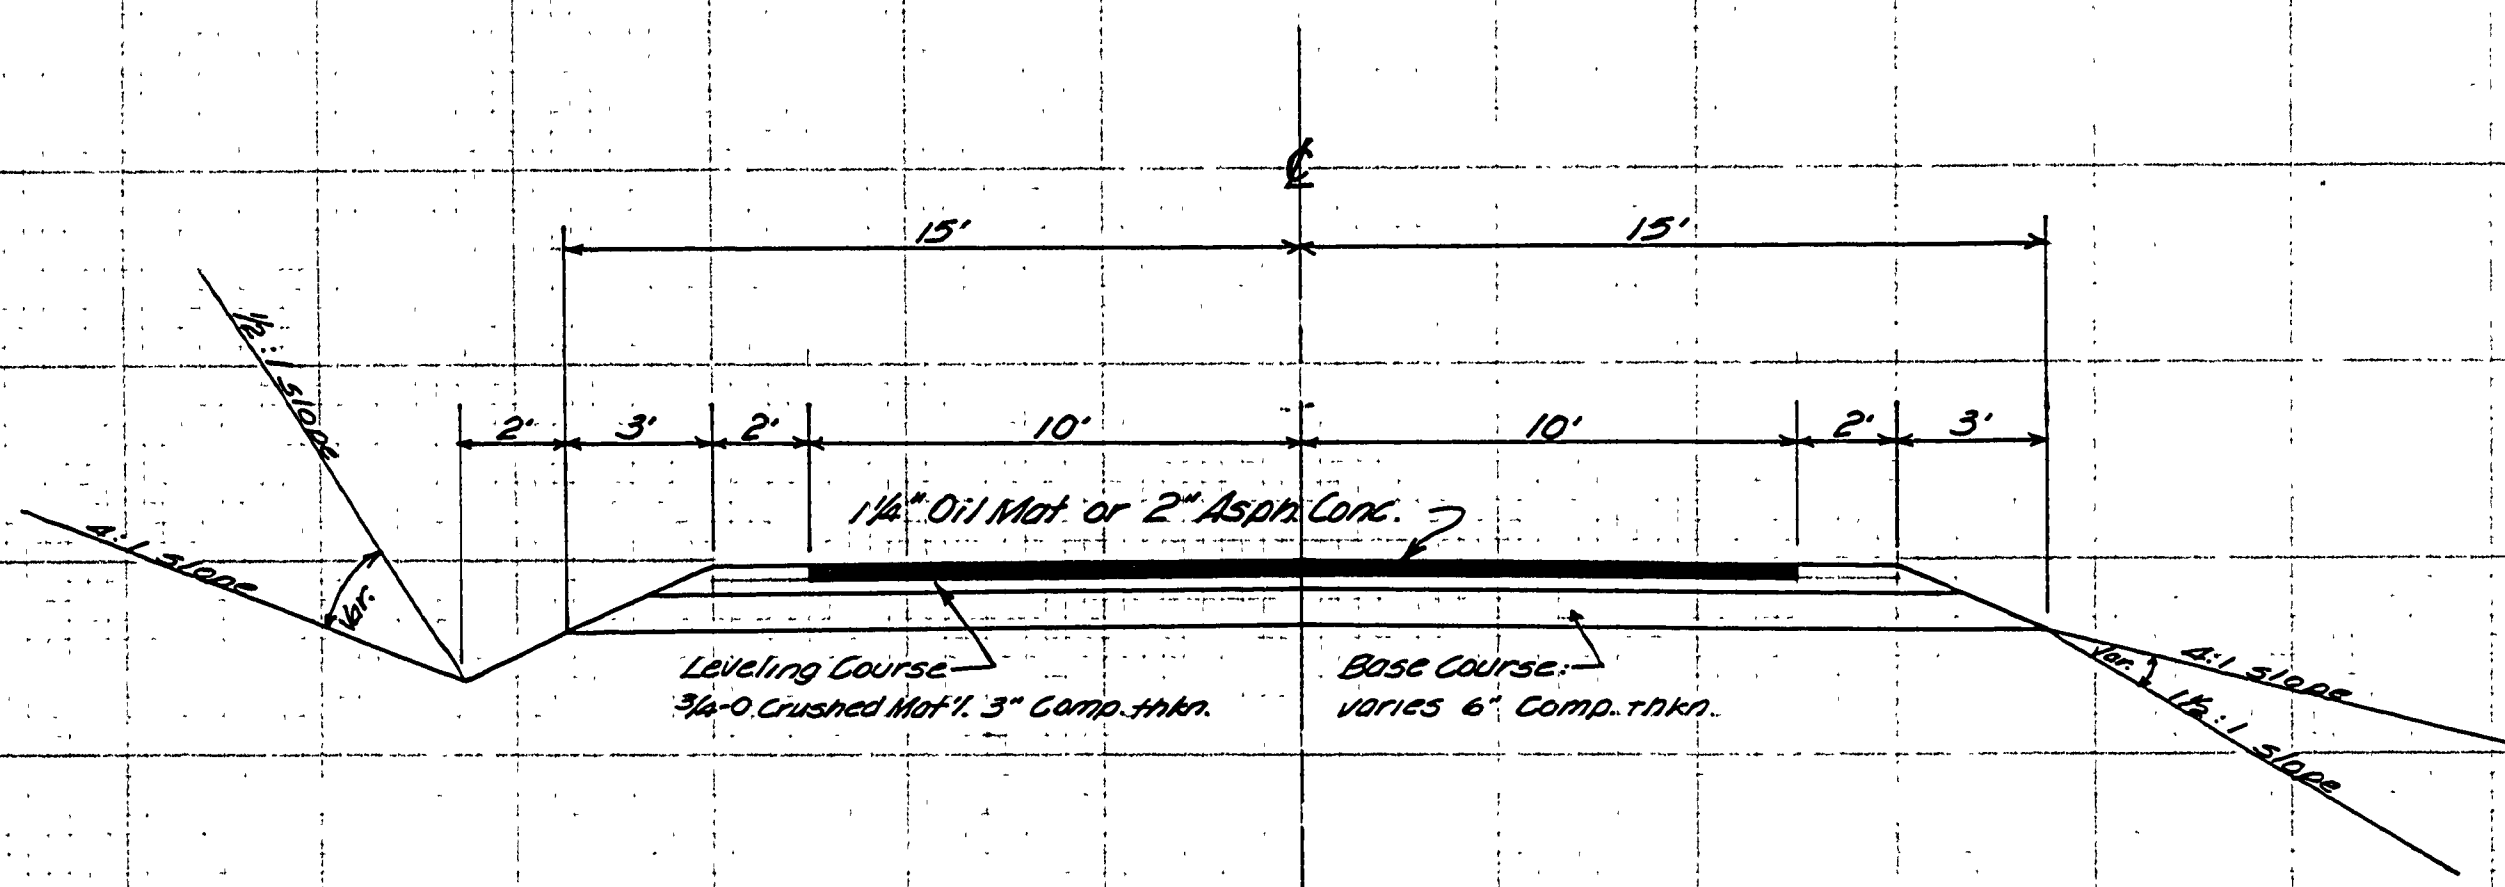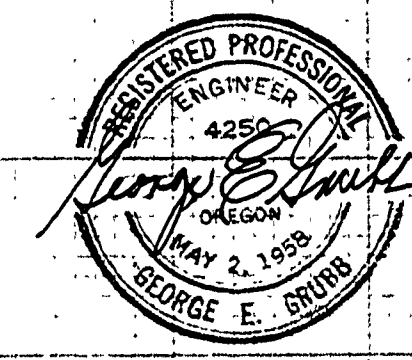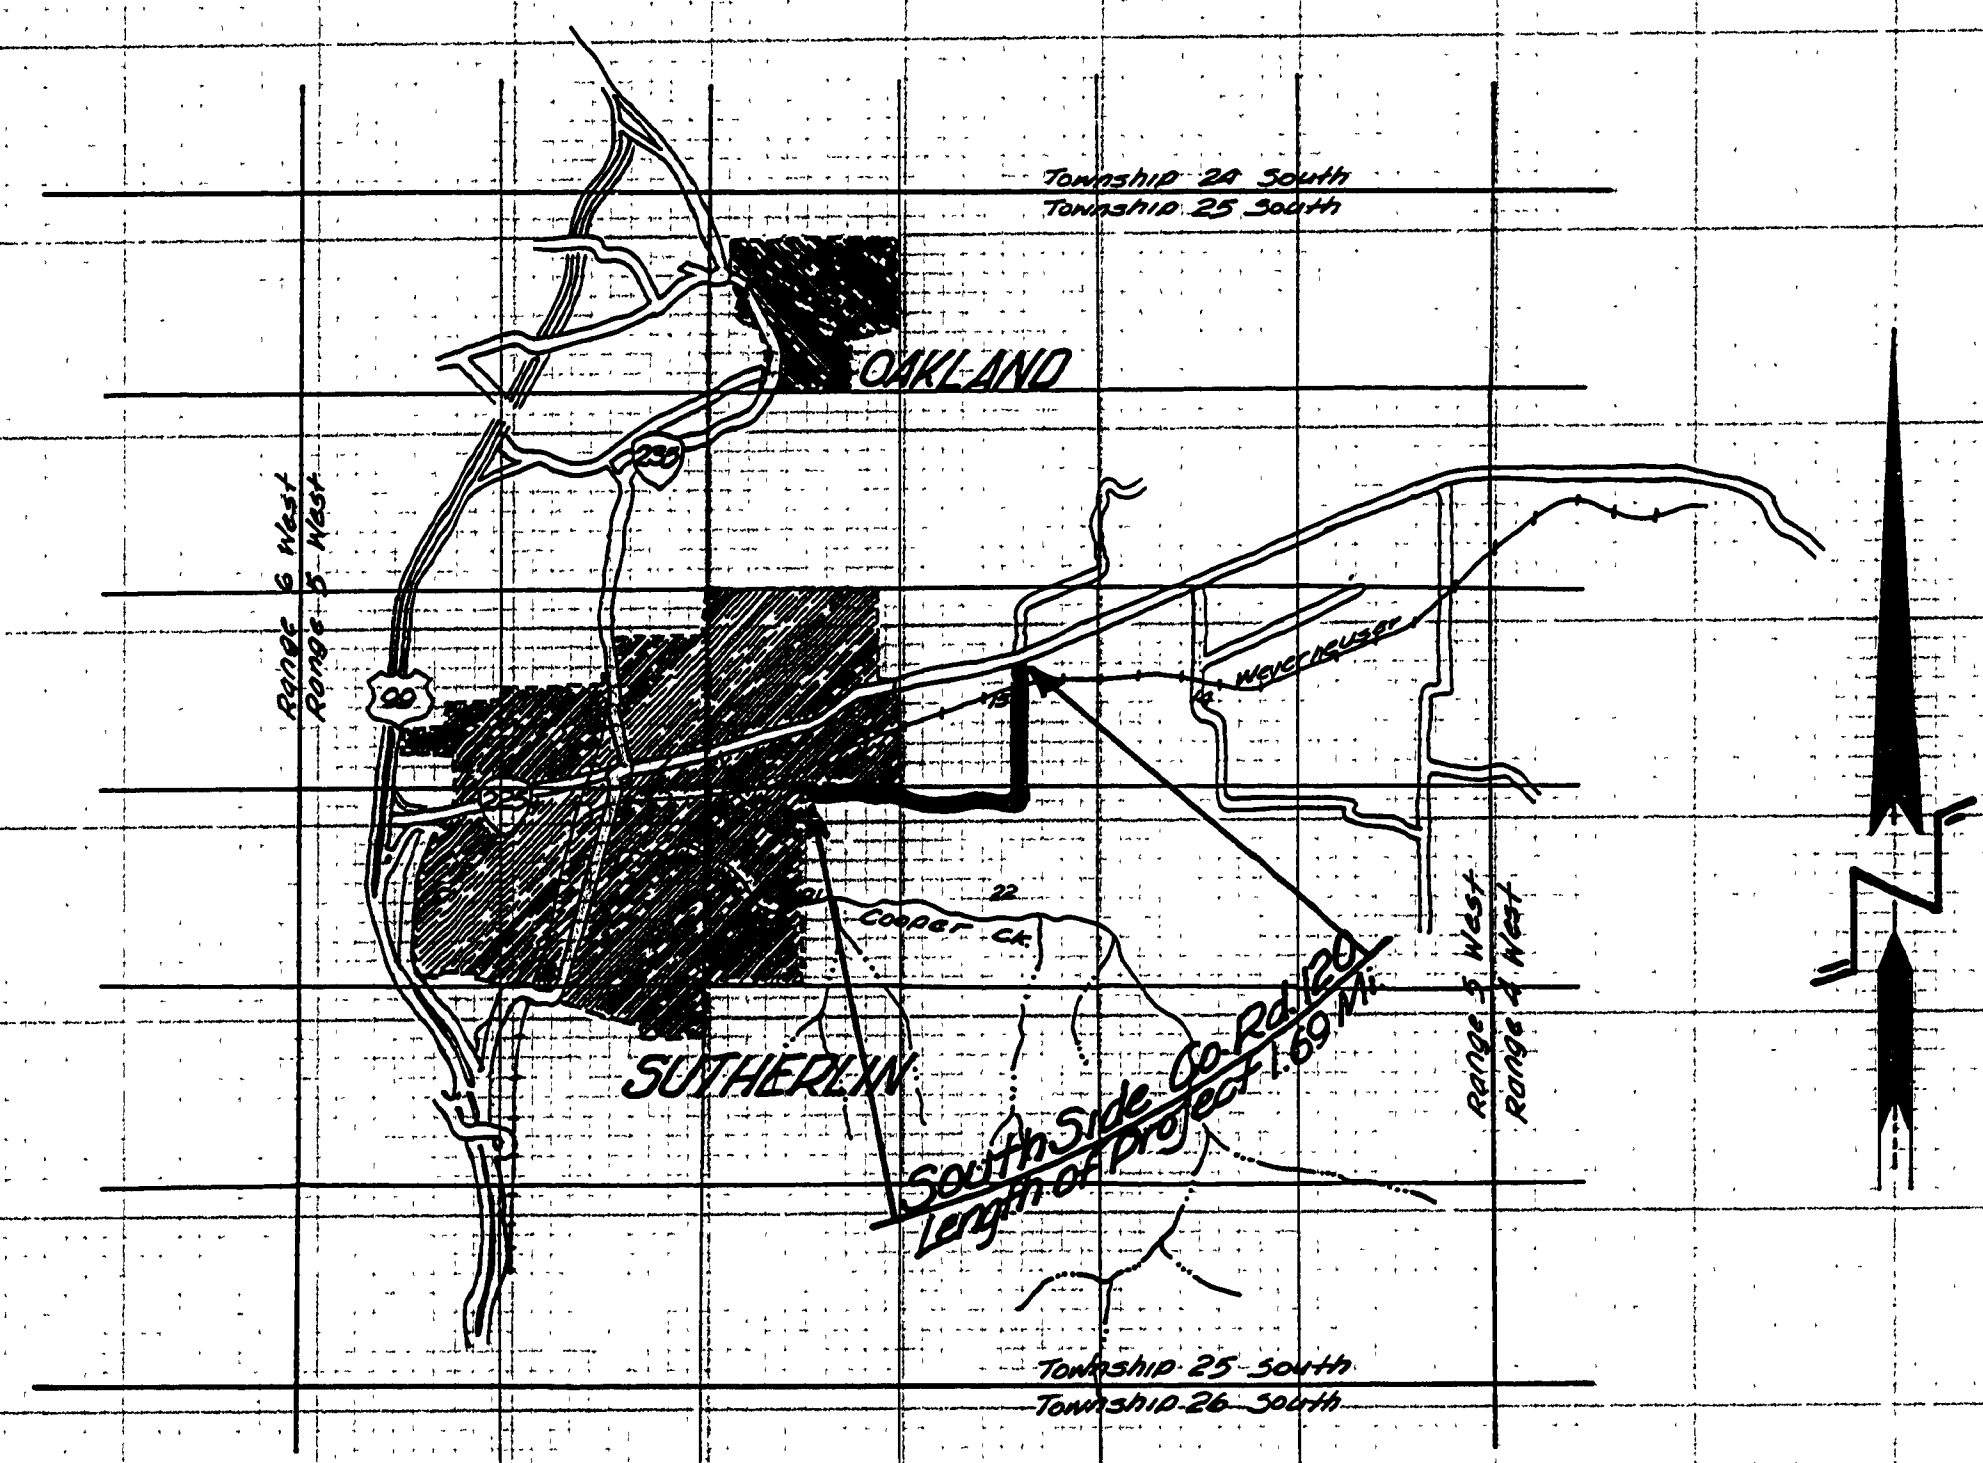

Approved by *George E. Smith* Nov. 24, 1964
 P.E. ENGINEER

Adopted by Resolution of the County
 Court this 13 day of June, 1962

V. T. Jackson
 JUDGE
E. H. Jackson
 COMM.
R. J. Jackson
 COMM.

FILED
 RECEIVED
 FEB 15 1963
 COUNTY SURVEYOR
 DOUGLAS COUNTY, ORE.

FILED
 RECEIVED
 FEB 15 1963
 COUNTY SURVEYOR
 DOUGLAS COUNTY, ORE.

4/9/62
 Co. Rd. #120
 Sta. 10+5

100850250