


DOUGLAS COUNTY, OREGON  
 PLANS FOR PROPOSED PROJECT  
 GRADING & SURFACING  
**GLENGARY LOOP NO. 121**  
**1975**  
 MILE POINT 0.00 TO MILE POINT 2.35

FILED  
 RECEIVED  
 AUG 1 1975  
 COUNTY SURVEYOR  
 DOUGLAS COUNTY, ORE.

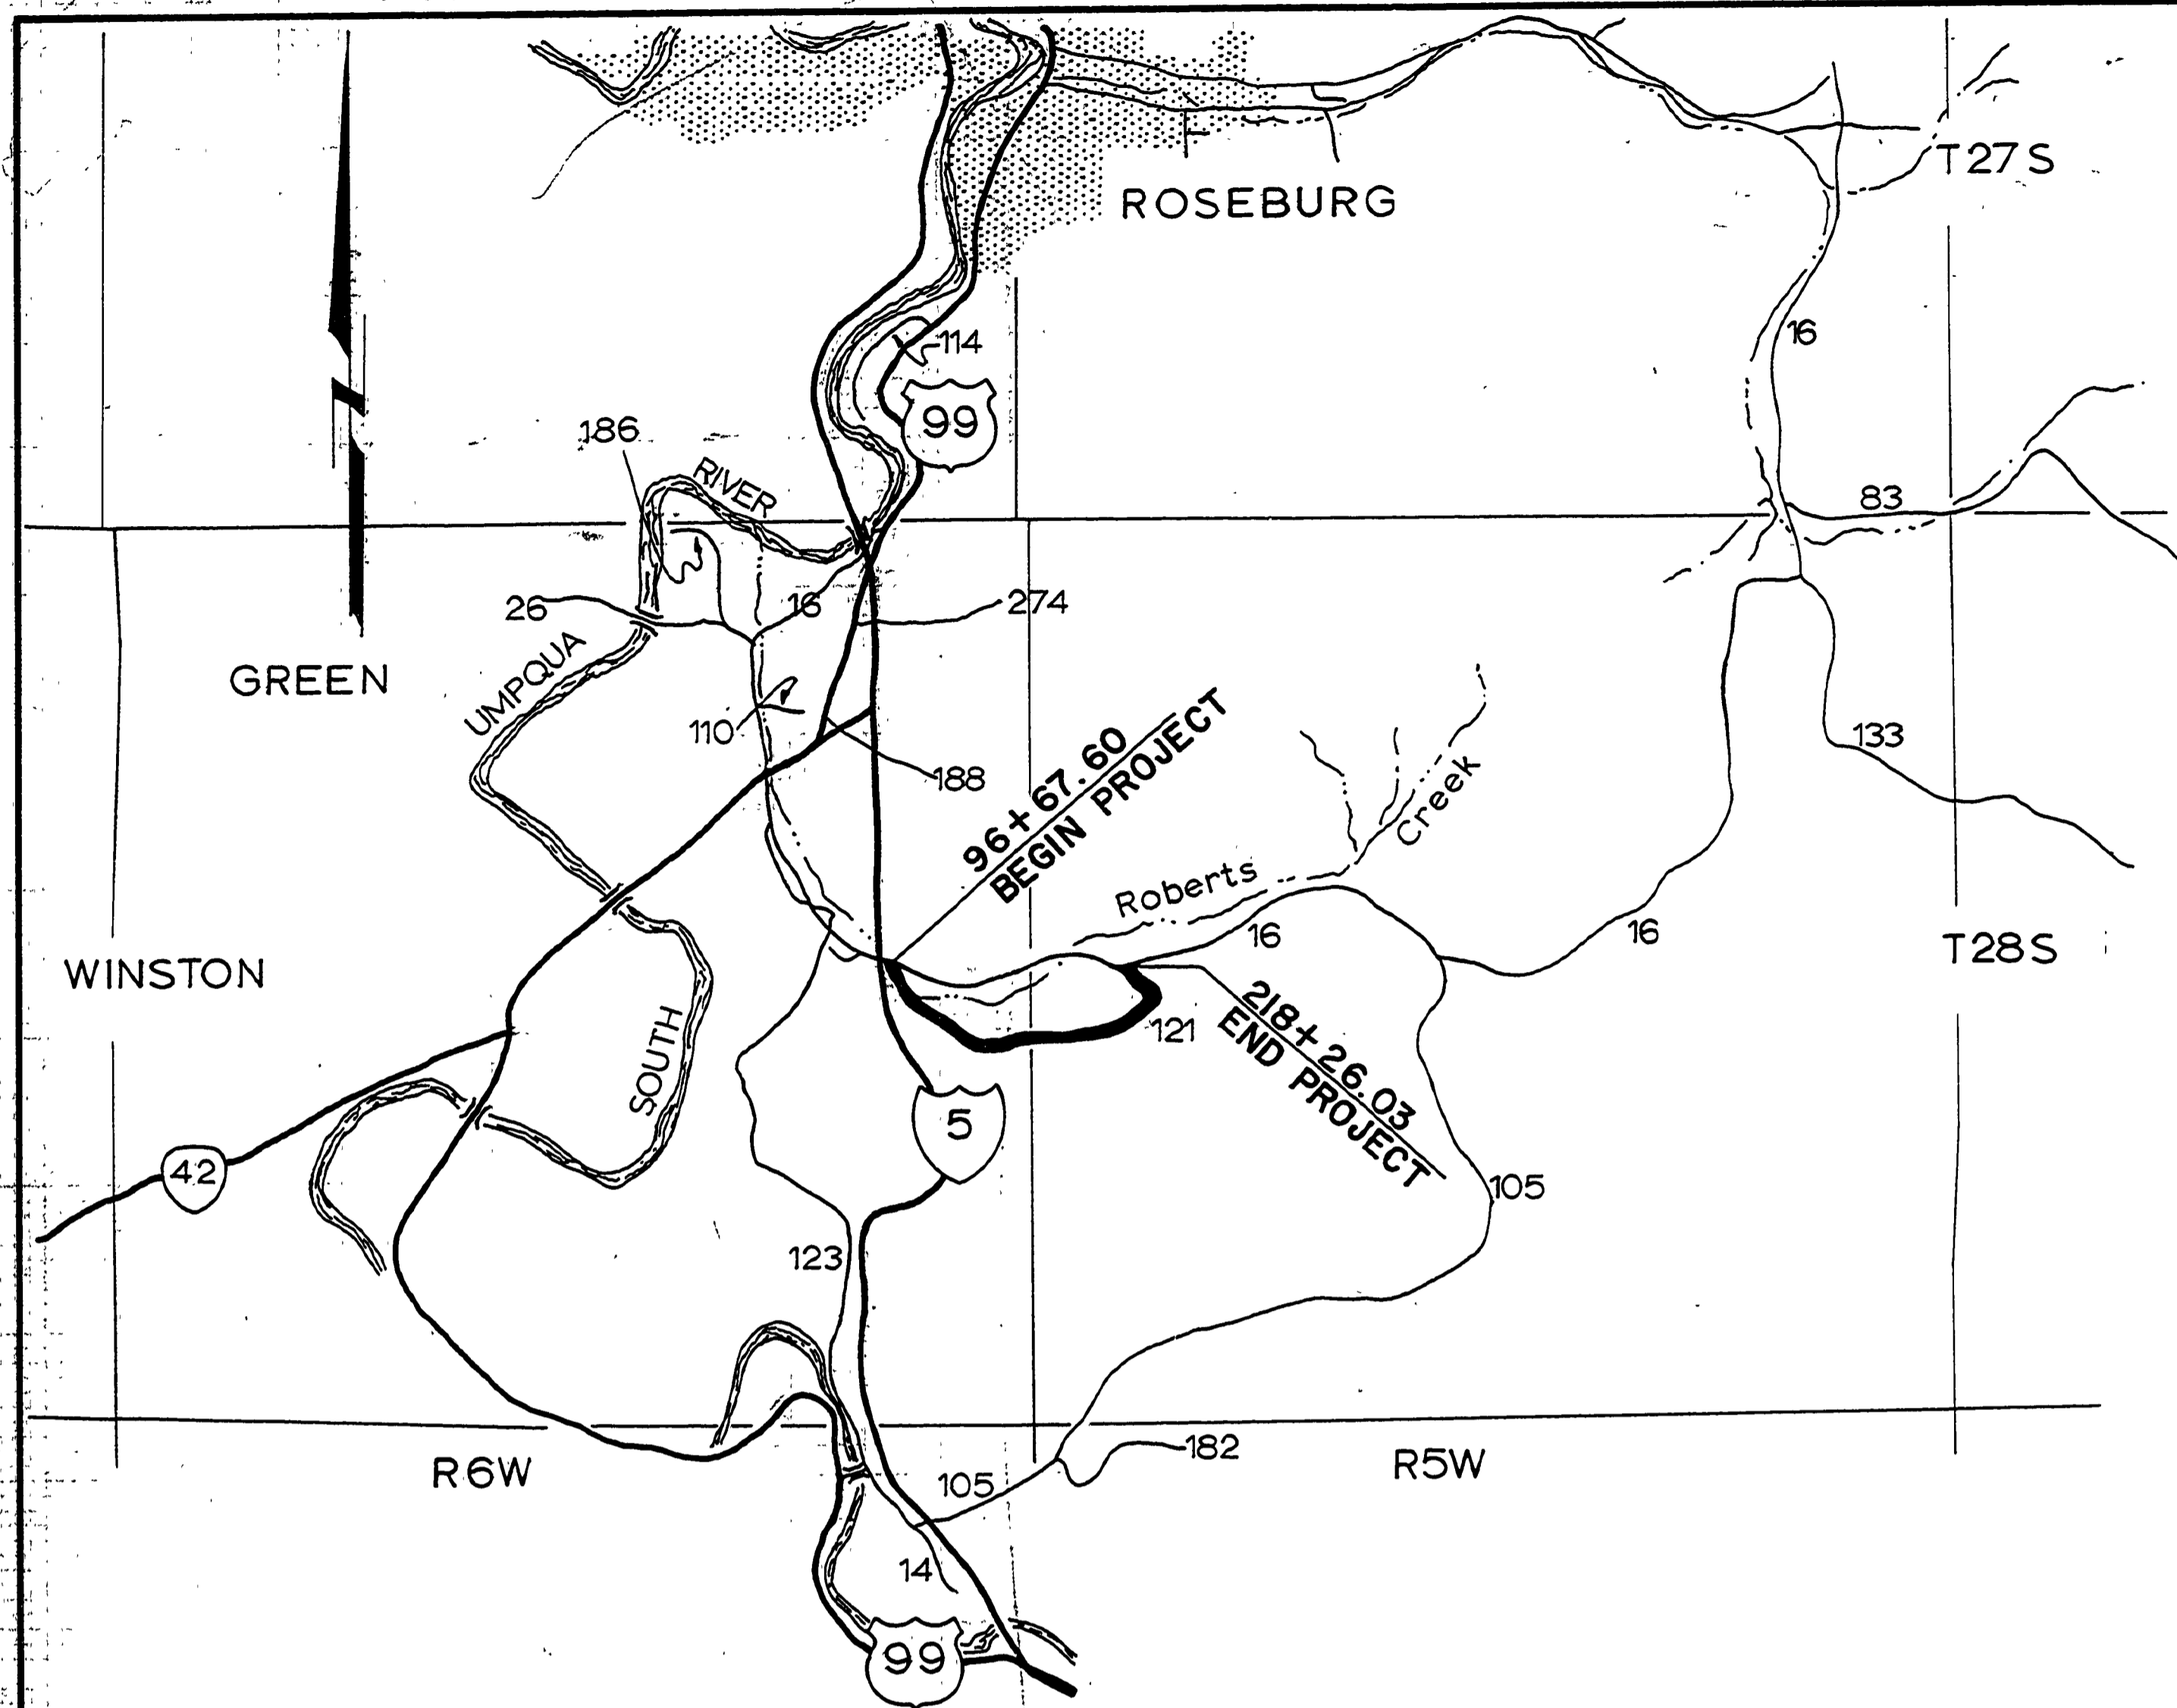

INDEX OF DRAWINGS

- 1 - COVER SHEET
- 2 - QUANTITY SUMMARY
- 3 - TYPICAL SECTIONS
- 4-8 - ROAD PLANS
- STANDARD DRAWINGS

AS BUILT 10-30-78 T.V.  
 DOUGLAS COUNTY  
 PUBLIC WORKS DEPARTMENT  
 GLENGARY LOOP ROAD 121  
 1975 SHT. 1  
 GEORGE F. GRUBB, DIRECTOR

G. R. # 121  
 1975  
 SHEET 1 OF 2

100000280