




FILED
 RECEIVED
 AUG 1 1979
 COUNTY SURVEYOR
 COULDS COUNTY, ORE

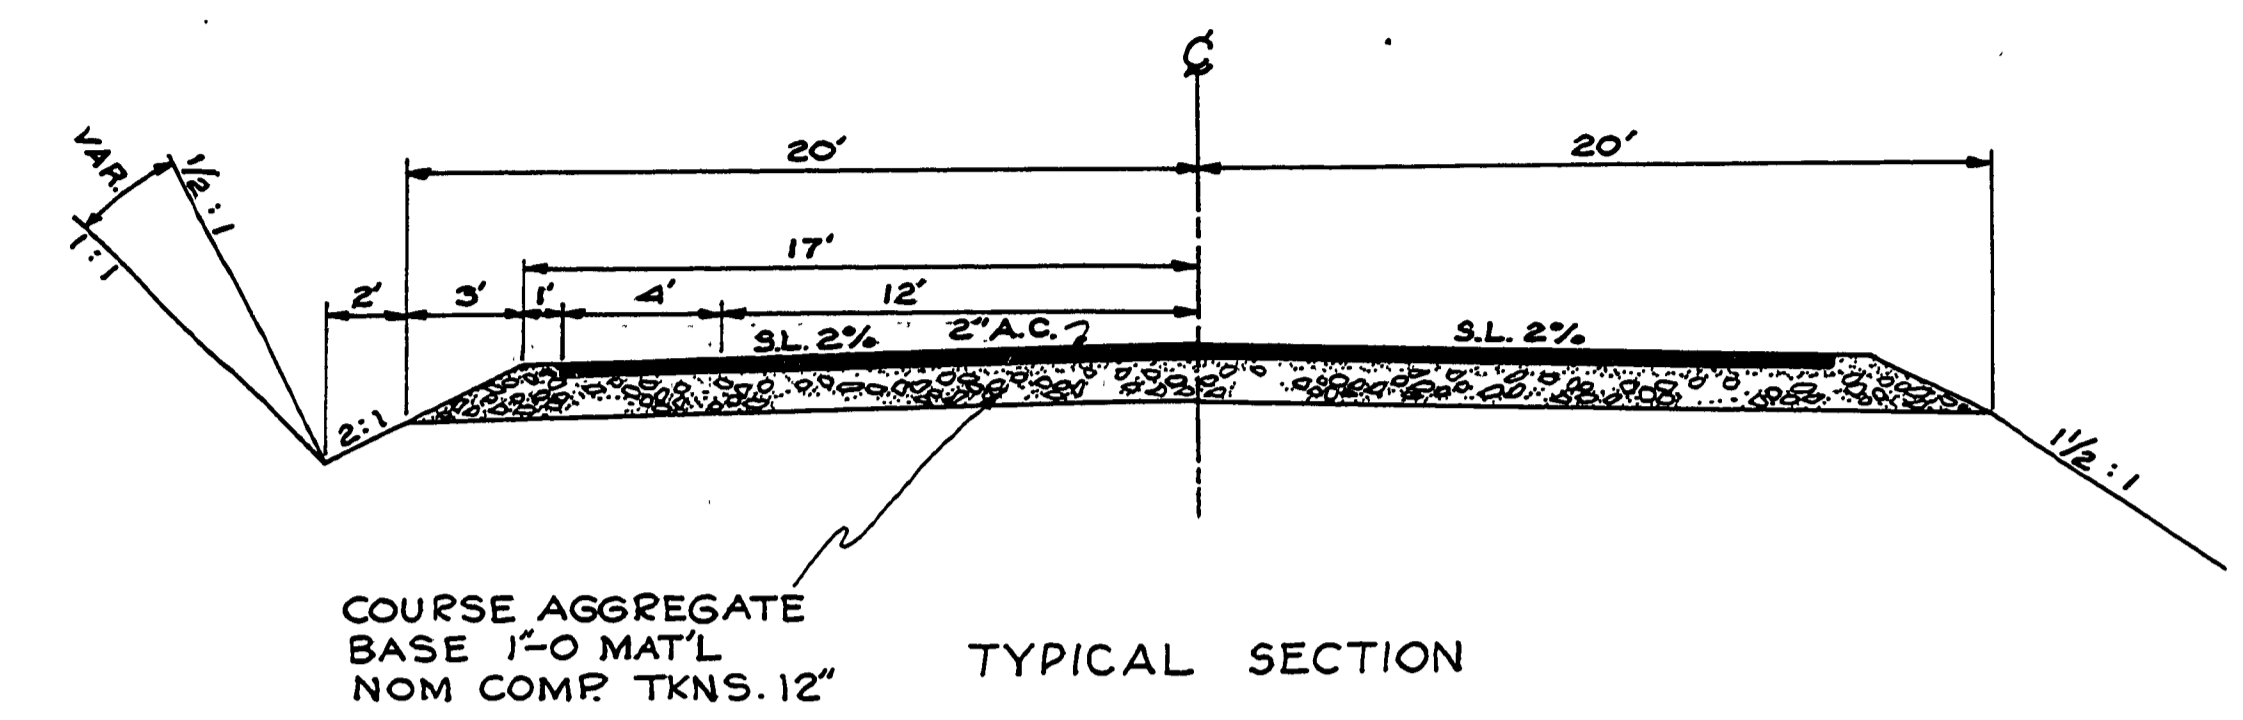


COURSE AGGREGATE
 BASE 1" O MAT'L
 NOM. COMP. TKNS. 12"
 TYPICAL SECTION

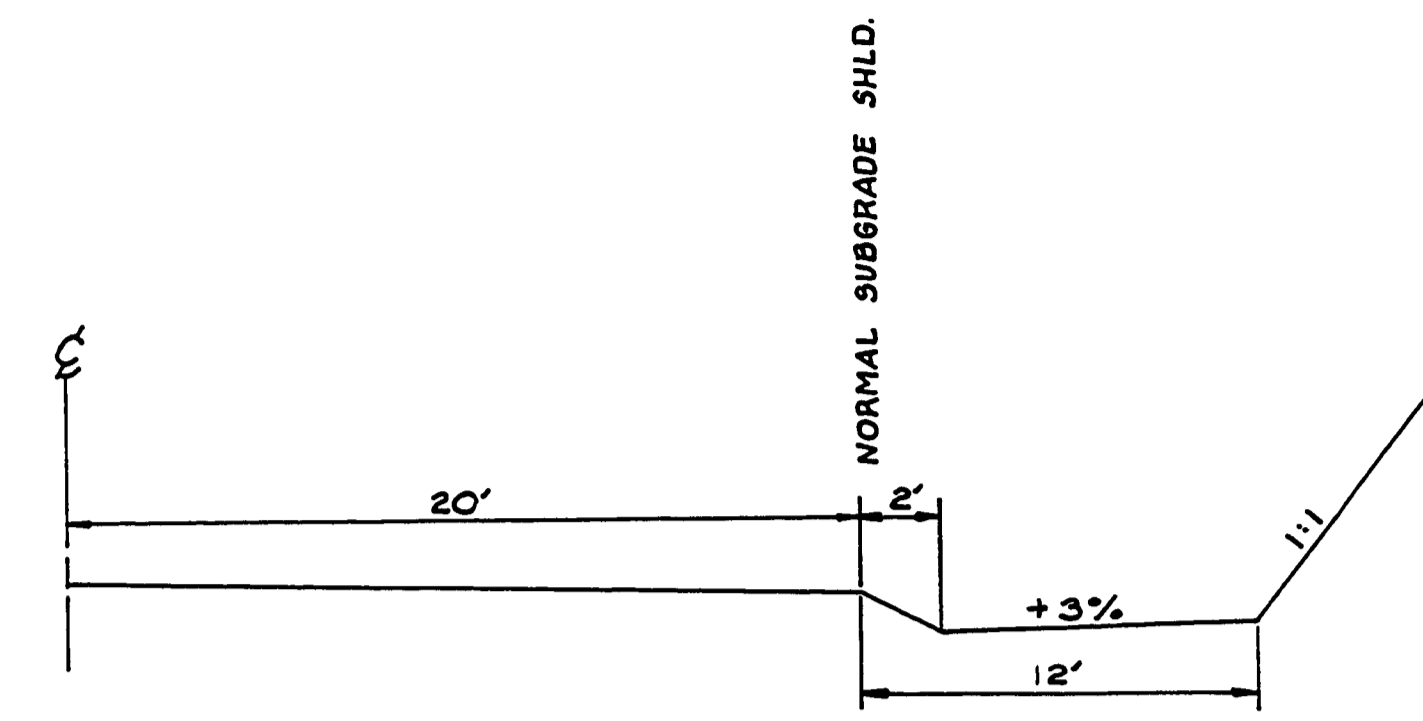


TYPICAL FALLOUT SECTION

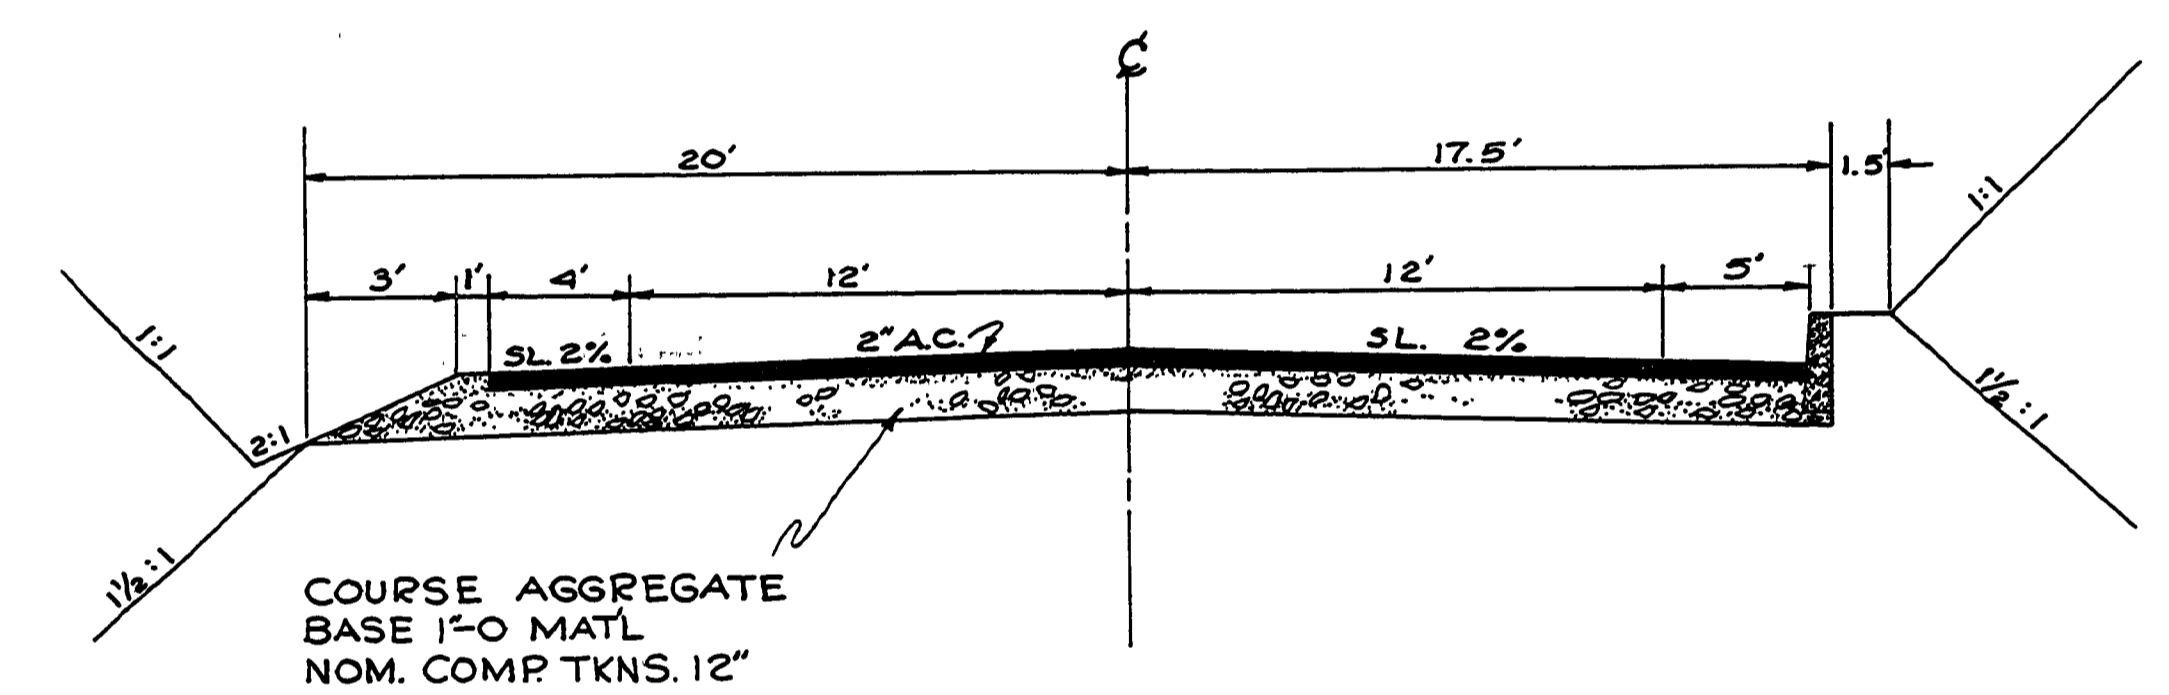

COURSE AGGREGATE
 BASE 1" O MAT'L
 NOM. COMP. TKNS. 12"
 TYPICAL SECTION
 STA. 96+70 TO STA. 104+00

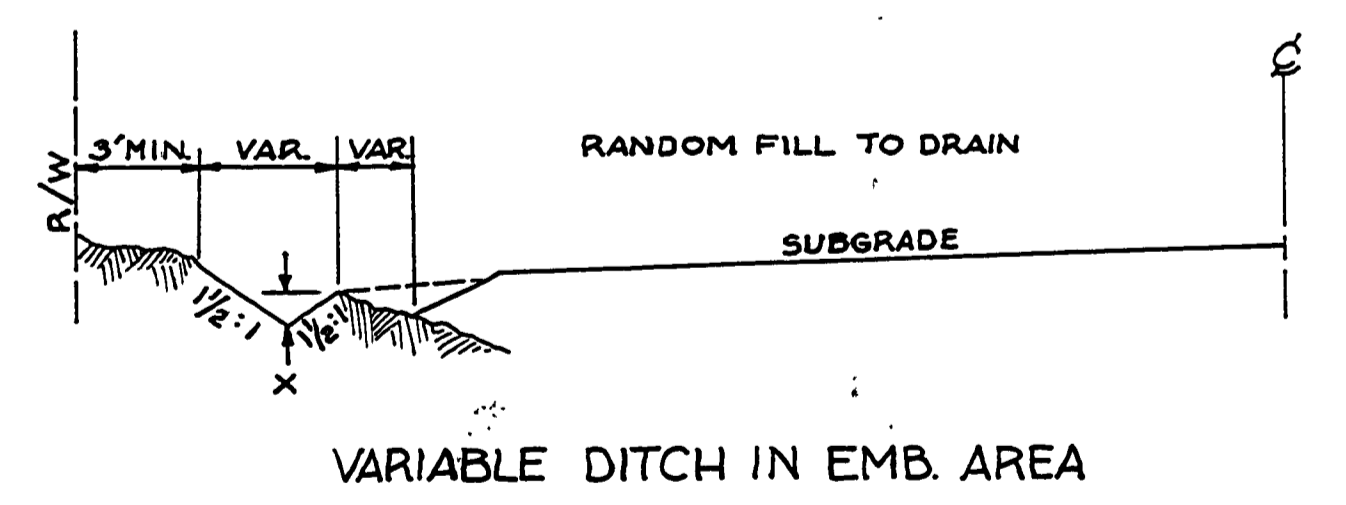

VARIABLE DITCH IN EMB. AREA

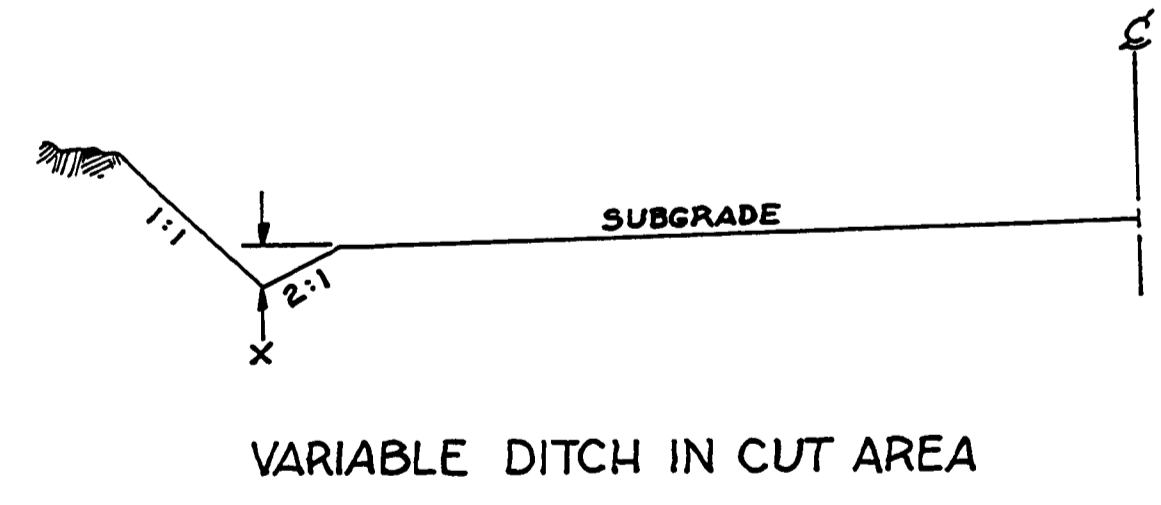

VARIABLE DITCH IN CUT AREA

AS BUILT 10-30-78 T.V.
 DOUGLAS COUNTY
 PUBLIC WORKS DEPARTMENT
 GLENGARY LOOP ROAD 121
 1975 SHT. 3
 GEORGE E. GRUBB, DIRECTOR

Co. Rd. #121 1975
 SHT. 3 of 8

000001P1