



DOUGLAS COUNTY, OREGON
 PLANS FOR PROPOSED PROJECT
 GRADING & SURFACING
HOOVER HILL ROAD NO. 125
1972
 MILE POINT 0.00 TO MILE POINT 2.03

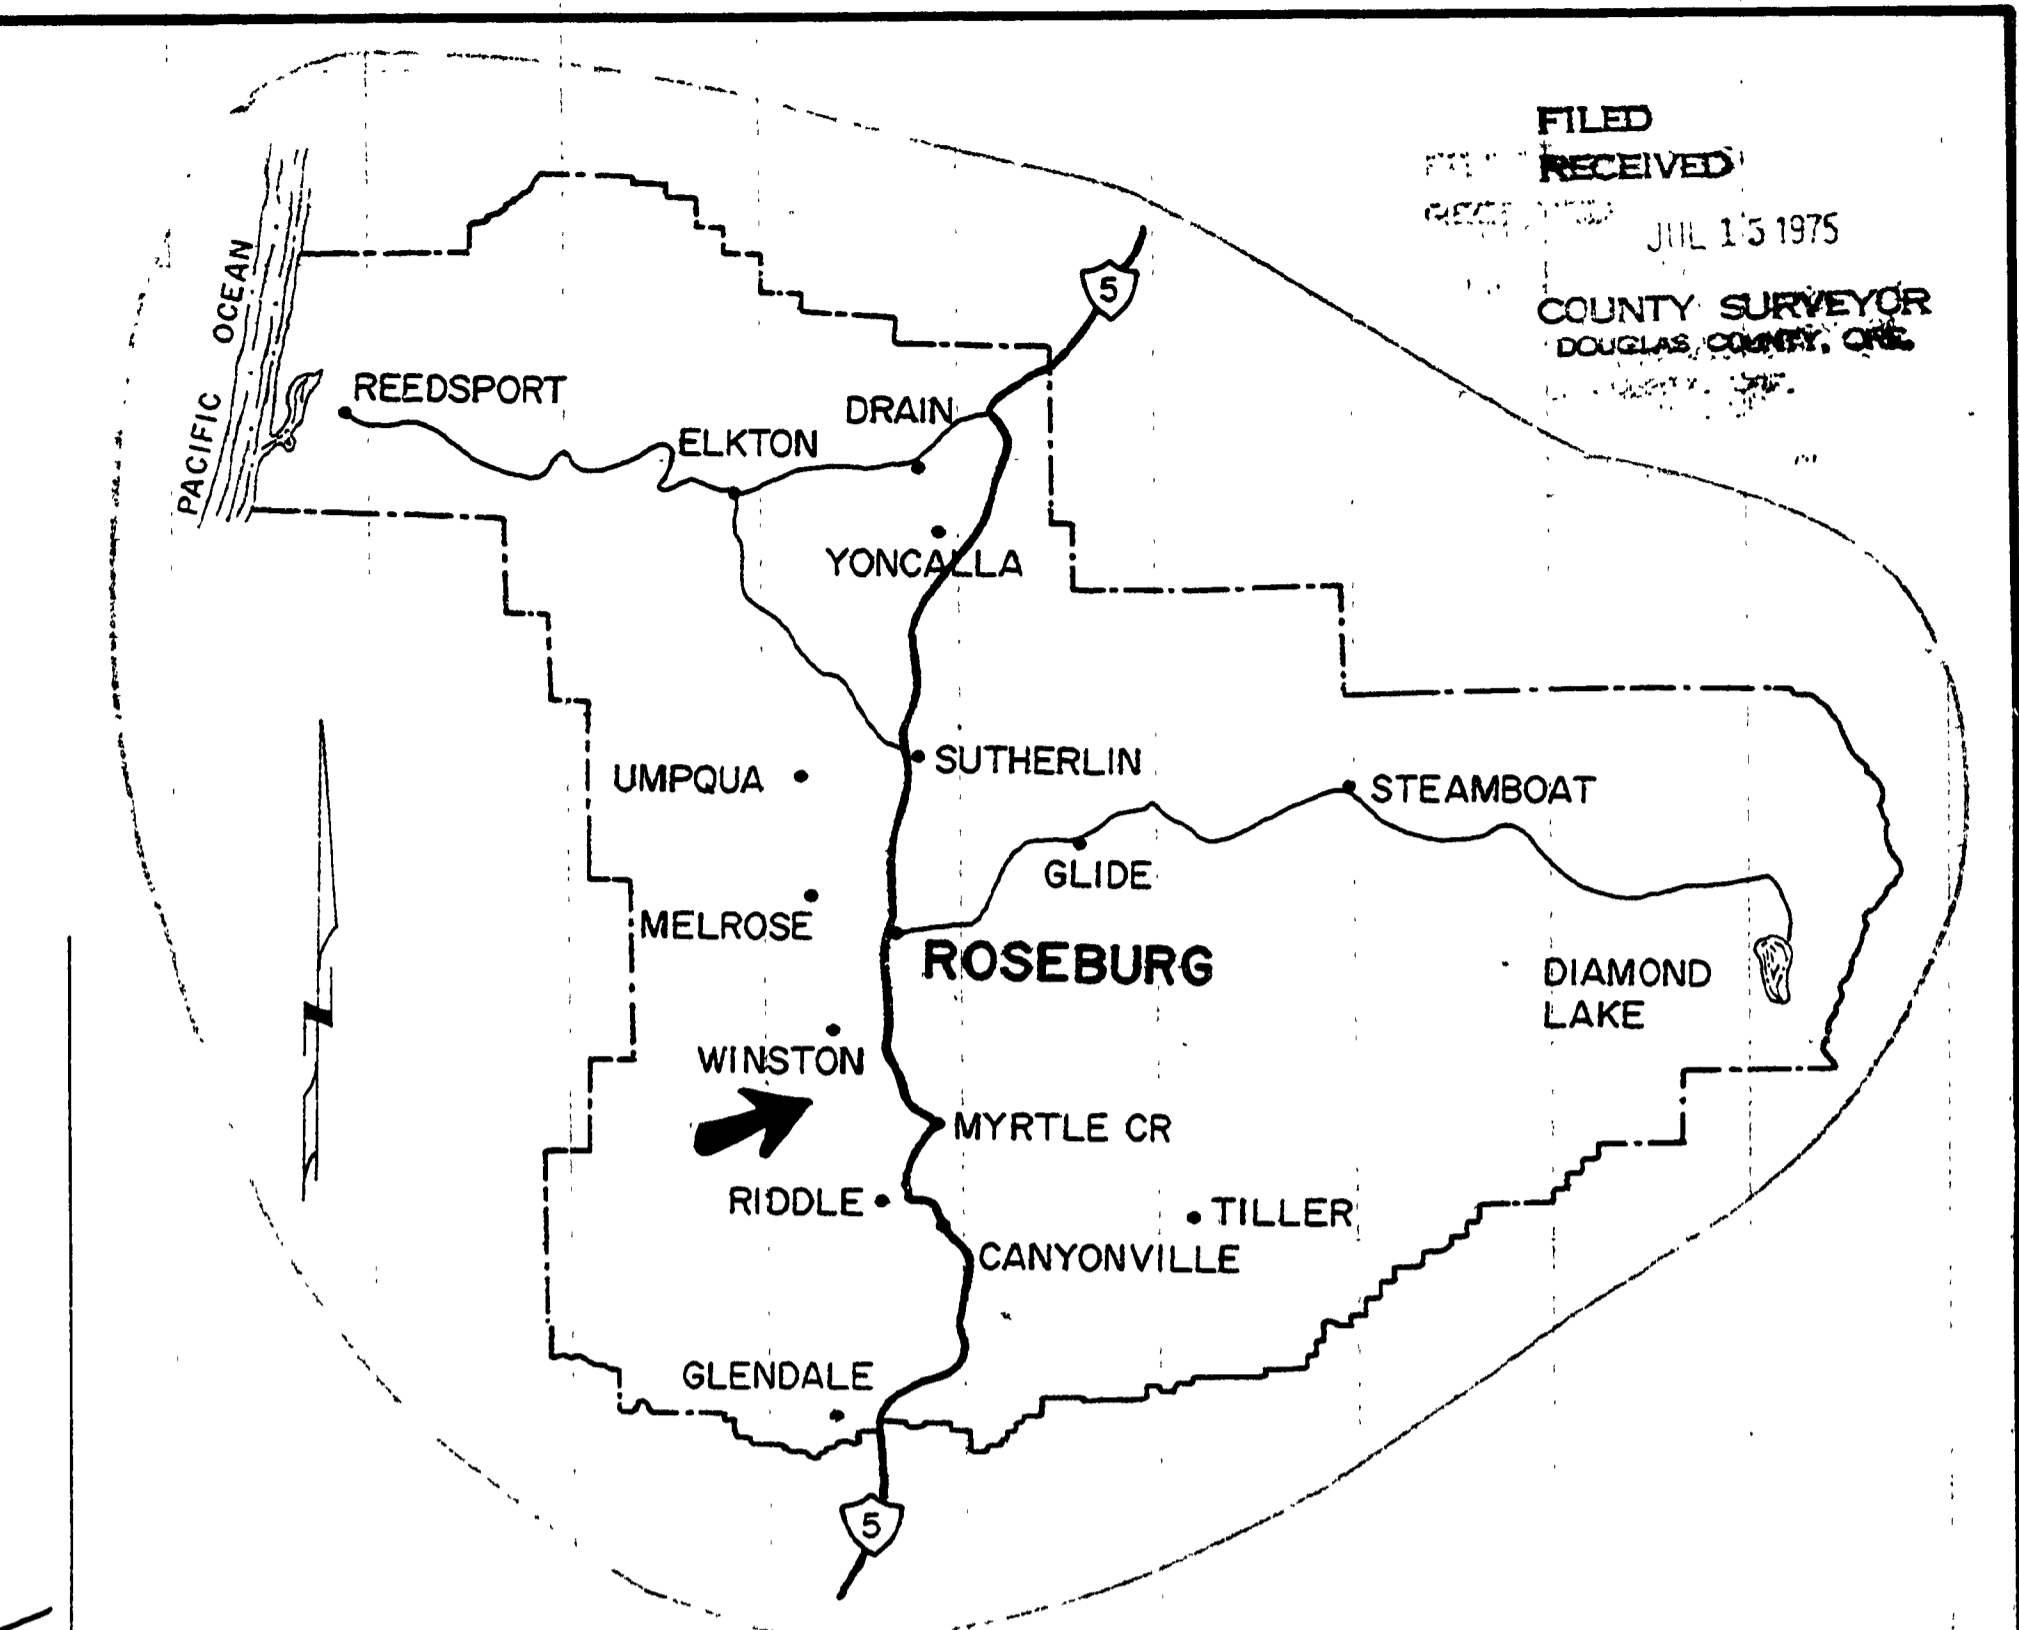

FILED
 RECEIVED
 JUL 15 1975
 COUNTY SURVEYOR
 DOUGLAS COUNTY, ORE.

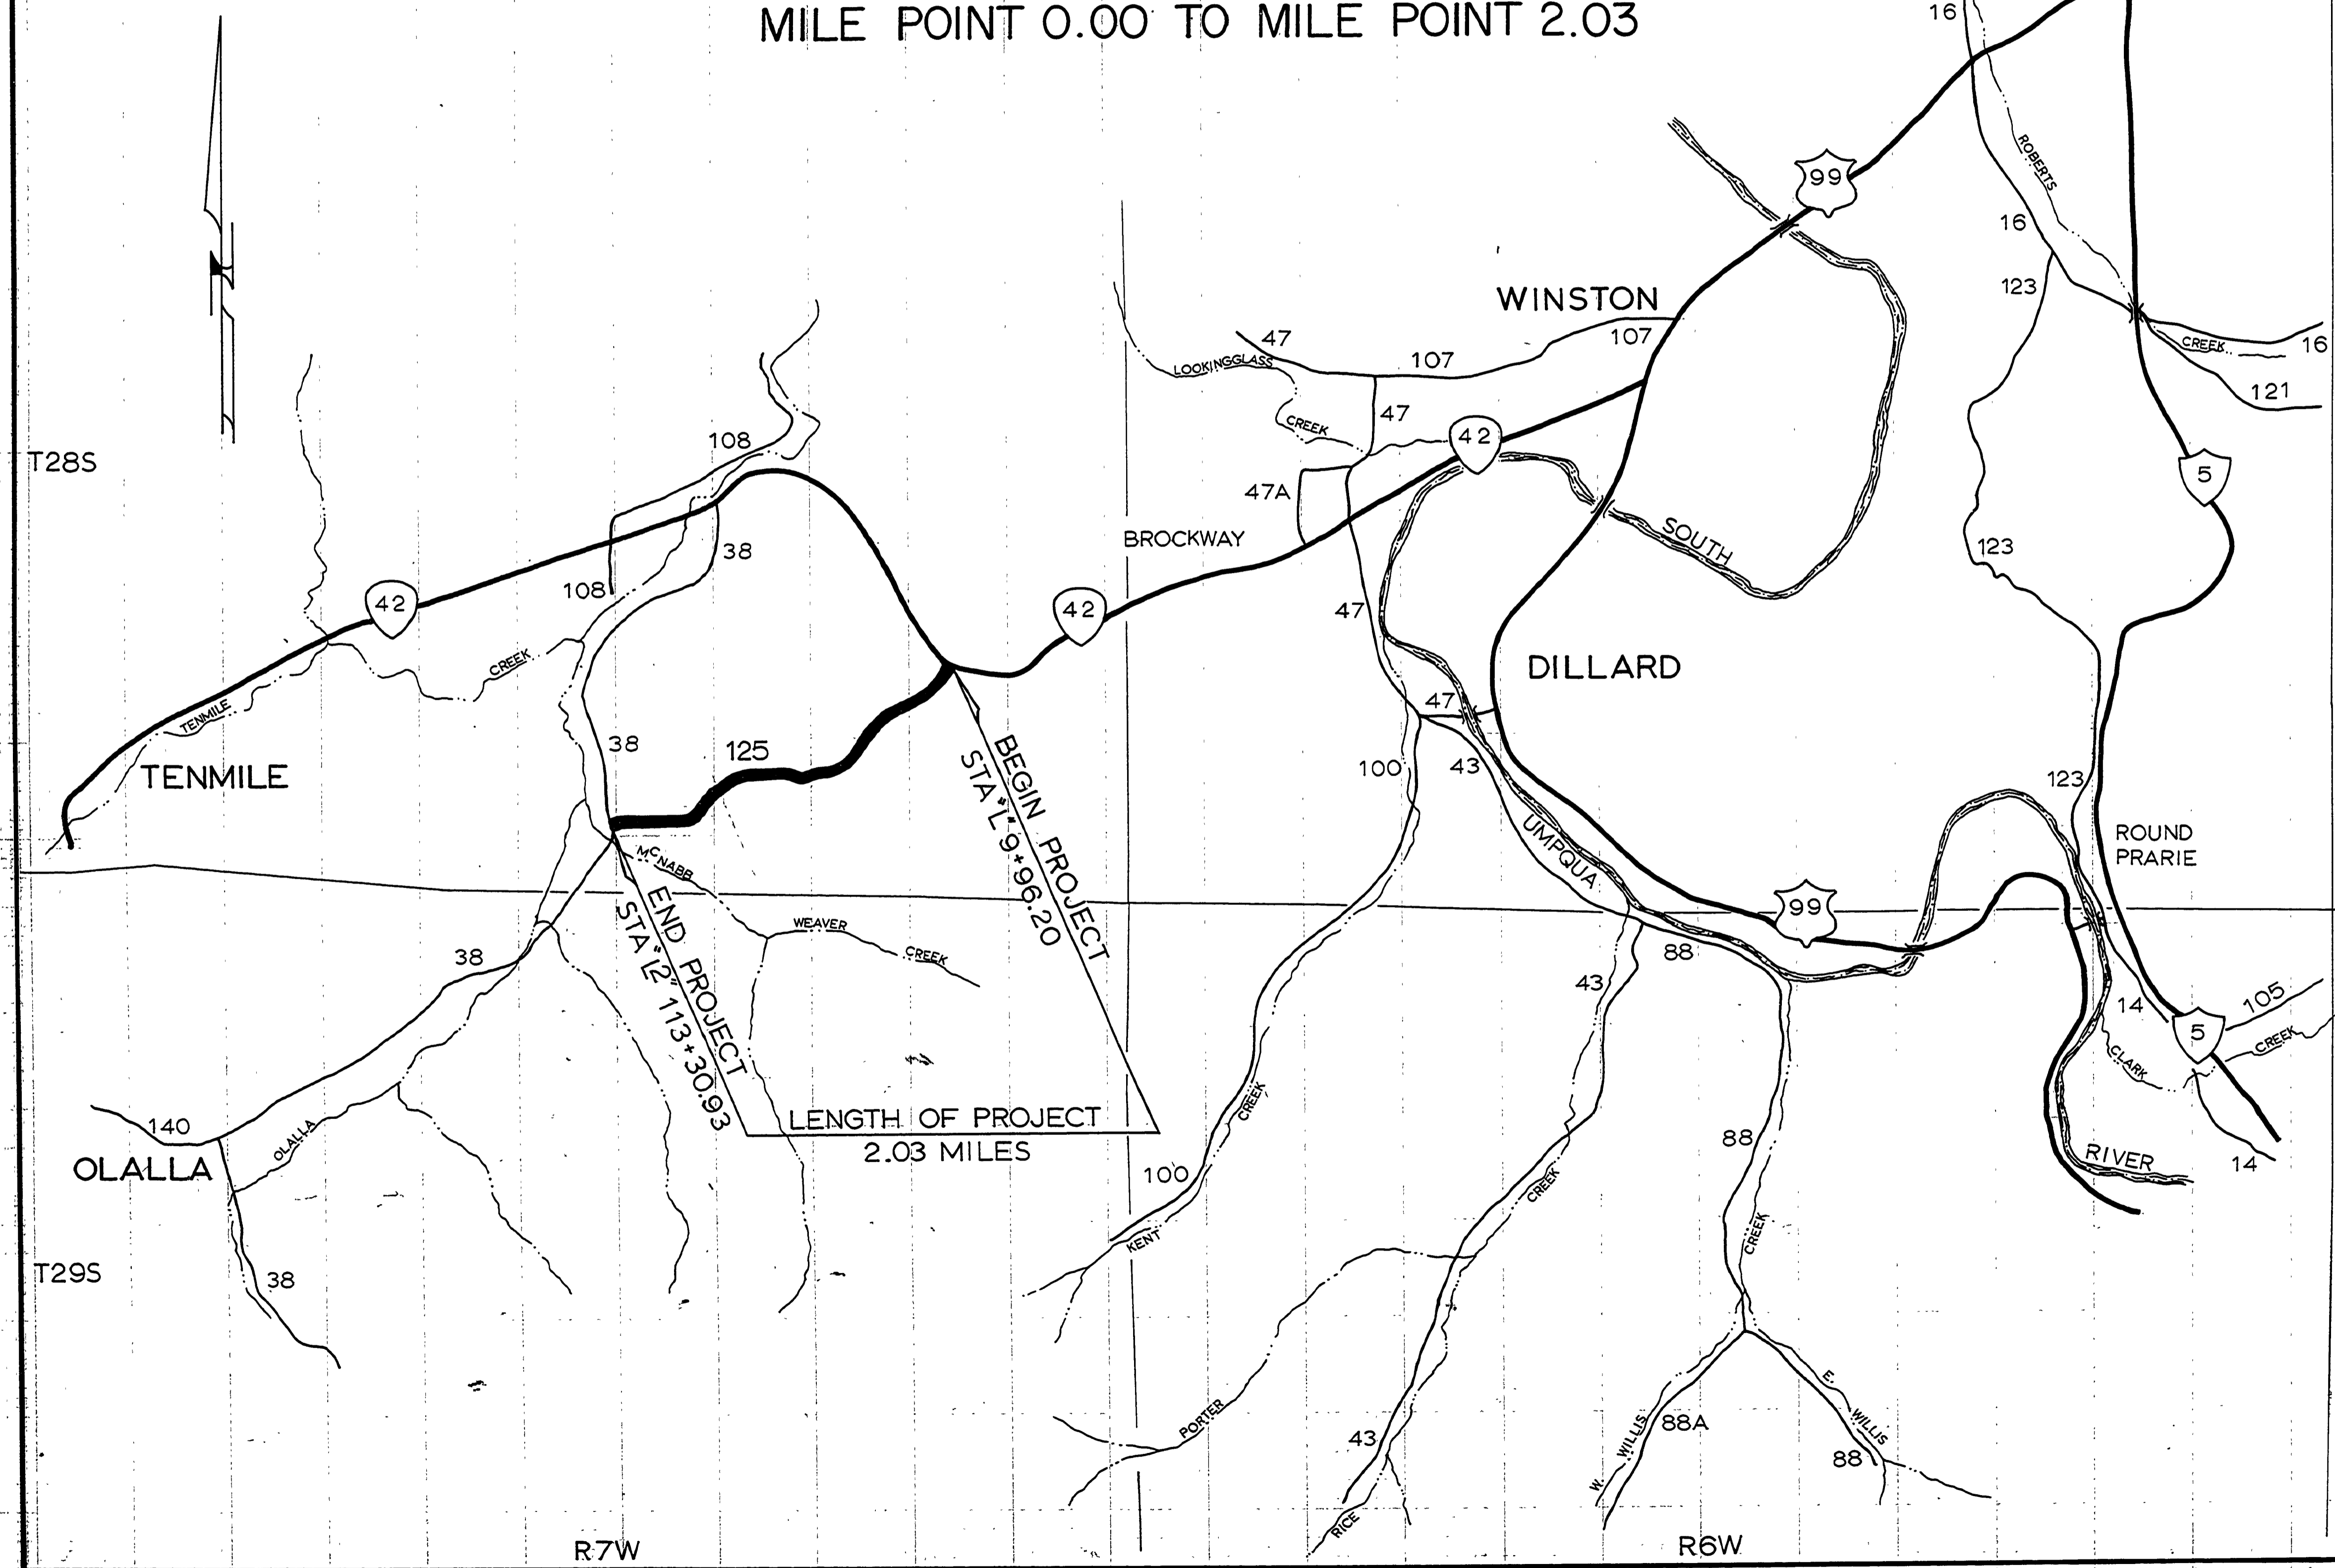

INDEX OF DRAWINGS

SHEET NUMBER	TITLE
1	TITLE SHEET
2	QUANTITY SUMMARY
3	TYPICAL SECTIONS
4	PIPE LIST
5,6,7,8	ROAD PLANS

STANDARD DRAWINGS

TOTAL OF SHEETS

NOT REVISED
 AS CONSTRUCTED



DOUGLAS COUNTY ROAD DEPT.
HOOVER HILL ROAD NO. 125
 1972 SHT 1
 GEORGE E. GRUBB COUNTY ENGR.