
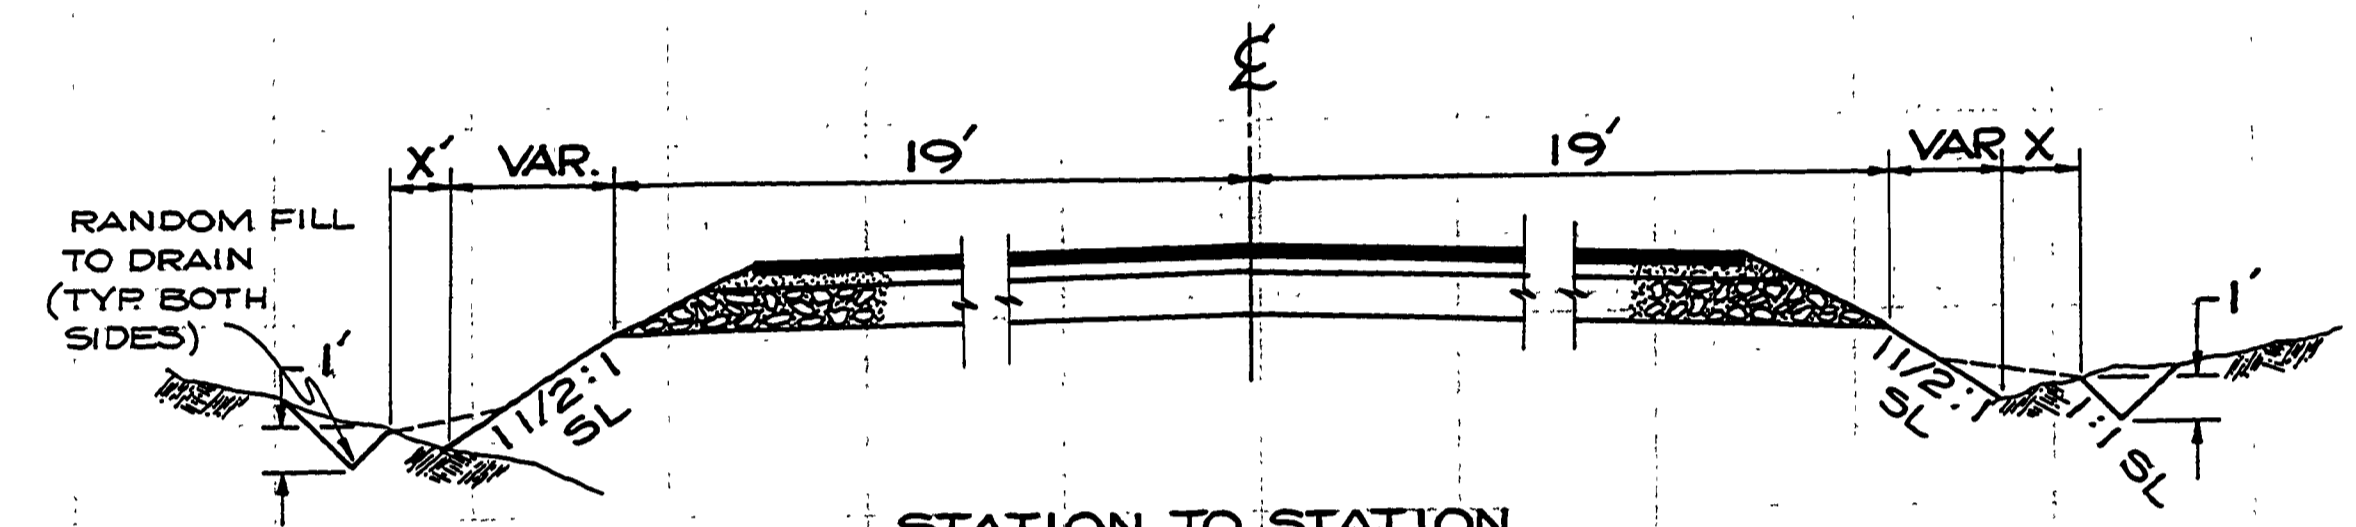


FILED  
 RECEIVED  
 JUL 15 1975  
 COUNTY SURVEYOR  
 DOUGLAS COUNTY, ORE.

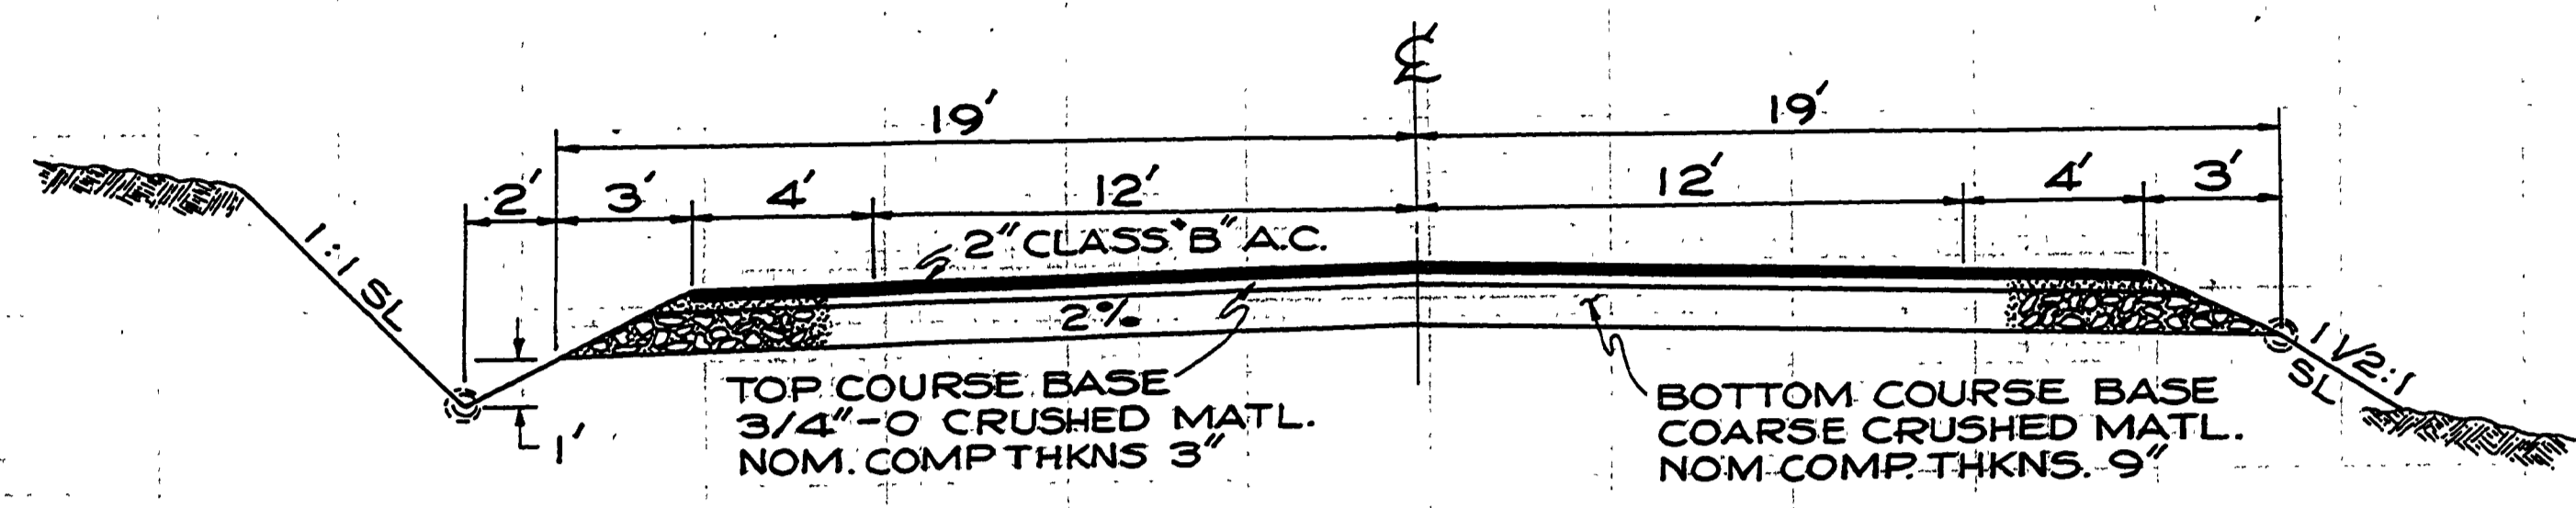

STATION TO STATION

X			X
31	+25	32	+25
36	+75	40	+30
42	+25	43	+25
49	+25	52	+25
71	+75	74	+25
75	+25	76	+75
87	+75	89	+25
93	+25	94	+25
96	+25	97	+25

NOT REVISED  
 AS CONSTRUCTED

DOUGLAS COUNTY ROAD DEPT.  
 HOOVER HILL ROAD NO. 125  
 1972 SHIT 2  
 GEORGE E. GRUBB COUNTY ENGR.

00001790