


2005
COUNTY

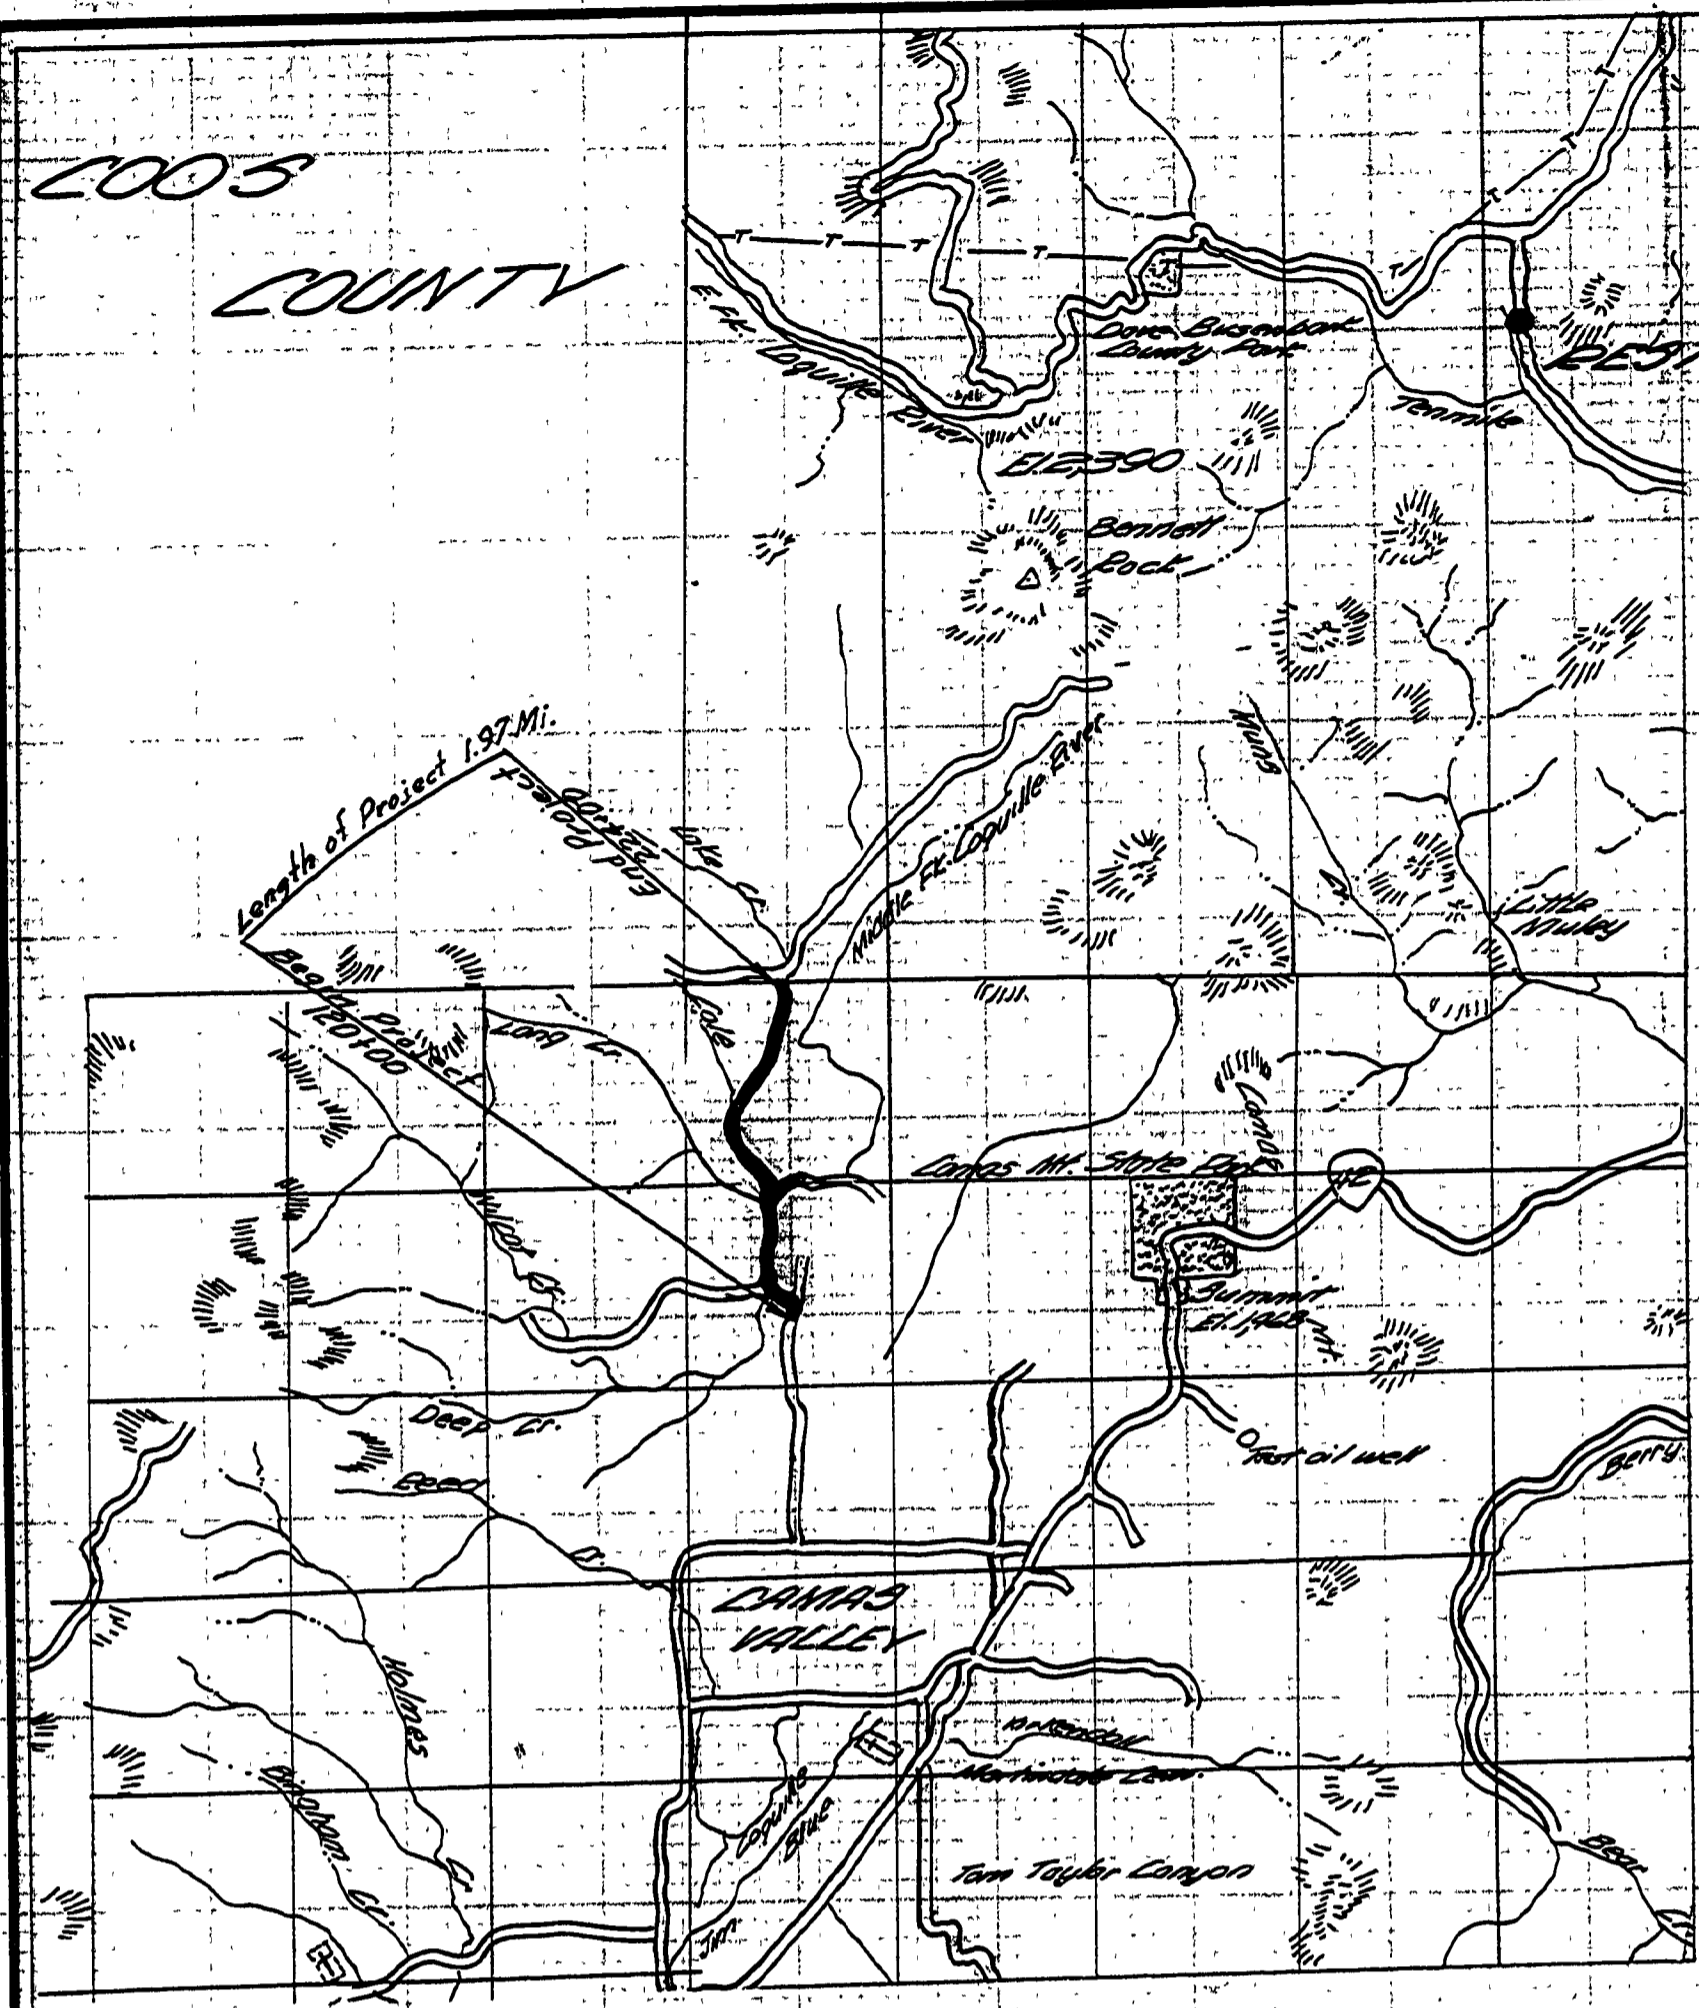



VICINITY MAP

DOUGLAS COUNTY OREGON

AS CONSTRUCTED

GRADING & SURFACING

UPPER CANNAS RD. 128

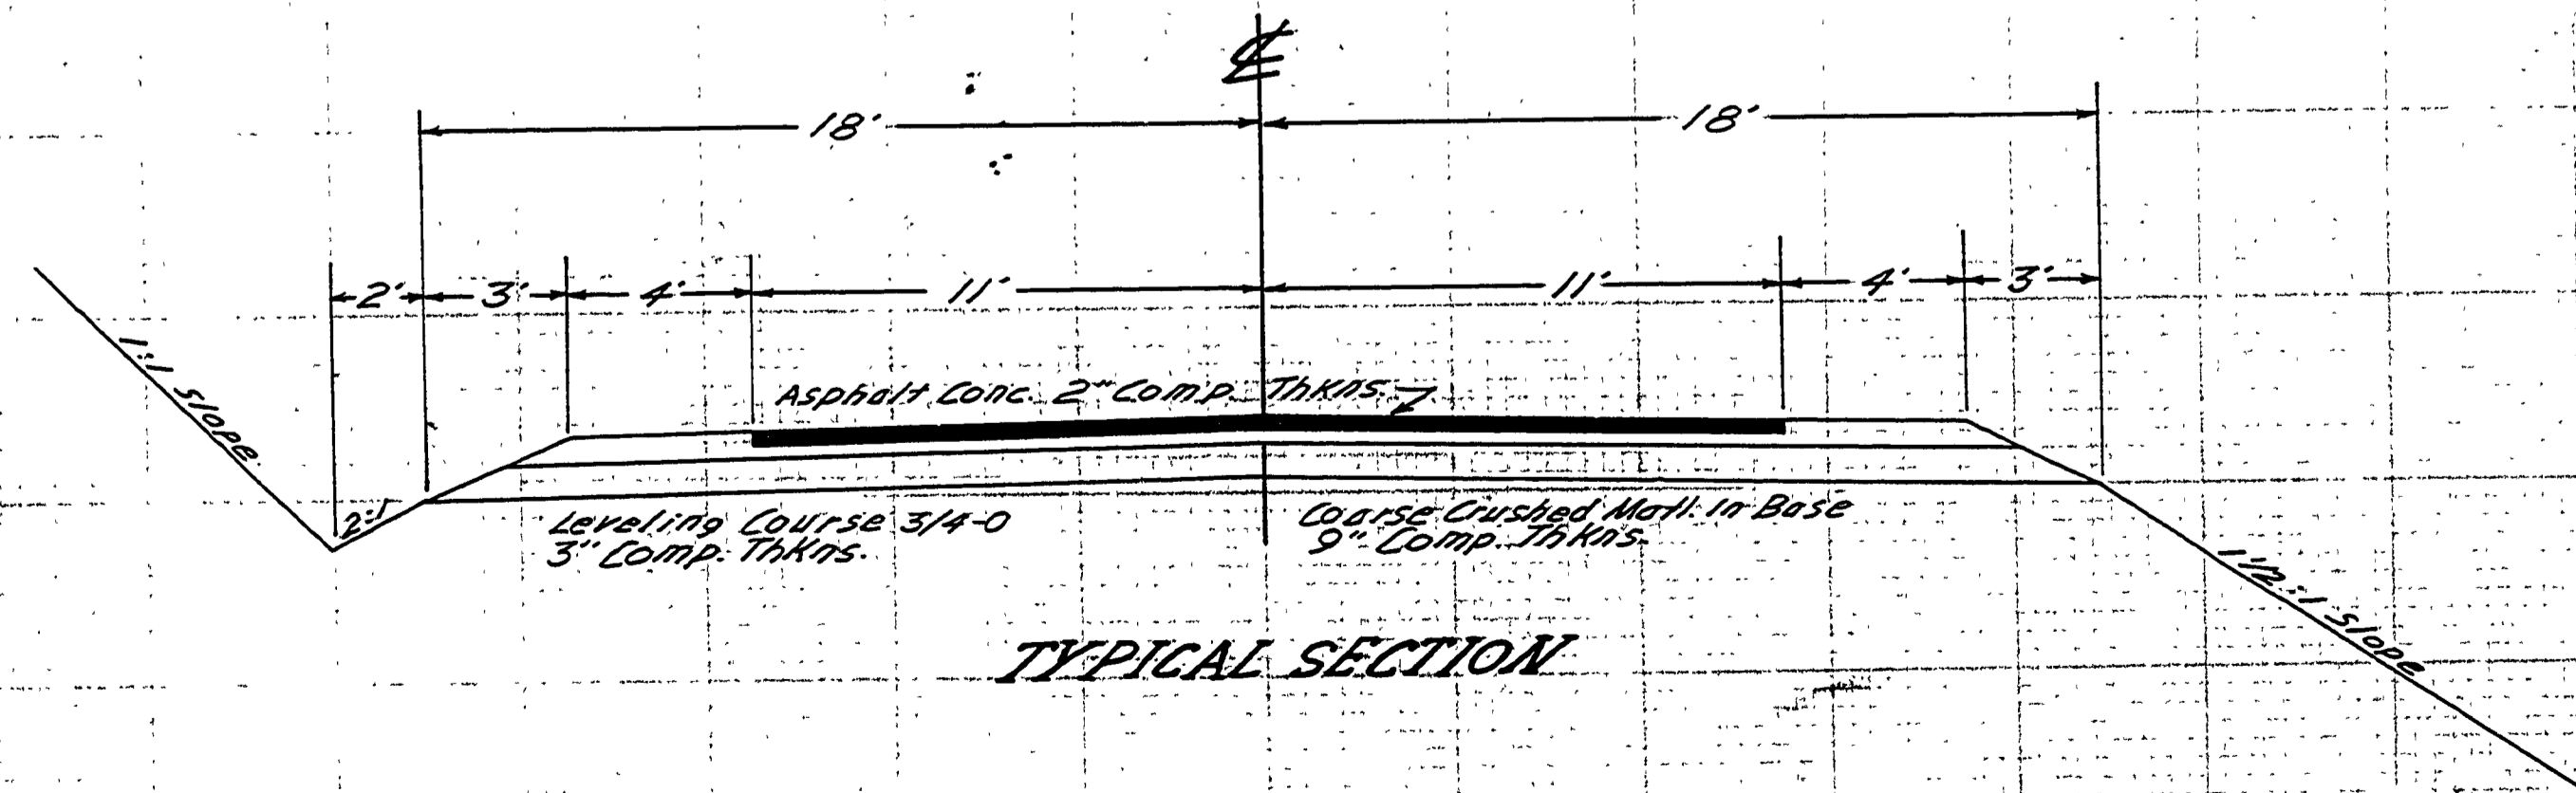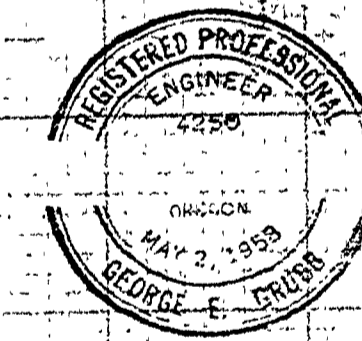

TYPICAL SECTION

FILED
RECEIVED
MAY 22 1968
COUNTY SURVEYOR
DOUGLAS COUNTY, ORE.

JUNE, 1966
Co. Rd. #128

02300740