
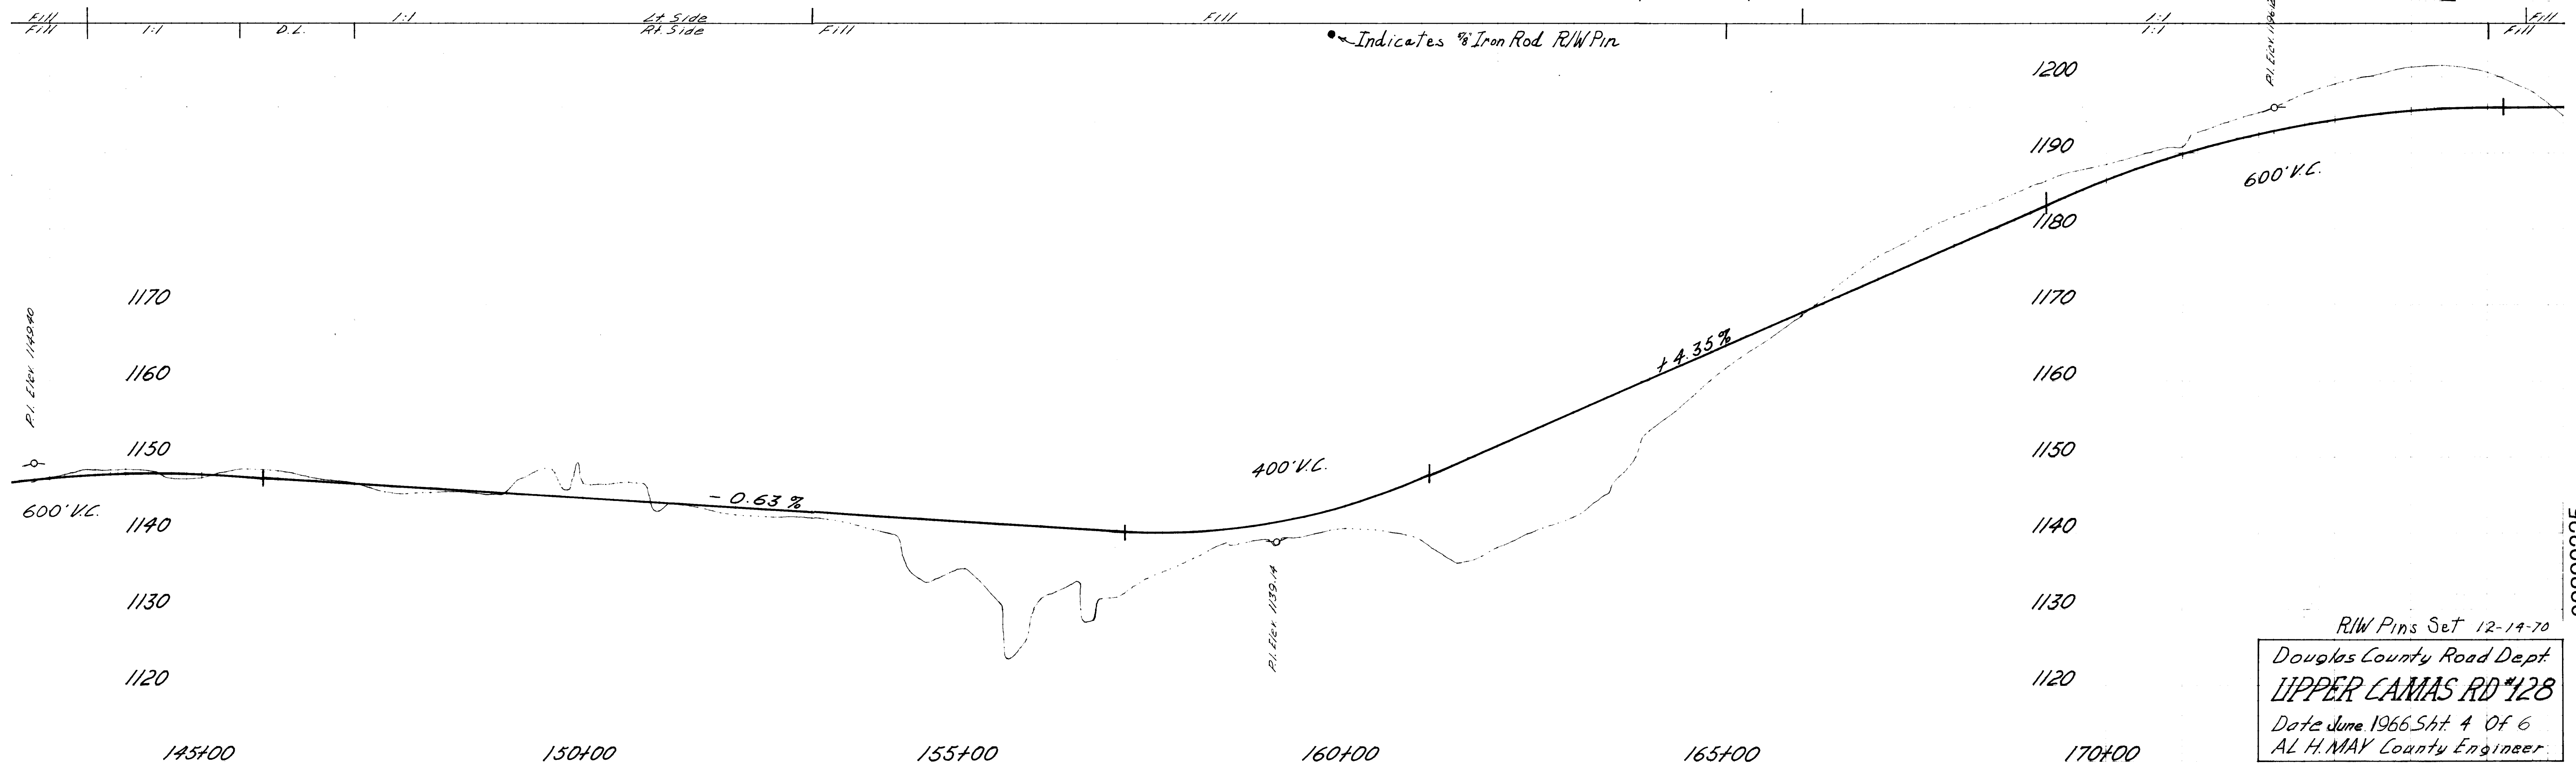


S.6&7, T.29S. R.8W.W.M.

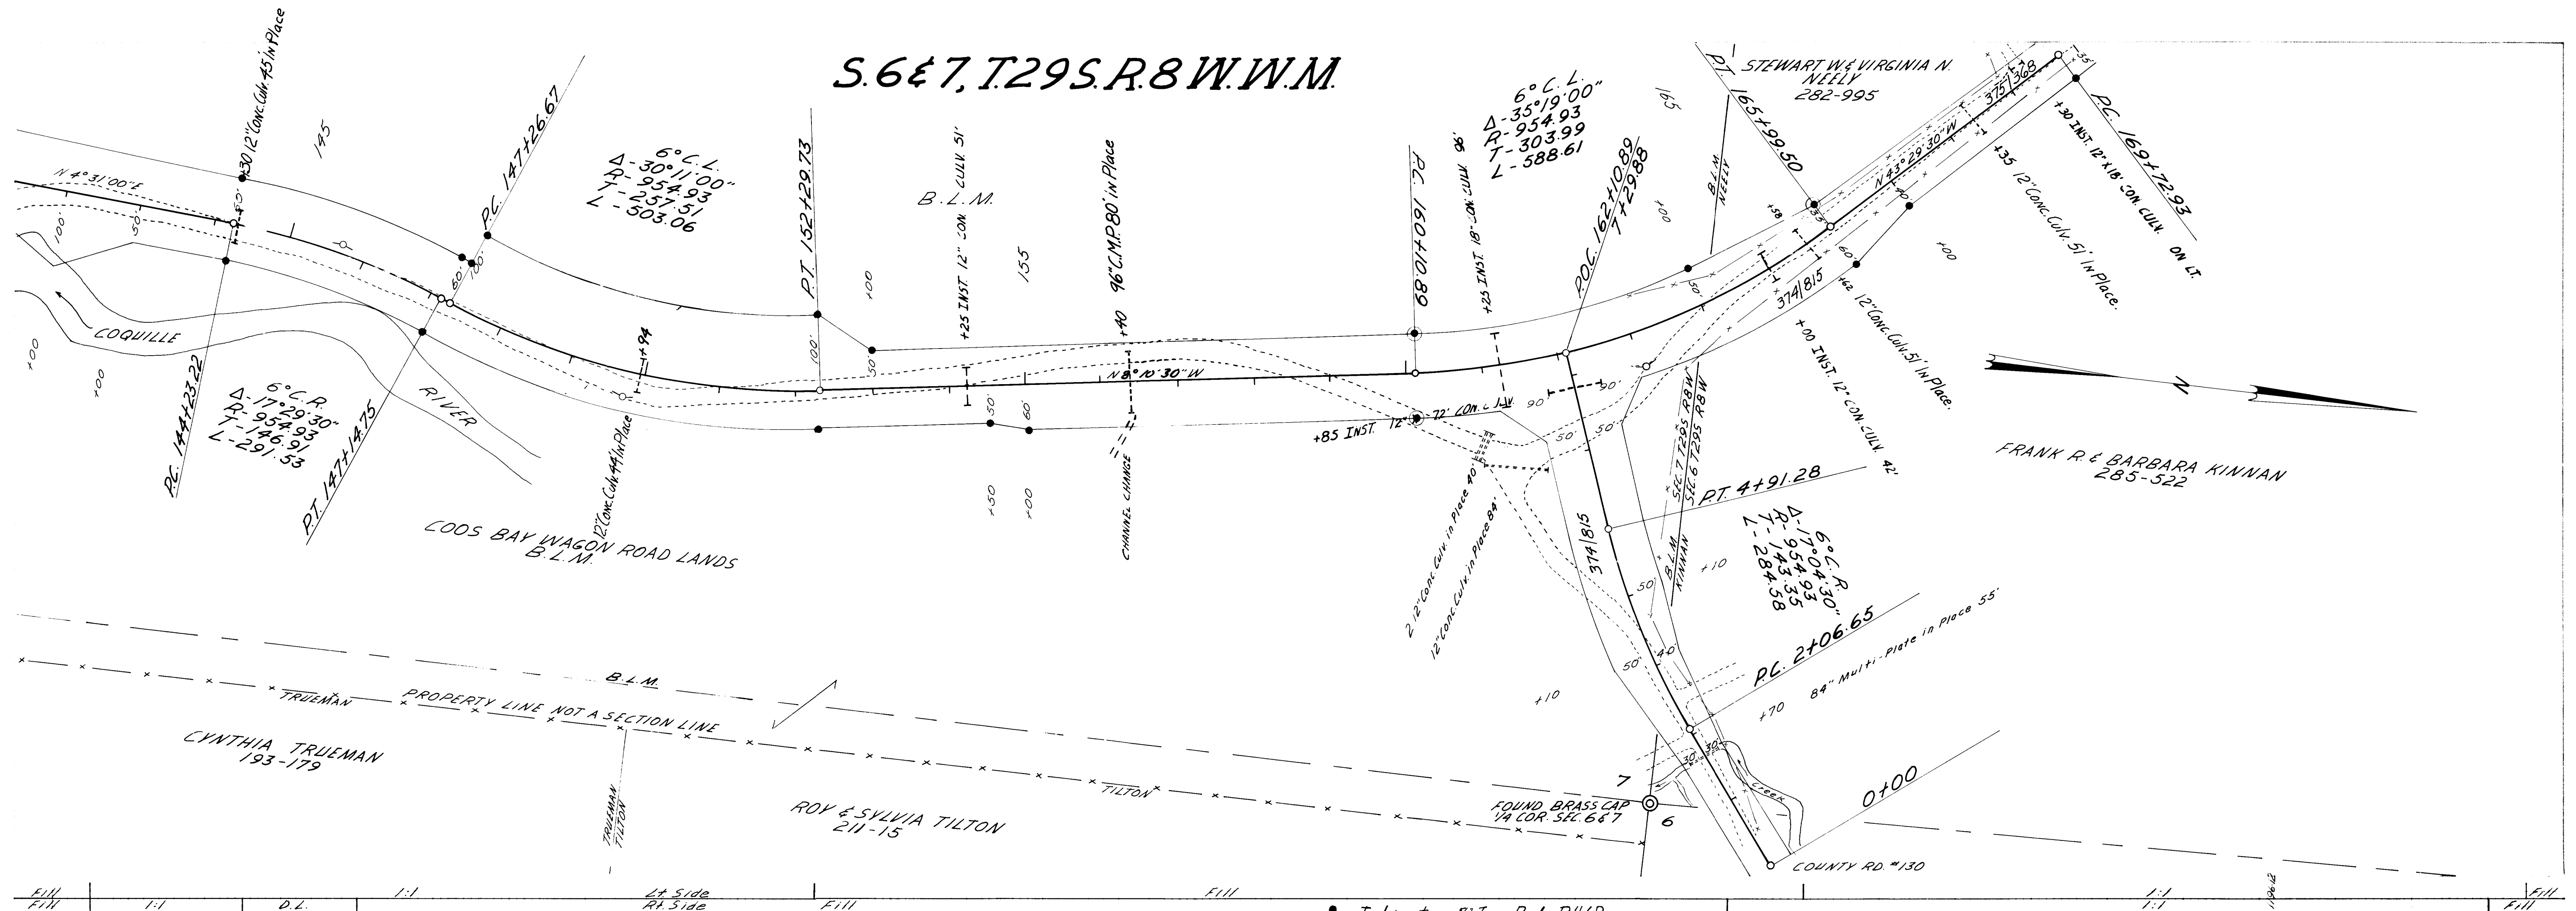

RIW Pins Set 12-14-70
 Douglas County Road Dept
UPPER CAMAS RD #128
 Date June 1966, Sht 4 of 6
 AL H. MAY County Engineer

02890325

Co. RS # 128 June 2, 1966