

DOUGLAS COUNTY HIGHWAY SURVEY



ELPEL ROAD N°C-128

Secs 31-32, T 28, R 8 W.

F.C. Freear, Roadmaster

1929

Sheet 2

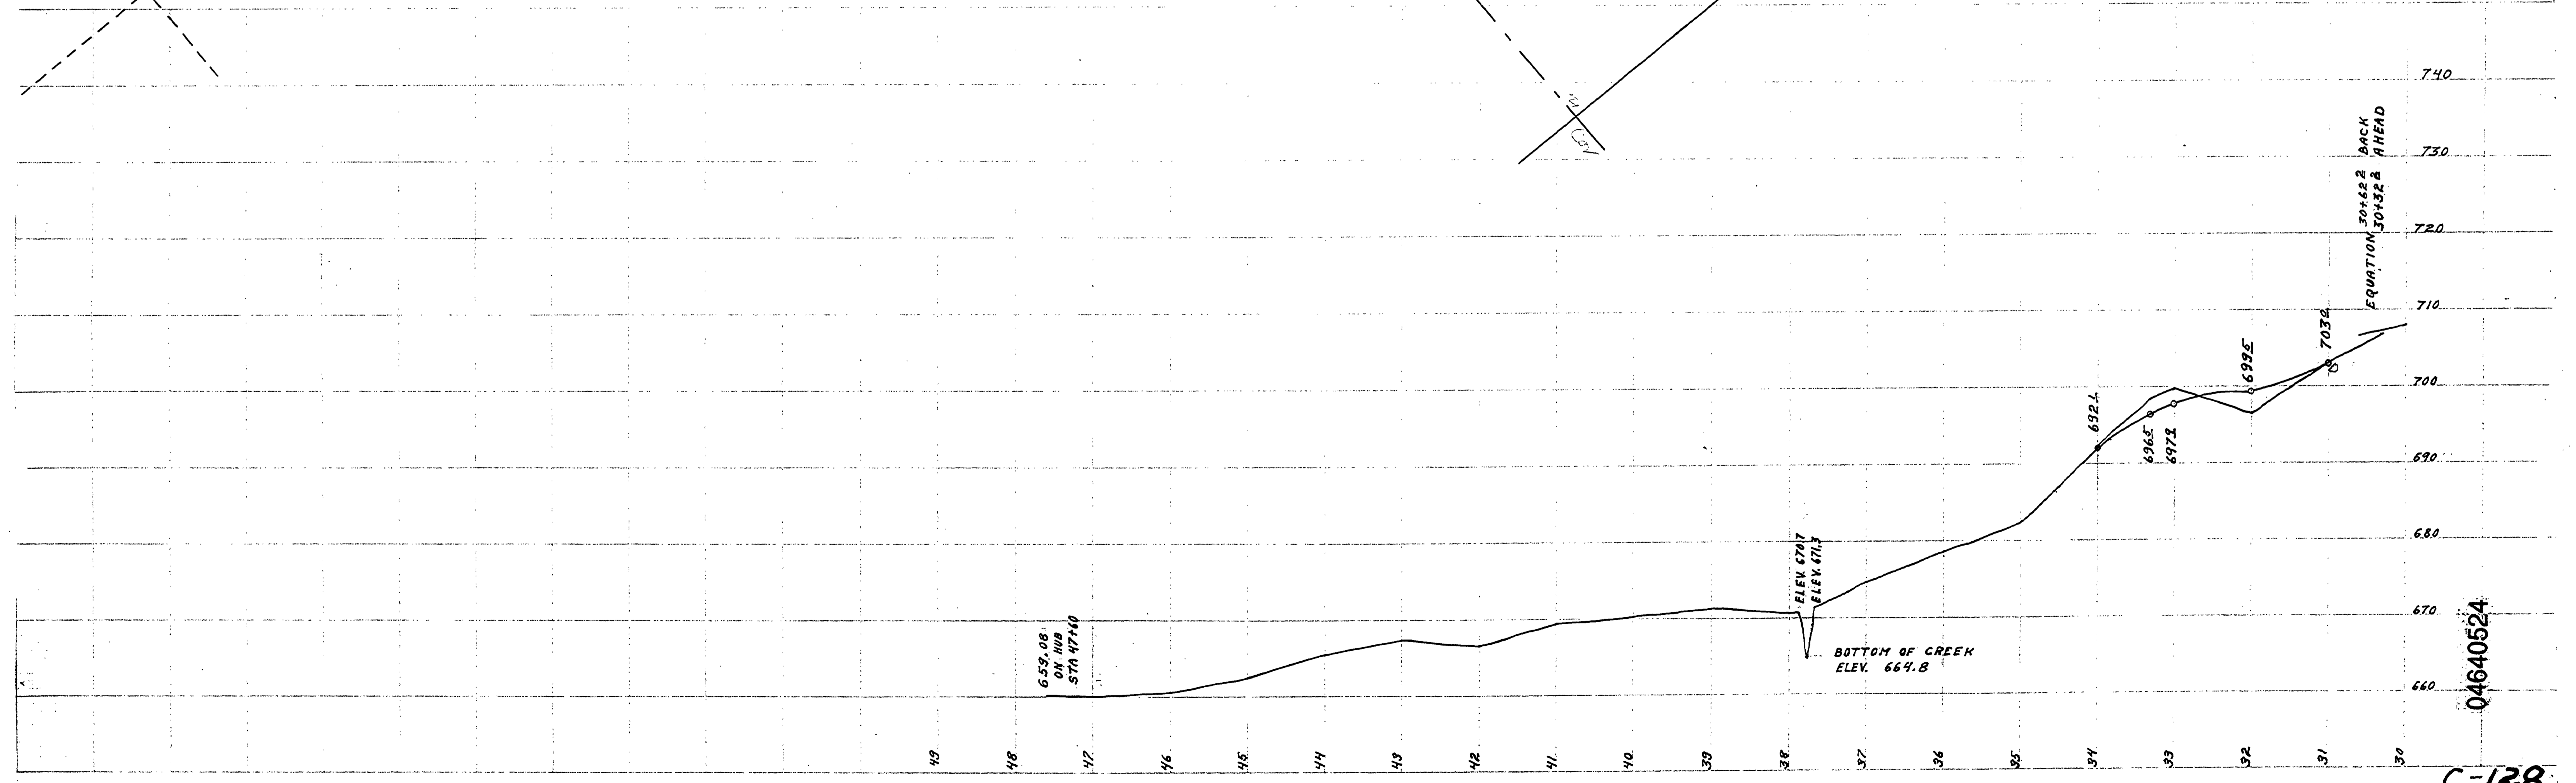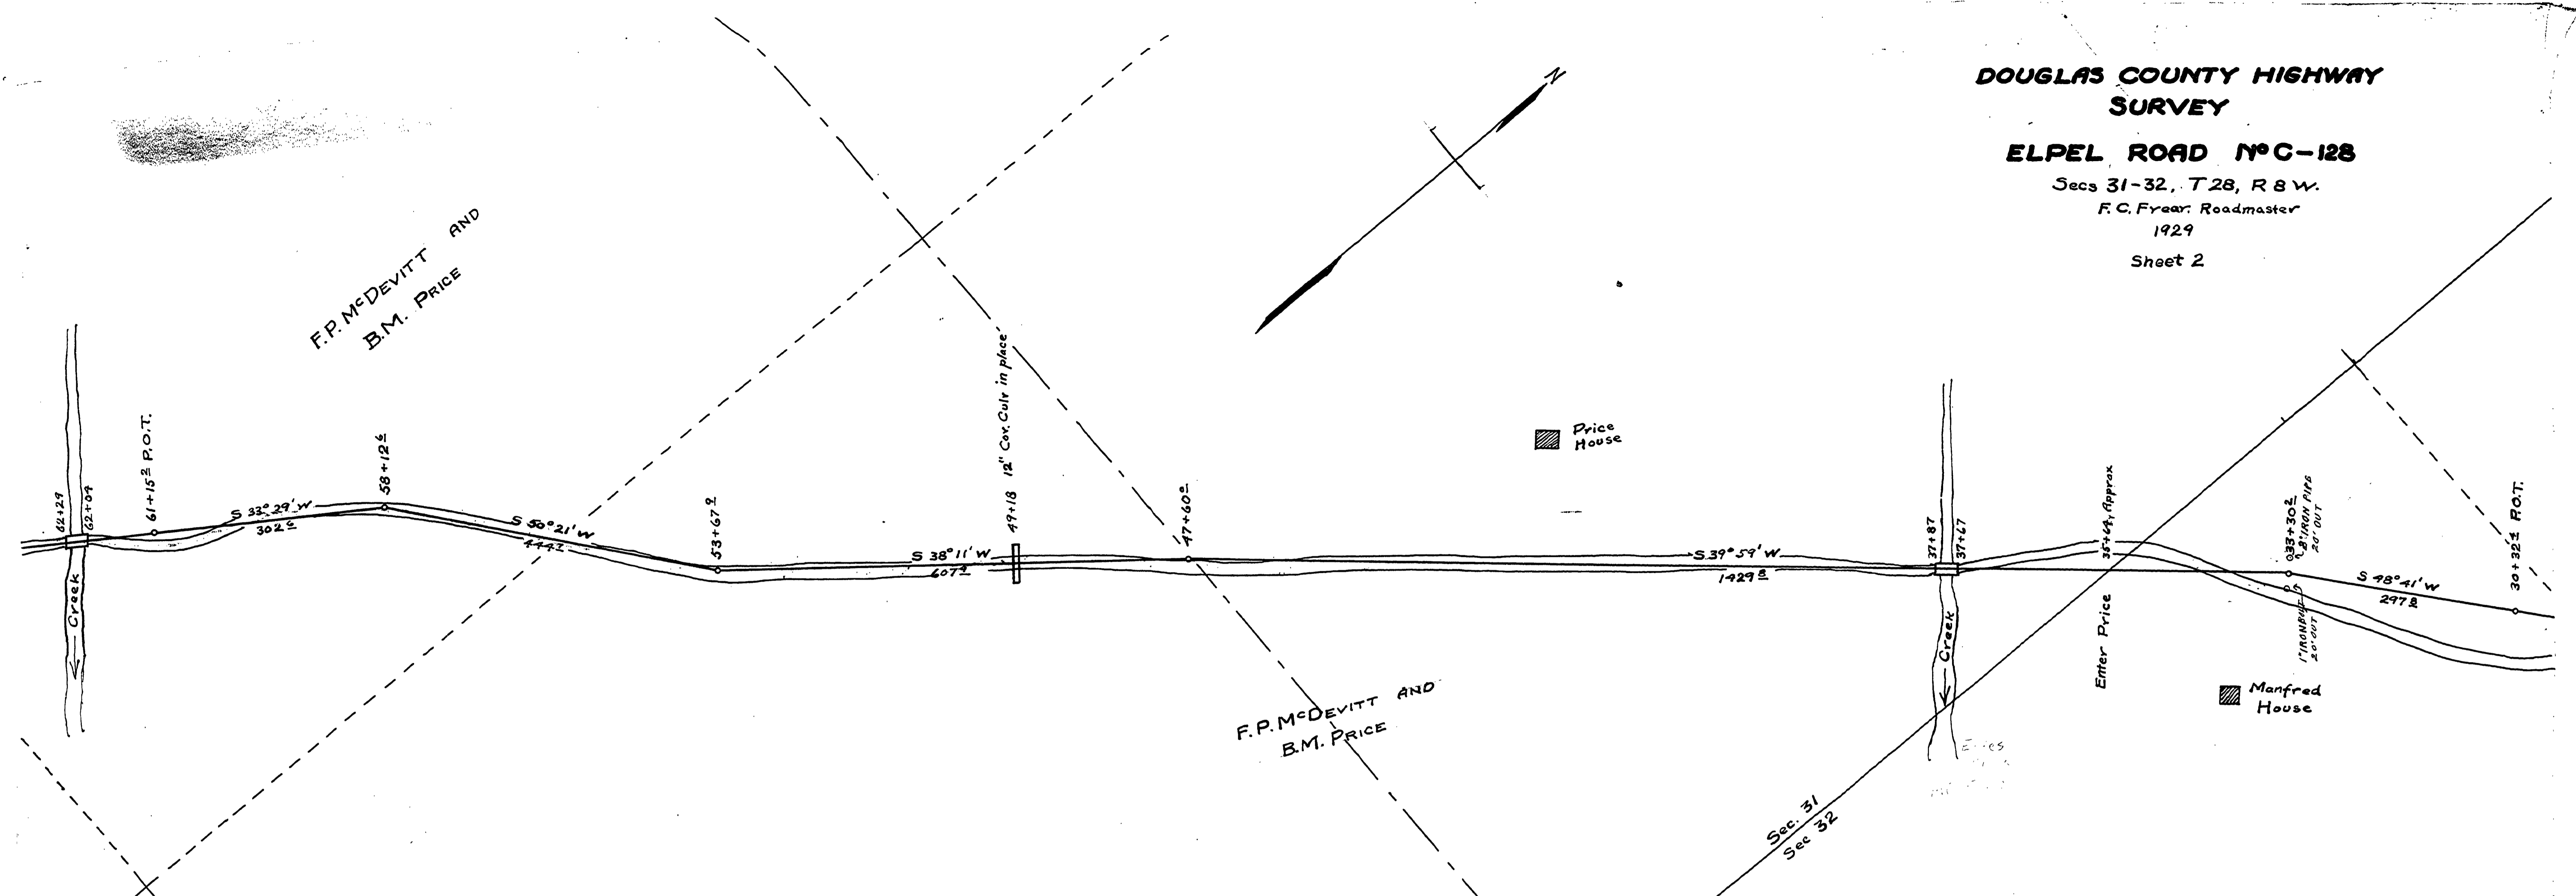

C-128

Handwritten notes and a scale bar at the bottom of the page.