


FILED
RECEIVED
JAN 12 1977
COUNTY SURVEYOR
DOUGLAS COUNTY, ORE.

LEGEND
SOFT SPOT
PATCH ROAD

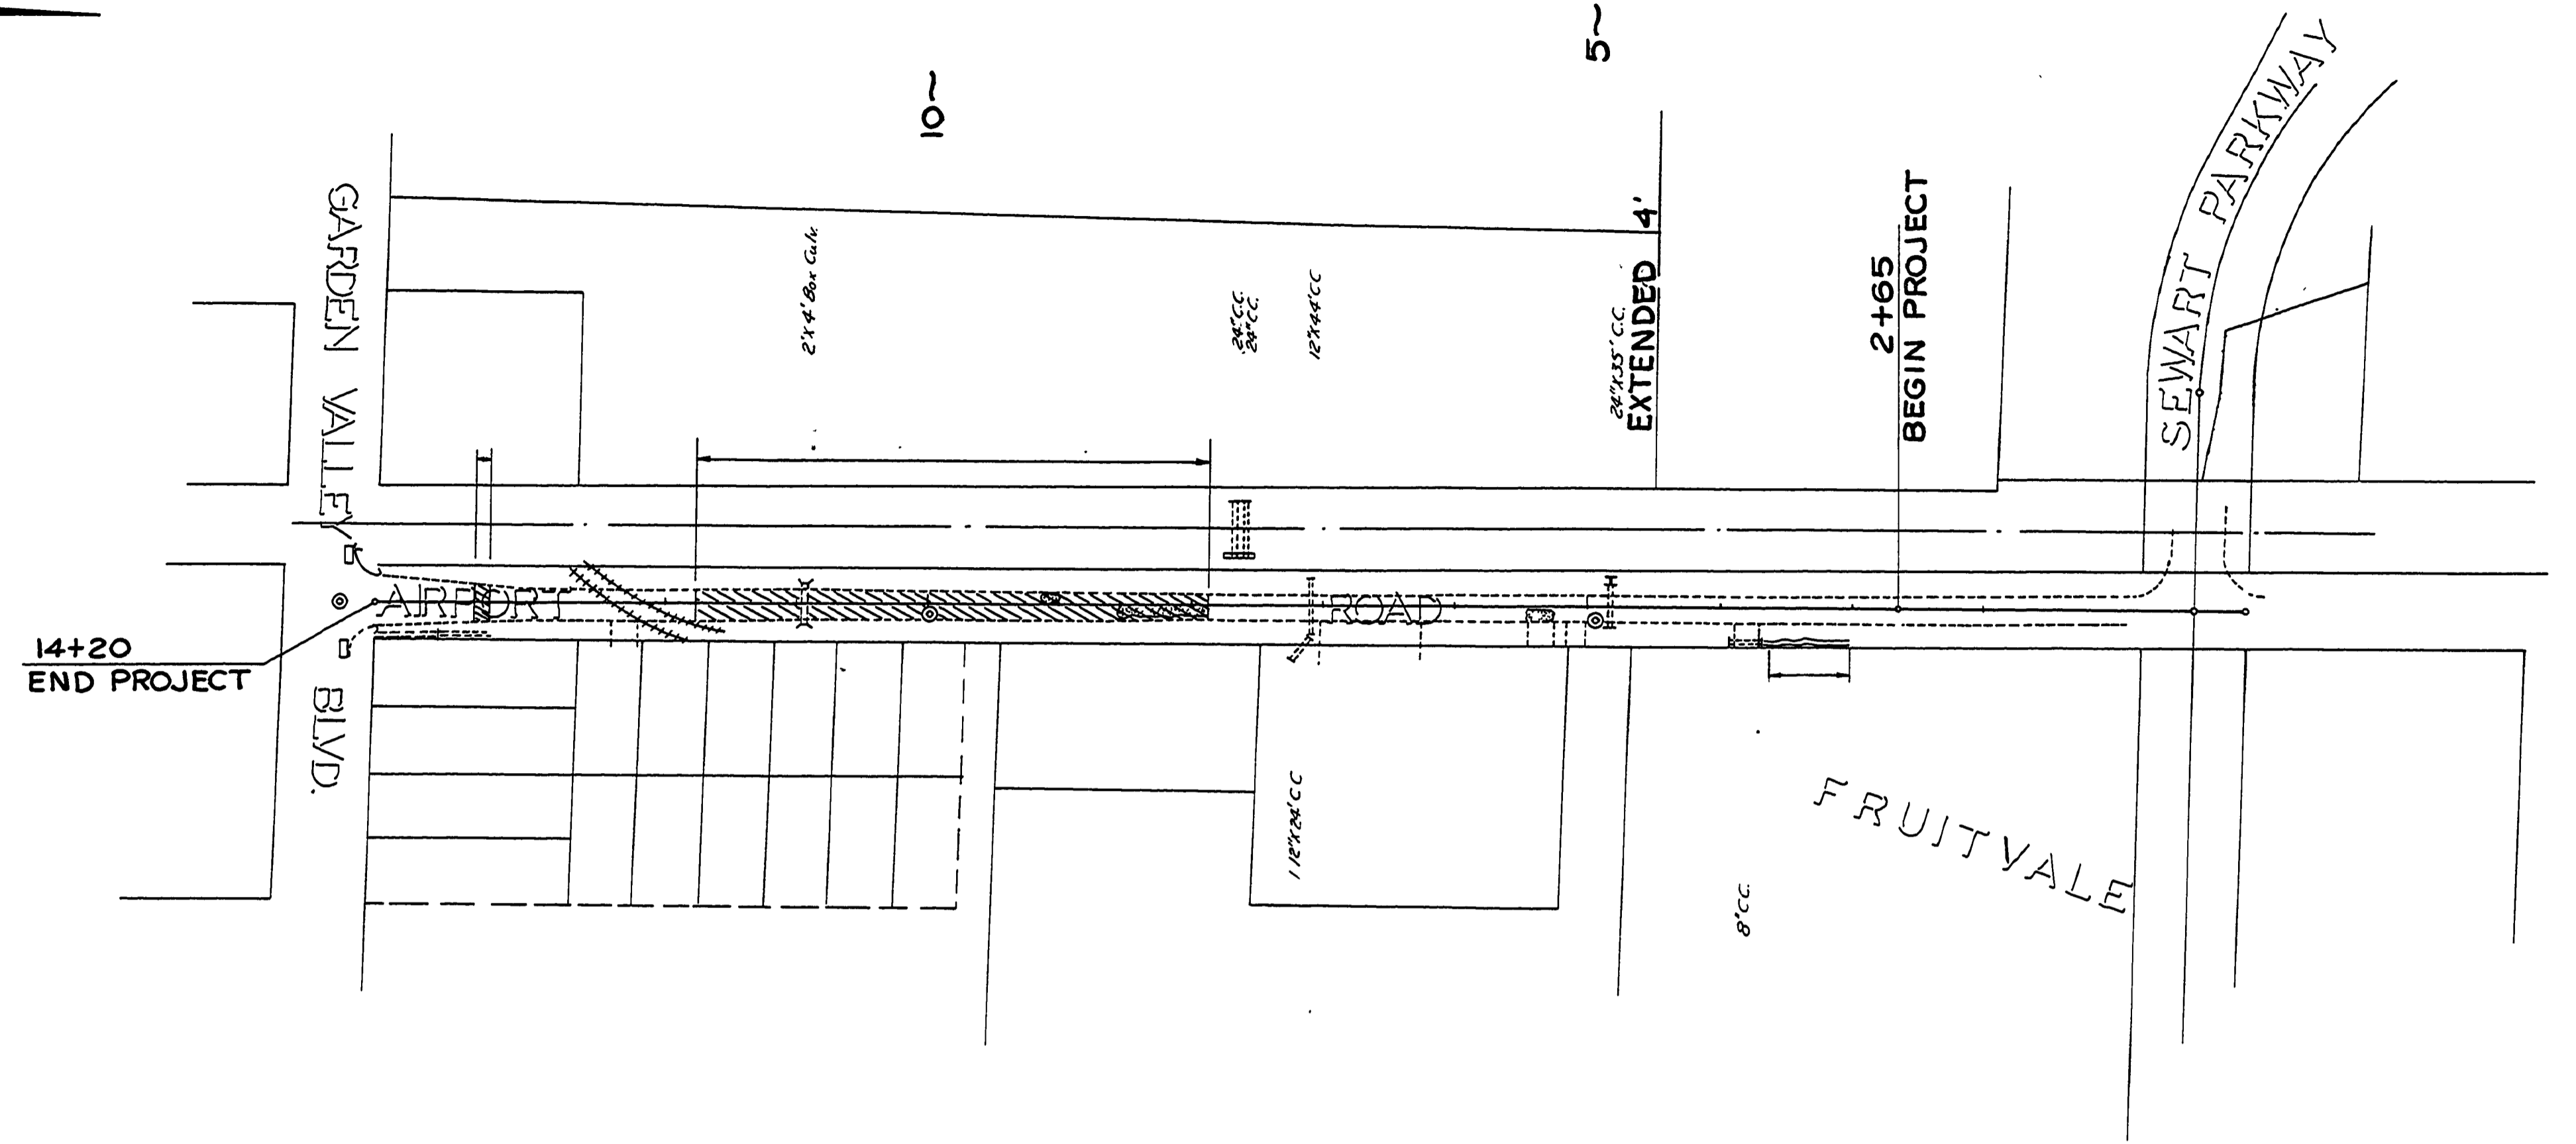

NOTE: DITCH SECTION AS DIRECTED BY ENG.

QUANTITY SUMMARY

ITEM	UNIT	QUANTITY	ALLOWANCE	TOTAL
1. DITCH EXCAVATION	C.Y.	4	1	5
2. RECONDITIONING OLD ROADBED	L-SUM	ALL	—	ALL
3. 1"-0 AGGREGATE BASE	C.Y.	50	10	60
4. CLASS "C" ASPHALT CONCRETE PATCH	TON	89	11	100
5. CLASS "C" ASPHALT CONCRETE	TON	667	63	730
6. R.S. 1 IN TACK COAT	TON	0.39	0.11	0.50
7. ADJUST MANHOLE	EACH	3	2	5
8. 24" CONCRETE CULVERT	L.F.	4	4	8



As CONSTRUCTED
JW 1-11-77
DOUGLAS COUNTY
PUBLIC WORKS DEPARTMENT
AIRPORT ROAD 171
1975 SHT. 17 -
GEORGE E. GRUBB, DIRECTOR

00000026