

SEC 14 T29S R4W W.M.



RD 176

DATE	BY

PLAN	DATE

DATE	BY

PROFILE	DATE

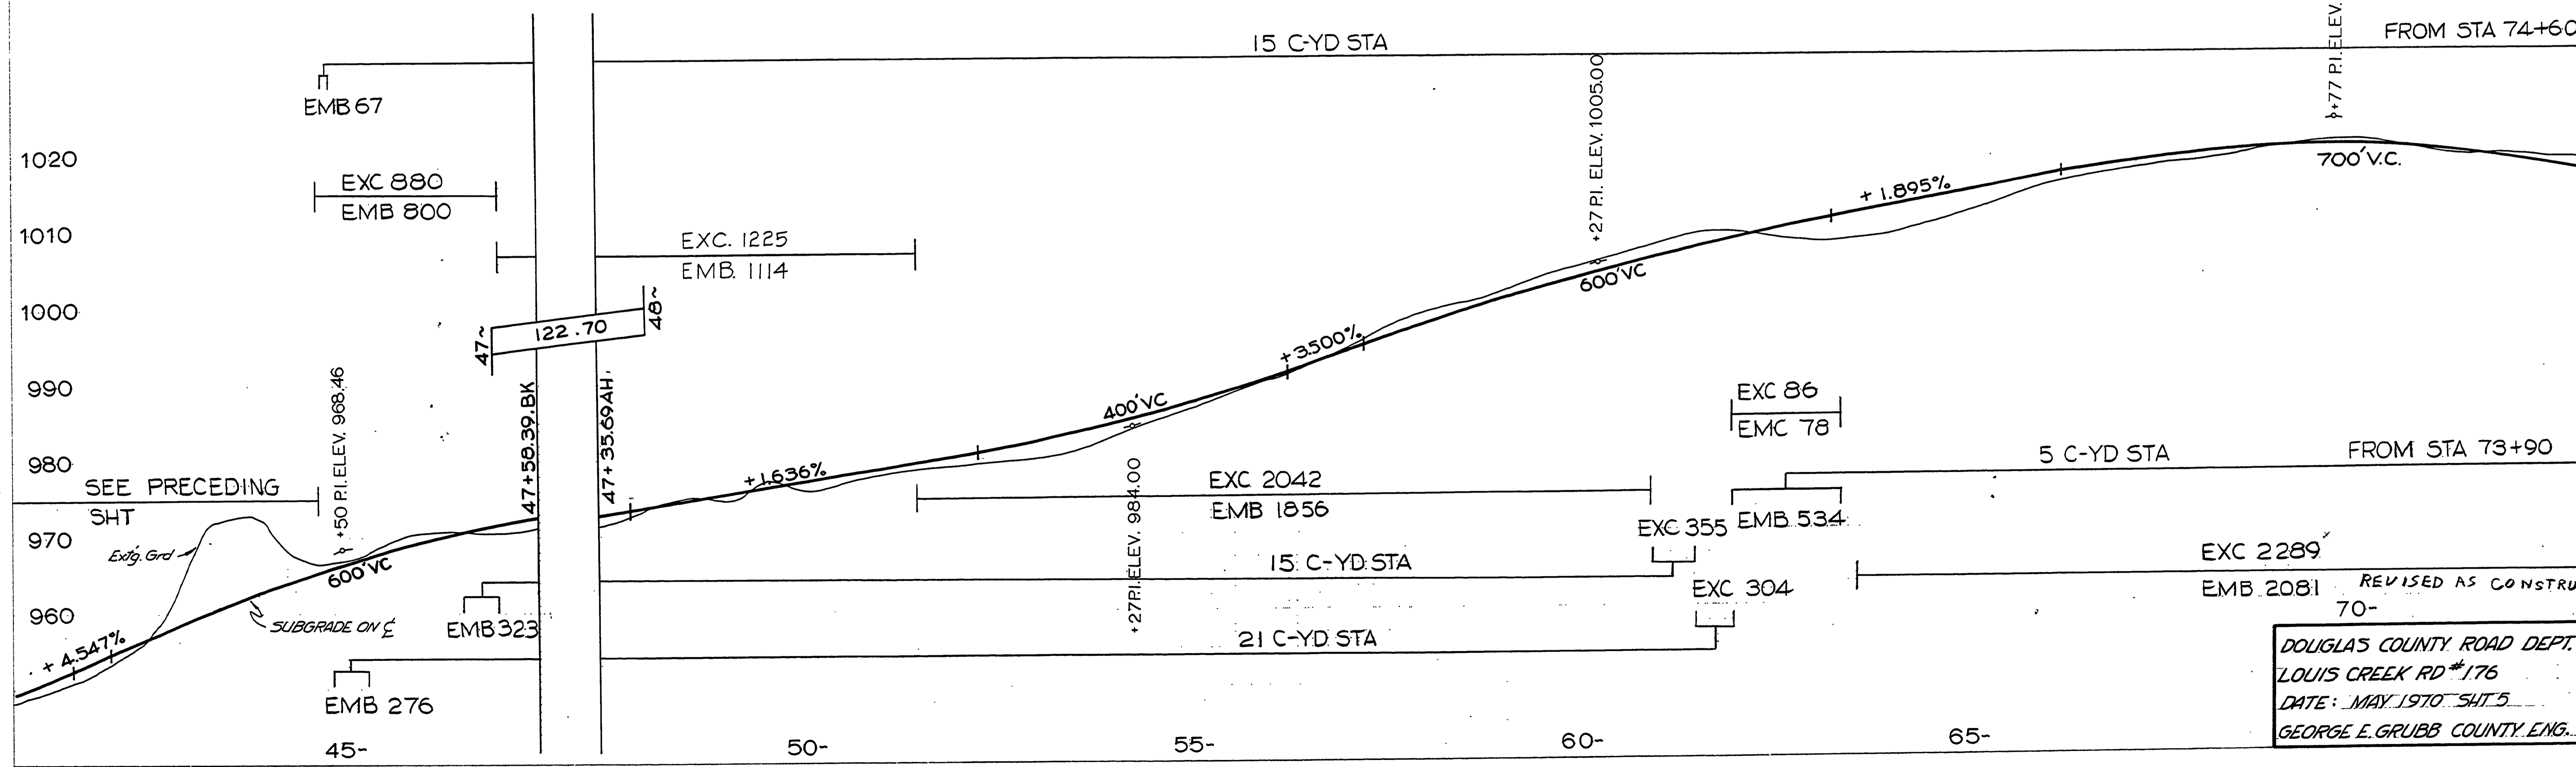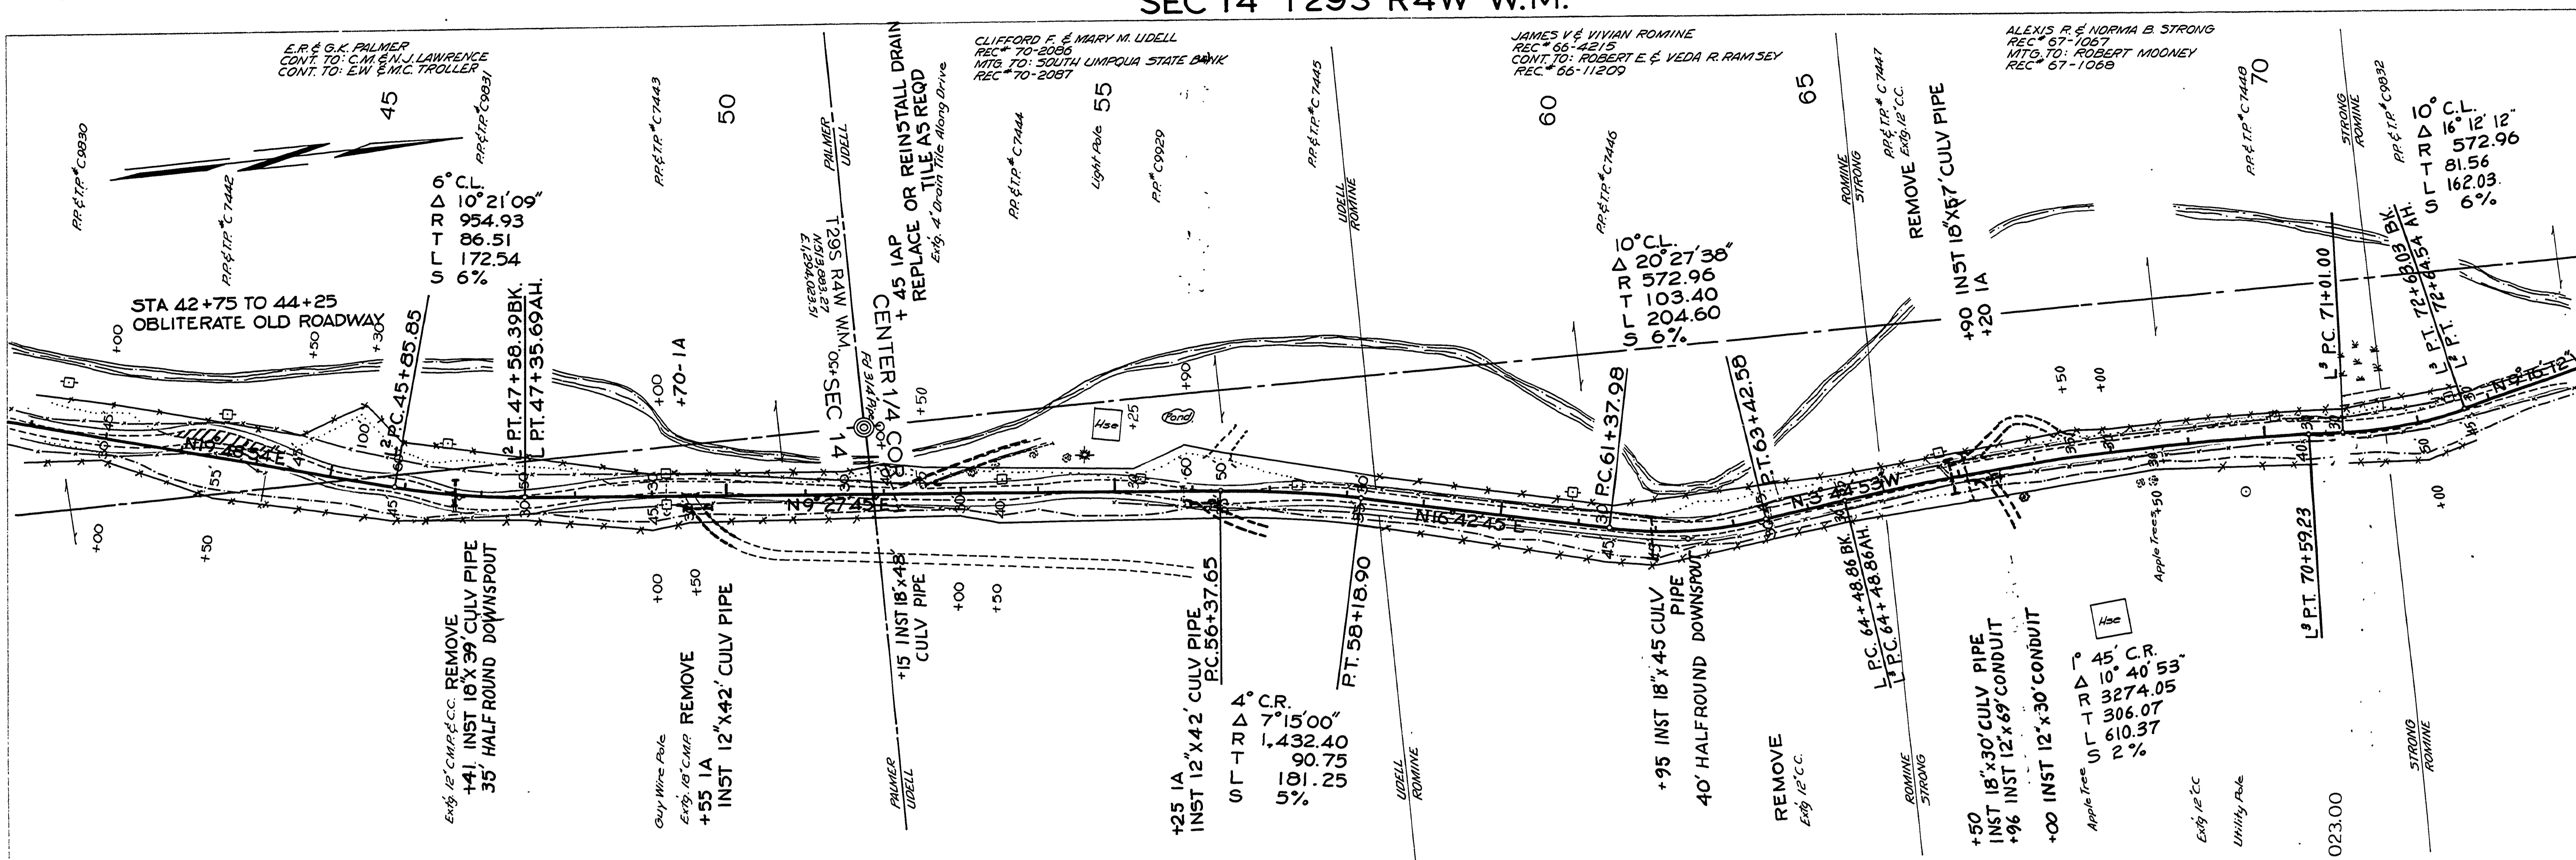

DOUGLAS COUNTY ROAD DEPT.
 LOUIS CREEK RD #176
 DATE: MAY 1970 SHT 5
 GEORGE E. GRUBB COUNTY ENG.

00590121