
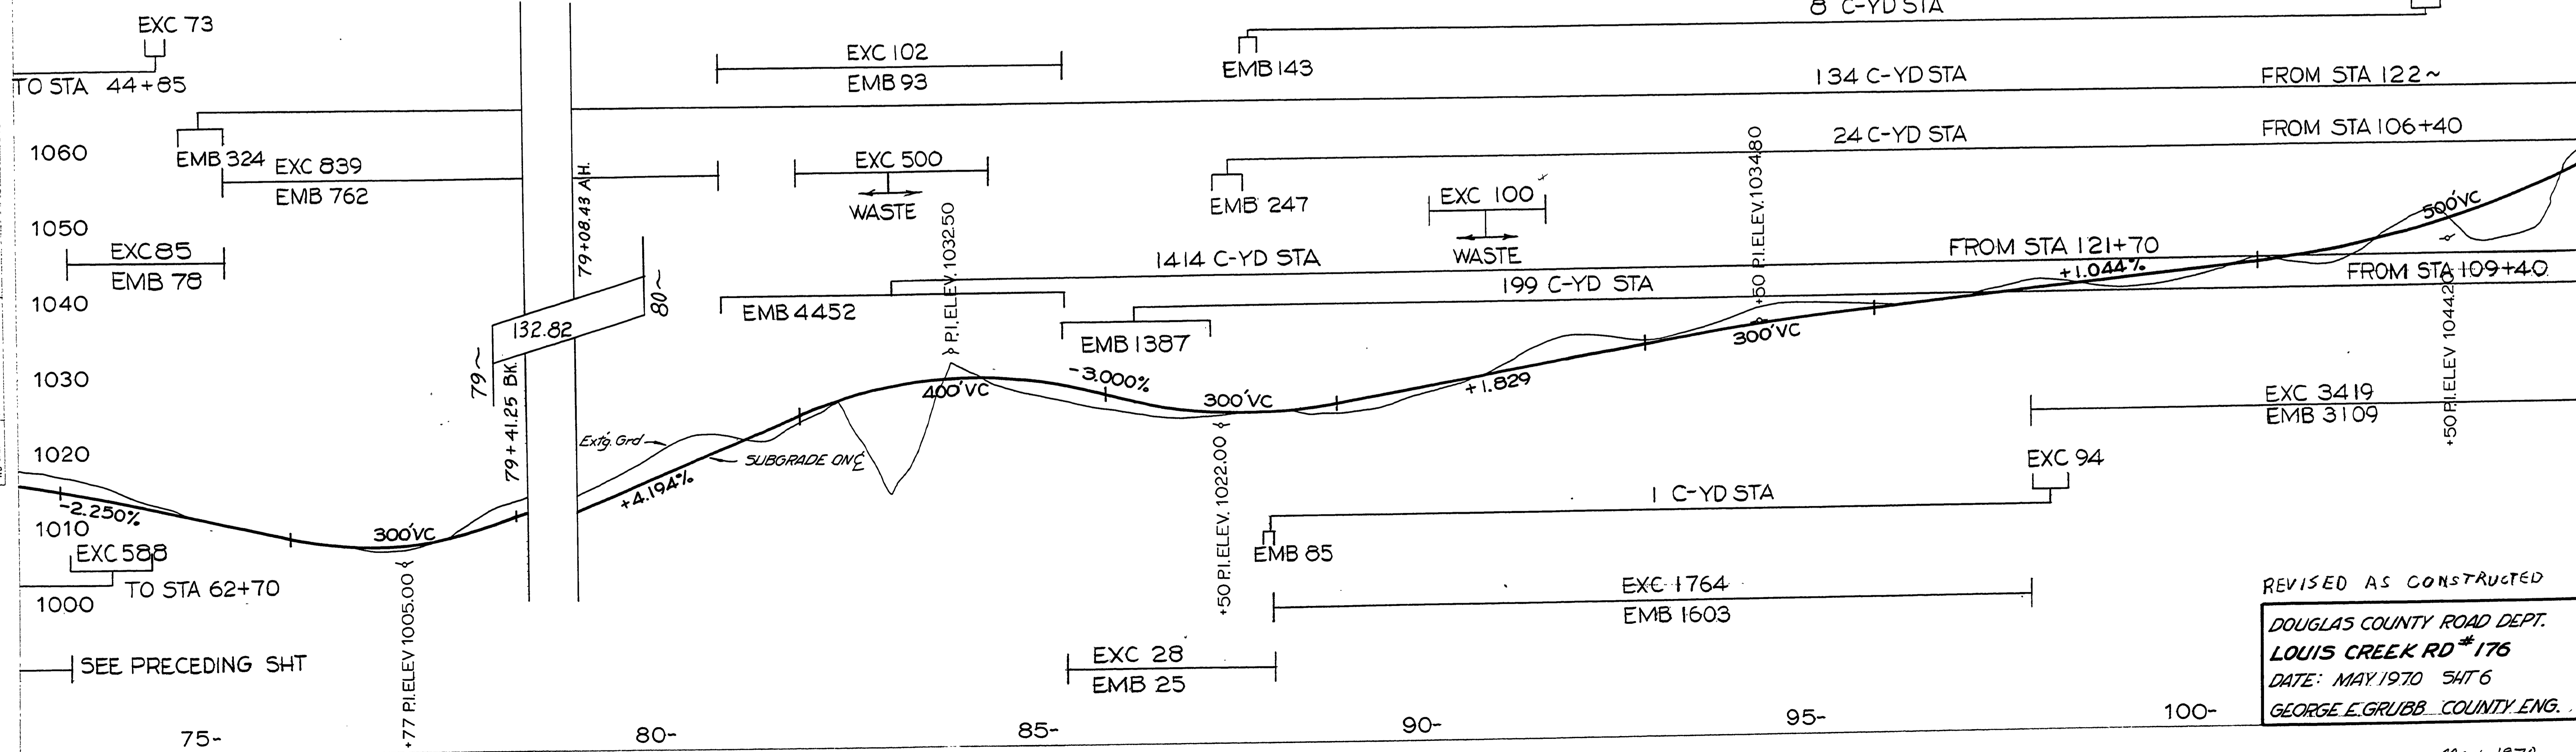


SEC 11.14 T29S R4W W.M.

DATE: \_\_\_\_\_  
 BY: \_\_\_\_\_  
 SURVEYED: \_\_\_\_\_  
 PLAN: \_\_\_\_\_  
 NOTE BOOK: \_\_\_\_\_  
 NO. \_\_\_\_\_

DATE: \_\_\_\_\_  
 BY: \_\_\_\_\_  
 SURVEYED: \_\_\_\_\_  
 PROFILE: \_\_\_\_\_  
 NOTE BOOK: \_\_\_\_\_  
 NO. \_\_\_\_\_

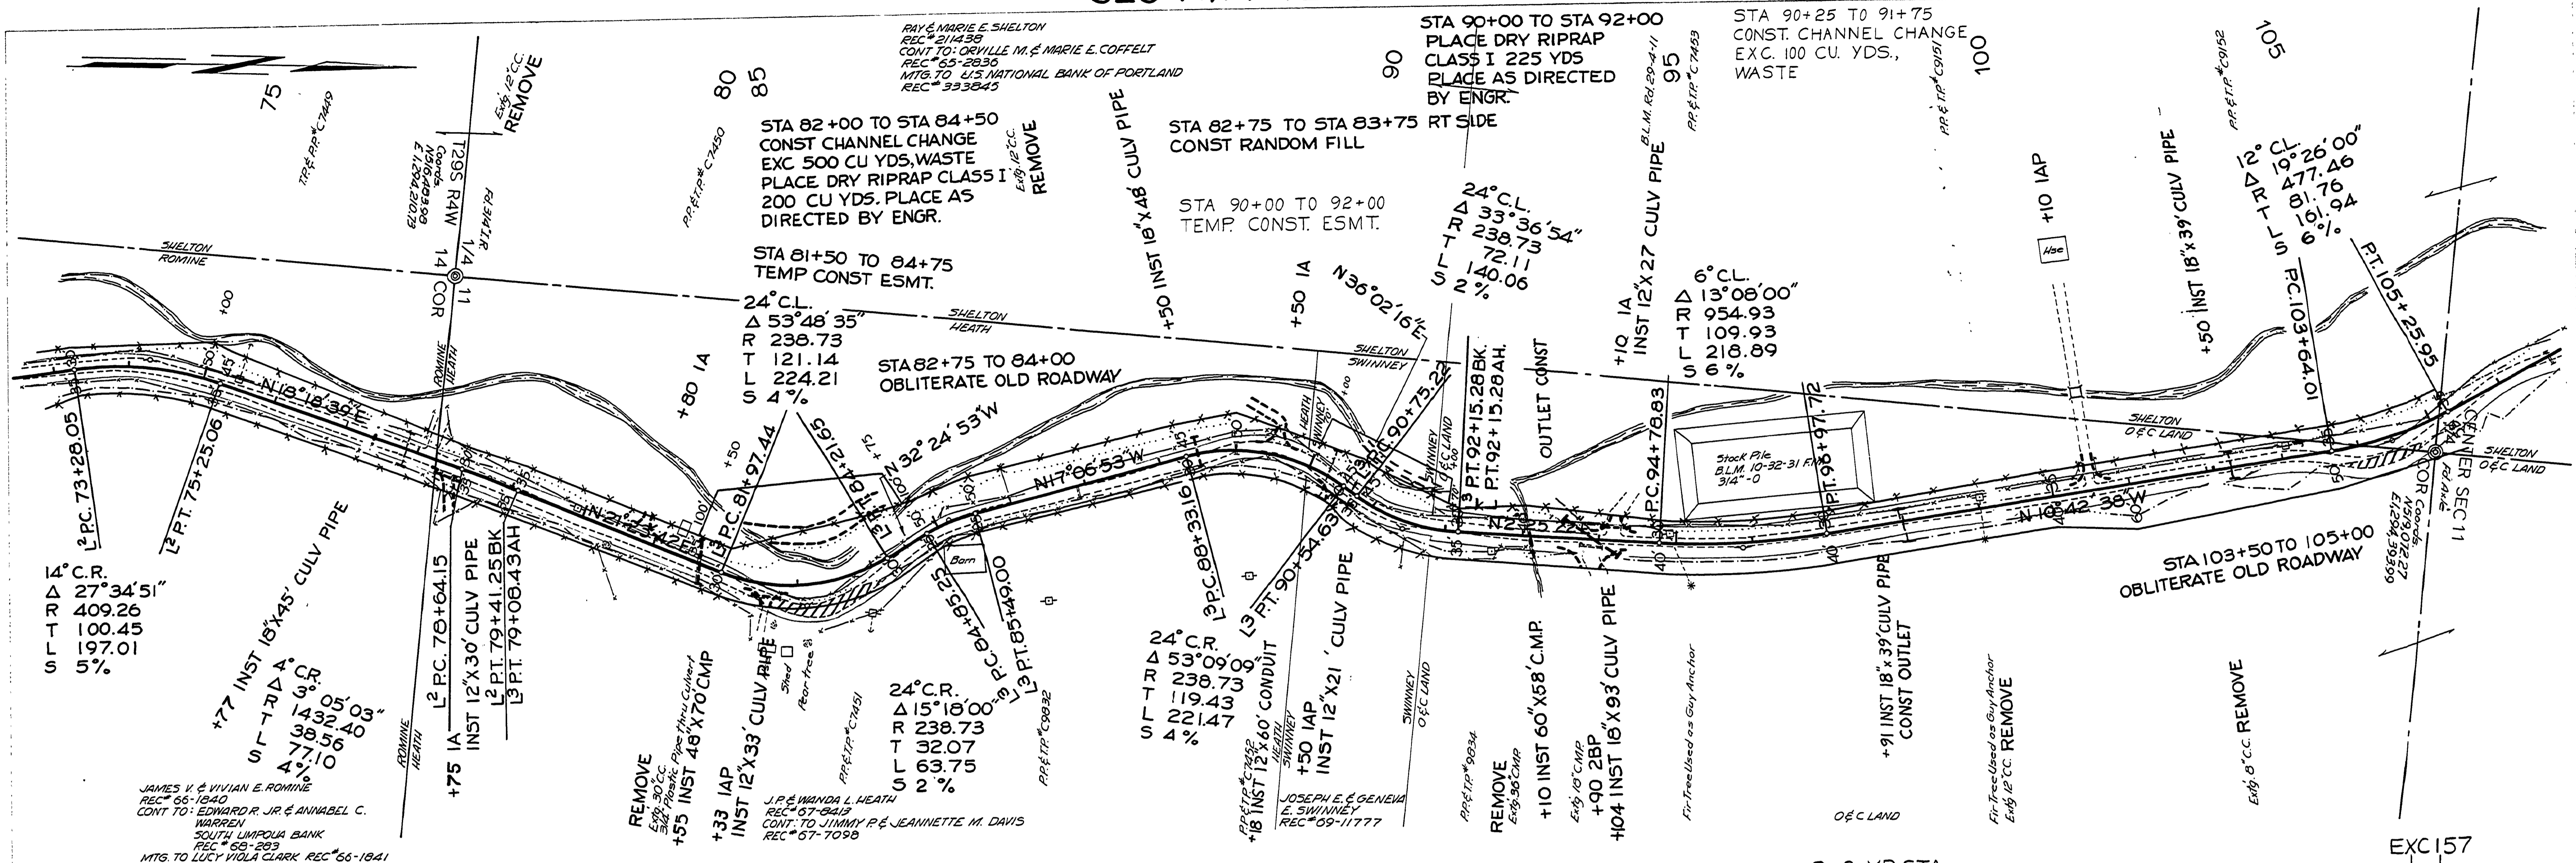

REVISED AS CONSTRUCTED  
 DOUGLAS COUNTY ROAD DEPT.  
 LOUIS CREEK RD # 176  
 DATE: MAY 1970 SHT 6  
 GEORGE E. GRUBB COUNTY ENG.