


MP4


Sec. 2, T33S, R. 7W, W.M.

PLAN	SURVEYED	DATE
	PLOTTED	
	CHECKED	
	BY	
	NO.	

PROFILE	SURVEYED	DATE
	PLOTTED	
	CHECKED	
	BY	
	NO.	

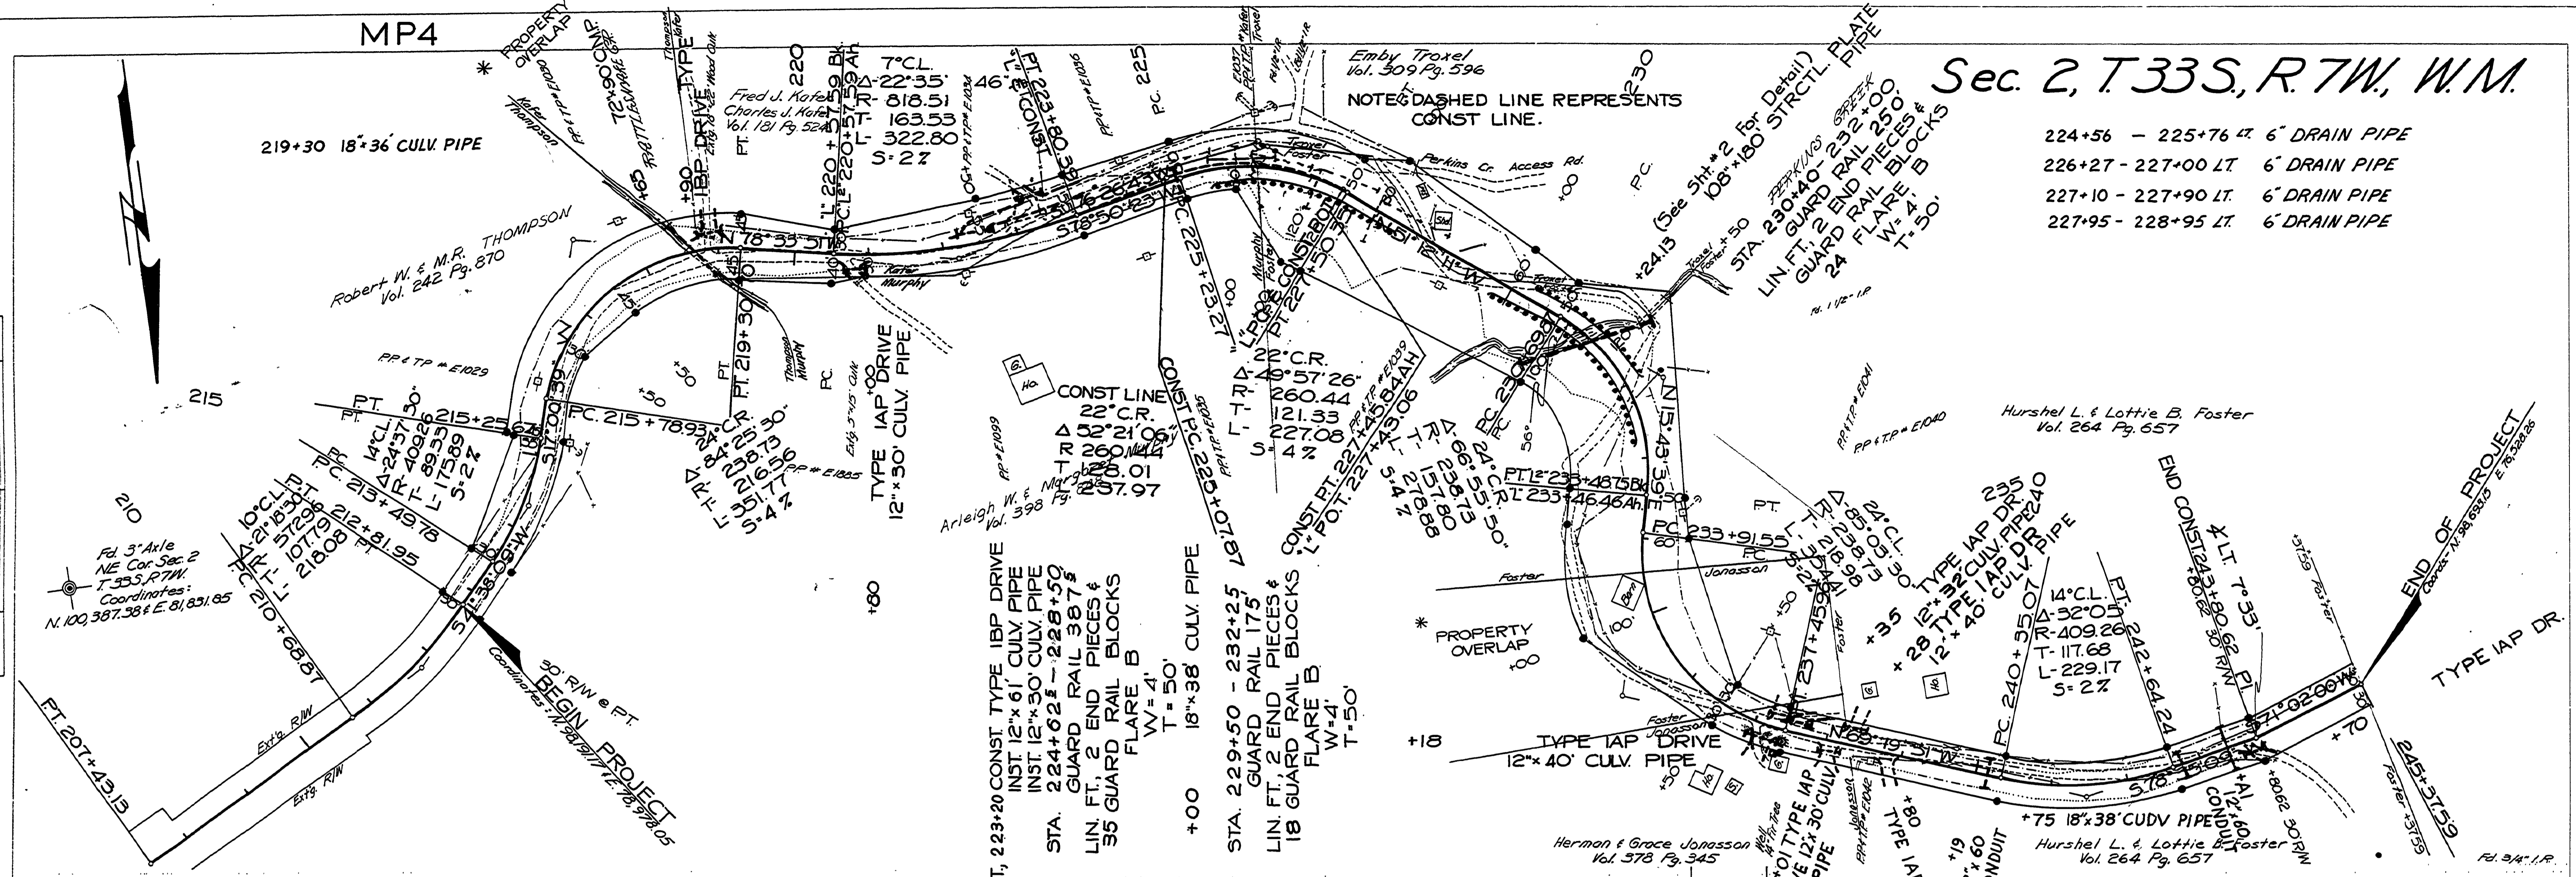

- 224+56 - 225+76 LT 6" DRAIN PIPE
- 226+27 - 227+00 LT 6" DRAIN PIPE
- 227+10 - 227+90 LT 6" DRAIN PIPE
- 227+95 - 228+95 LT 6" DRAIN PIPE

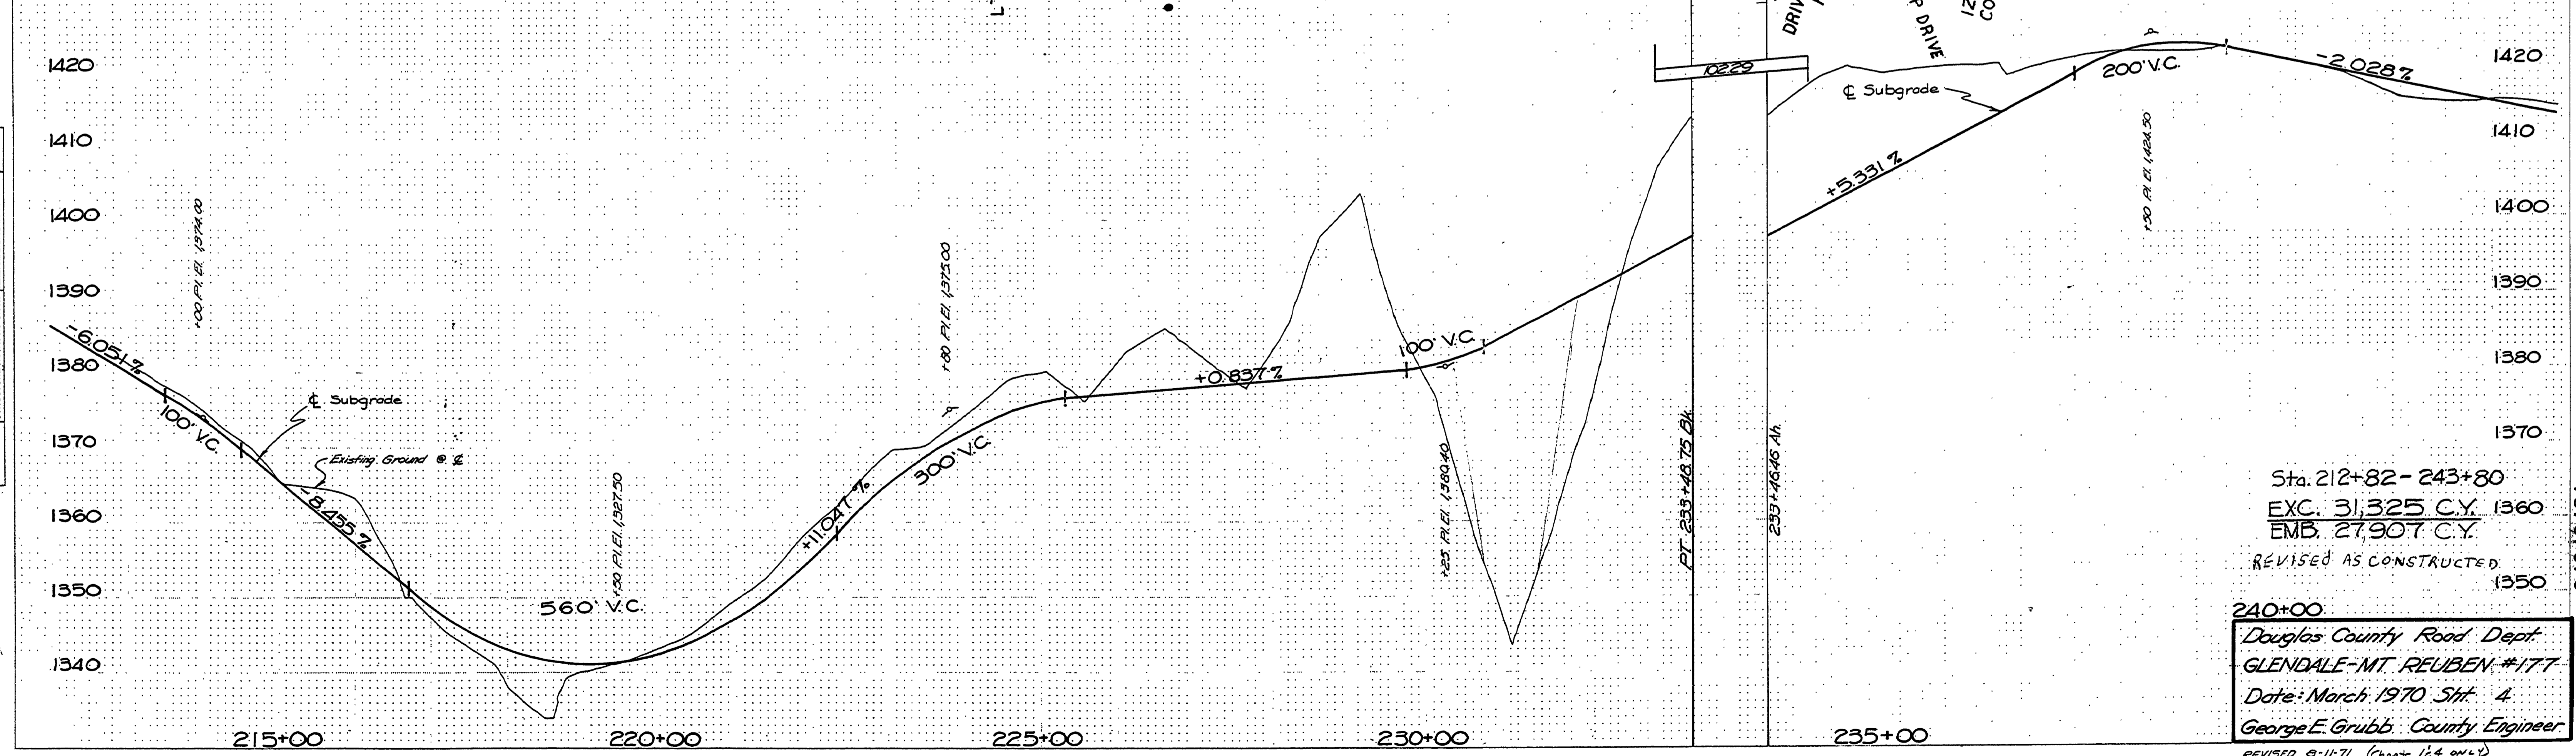

Sta. 212+82 - 243+80
 EXC. 31,325 C.Y. 1360
 EMB. 27,907 C.Y.
 REVISED AS CONSTRUCTED
 1350

240+00
 Douglas County Road Dept.
 GLENDALE-MT. REUBEN #177
 Date: March, 1970 Sht. 4
 George E. Grubb, County Engineer