


VICINITY MAP

# DOUGLAS COUNTY OREGON AS CONSTRUCTED GRADING & SURFACING FISHER ROAD #189

JULY 1965

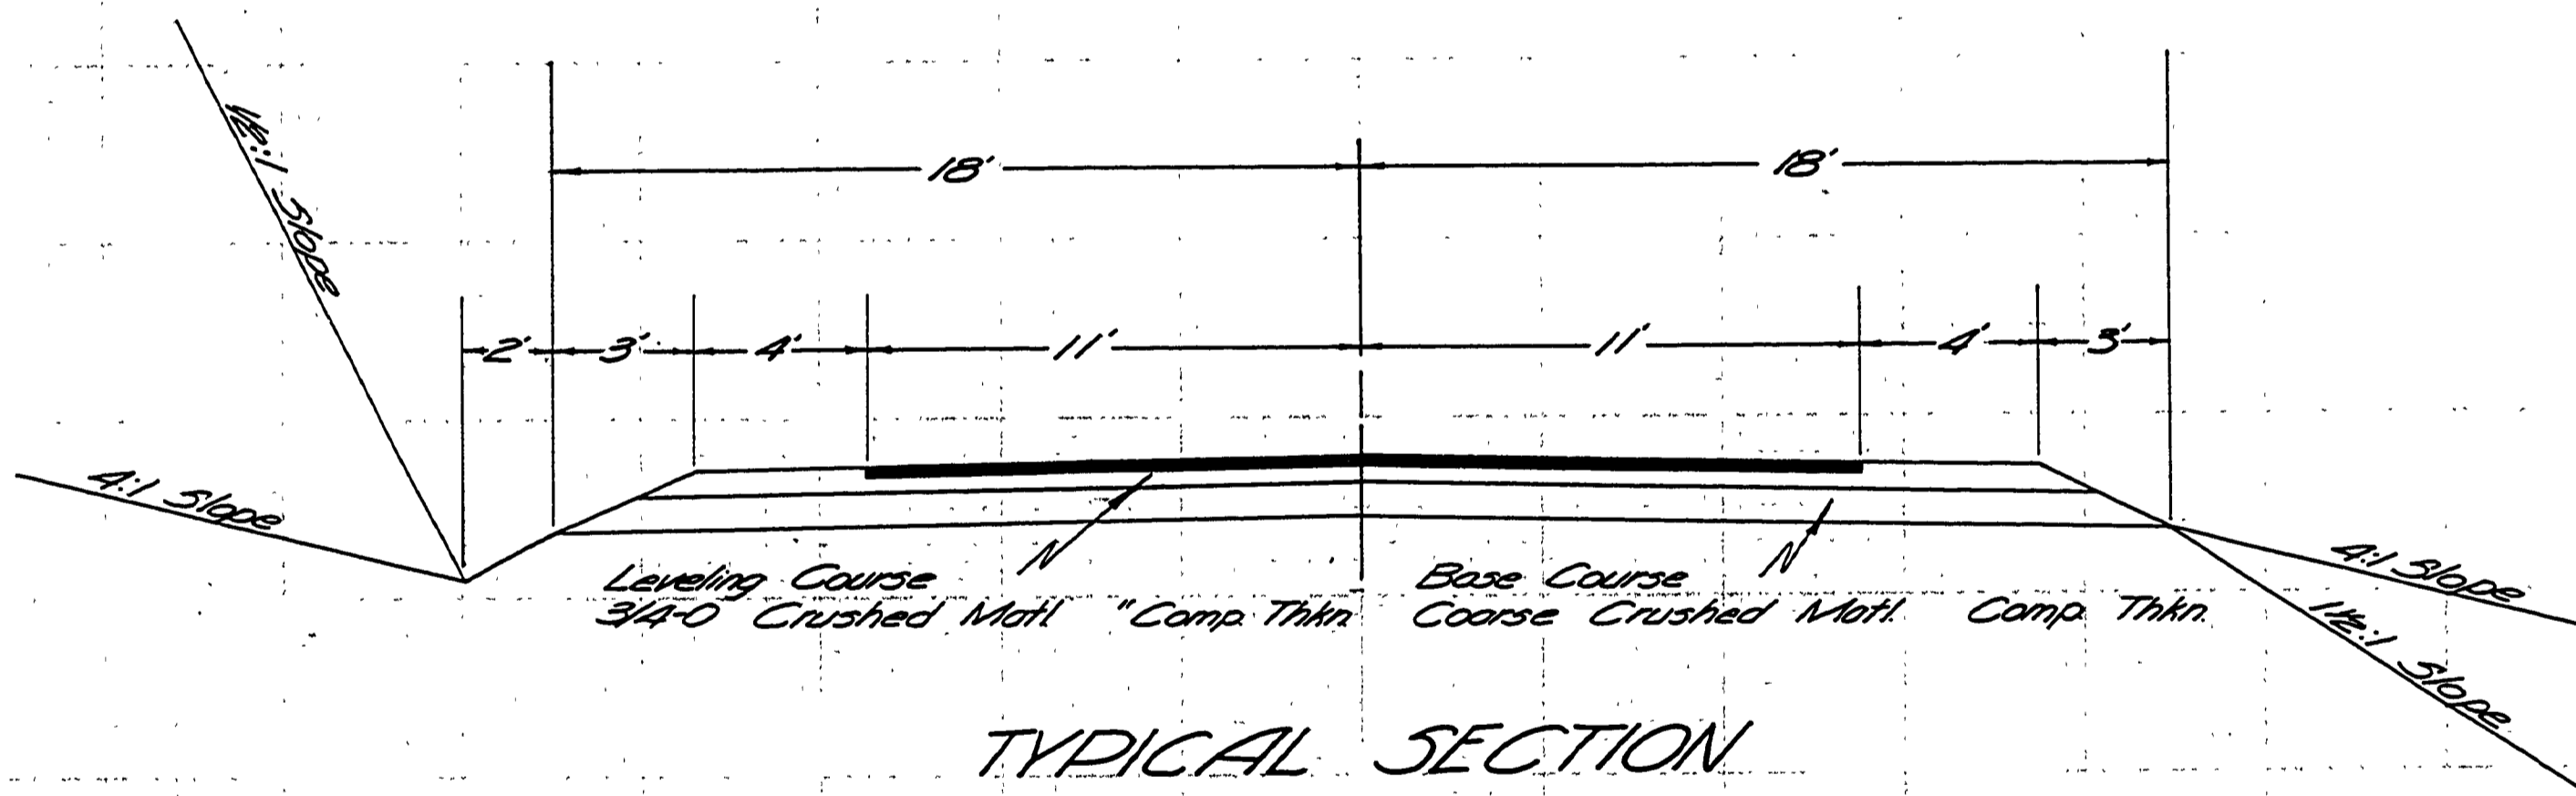

FILED  
RECEIVED  
APR 4 1965  
COUNTY SURVEYOR  
DOUGLAS COUNTY, OREGON

6/25/65

G.R. #189

SHEET 1 of 3

10000016

2