
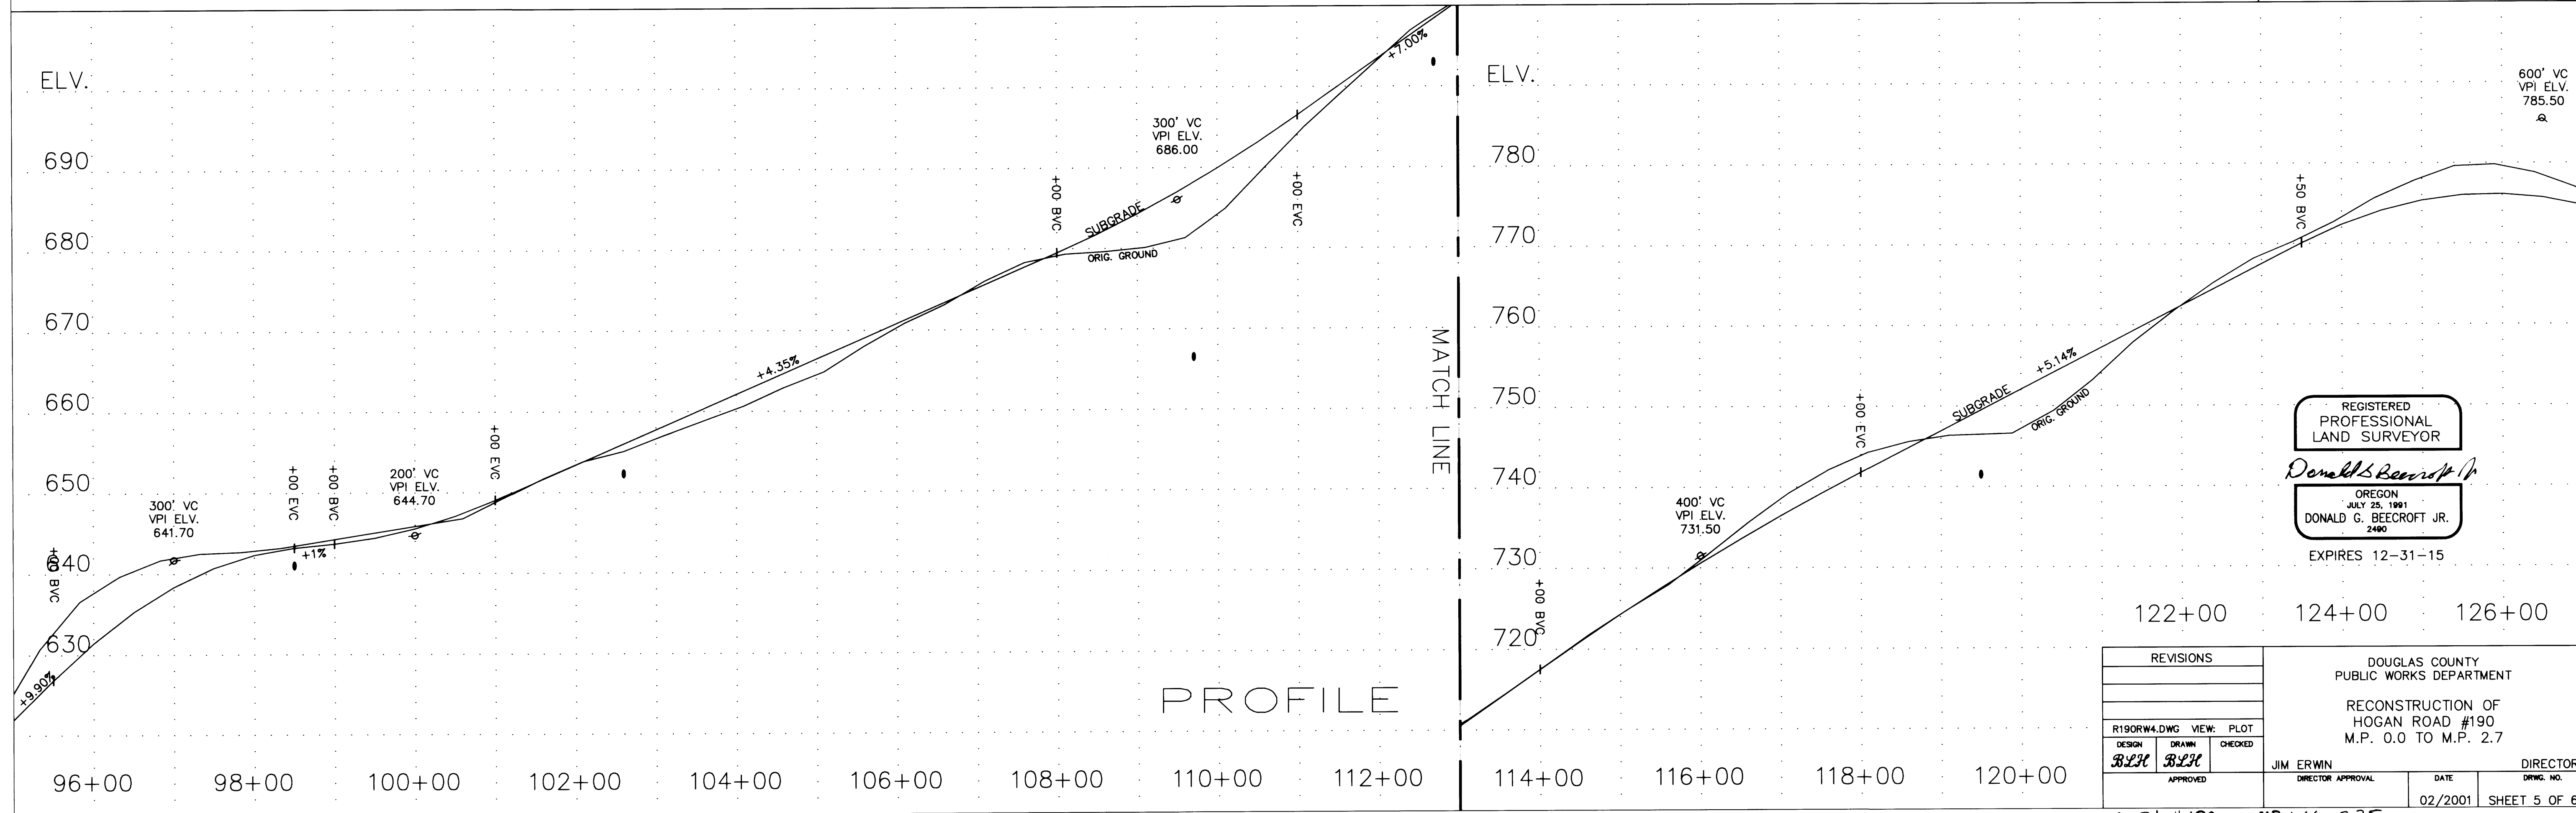


FILED
 Date: 12/17/2014 By: JC
 This survey consists of:
 Map: CO RD 190
 Narrative:
 Corner Rpt: L.P.S.
 DOUGLAS COUNTY SURVEYOR

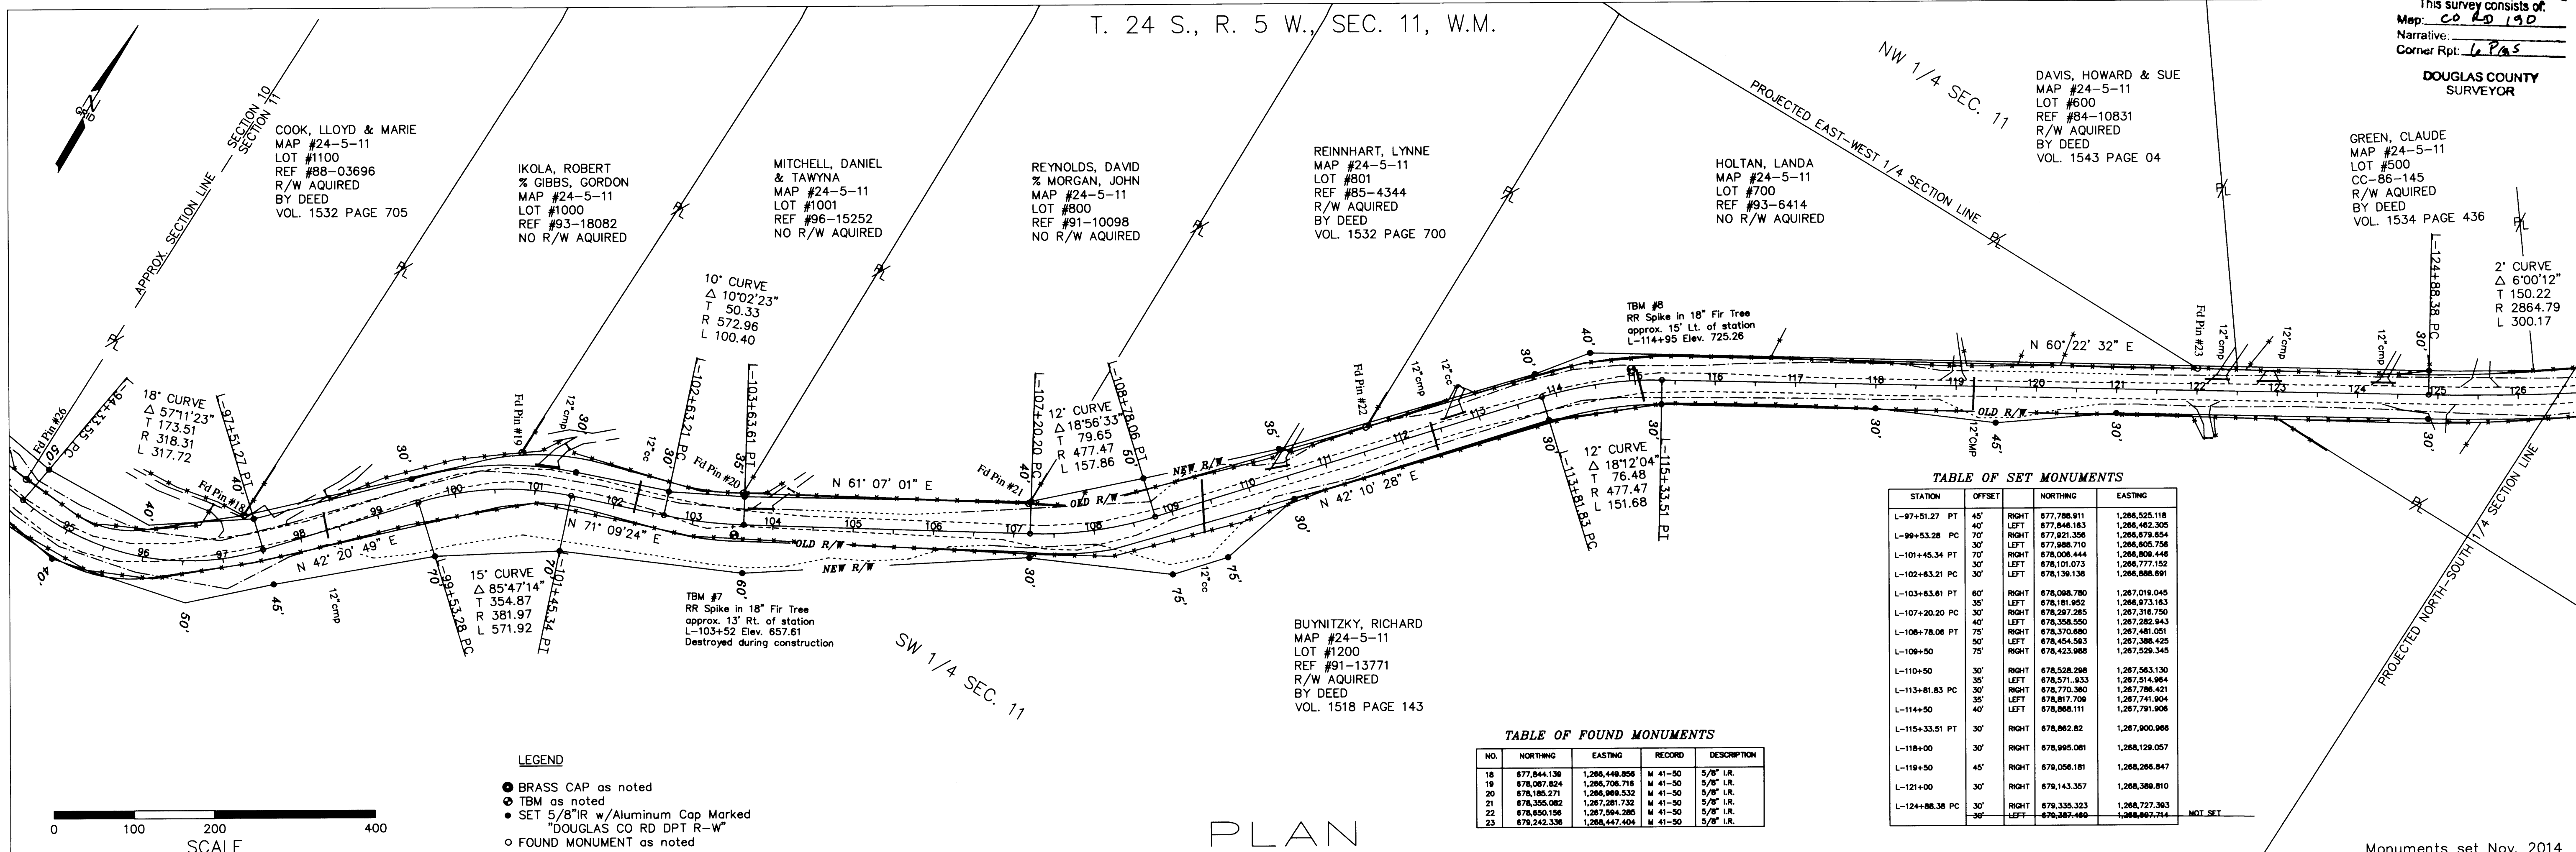

CO. RD. # 190.

01660235