


FINAL SURVEY
 SURVEYED BY
 WALLY M. HECTOR
 DATE
 1954
 SHEET NO.
 4

ORIGINAL SURVEY
 SURVEYED BY
 WALLY M. HECTOR
 DATE
 1954
 SHEET NO.
 4

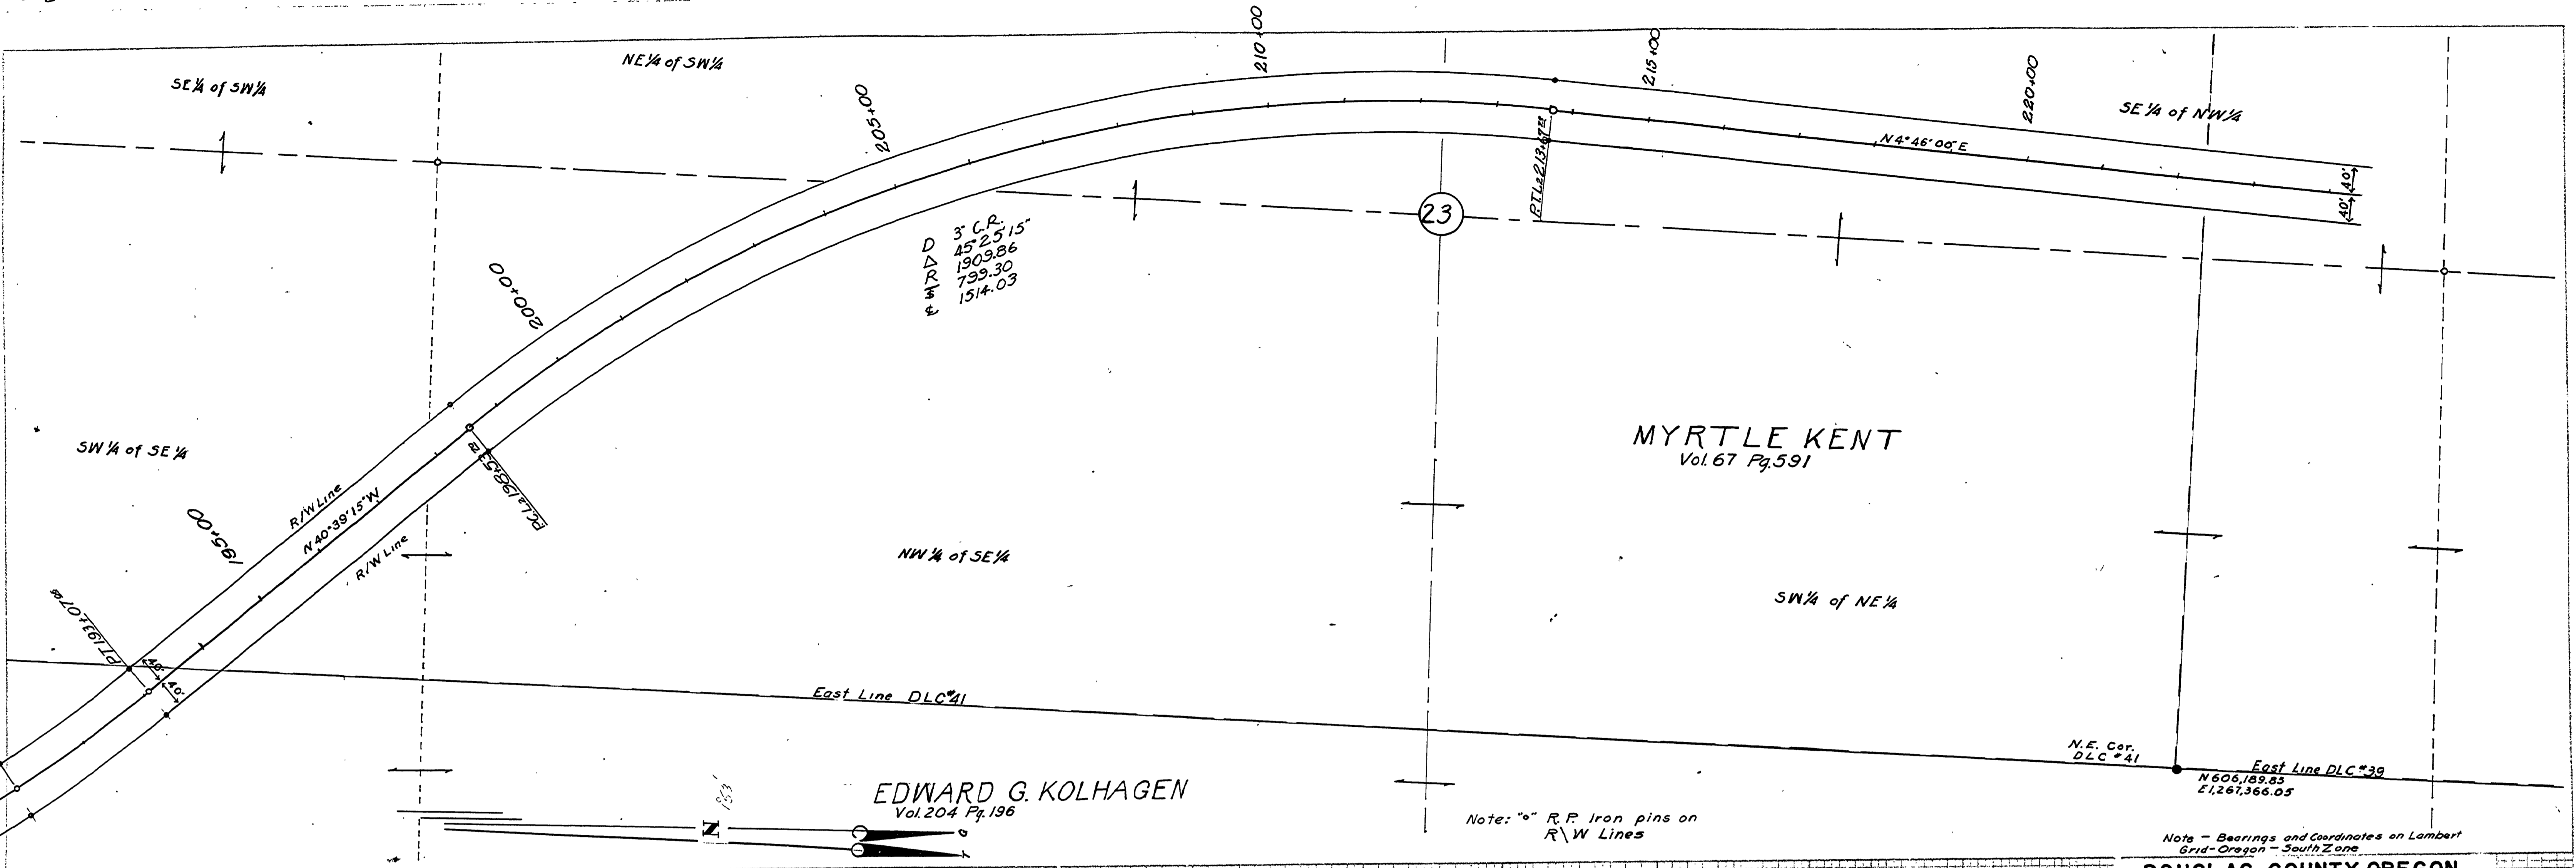

Note - Bearings and Coordinates on Lambert Grid - Oregon - South Zone

DOUGLAS COUNTY, OREGON
ROAD NO. 200

TWP. 26 S. Date 1954
 RNG. 5 W. Sheet No. 4
 SEC. 23 of ___ Sheets
 Scales: Map 1"=100'
 Profile: Hor. 1"=100'
 Vert. 1"=10'
 WALLY M. HECTOR COUNTY ENG.



LATE 4-CROSS SECTION O.P.R.S.R.E. STANDARD
 KEUFFEL & ESSER CO., NEW YORK

K.E. Co. No. 348-4C

M.P. 7.49-6.92

07490692