


NEW AIRPORT COUNTY RD.
 NO. 217
 ADOPTED BY RESOLUTION
 OF THE COUNTY COURT
 SHOWN IN RED 1955

Cliff
 COUNTY JUDGE

W. Matson
 COUNTY COMM.

Joseph A. W.
 COUNTY COMM.

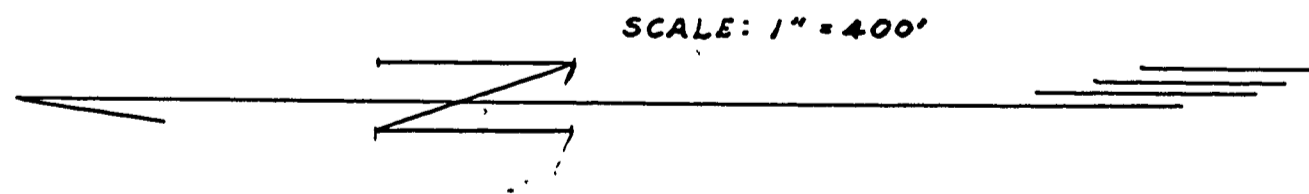

FILED
 RECEIVED
 JUN 3 1955
 COUNTY SURVEYOR
 WHEELER COUNTY, ORE.

M.P. 0.00 - 0.50

Co. Rd. # 217A 1955
 one sheet (51)

00000050

