

SURVEYING & ENGINEERING, INC.
ENGINEERING • SURVEYING • PLANNING

AAA

3076 NE DIAMOND LAKE BLVD.
ROSEBURG, OREGON 97470
TEL (541)972-2086
FAX (541)972-0611

Revision	Date
Revision	Date

Drawn	STAFF
Design	SSS
Checked	SSS
Reviewed	SSS

AA PROJECT# 8078.02 09/16/03

TITLE: **SUBDIVISION LOT LAYOUT & GRADING PLAN**

PROJECT NAME: **WINNGATE SUBDIVISION GREEN DISTRICT, OREGON**

SHT.	2
OF	7


246BGRAD

**GEORGINA DRIVE
(R/W 60')**


**STELLA STREET
(R/W 60')**

PASADENA COURT

**WINNGATE COURT
(R/W 54')**

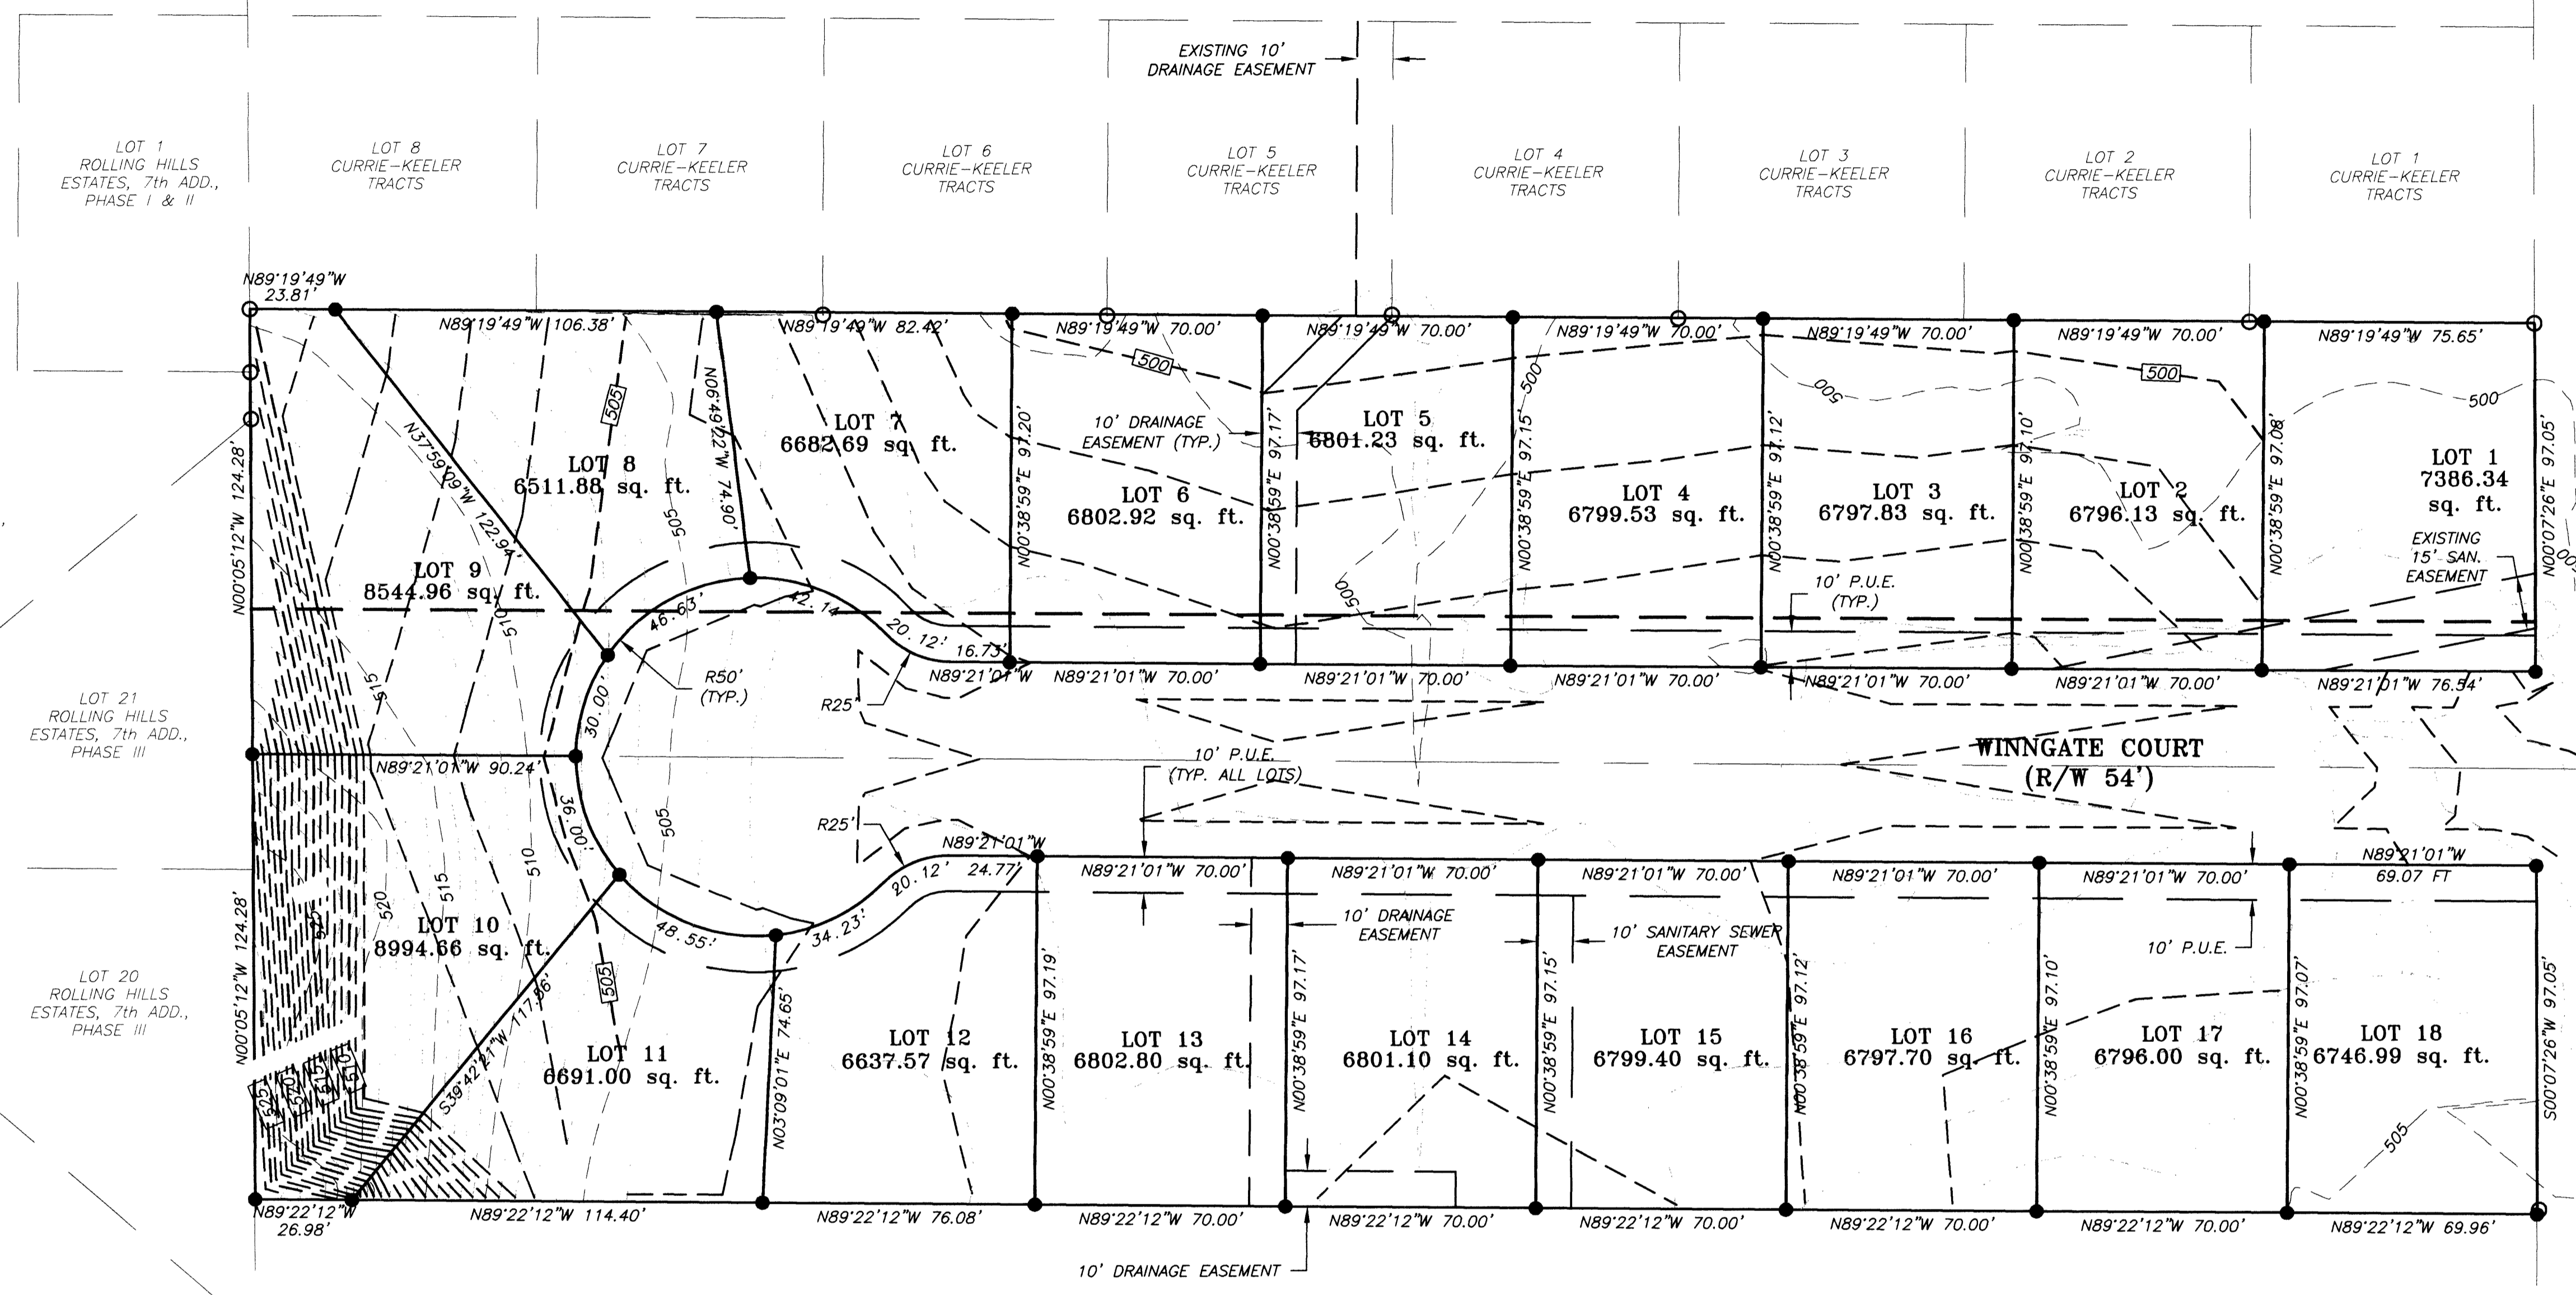

TAX LOT 3500
T.28S., R.06W.,
SEC 10AC

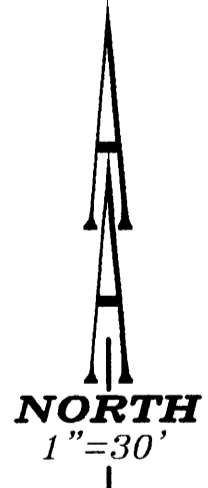

POST CONSTRUCTION DRAWINGS

THESE DRAWINGS REPRESENT THE CONSTRUCTION WORK AS NEAR AS CAN BE DETERMINED. THEY WERE PREPARED FROM INFORMATION GATHERED DURING CONSTRUCTION ACTIVITY BY THE CONTRACTORS AND INSPECTORS AND ARE THOUGHT TO BE ACCURATE. HOWEVER NO GUARANTEE OR WARRANTY IS EXPRESSED OR IMPLIED AS TO THEIR EXACTNESS AND THEY SHOULD BE USED ONLY AS A GENERAL REPRESENTATION OF THE CONSTRUCTION WORKS.

ATTENTION: OREGON LAW REQUIRES YOU TO FOLLOW RULES ADOPTED BY THE OREGON UTILITY NOTIFICATION CENTER. THOSE RULES ARE SET FORTH IN OAR 952-001-0010 THROUGH 952-001-0090. YOU MAY OBTAIN COPIES OF THE RULES BY CALLING THE CENTER AT 1-800-332-2344. CALL BEFORE YOU DIG.