


FILED
 Date: 3/17/2008 By: K
 This survey consists of:
 Map: CO RD 246C
 Narrative:
 Corner Rpt: 3 pgs
 DOUGLASS COUNTY
 SURVEYOR

OWNER: **ERIK HELLENTHAL**
 ENGINEERING & SURVEYING INC.
 415 S.E. MAIN ST. ROSELAND, OR 97068
 PHONE (503) 973-5996 FAX (503) 973-0105
BTS

ORCHARD MEADOWS ESTATES
 STREET DESIGN PLAN & PROFILE

PROJECT: **ORCHARD MEADOWS ESTATES**
 SHEET TITLE: **STREET DESIGN PLAN & PROFILE**
 DATE: MAY 3, 2006
 REV. #1: JUNE 23, 2006
 REV. #2: JULY 12, 2006
 REV. #3: -
 REV. #4: -
 REV. #5: -




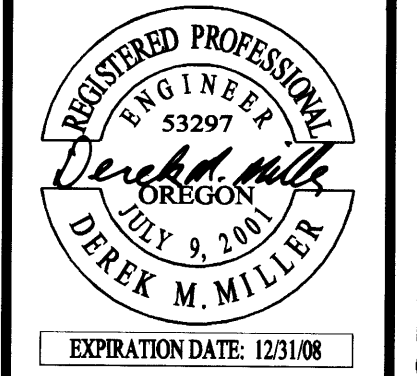


PROJ. #97-031
 SHEET NO.

ST1 of 1

Co. Rd. # 246C MP 0.00 - 0.07

246CPPRF

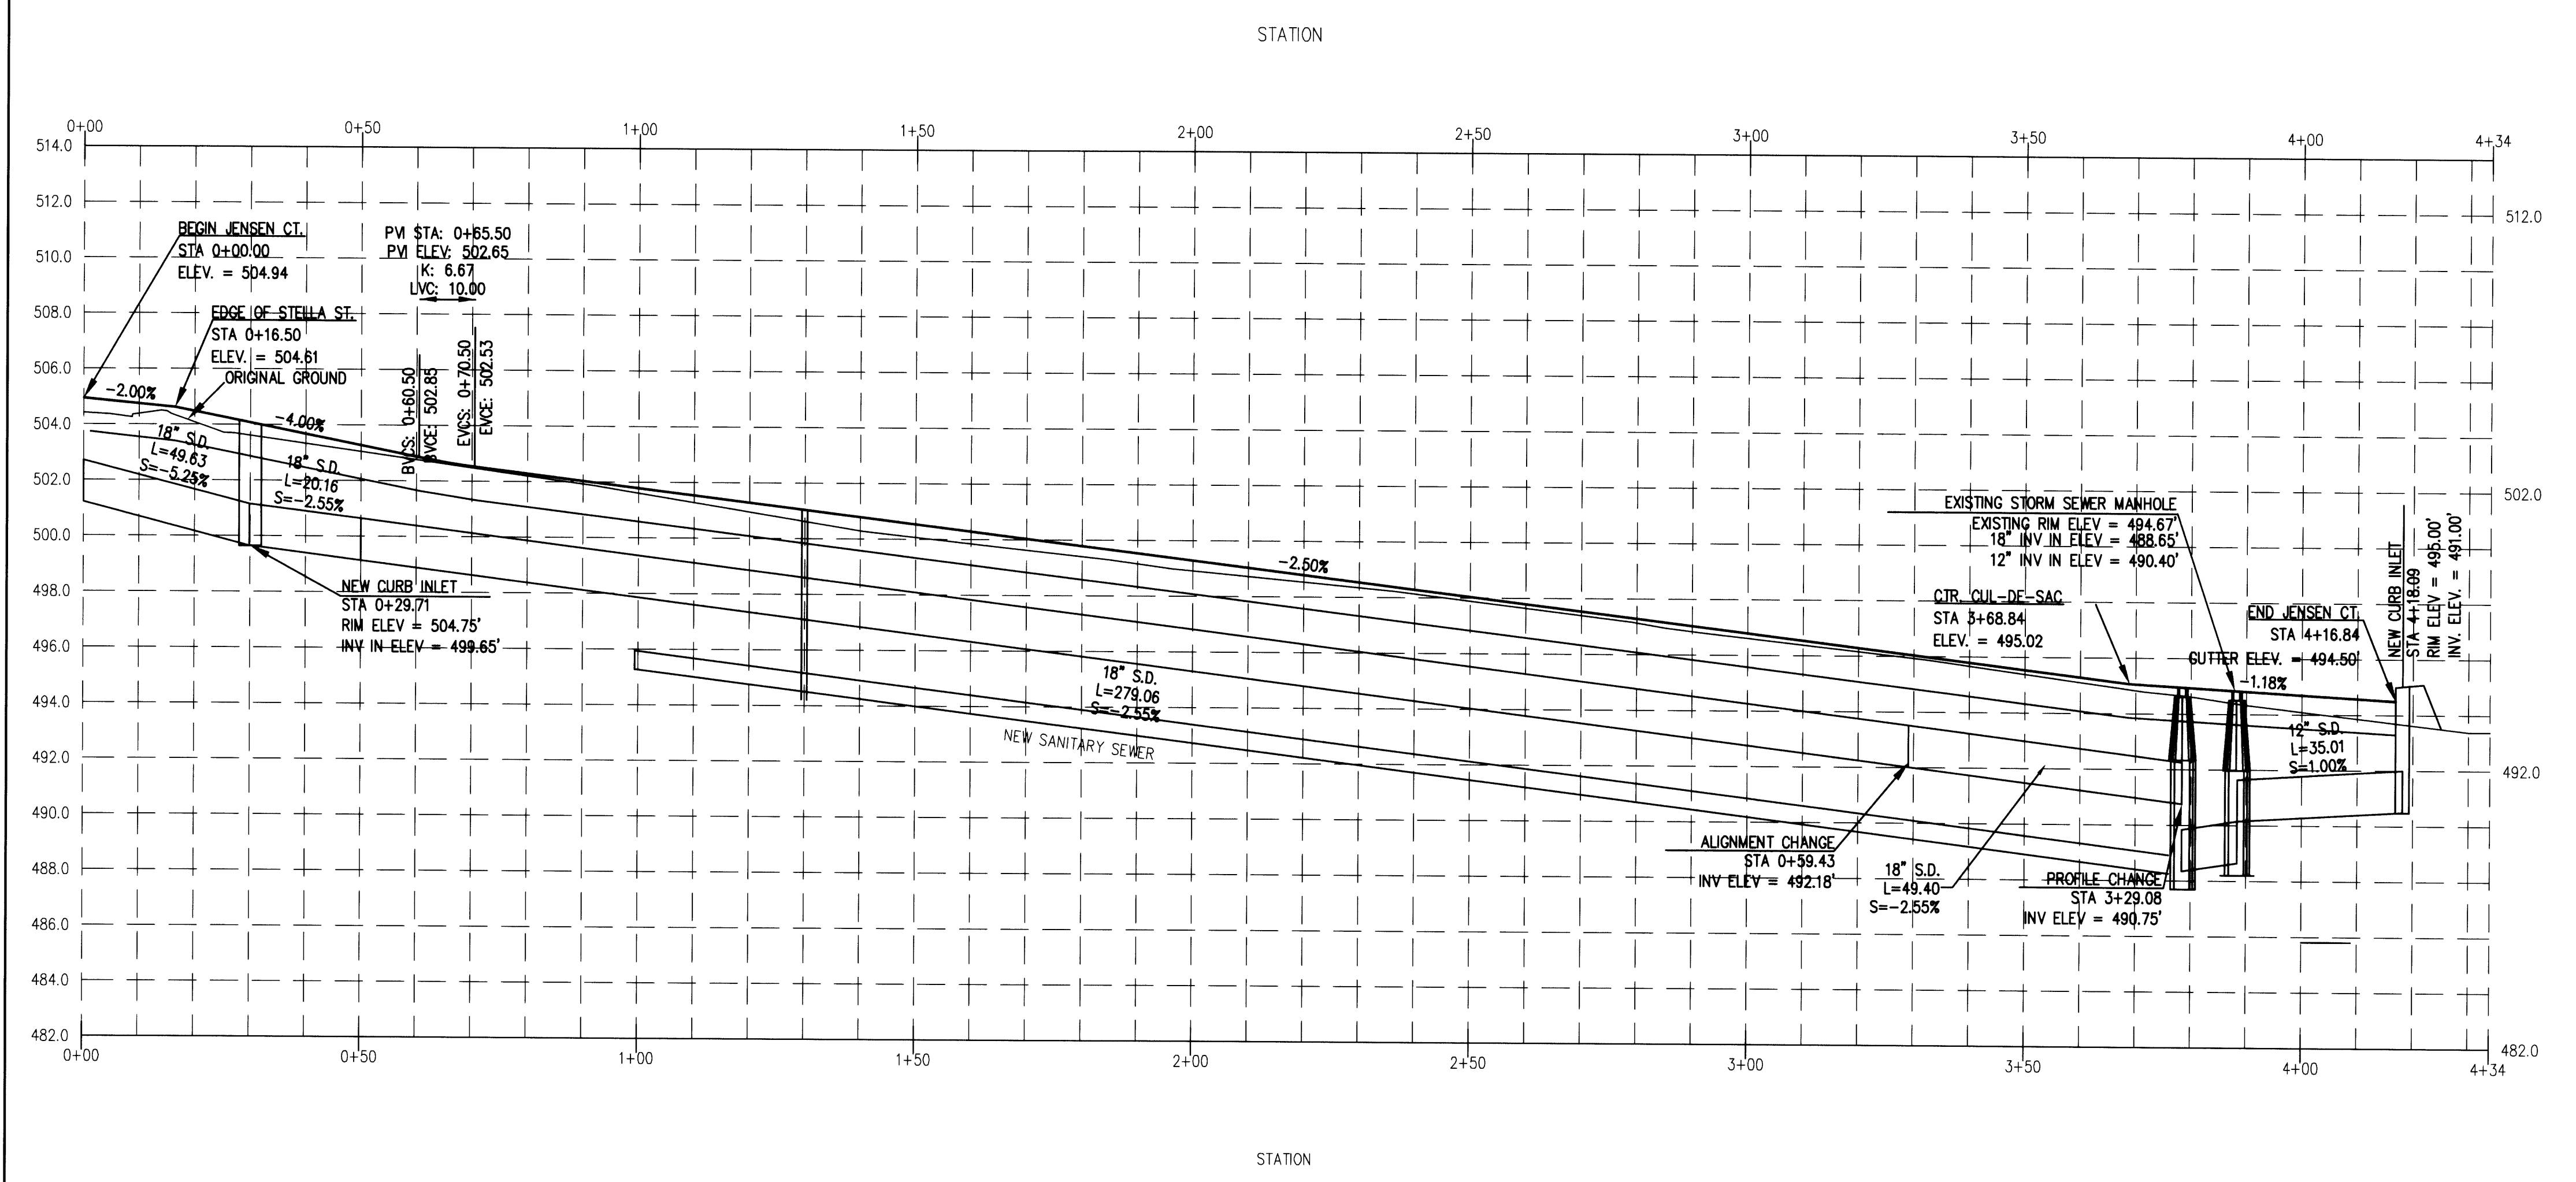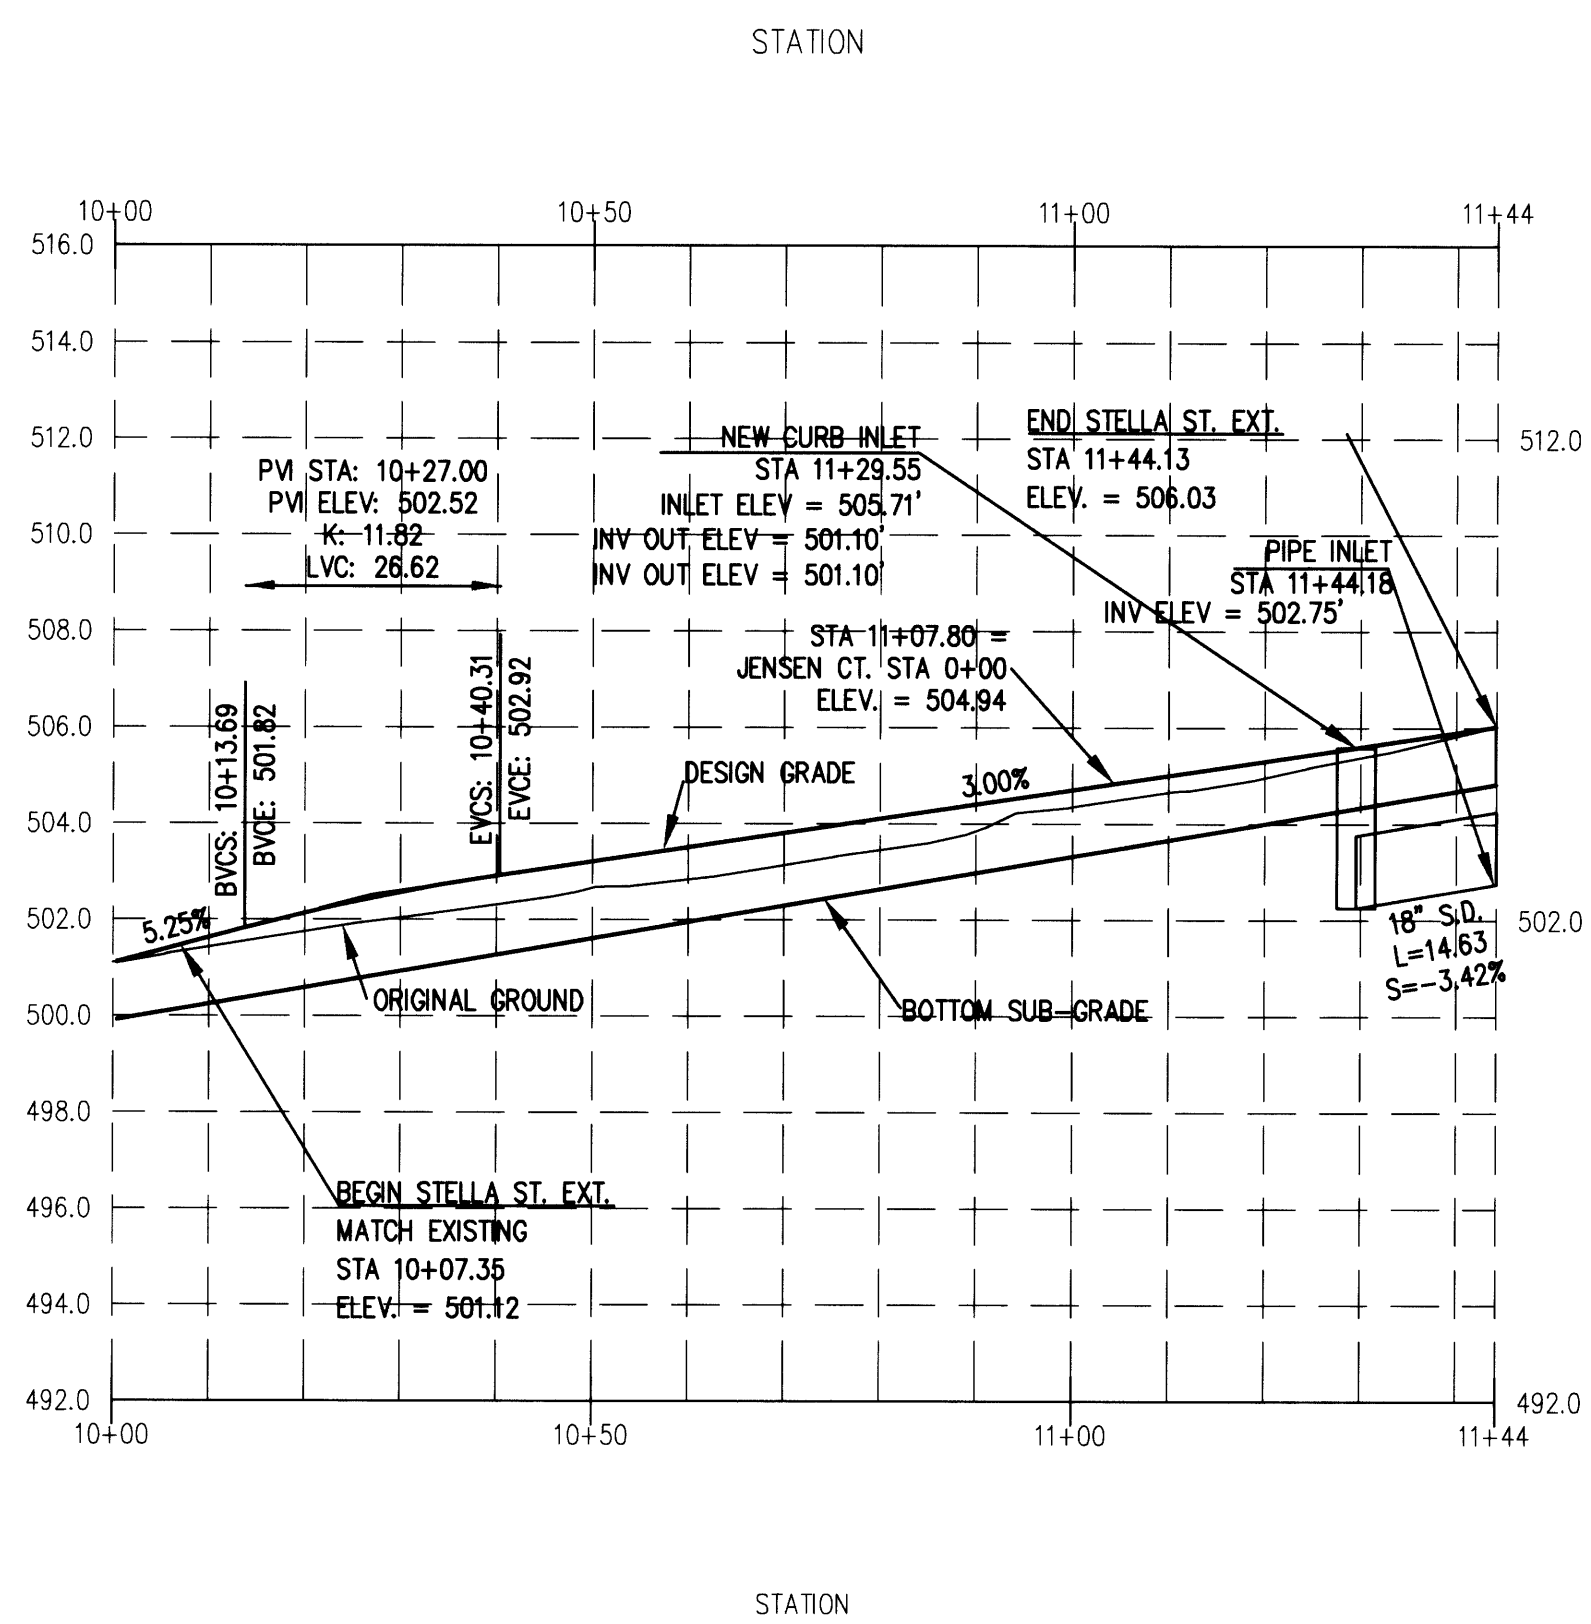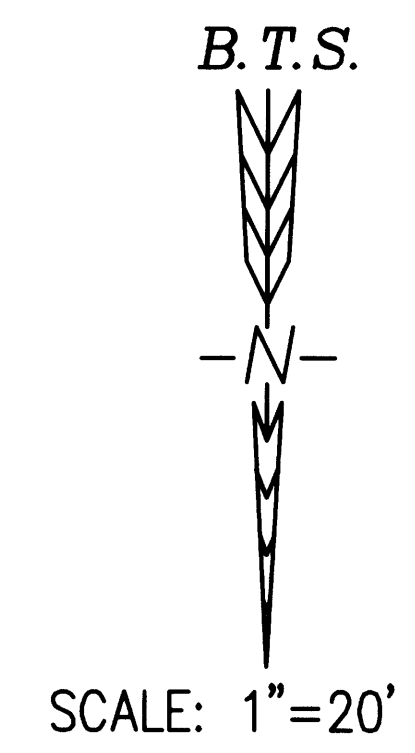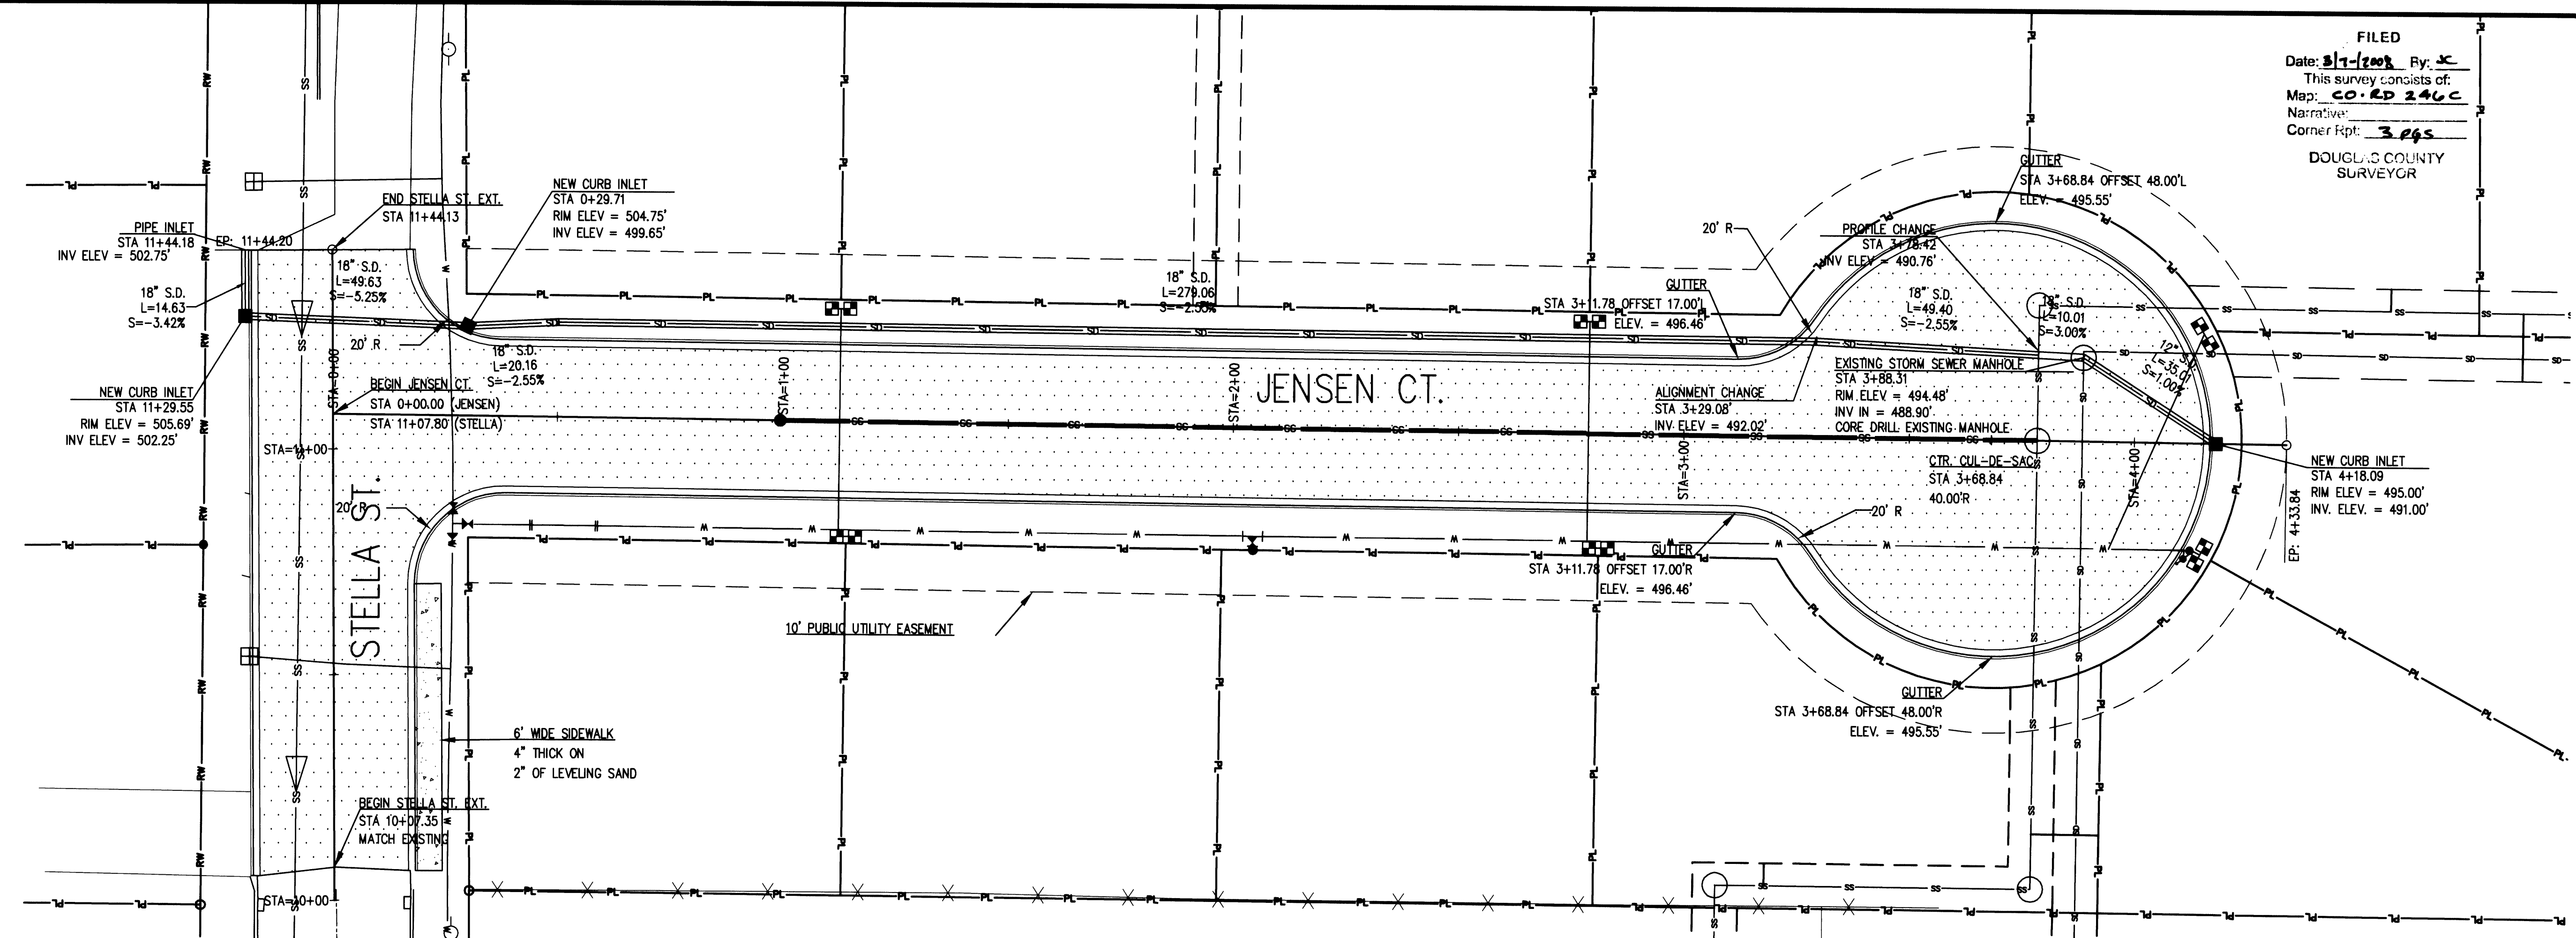

CO RD 246C AS-BUILT DRAWINGS 4/11/07