


DOUGLAS COUNTY OREGON
 PLANS FOR PROPOSED PROJECTS
 STREET IMPROVEMENTS
 AS CONSTRUCTED
 JOHNSON STREET Co. Rd. No. 252
 WARD STREET Co. Rd. No. 269
 CLUB AVENUE Co. Rd. No. 270

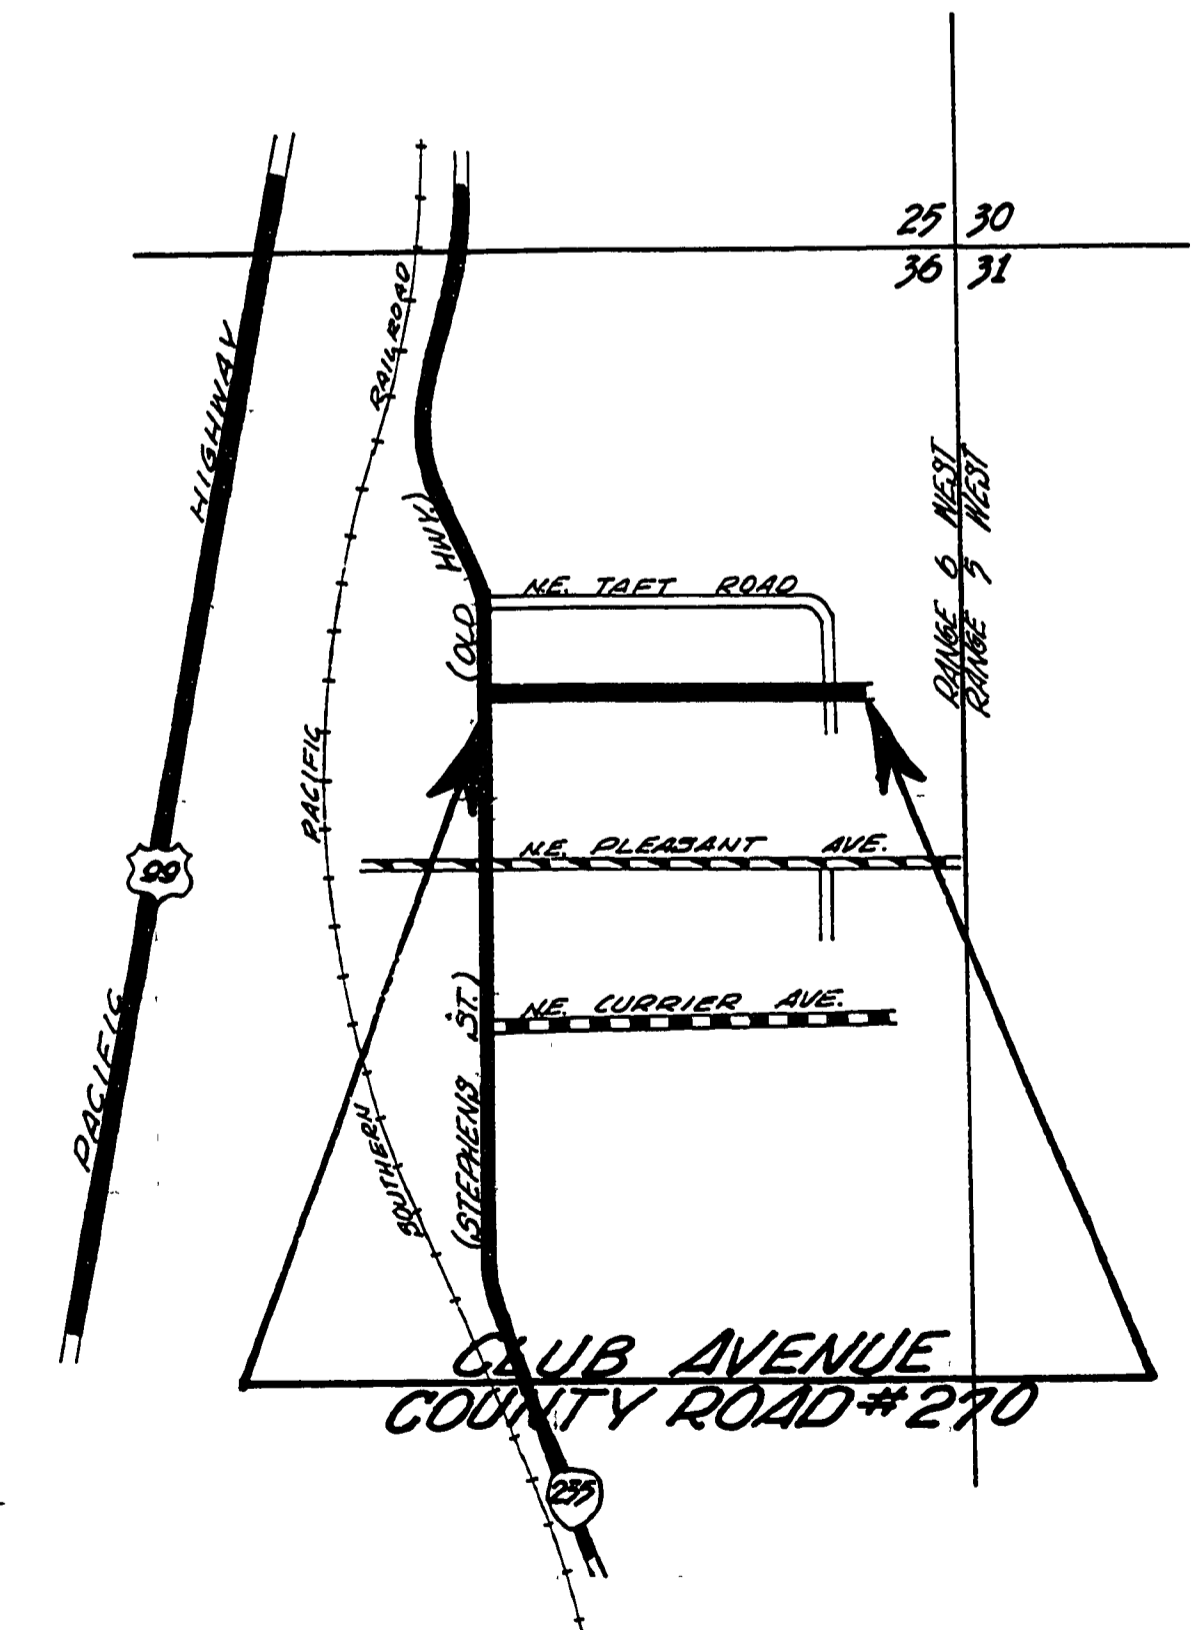

JOHNSON STREET; Dedicated in Newton Creek Homesites Subdivision as shown in Vol. 3 Page 33 of Douglas County Plat Records.

WARD STREET; Dedicated in Riverside Addition to Roseburg Subdivision as shown in Vol. 1 Page 10 of Douglas County Plat Records.


CLUB AVENUE; Dedicated in Fairacres Subdivision as shown in Vol. 6 Page 43 of Douglas County Plat Records.

Adopted by resolution of the County Court this 29th day of December 1962.

V. T. Jackson
 COUNTY JUDGE

E. P. ...
 COUNTY COMMISSIONER

Ray E. Deane
 COUNTY COMMISSIONER

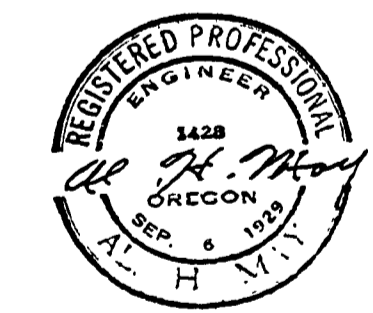

APPROVED *A. H. ...* DATE 23 July 1962
 COUNTY ENGINEER

FILED
 RECEIVED
 FEB 15 1963
 COUNTY SURVEYOR
 DOUGLAS COUNTY, ORE.

FILED
 RECEIVED
 FEB 15 1963
 COUNTY SURVEYOR
 DOUGLAS COUNTY, ORE.

0012000C