
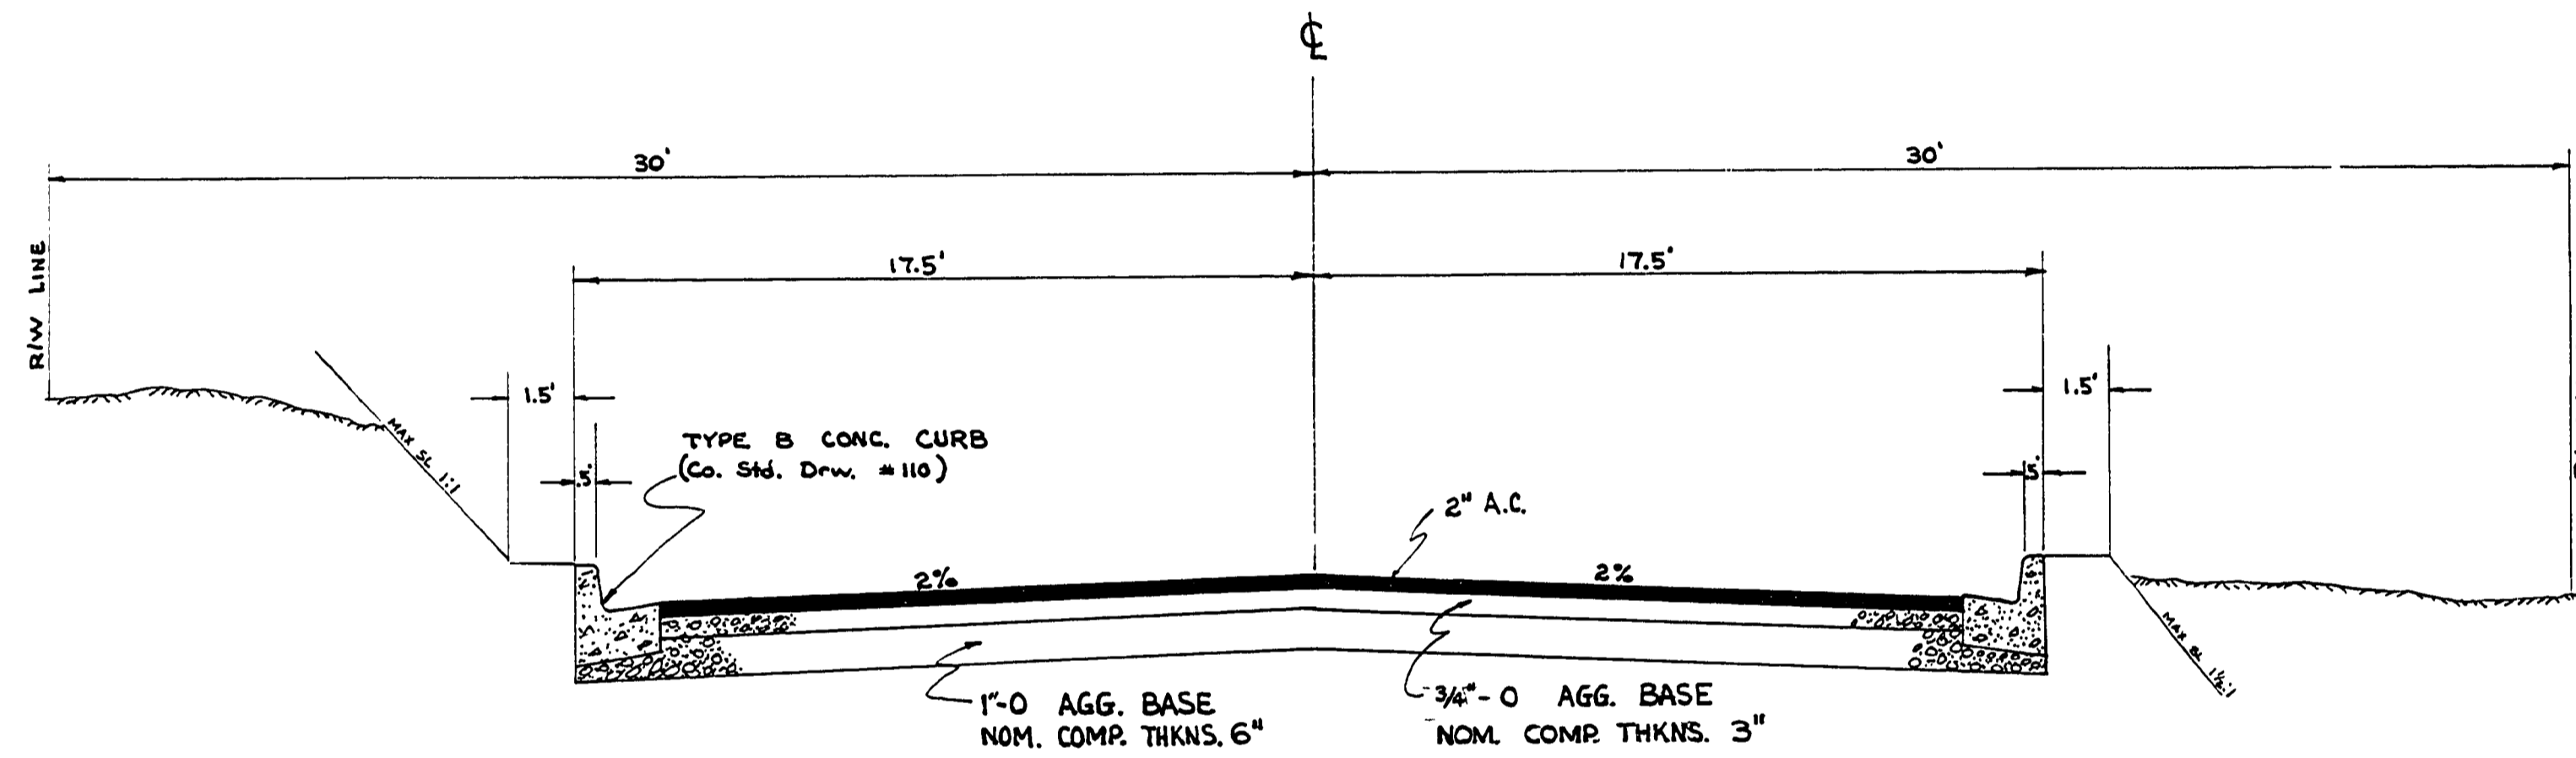


FILED

AUG 10 1987

COUNTY SURVEYOR
DOUGLAS COUNTY, ORE.

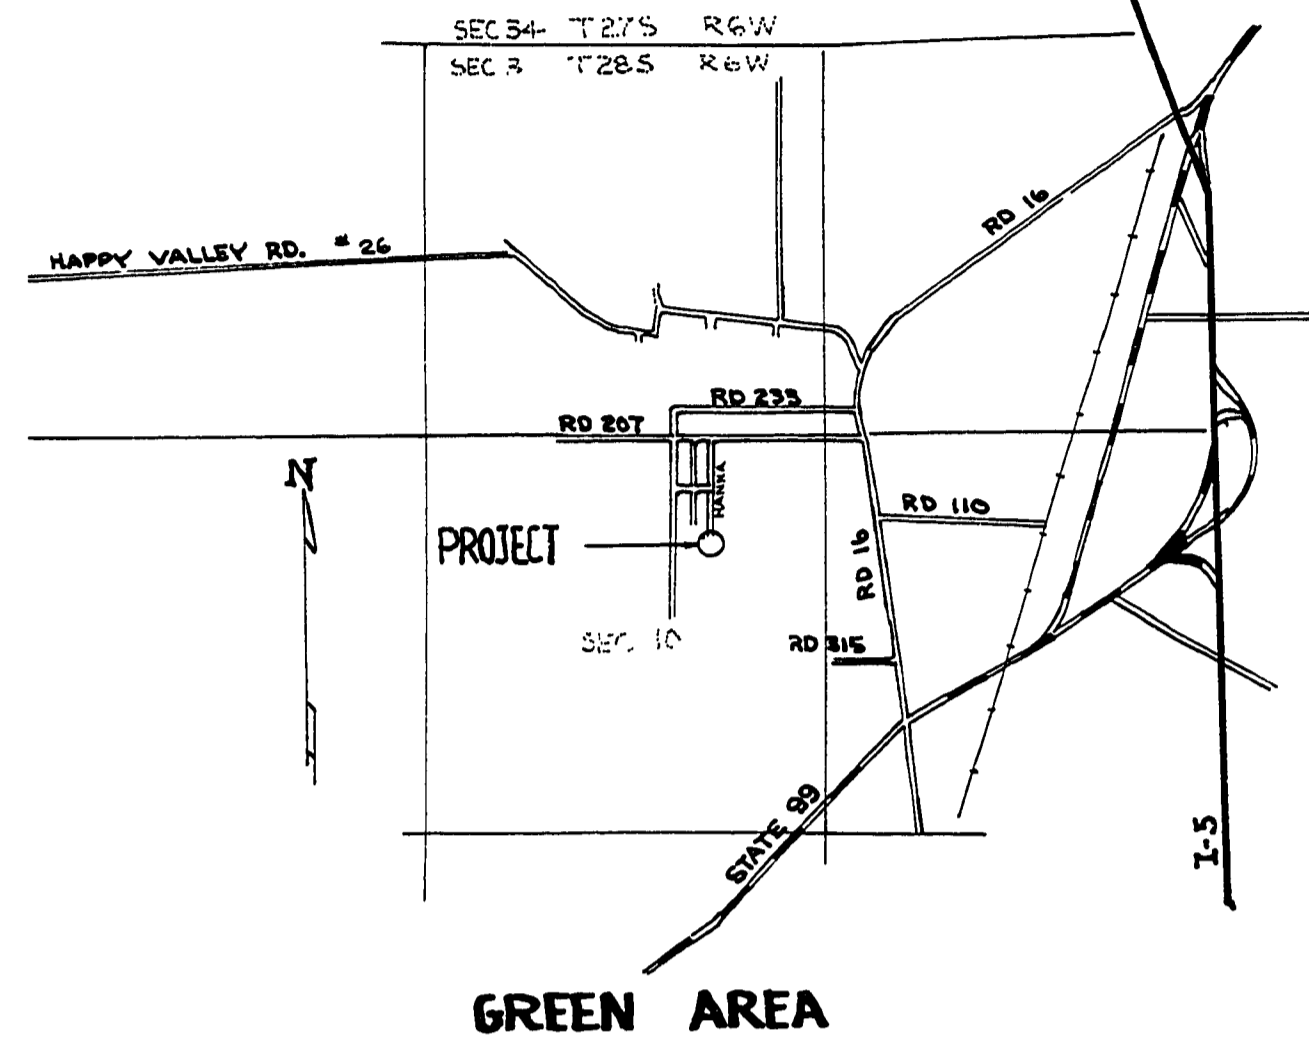

TYPICAL SECTION

STA 15+72 to 18+36

BEGIN TRANSITION TO CUL-DE-SAC - STA 17+50

INDEX OF DRAWINGS

SHEET NO.	DESCRIPTION
1	COVER SHEET
2	STREET PLANS
3	UTILITY PLANS

"AS CONSTRUCTED"

THE ROAD HEREON HAS BEEN CONSTRUCTED IN ACCORDANCE WITH THE TYPICAL SECTION SHOWN AND TO THE GRADES AND ALIGNMENT SHOWN

CLEARVIEW ESTATES SUBDIVISION
DOUGLAS COUNTY, OREGON
HANNA STREET PLANS

DEVELOPER
BURDETTE HOMES INC. ROSEBURG, OR

ENGINEER
TERRY C. CONNELL
ROSEBURG, OREGON

JULY 1977

SHEET 1 OF 3 SHEETS

DOUGLAS COUNTY
PUBLIC WORKS DEPT.
APPROVED
By *[Signature]* Date 8-1-77



0029003C