


DATE	
BY	
REVISIONS	
NO.	
DESCRIPTION	
DATE	
BY	
REVISIONS	
NO.	
DESCRIPTION	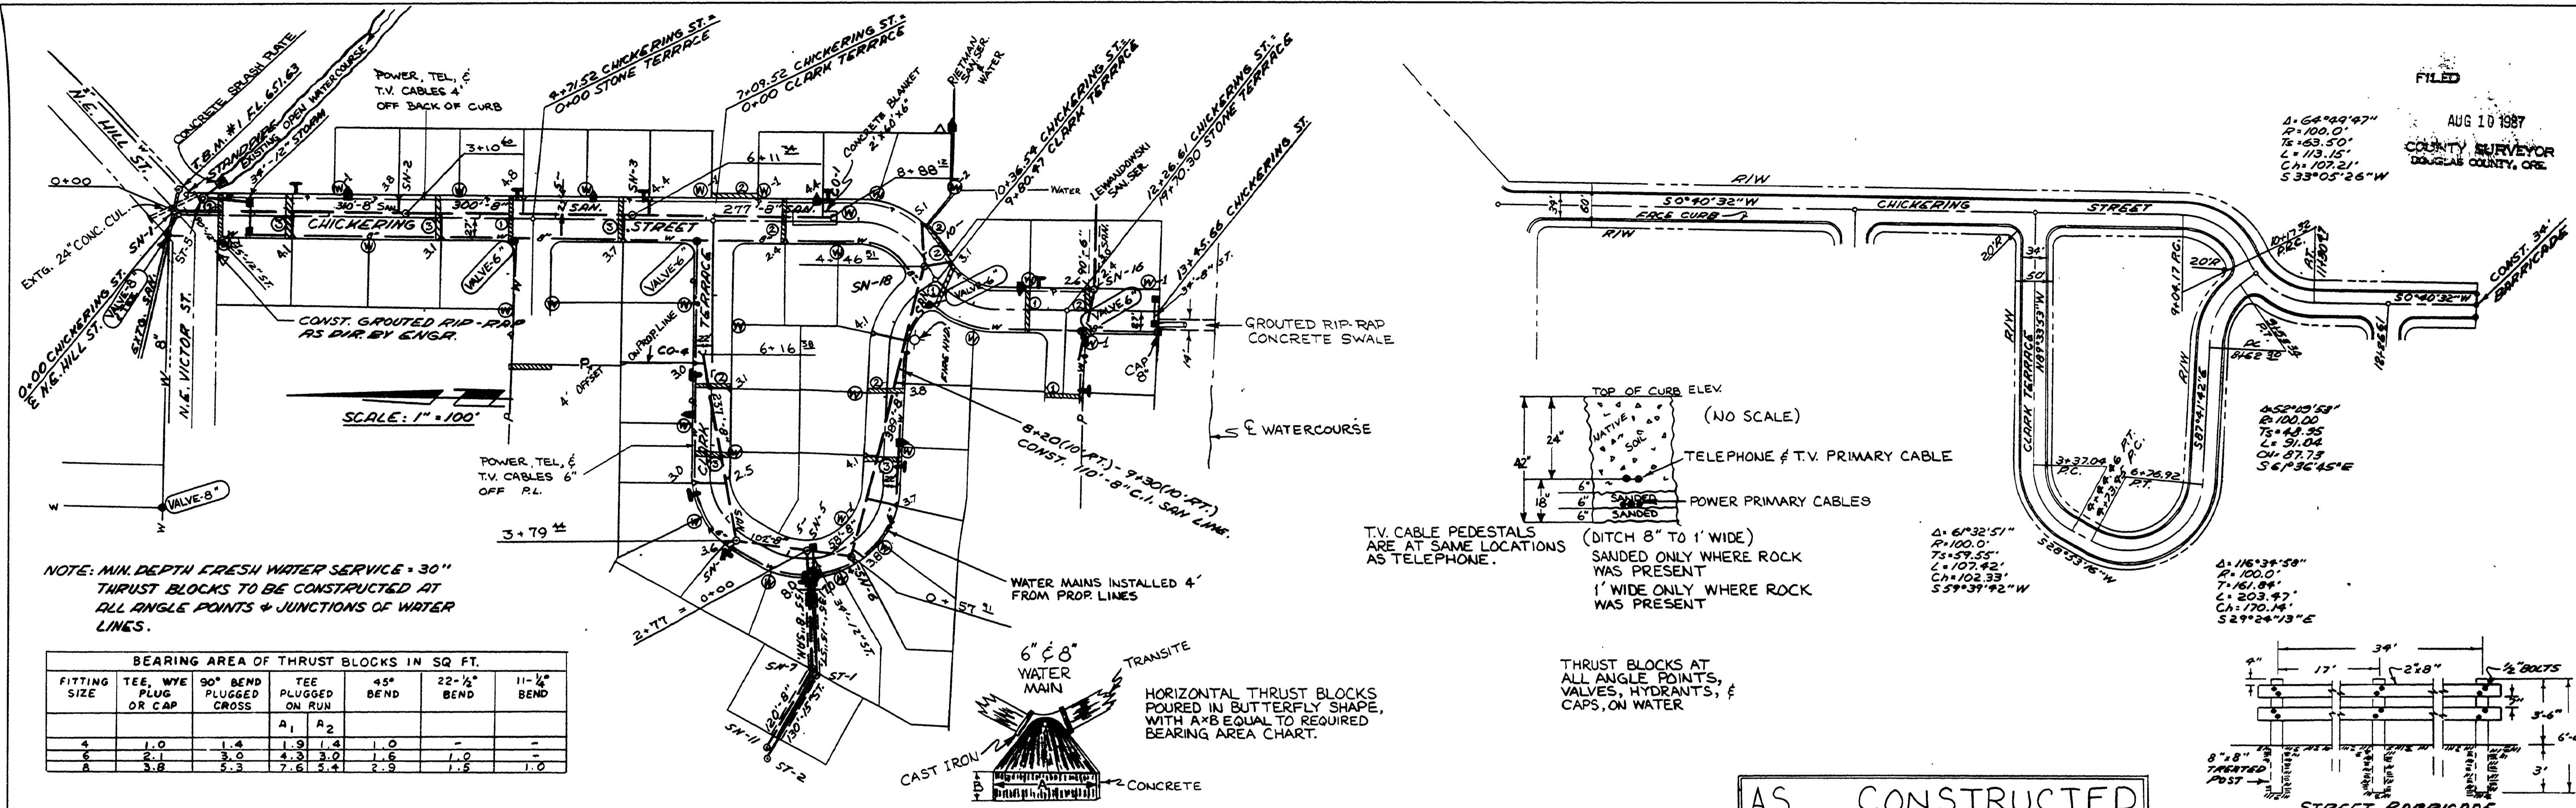
BEARING AREA OF THRUST BLOCKS IN SQ. FT.


FITTING SIZE	TEE, WYE PLUG OR CAP	90° BEND PLUGGED CROSS	TEE PLUGGED ON RUN	45° BEND	22-1/2° BEND	11-1/4° BEND
4	1.0	1.4	1.9	1.4	1.0	-
6	2.1	3.0	4.3	3.0	1.6	-
8	3.8	5.3	7.6	5.4	2.9	1.0

FILED
AUG 10 1987
COUNTY SURVEYOR
DOUGLAS COUNTY, ORE.

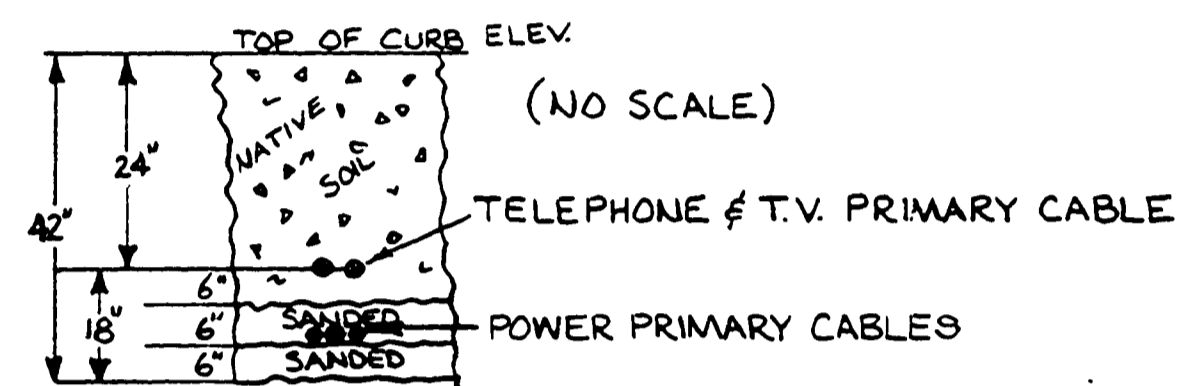

THrust BLOCKS AT ALL ANGLE POINTS, VALVES, HYDRANTS, & CAPS, ON WATER

AS CONSTRUCTED

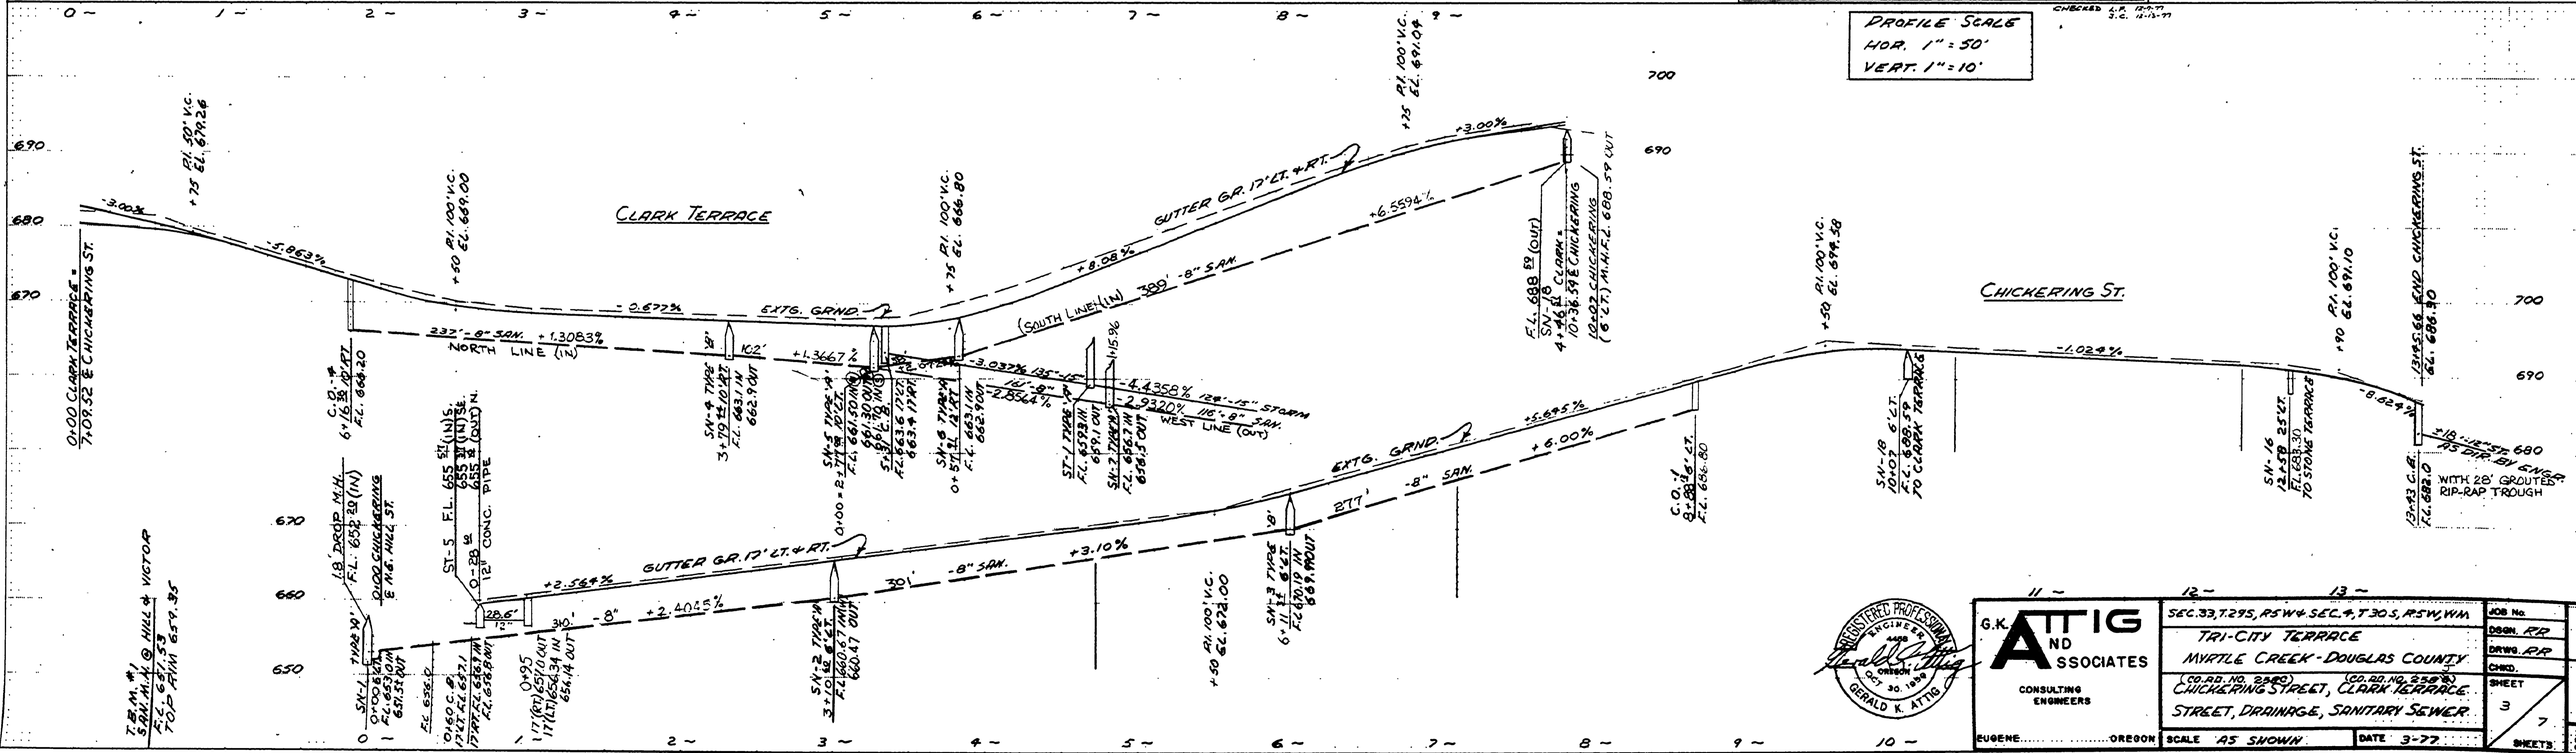

PROFILE SCALE
HOR. 1" = 50'
VERT. 1" = 10'



G.K. ATTIG AND ASSOCIATES
CONSULTING ENGINEERS

SEC. 33, T. 29S, R. 5W & SEC. 4, T. 30S, R. 5W, W.M.
TRAI-CITY TERRACE
MYRTLE CREEK - DOUGLAS COUNTY
(CO. RD. NO. 248)
CHICKERING STREET, CLARK TERRACE
STREET, DRAINAGE, SANITARY SEWER.

JOB No. DRN. 112
DRWN. R.P.R.
CHKD. C.H.W.
SHEET 3
SHEETS 7

EUGENE, OREGON SCALE AS SHOWN DATE 3-77

00000026