




DATE	
BY	
REVISION	
NO. 1	
NO. 2	
NO. 3	
NO. 100	

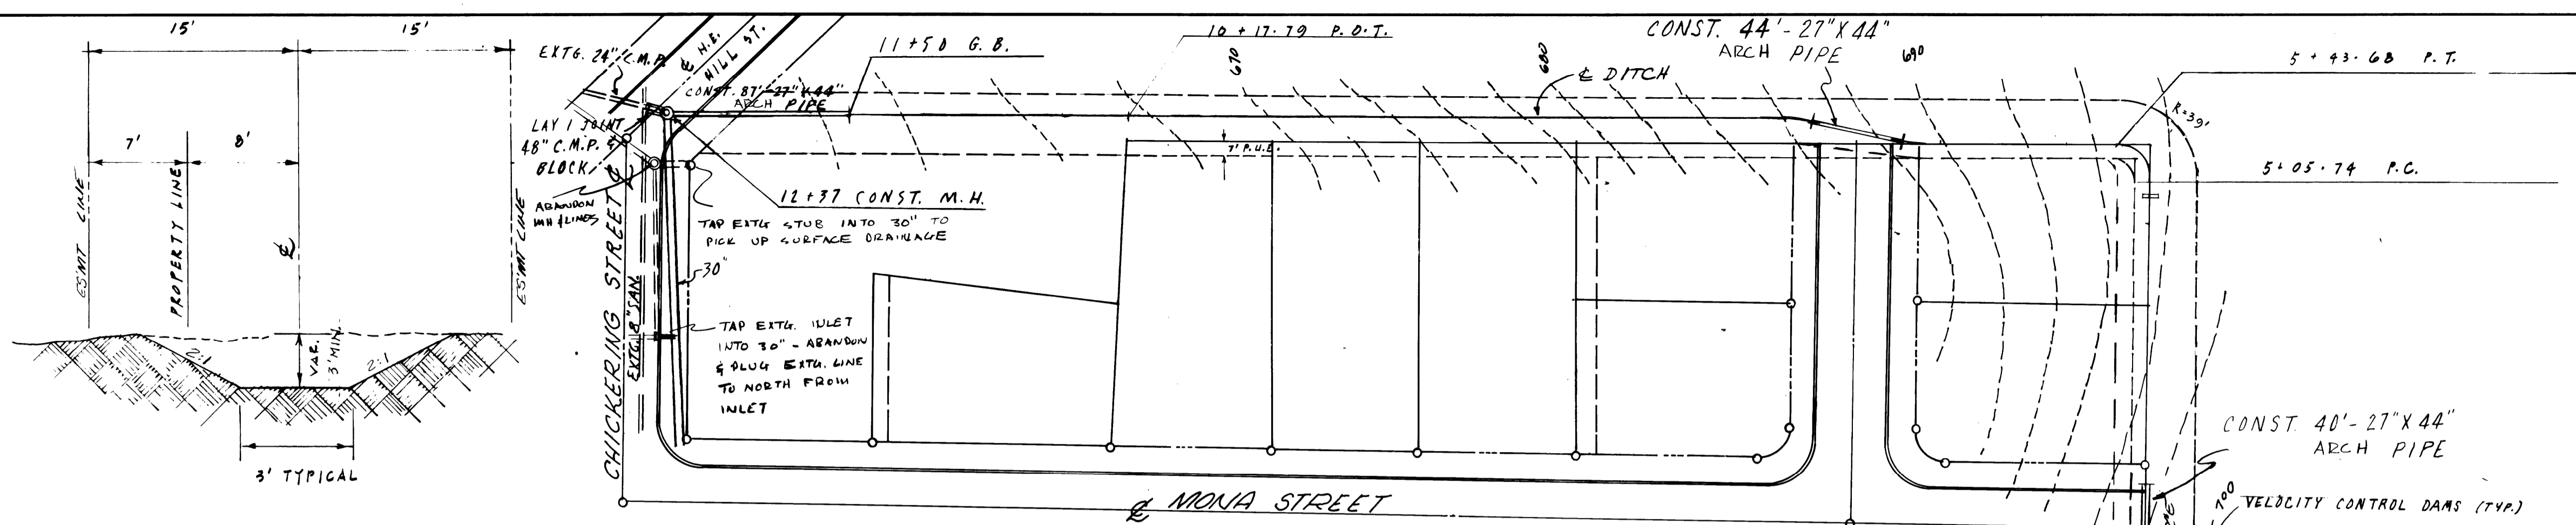


TYPICAL DITCH SECTION
 (NO SCALE)

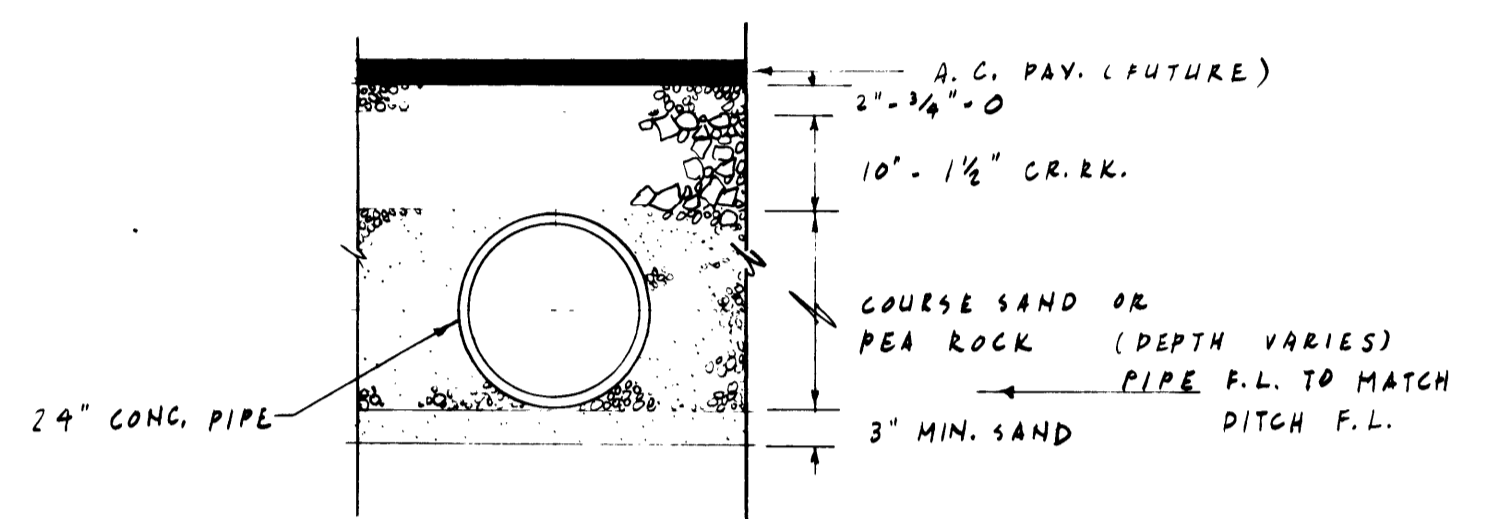


SECTION @ CULVERT
 (NO SCALE)

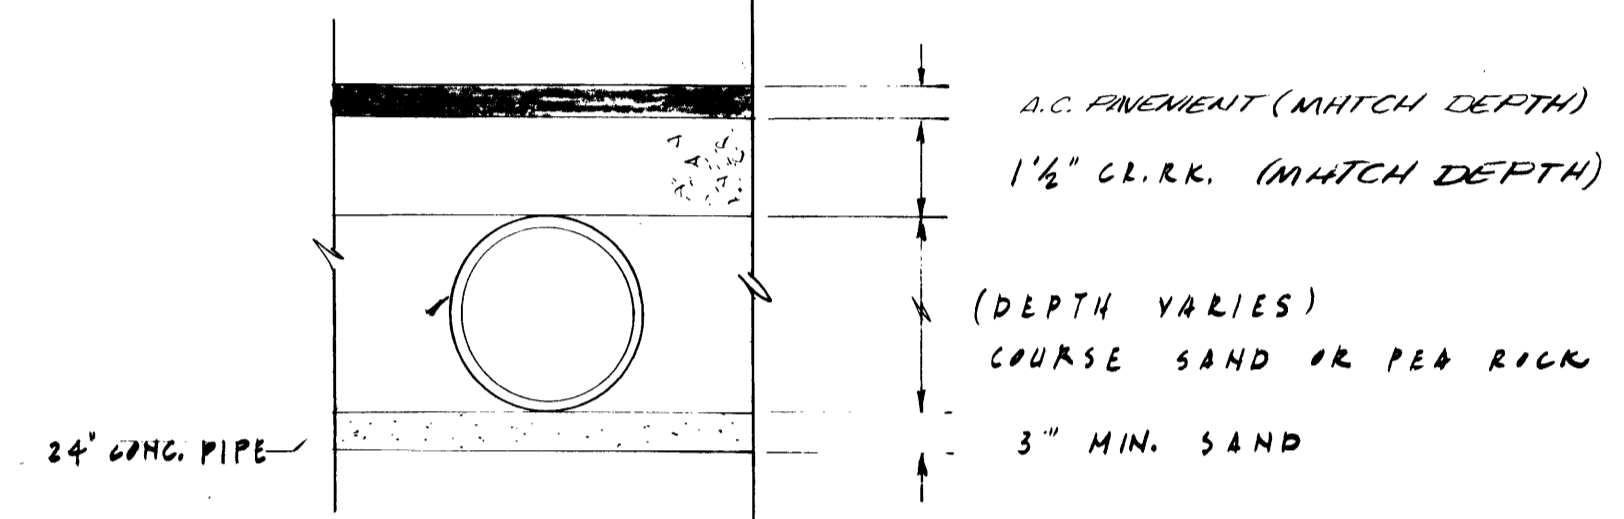

PIPE @ N.E. HILL STREET
 (NO SCALE)

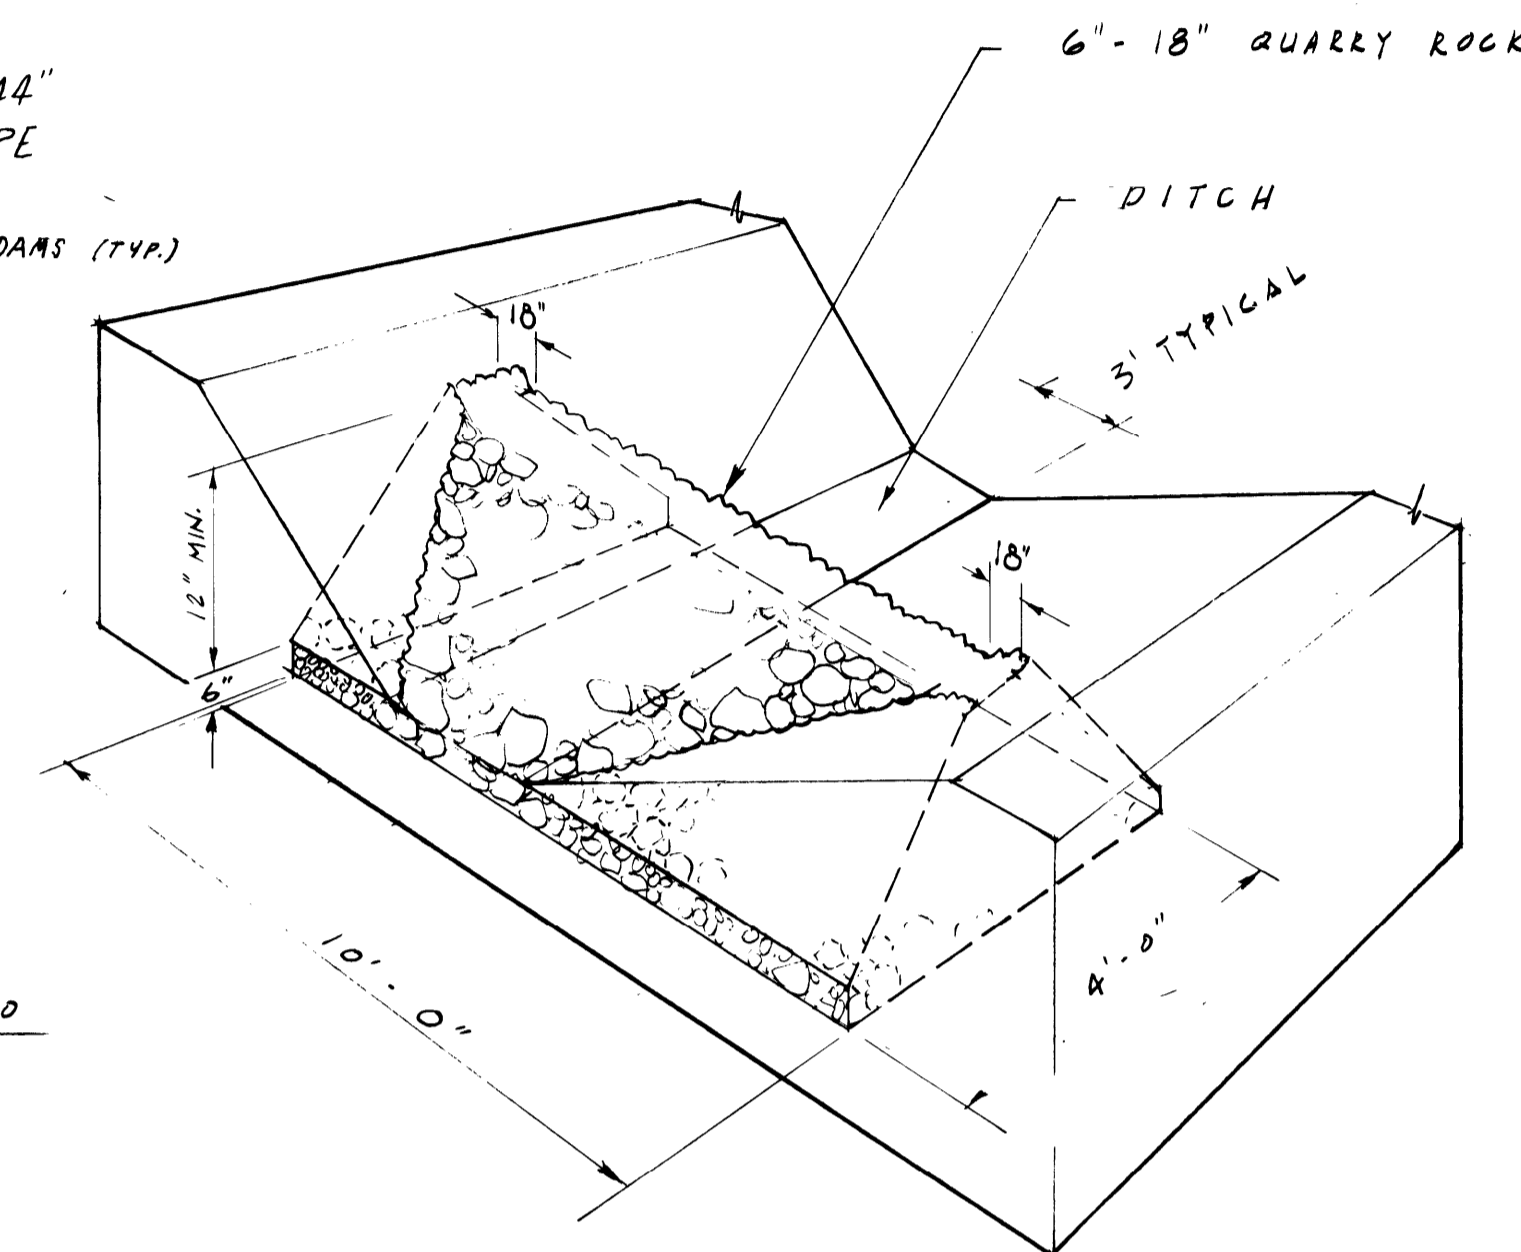

TYPICAL VELOCITY CONTROL DAM N.T.S.

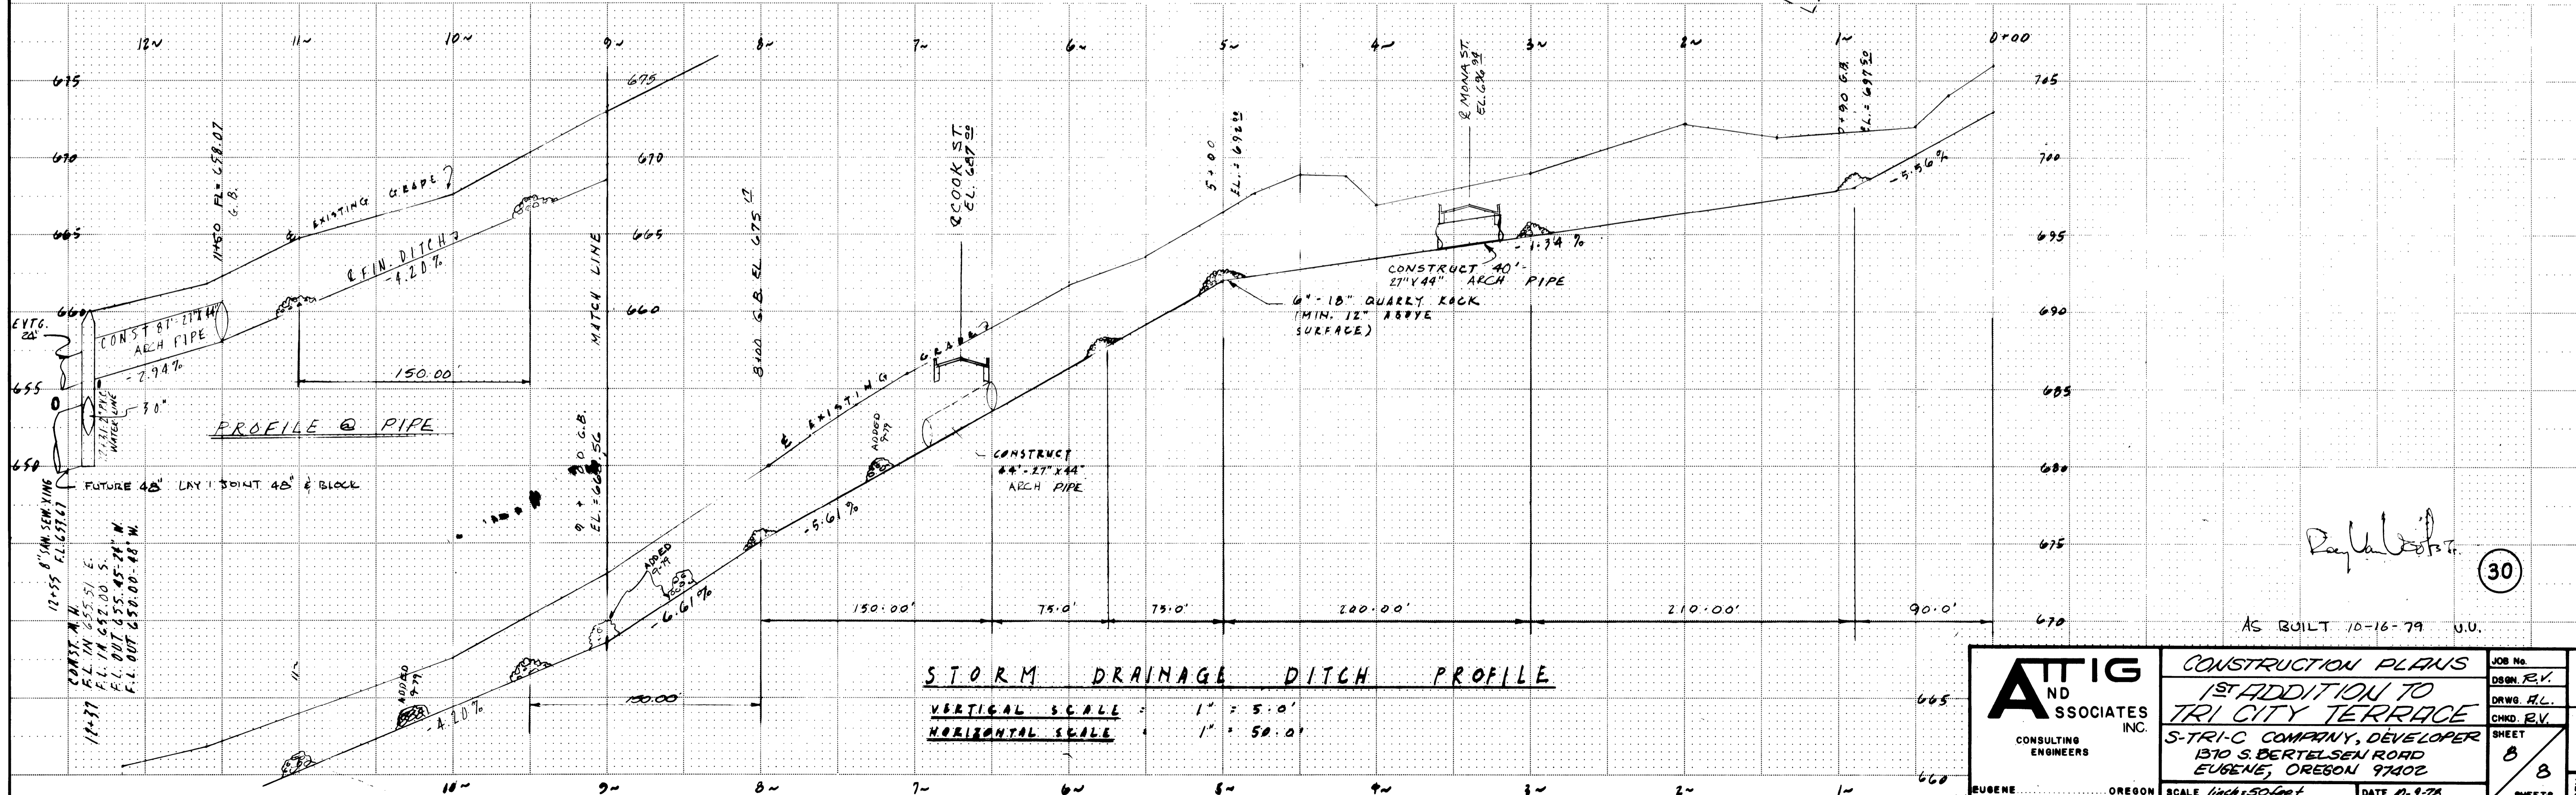

STORM DRAINAGE DITCH PROFILE

VERTICAL SCALE = 1" = 5.0'
 HORIZONTAL SCALE = 1" = 50.0'

DATE	
BY	
REVISION	
NO. 1	
NO. 2	
NO. 3	
NO. 100	

ATTIG AND ASSOCIATES INC. CONSULTING ENGINEERS EUGENE OREGON	CONSTRUCTION PLANS 1ST ADDITION TO TRI CITY TERRACE S-TRI-C COMPANY, DEVELOPER 1370 S. BERTELSEN ROAD EUGENE, OREGON 97402	JOB NO. DESIGNED BY DRAWN BY CHECKED BY SHEET 8 SHEETS 8
	SCALE 1/4" = 50 FEET DATE 10-9-78	REV
	CO. RD. 258 D	MONA ST
	AS BUILT 10-16-79 U.U.	(30)