
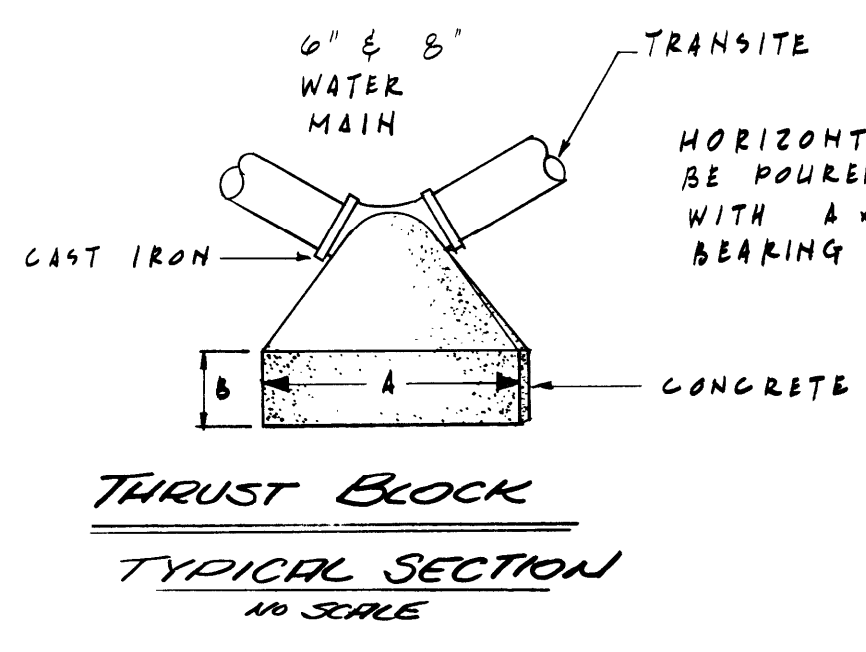


DATE	
BY	
REVISIONS	
NO.	
DATE	
BY	
REVISIONS	
NO.	
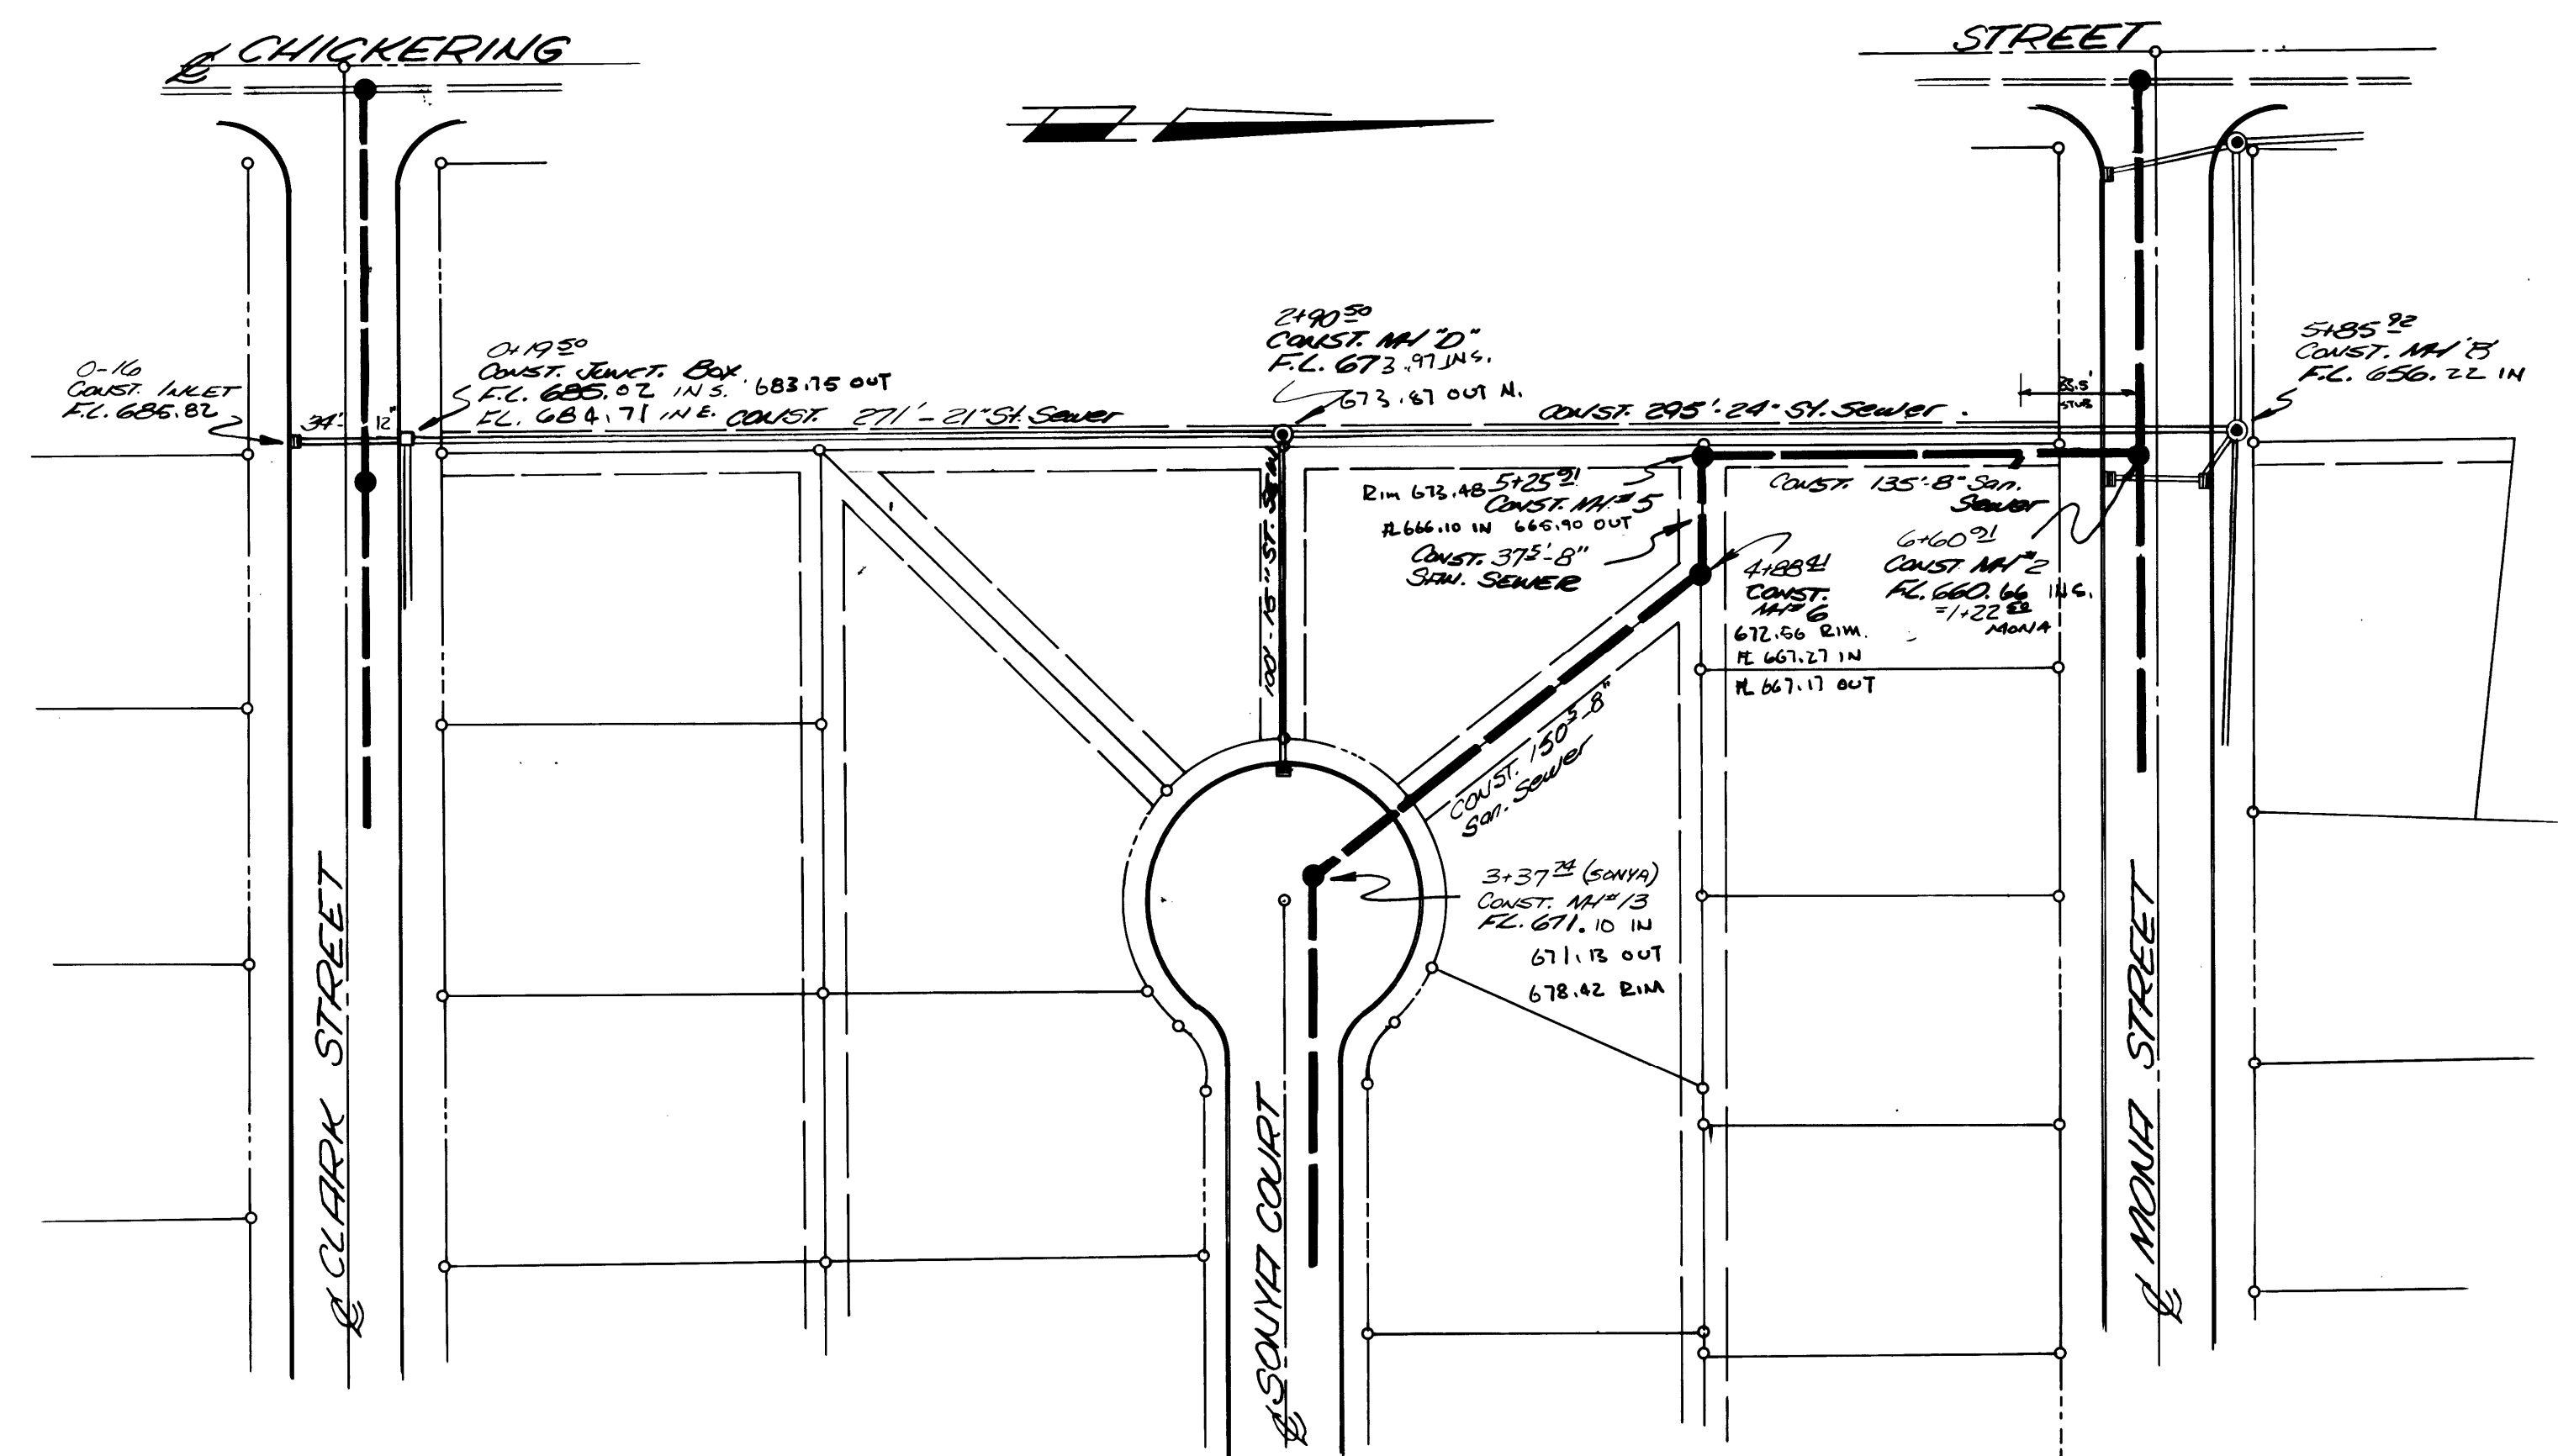


HORIZONTAL THRUST BLOCKS TO BE POURED IN BUTTERFLY SHAPE, WITH A x B EQUALS TO REQUIRED BEARING AREA CHART. SEE SHEET 6.

CONSTRUCT THRUST BLOCKS AT ALL ANGLE POINTS, VALVES, HYDRANTS, & CAPS, ON WATER.

NOTE: SEE TRI-CITY WATER AND SANITARY DISTRICT STD. SPECS FOR OTHER THRUST BLOCK AND PIPING CONNECTION DETAILS.

DATE	
BY	
REVISIONS	
NO.	
DATE	
BY	
REVISIONS	
NO.	
DATE	
BY	
REVISIONS	
NO.	
DATE	
BY	
REVISIONS	
NO.	

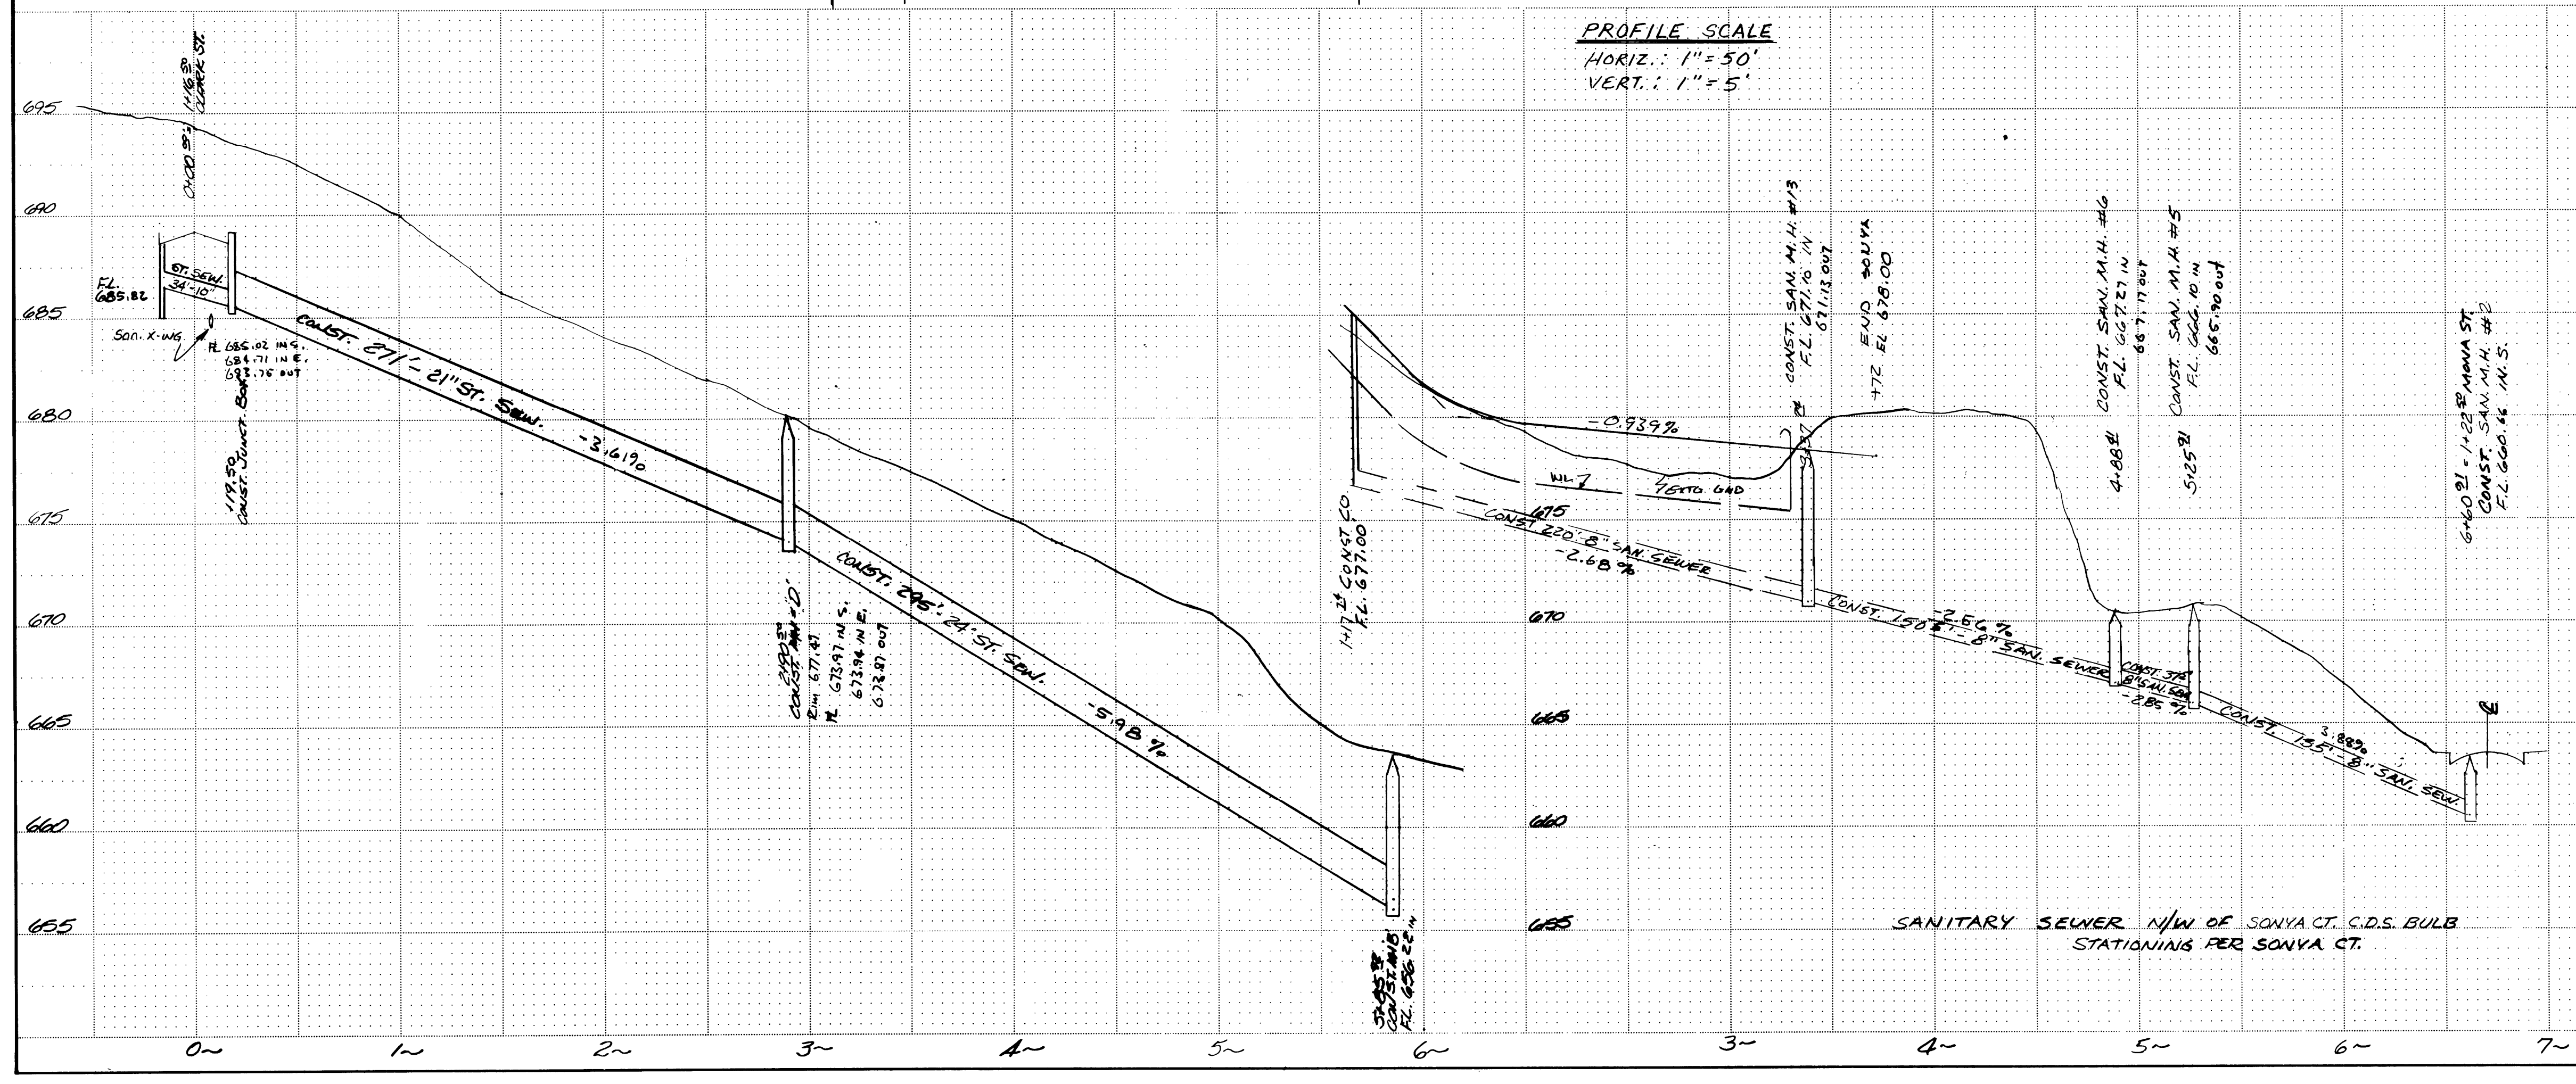

ATTIG AND ASSOCIATES CONSULTING ENGINEERS EUGENE, OREGON	CONSTRUCTION PLANS 1ST ADDITION TO TRI CITY TERRACE S-TRI-C COMPANY, DEVELOPER 1370 S. BERTELSEN ROAD EUGENE, OREGON 97402	JOB No. DSGN DRWG CHKD SHEET 18 SHEETS
	SCALE 1/4" = 50'-0" DATE 10-6-78	AS BUILT 10-11-79 U.O. 30 R258FSEW

Sonya Ct

Co. Rd. # 258 F

CO. RD. # 258 F