


BEARING AREA OF THRUST BLOCKS IN SQ. FT.

FITTING SIZE	TEE, WYE PLUG OR CAP	90° BEND PLUGGED CROSS	TEE PLUGGED ON RUN	45° BEND	22-1/2° BEND	11-1/2° BEND
4	1.0	1.4	A1 A2	1.0	-	-
6	2.1	3.0	4.3 3.0	1.6	1.0	-
8	3.8	5.3	7.6 5.4	2.9	1.5	1.0

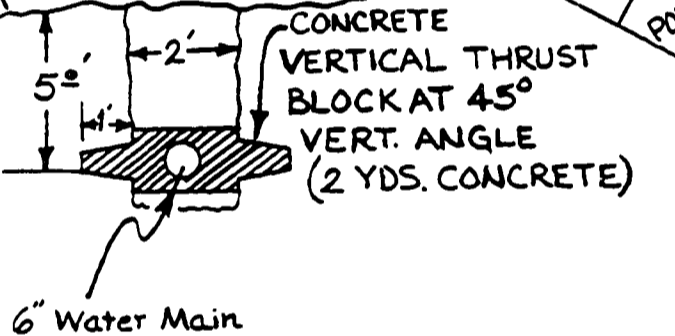

- LEGEND**
- T TELEPHONE & T.V. PEDESTAL
 - ▲ POWER TRANSFORMER PAD
 - CONDUIT X-INGS & NO. OF PIPES
 - SINGLE WATER (SINGLE BOX)
 - ⊖ DOUBLE WATER (DOUBLE BOX)
 - 4.2' DEPTH BELOW G. OF STUBOUT (SAN)
 - P POWER, TELEPHONE, T.V. CABLE ROUTES
 - △ POWER POLE
 - TEE & VALVE WATER MAIN
 - ⊙ M.H.
 - ⊙ VALVE LOCATION & SIZE

* ALL CURBS MARKED IN BLACK STENCIL PAINT AT CROSSINGS.

UL-(CONDUIT)
S-(SANITARY)
W-(WATER SERVICE)
WM-(WATER MAIN)


FILED

AUG 10 1987

COUNTY SURVEYOR
DOUGLAS COUNTY, ORE


NOTE: POWER, TELE. & T.V. DITCH LOCATED IN R.W. 6" FROM PROPERTY LINE AT 30" COVER TO POWER, 20" COVER TO TELEPHONE.

NOTE: WATER MAIN LINE LOCATED AT 4' FROM PROPERTY LINES. IMBEDDED IN GREEN SAND.

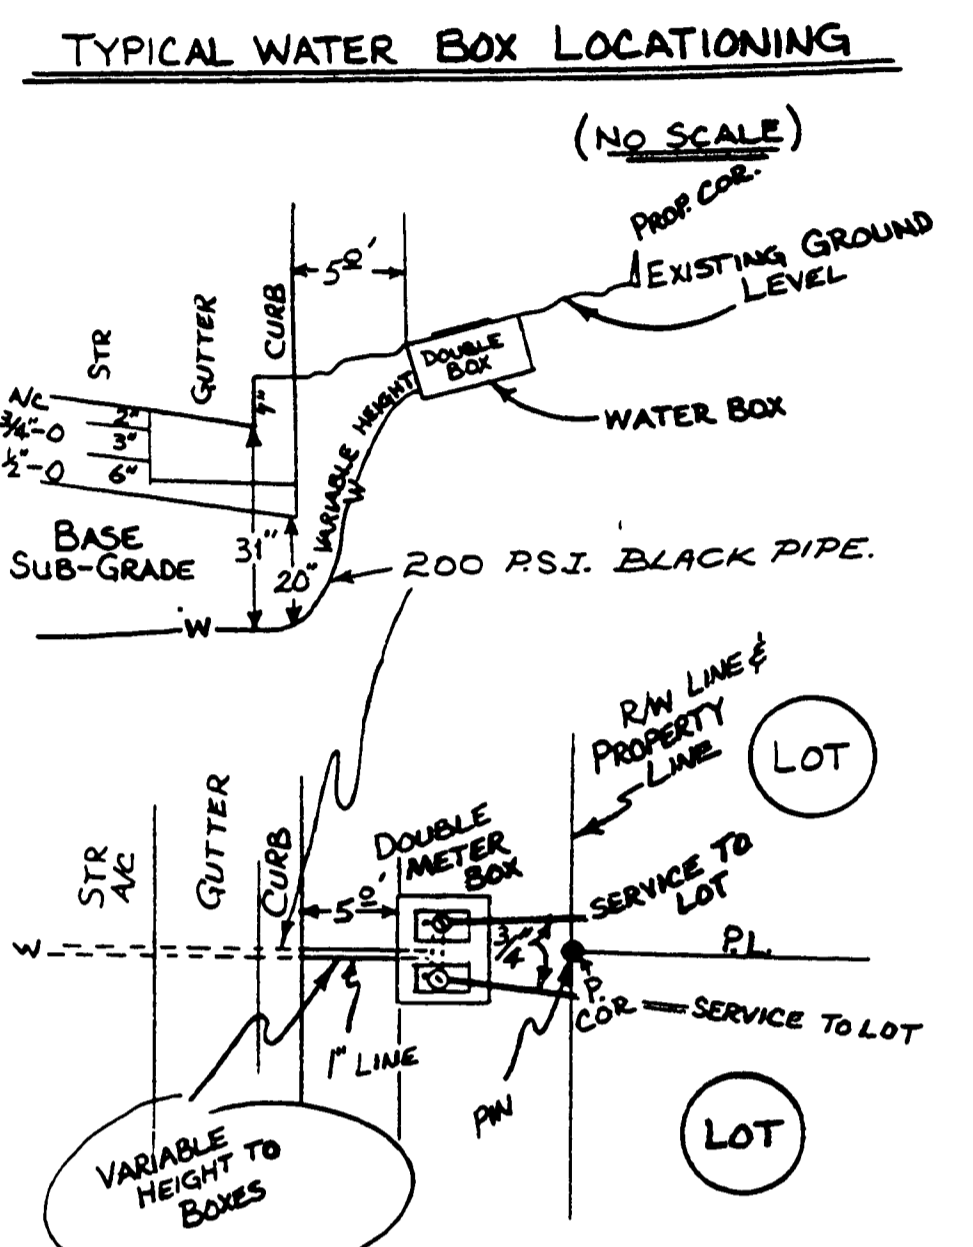


AS CONSTRUCTED

NOTE: S.S. STATIONING = CONSTRUCTION STATIONING / NOT G. REF.

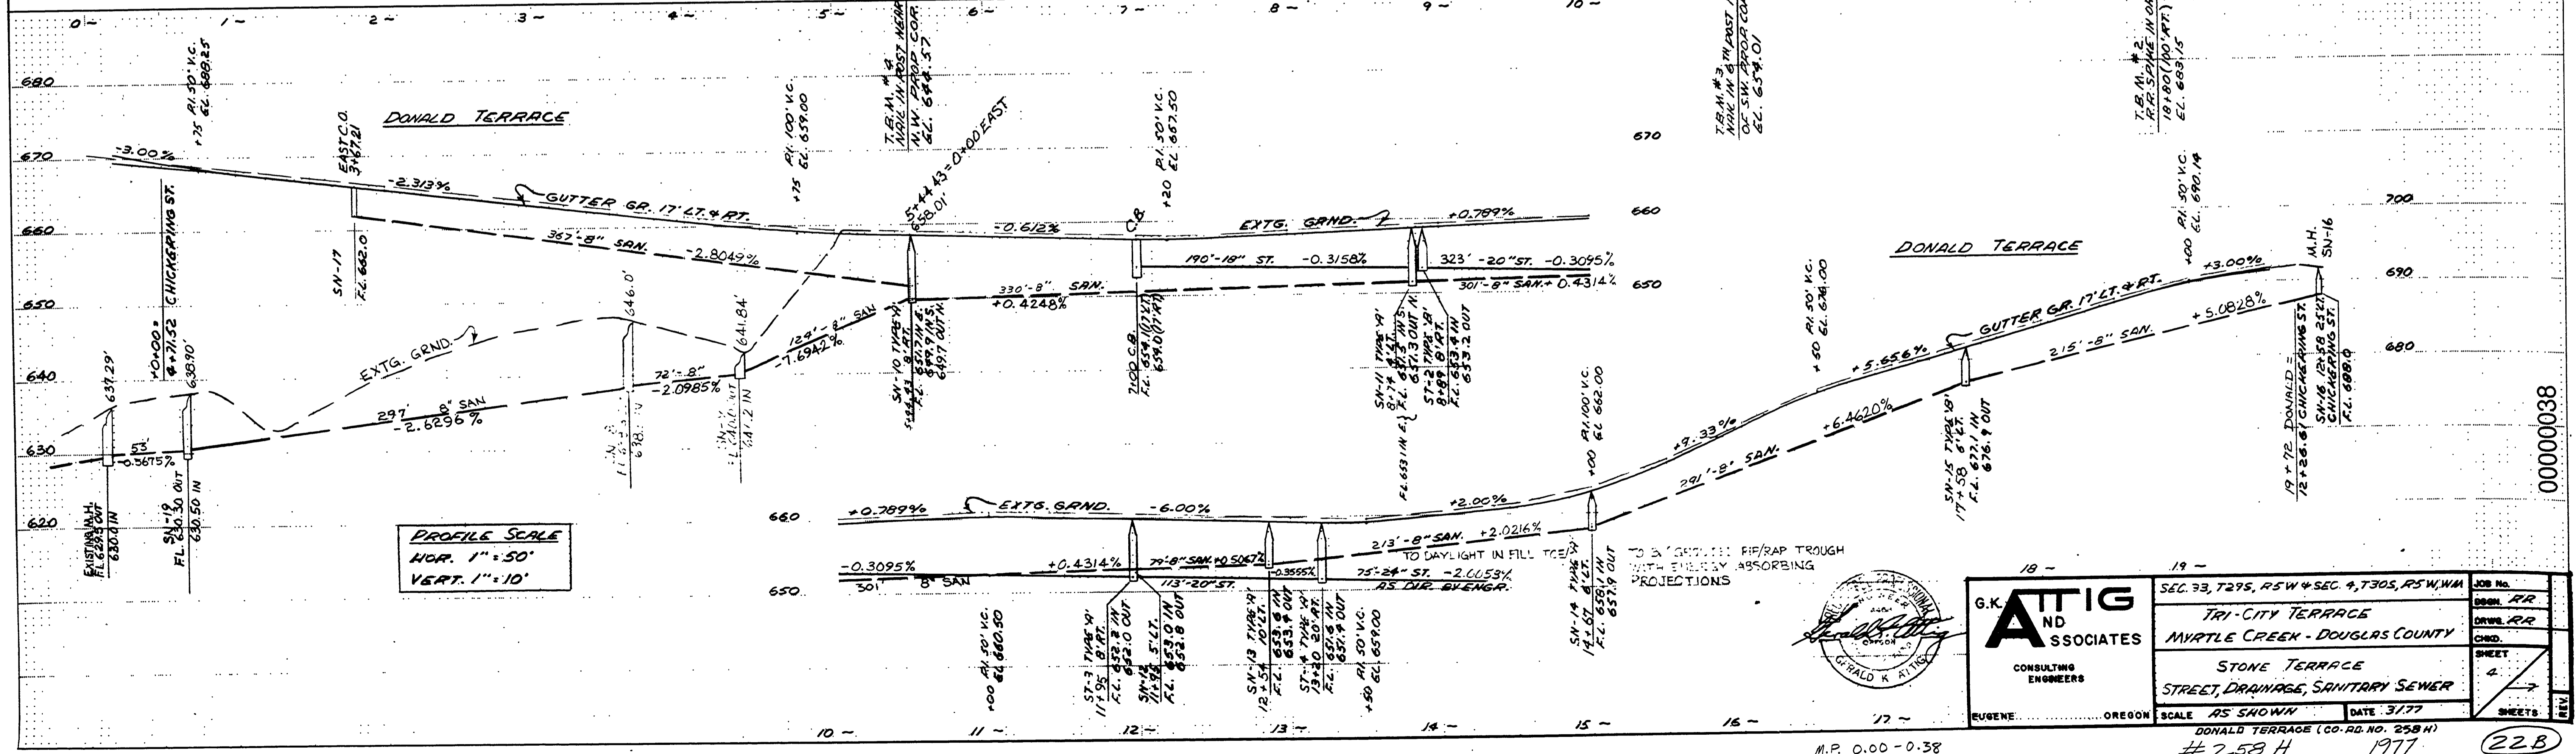

PROFILE SCALE
HOR. 1" = 50'
VERT. 1" = 10'

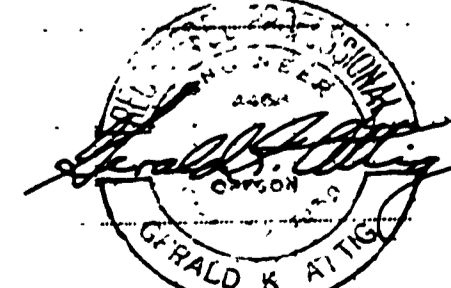

G.K. ATTIG AND ASSOCIATES
CONSULTING ENGINEERS

SEC. 33, T29S, R5W & SEC. 4, T30S, R5W, WM

TRI-CITY TERRACE
MYRTLE CREEK - DOUGLAS COUNTY

STONE TERRACE
STREET, DRAINAGE, SANITARY SEWER

SCALE AS SHOWN DATE 3/77

NO. 258 H 1977

00000038

00000038

M.P. 0.00-0.38

22B