


GENERAL SERVICES DIVISION  
 FEDERAL HOUSING ADMINISTRATION  
 CLOVERDALE ADDITION - ROSEBURG, OREGON  
 SCHEDULE P  
 MORRIS STREET

SCALE: AS NOTED	DATE: MARCH 28, 1957	SHEET 5	OF 9
DES. DWR DR. A.L.S. CK	CORNELL, HOWLAND, HAYES & MERRYFIELD CORVALLIS, OREGON ENGINEERS		DWG. NO. C-371-5
1" = 120' HORIZ. 1" = 10' VERT.	AS BUILT	TAC	TRC GJW
NO. DATE	BY	CHK	APP

FILED  
 RECEIVED  
 COUNTY SURVEYOR  
 DOUGLAS COUNTY, OREGON

PROFILE SCALES: HORIZ. 1" = 50'  
 VERT. 1" = 10'

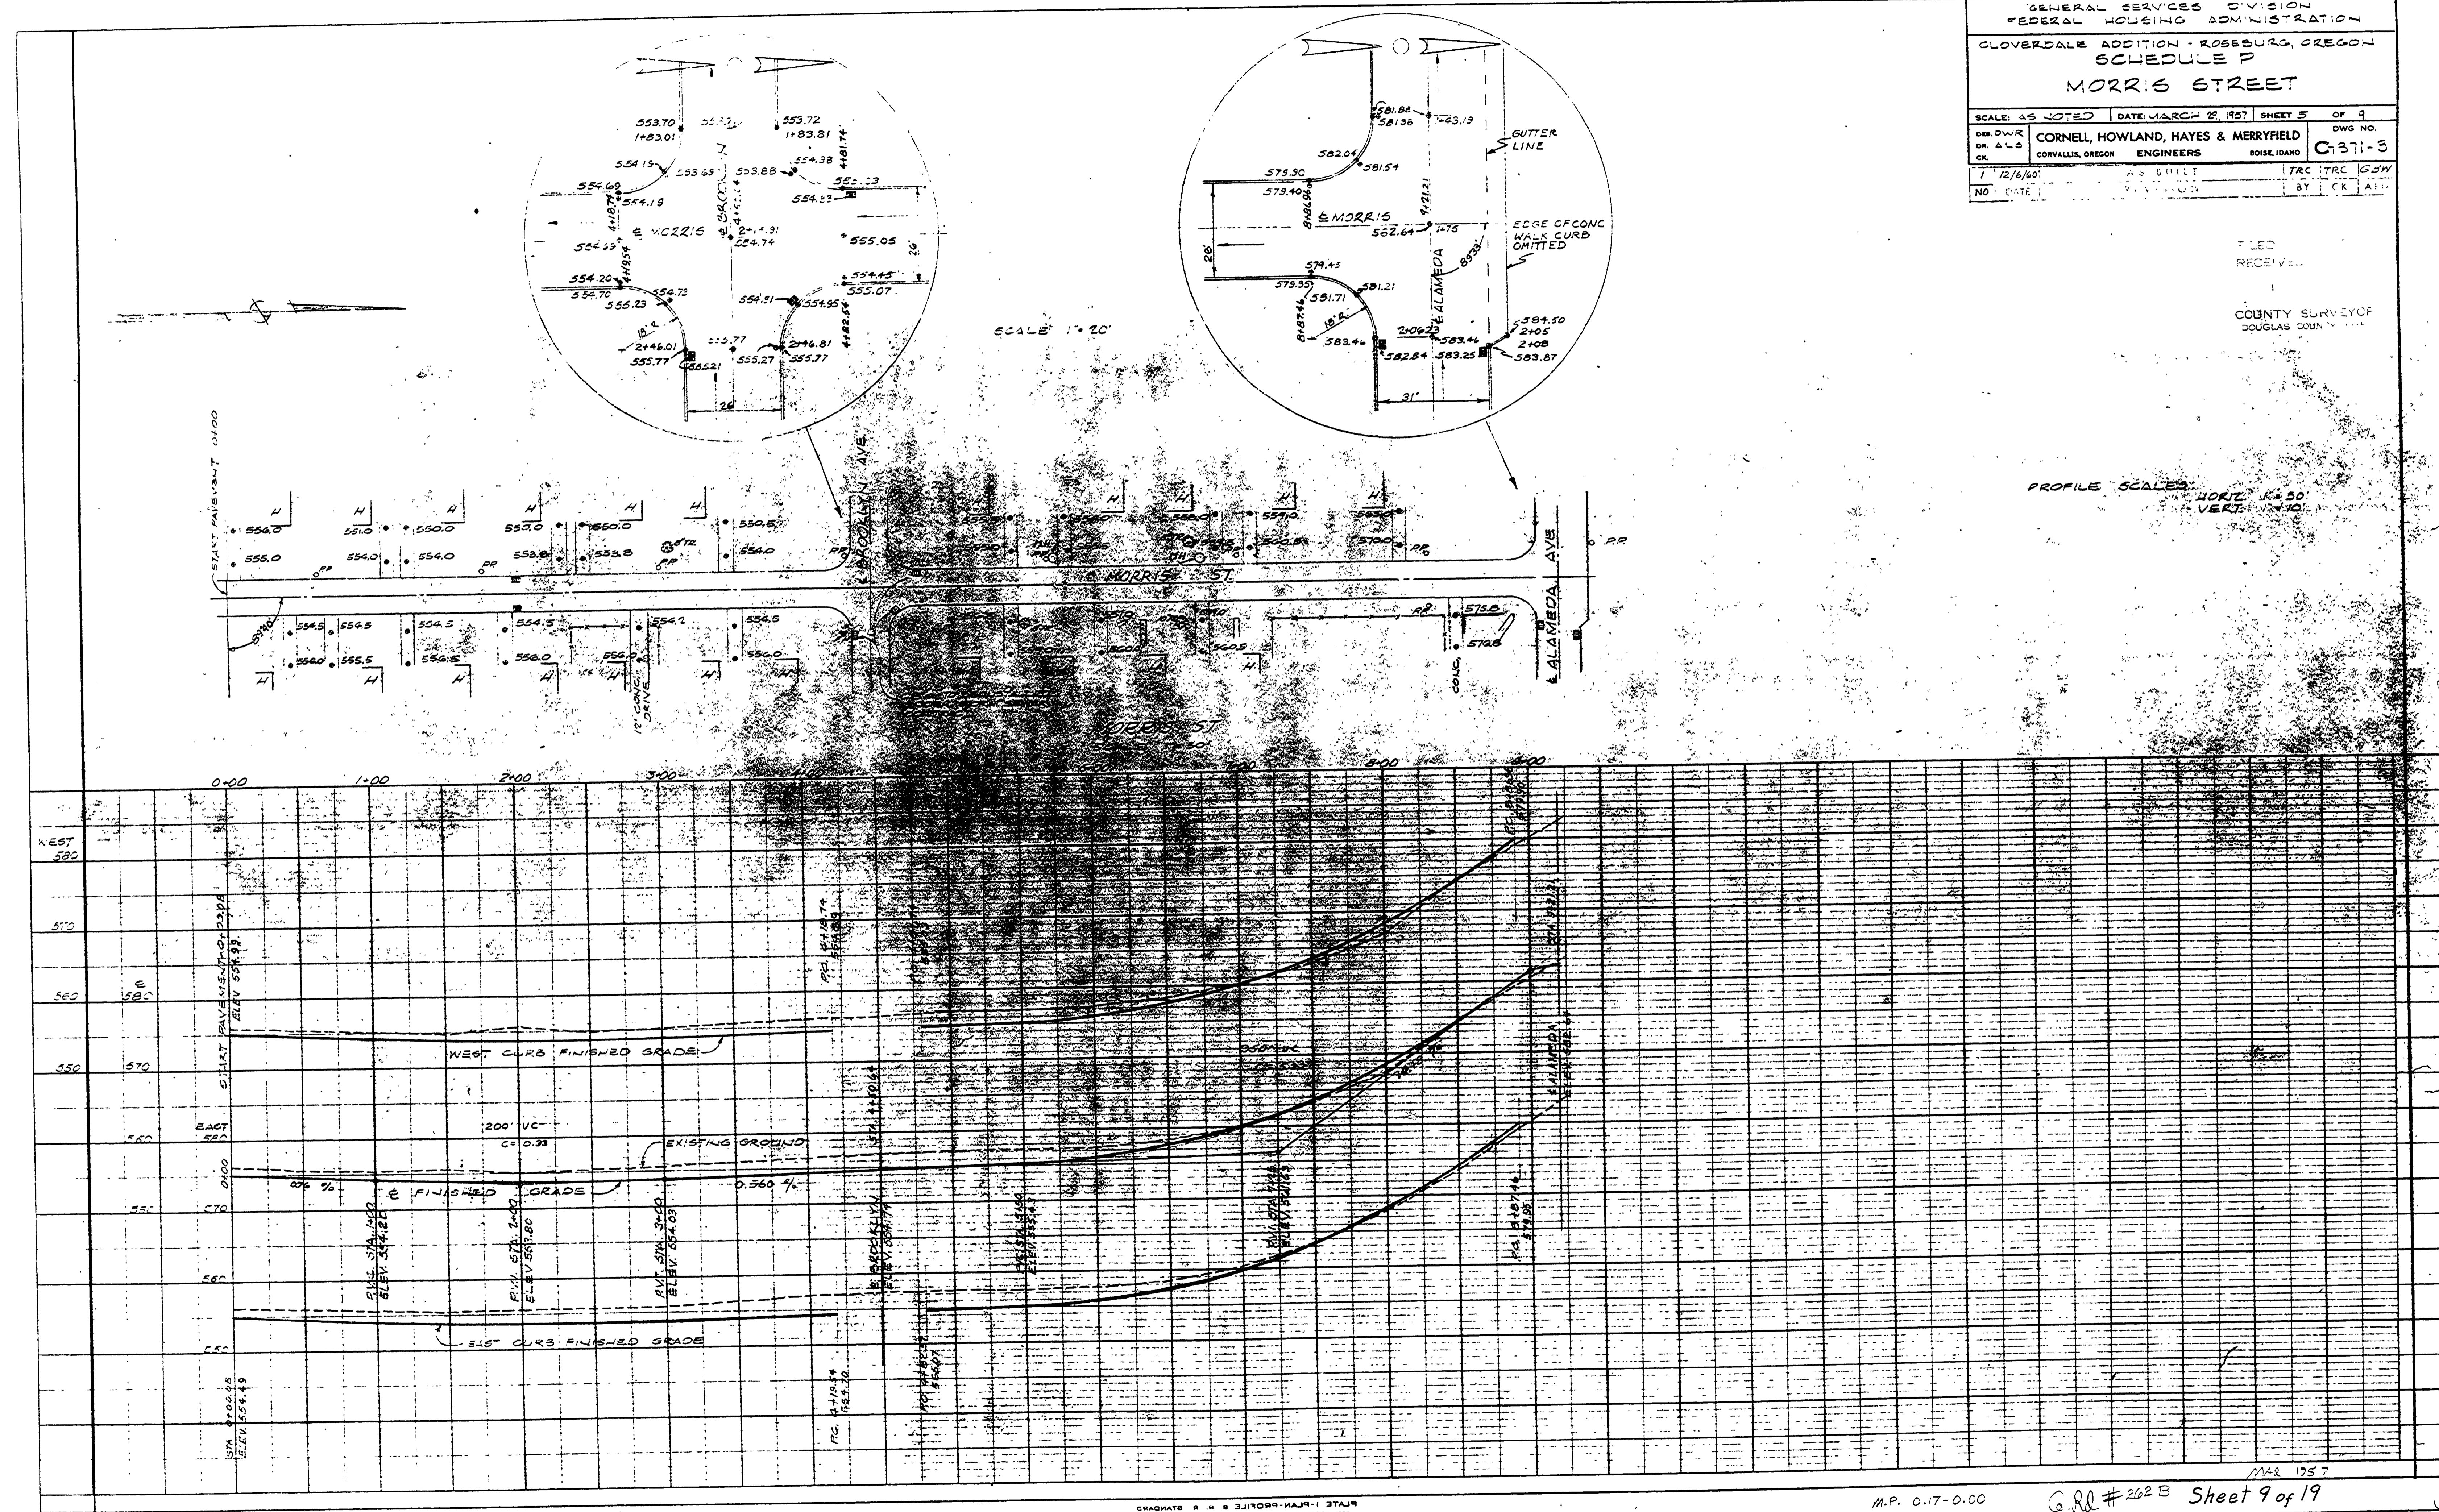

ENGINEER: DILLON  
 1000 OREGON AVENUE - SEASIDE, OREGON  
 PLATE 1 PLAN-PROFILE B. B. SANDRA

00170000