

GENERAL SERVICES DIVISION FEDERAL HOUSING ADMINISTRATION			
CLOVERDALE ADDITION - ROSEBURG, OREGON			
SCHEDULE P			
JACOBSON AND TAYLOR STREETS			
SCALE: AS NOTED	DATE: MARCH 29, 1957	SHEET 9 OF 9	DWG. NO.
DRS. DWG. DR. VGS CK.	CORNELL, HOWLAND, HAYES & MERRYFIELD CORVALLIS, OREGON ENGINEERS BOISE, IDAHO		C1371-3
NO. 1	DATE 12/6/60	REVISION AS BUILT	JVR TRC
			SY CK APD

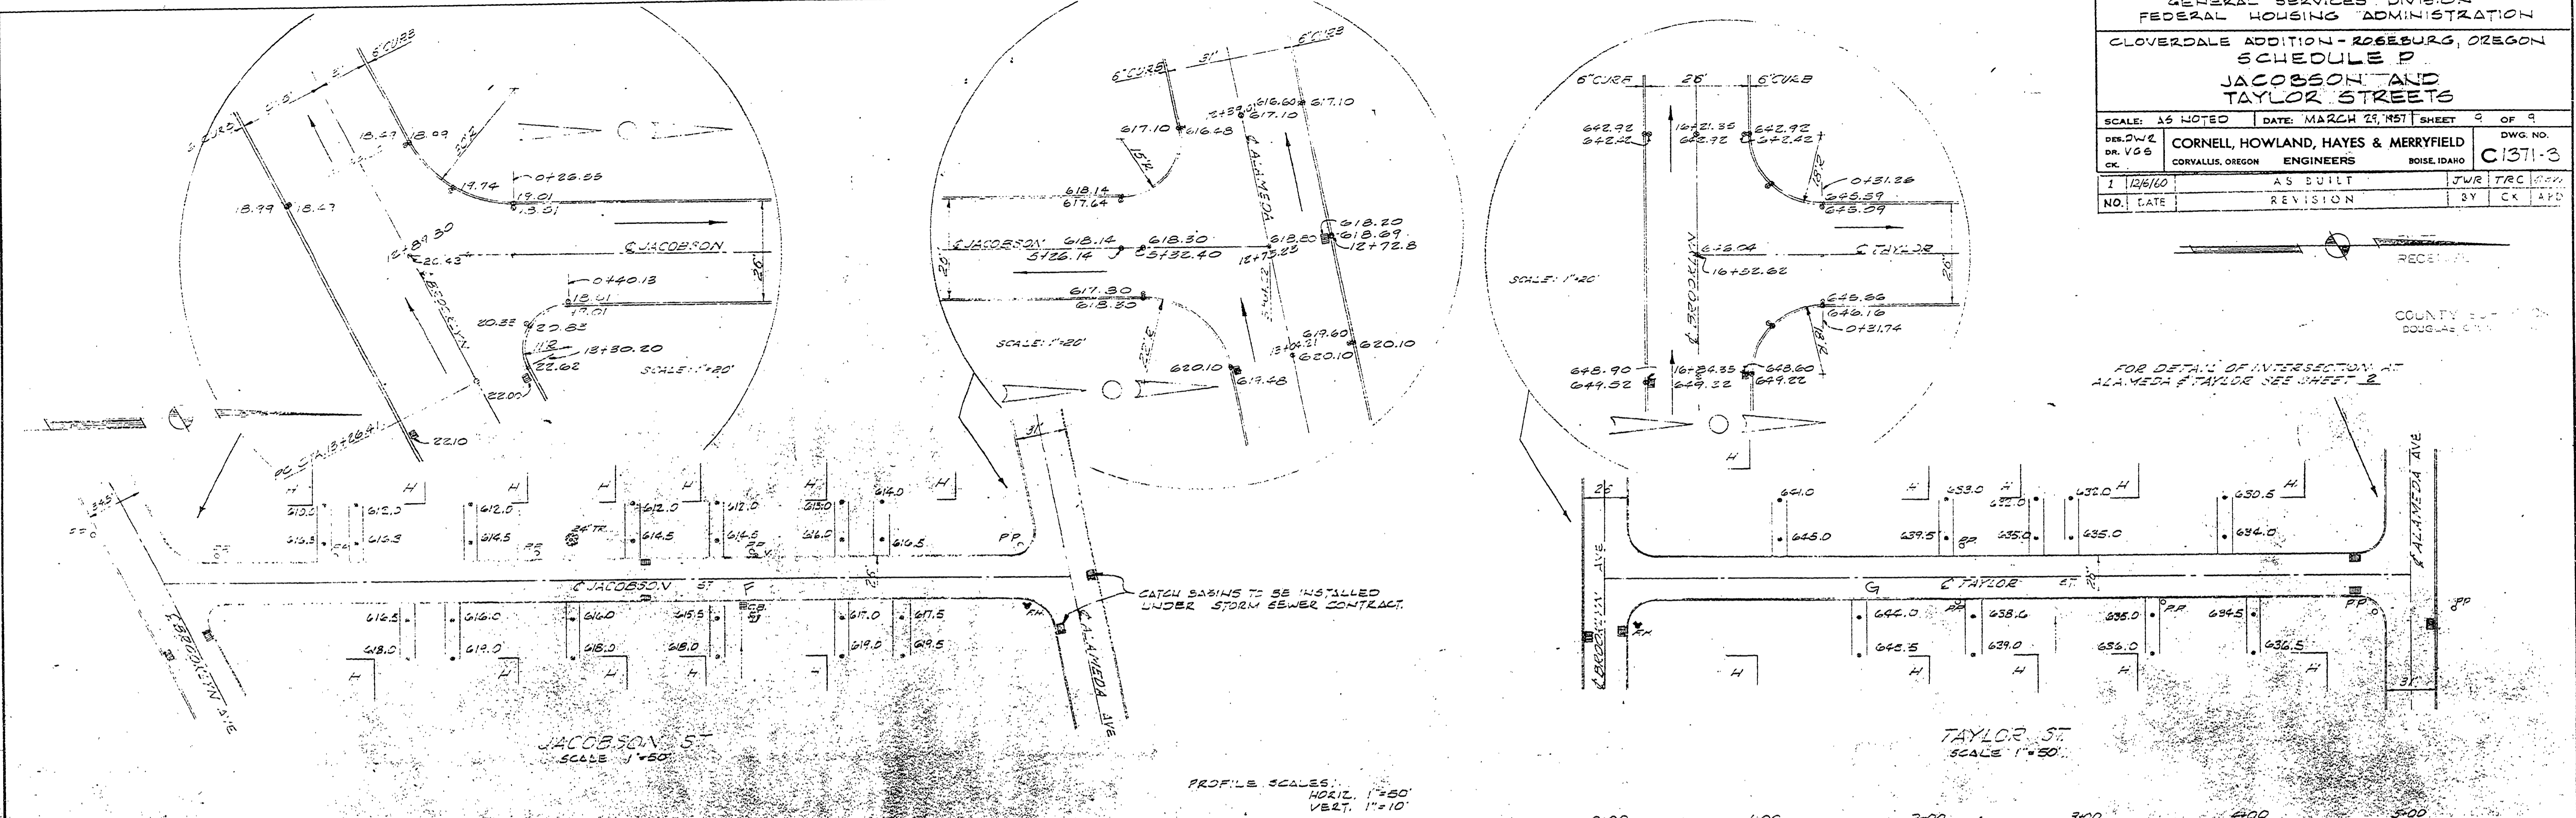


PLATE 1 - PLAN - PROFILE B. R. B. STANDARD
100% REPRODUCED FROM ORIGINAL DRAWING
ENGINEER DESIGNER