


DOUGLAS COUNTY ROAD DEPARTMENT

Douglas County, Oregon
PLANS FOR PROPOSED PROJECT

**AS CONSTRUCTED
RIDDLE BY-PASS**

County Road No. 263


July 1961

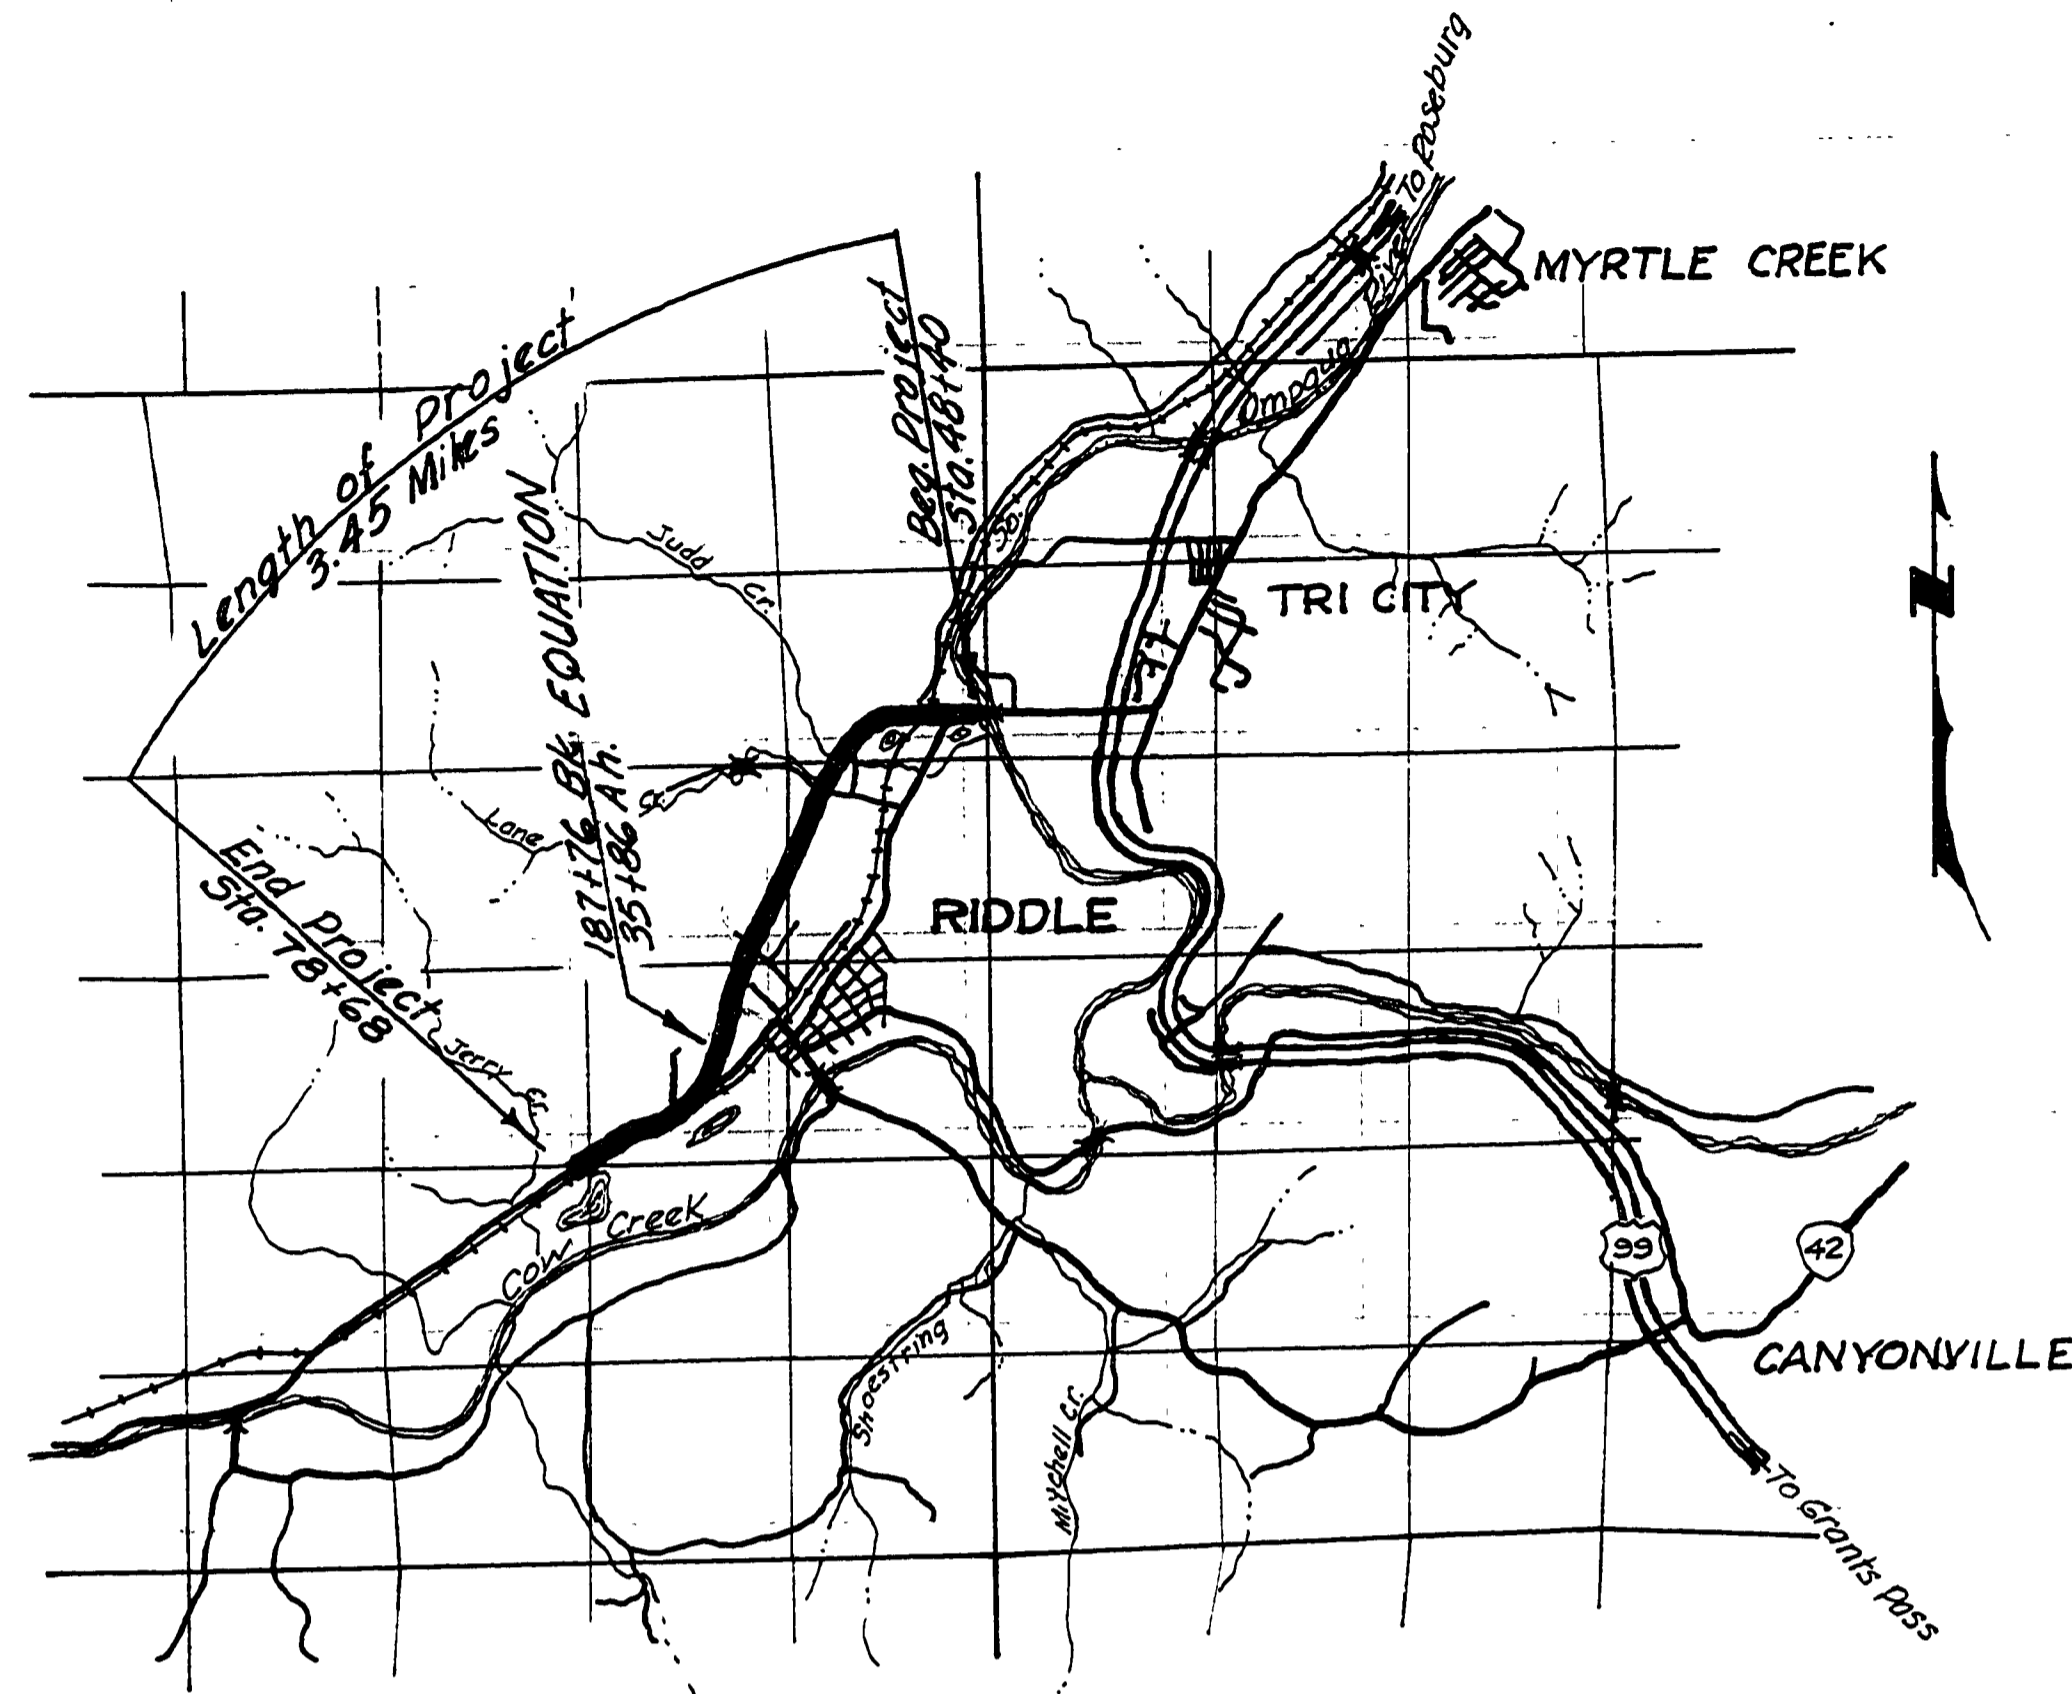

Approved *A. H. May*
County Engineer

Date *8/7/61*

TYPICAL SECTIONS

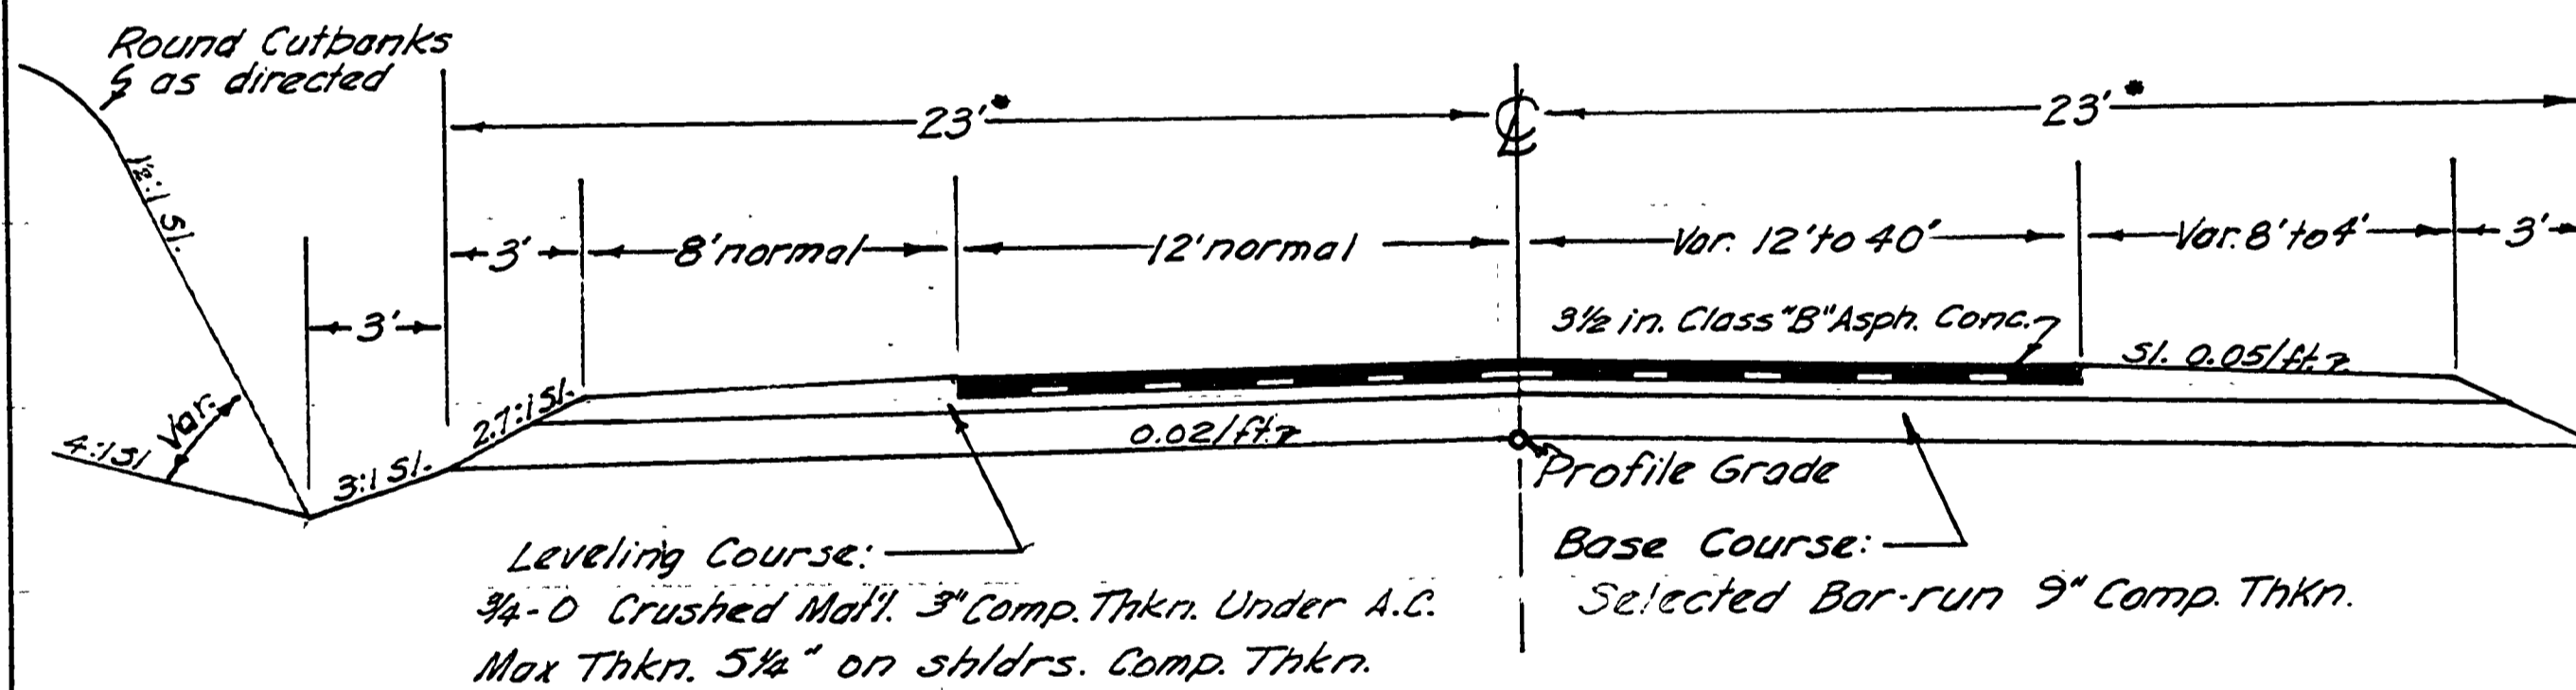

Approved by the County Court _____


JUDGE _____
COMM. _____
COMM. _____

Leveling Course:
3/4" - 0 Crushed Mat'l. 3" Comp. Thkn. Under A.C.
Max. Thkn. 5 1/4" on shldr. Comp. Thkn.

Base Course:
Selected Bar-run 9" Comp. Thkn.


* Variable 23ft. to 47ft. in traffic turn-outs
See sheets 9 & 10 for details

Mainline Roadbed "L" Sta. 48+40 to 187+76 Bk.
" " "L" Sta. 35+86 Ah. to 78+68

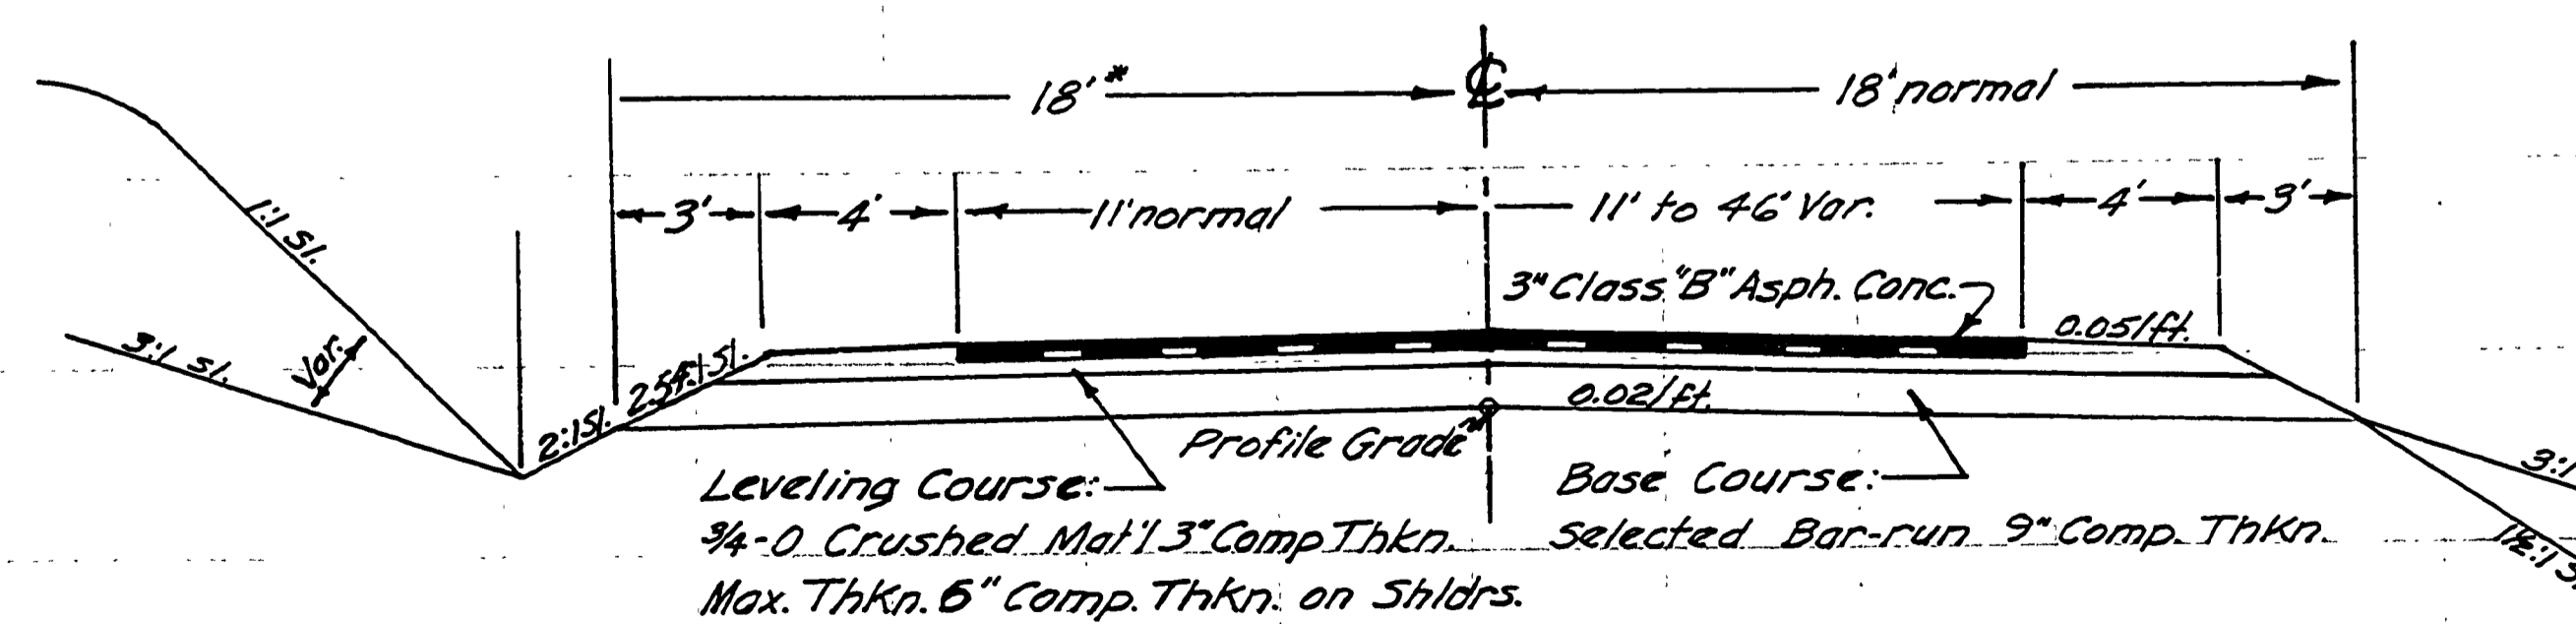

* Variable 18ft. to 50ft. in Radius returns
See Sheets 9 & 10 for details

Road Connections, On & Off Ramps
"T", "S" & Boyer. Co. Rd. Lines

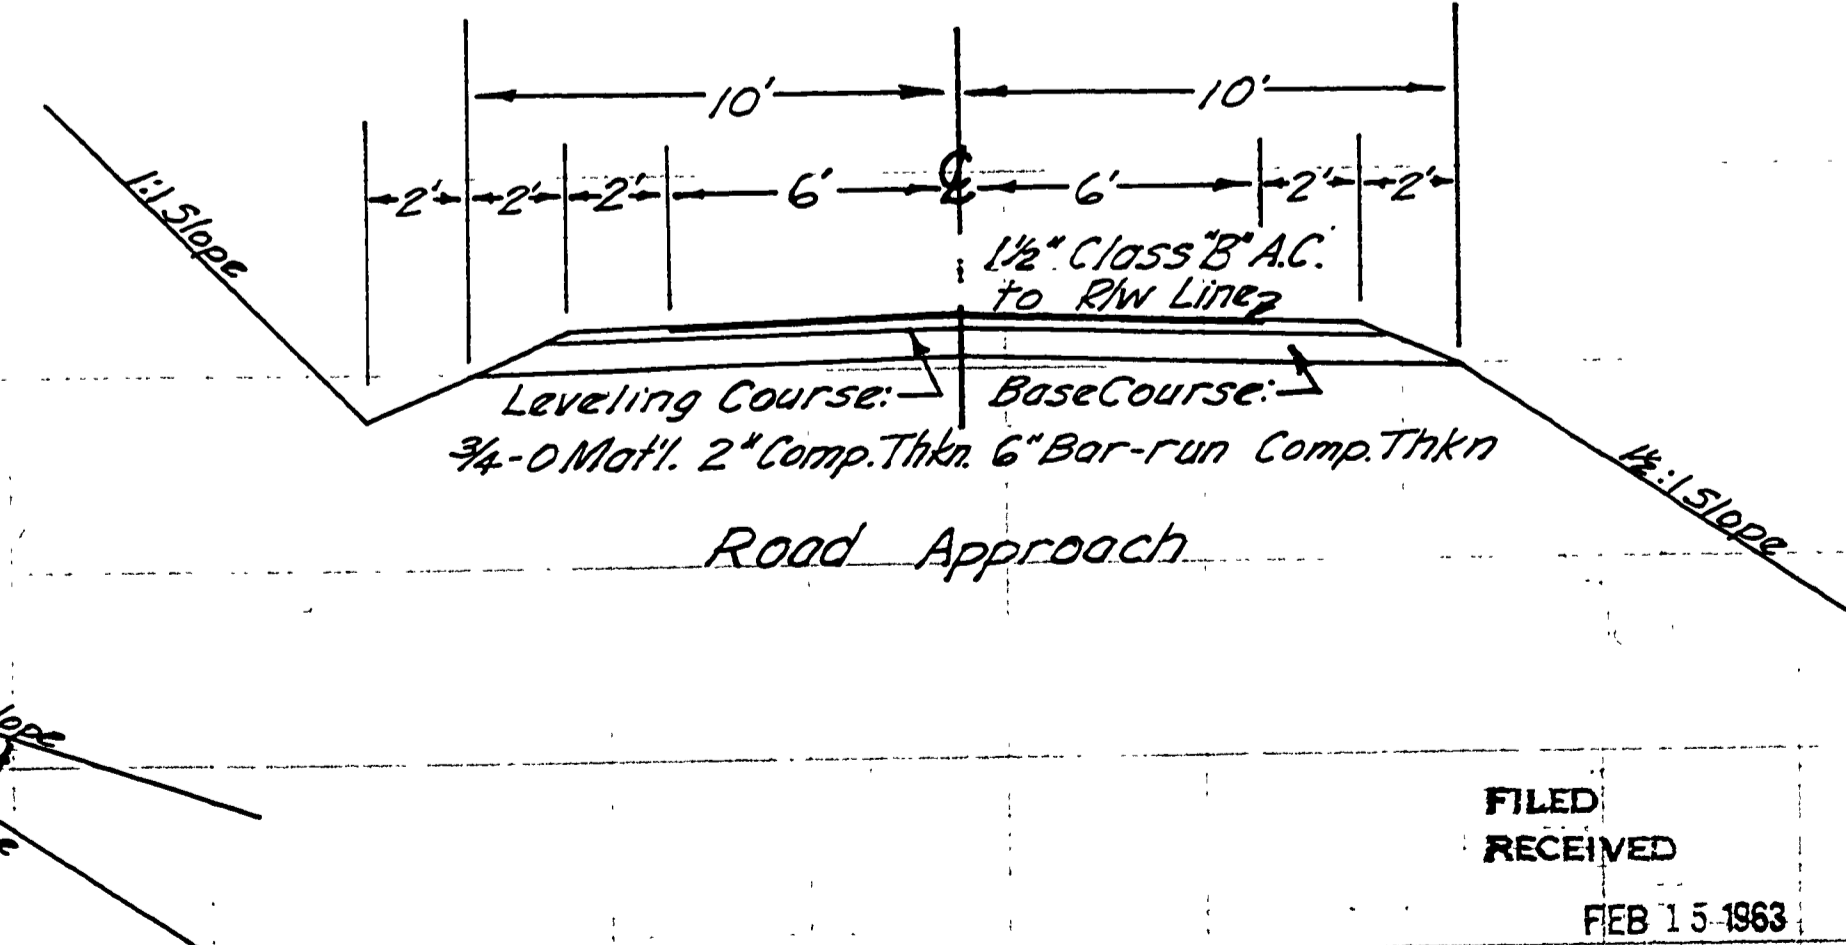

FILED
RECEIVED

FEB 15 1963

COUNTY SUEVEYOR
DOUGLAS COUNTY, ORE.

Revised 8-11-61

July 1961
G. Rd # 263
Sht. 1 of 3
(21)

0000283