


DOUGLAS COUNTY OREGON

PLANS FOR PROPOSED PROJECT


AS CONSTRUCTED

WINSTON PARK ROAD

COUNTY ROAD #266

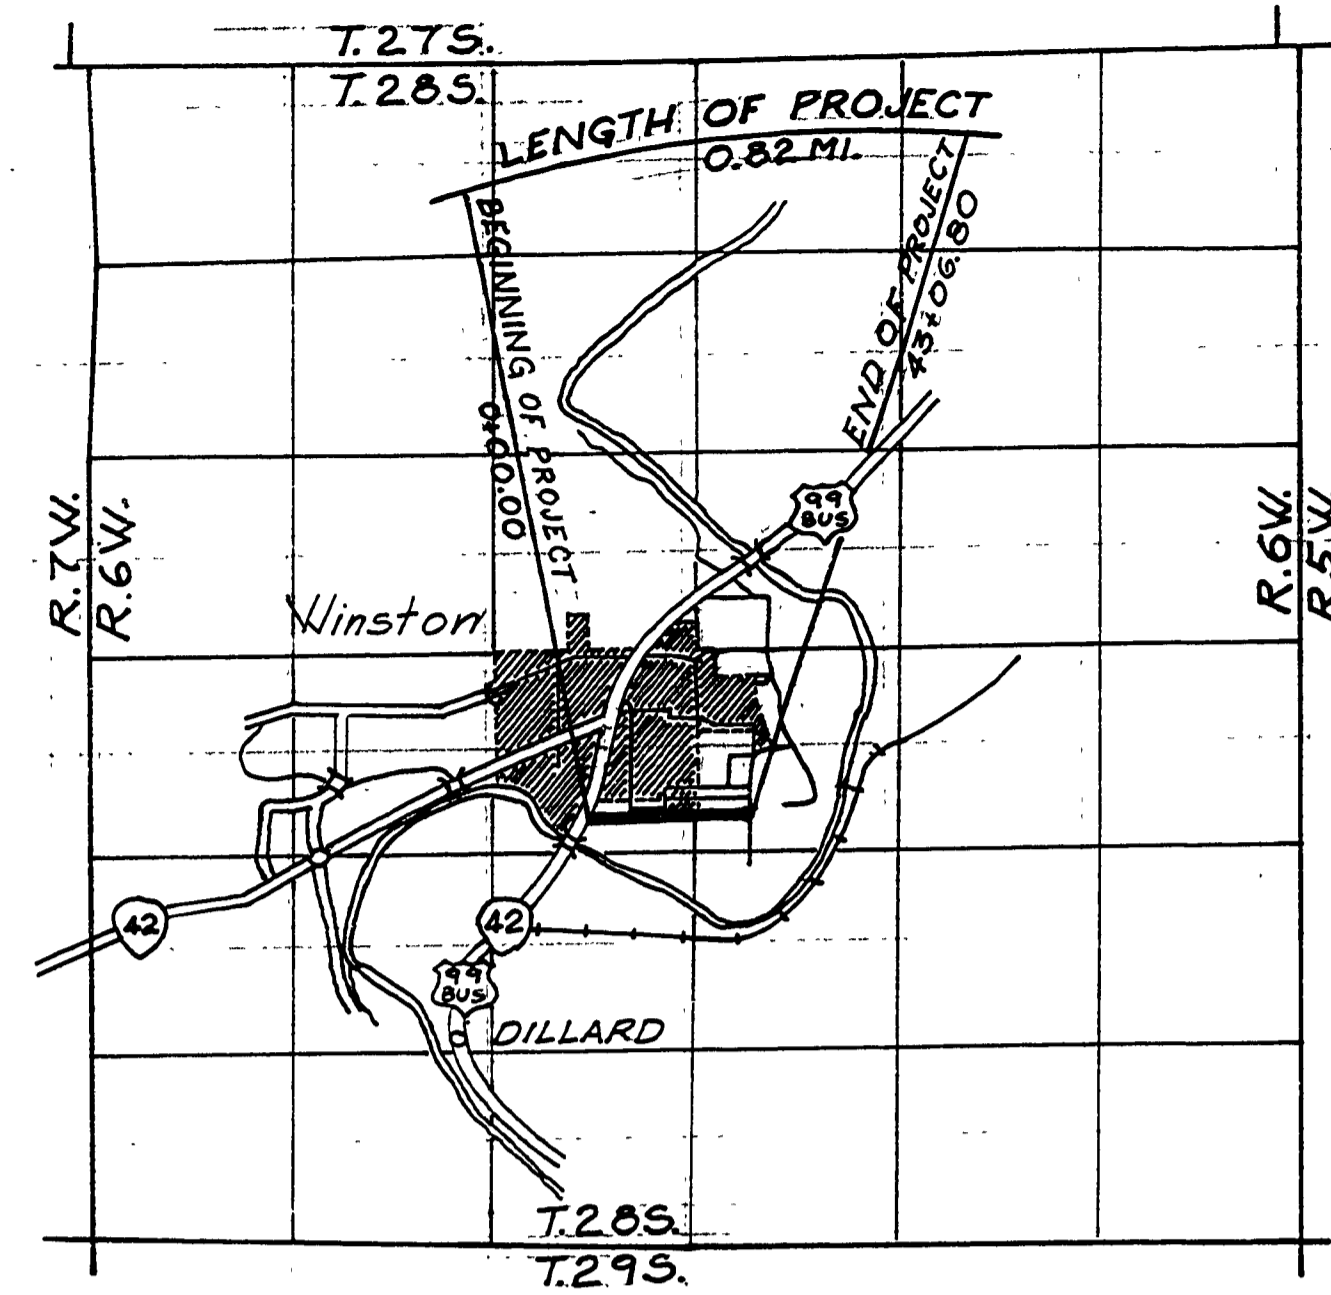

VICINITY MAP

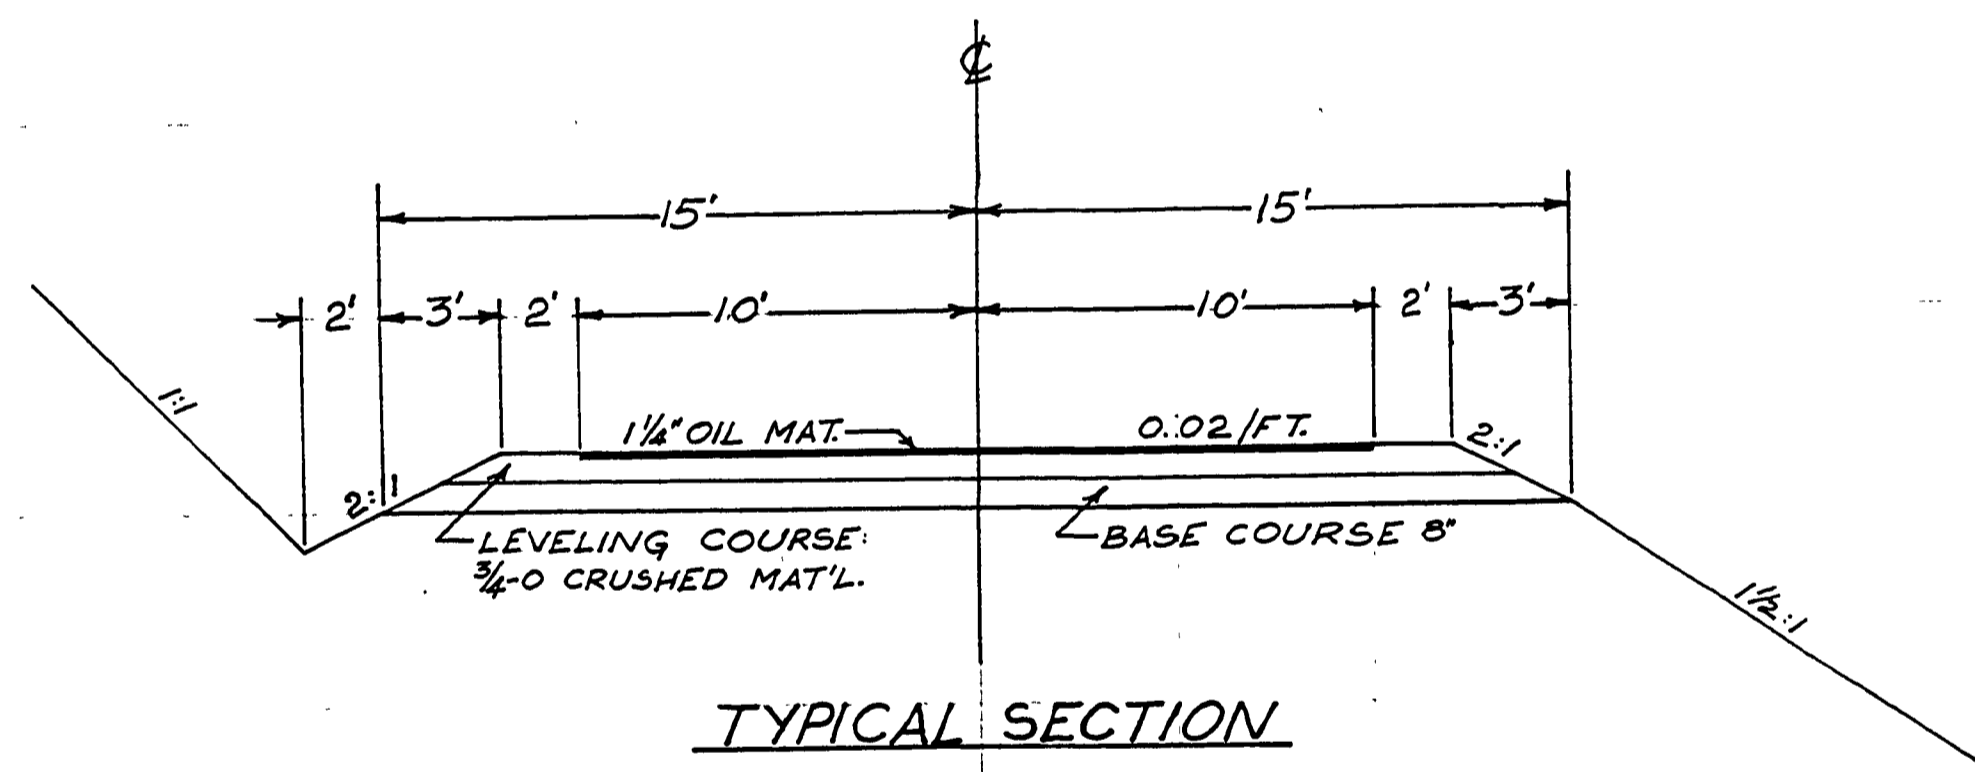

TYPICAL SECTION

Accepted by George E. Gault Nov 24, 1962
Asst. Engineer



THOMPSON AVENUE: A portion of a road lying between Old Highway 99 and Winston Road County Road No 111. Dedicated in Benders Subdivision as recorded in Volume 11 Page 30 of Douglas County Plat Records. Adopted by resolution of the County Court. 1962

V. L. Jackson
COUNTY JUDGE
E. K. Metzger
COUNTY COMMISSIONER
Ray C. Osborn
COUNTY COMMISSIONER

FILED
RECEIVED

FEB 21 1963

COUNTY SURVEYOR
DOUGLAS COUNTY, ORE.

0000008C