

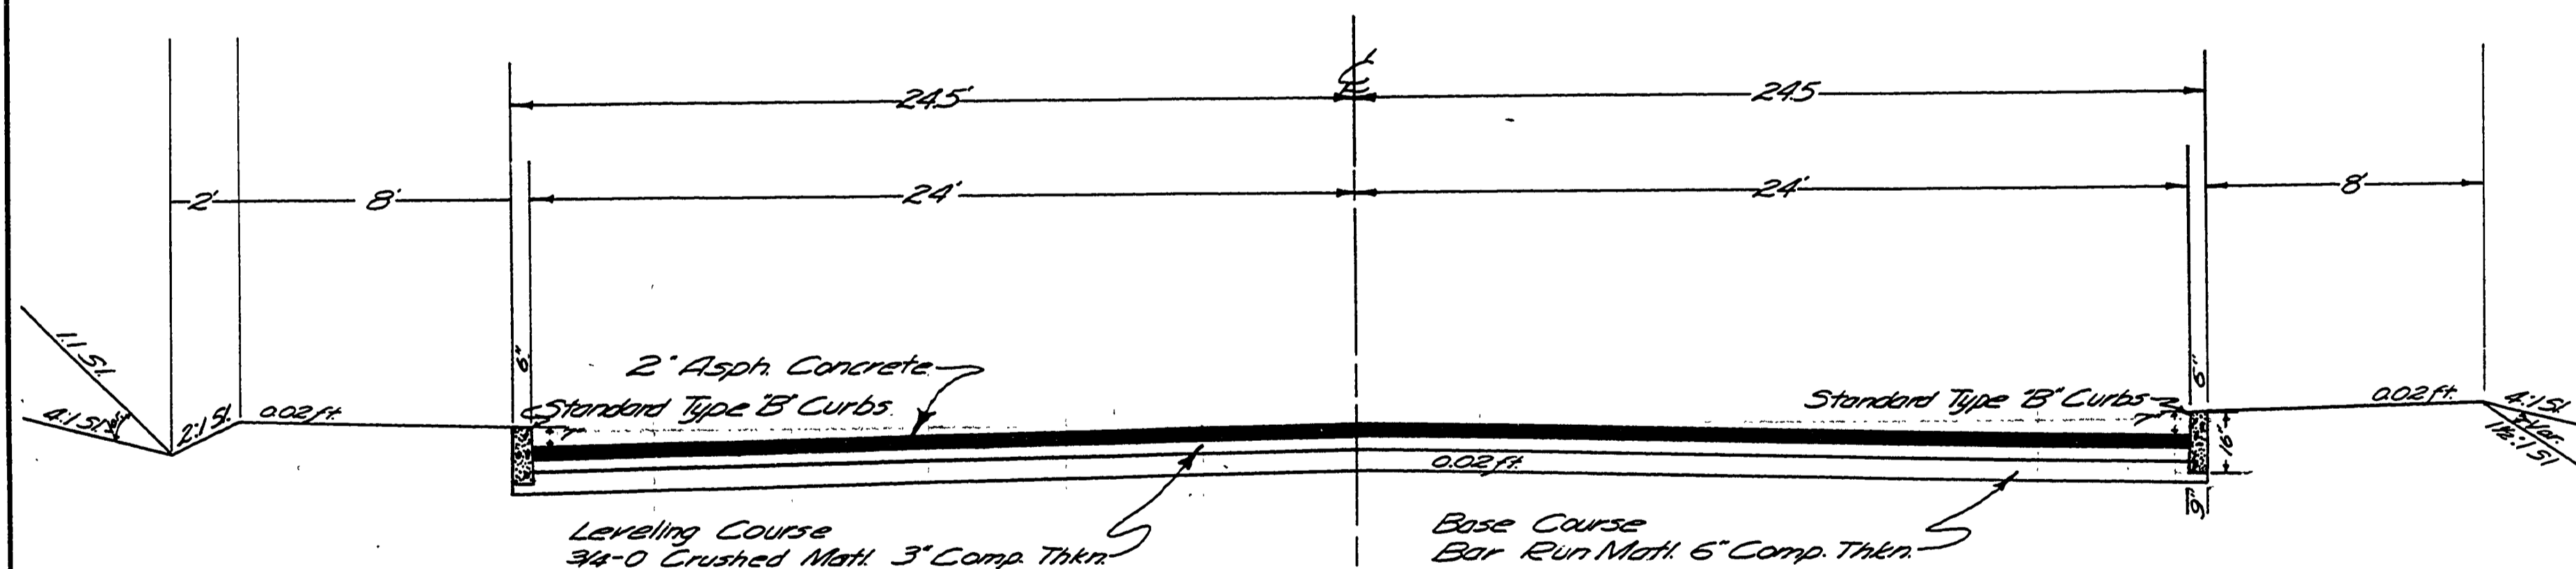


DOUGLAS COUNTY OREGON
 AS CONSTRUCTED
 GRADING & SURFACING
 TROOST STREET
 COUNTY ROAD NO. 273
 JULY 1964

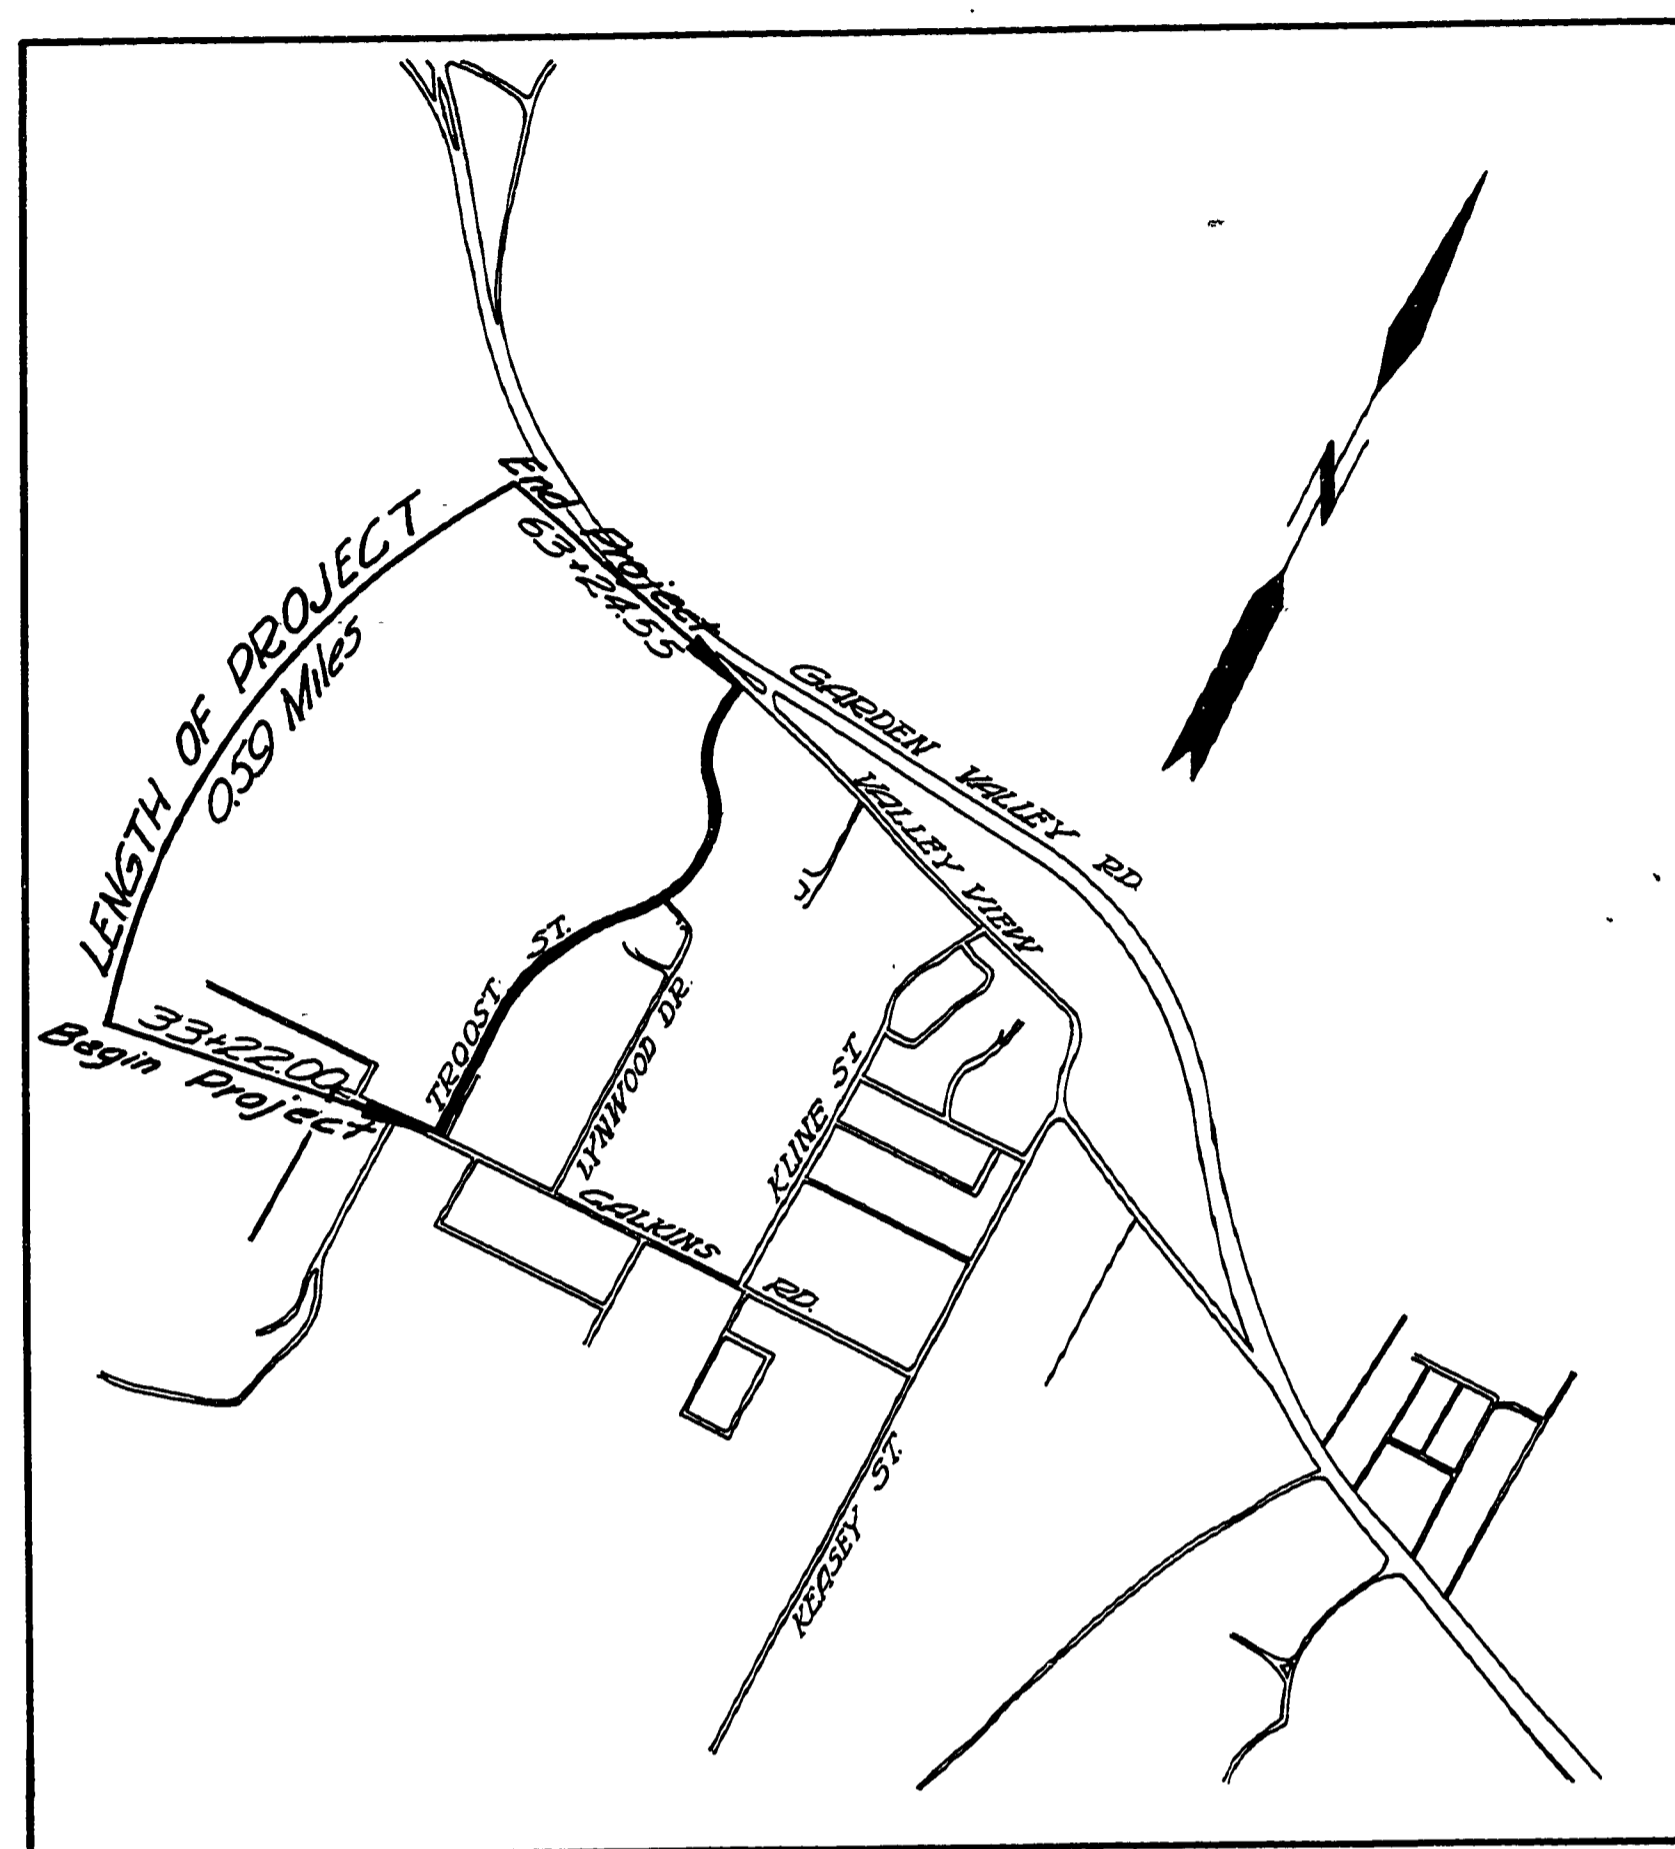

Typical Section
 Sta. 32+22.00 to Sta. 63+24.55

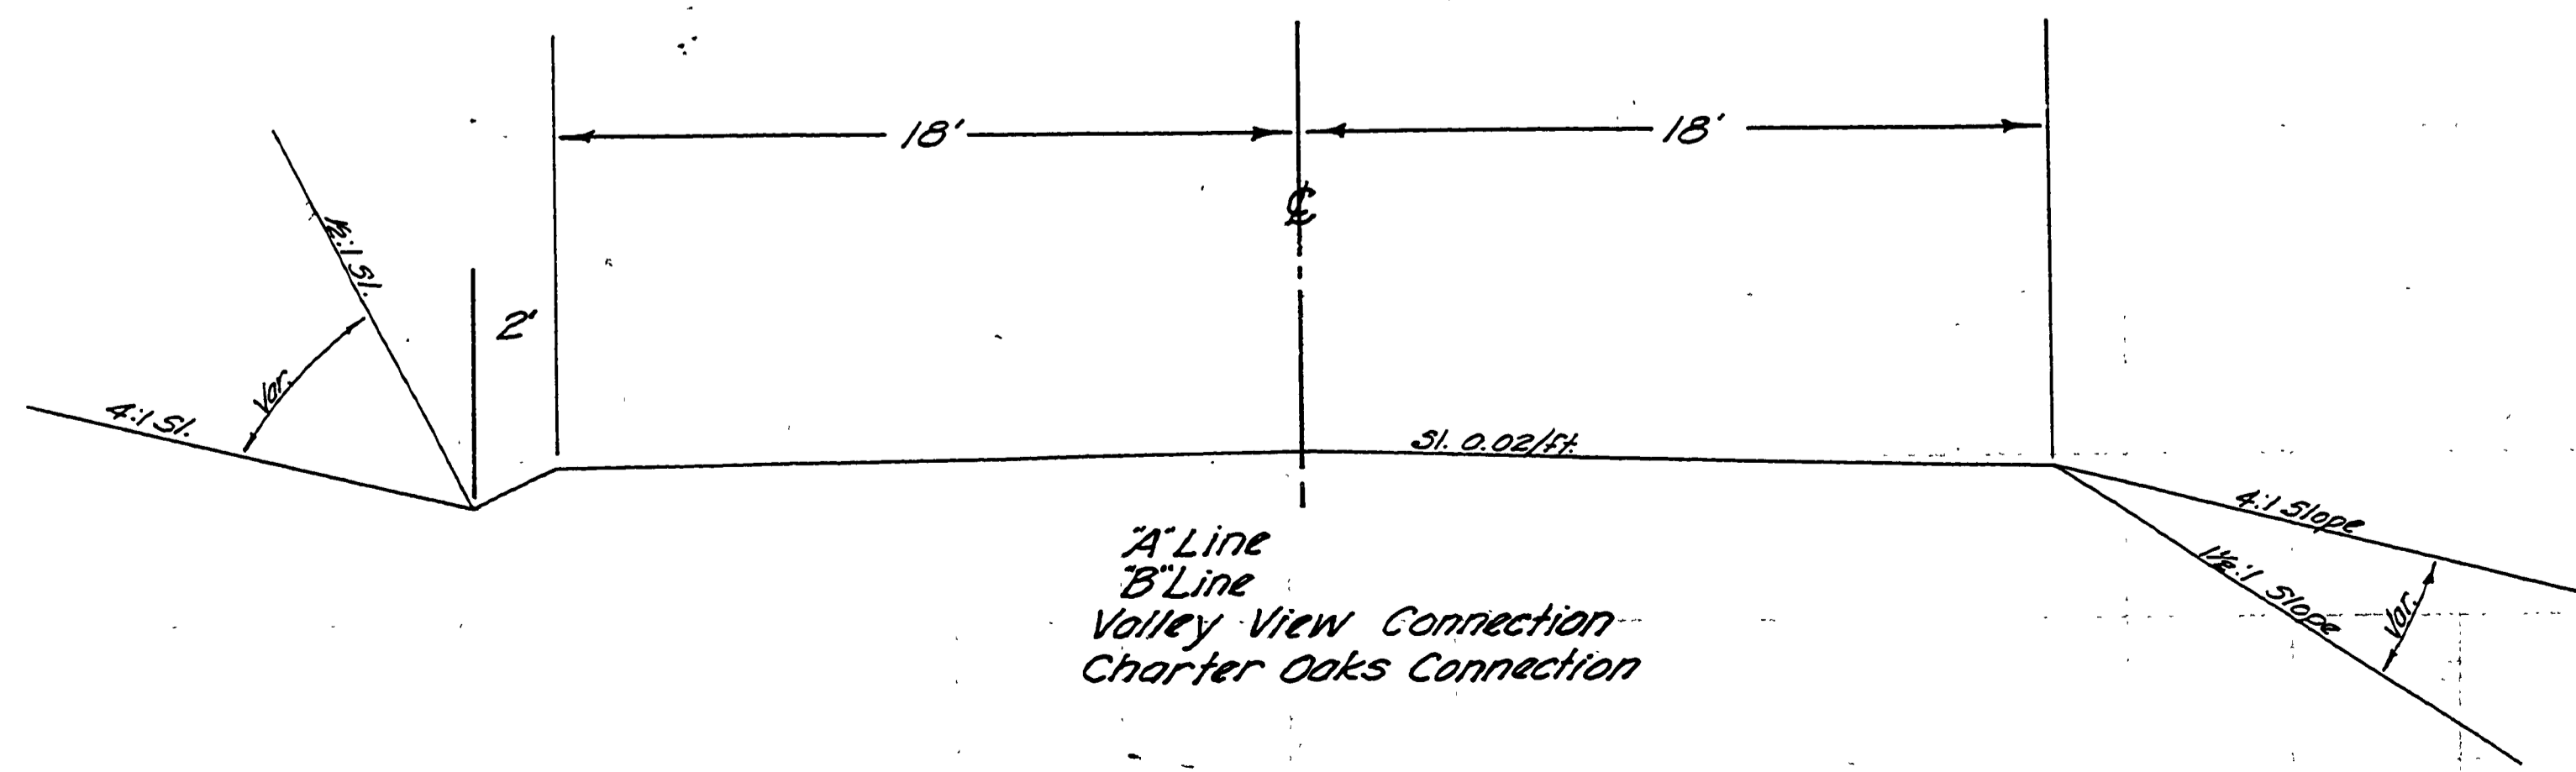

A-Line
 B-Line
 Valley View Connection
 Charter Oaks Connection

Approved Nov. 24, 1964
 By the County Court
V. J. Jackson
 COUNTY JUDGE
Commissioner
Commissioner

Approved Al. H. May July 16, 1964
 County Engr.



FILED
 RECEIVED
 MAR 11 1965
 COUNTY SURVEYOR
 DOUGLAS COUNTY, ORE.

0057000C