

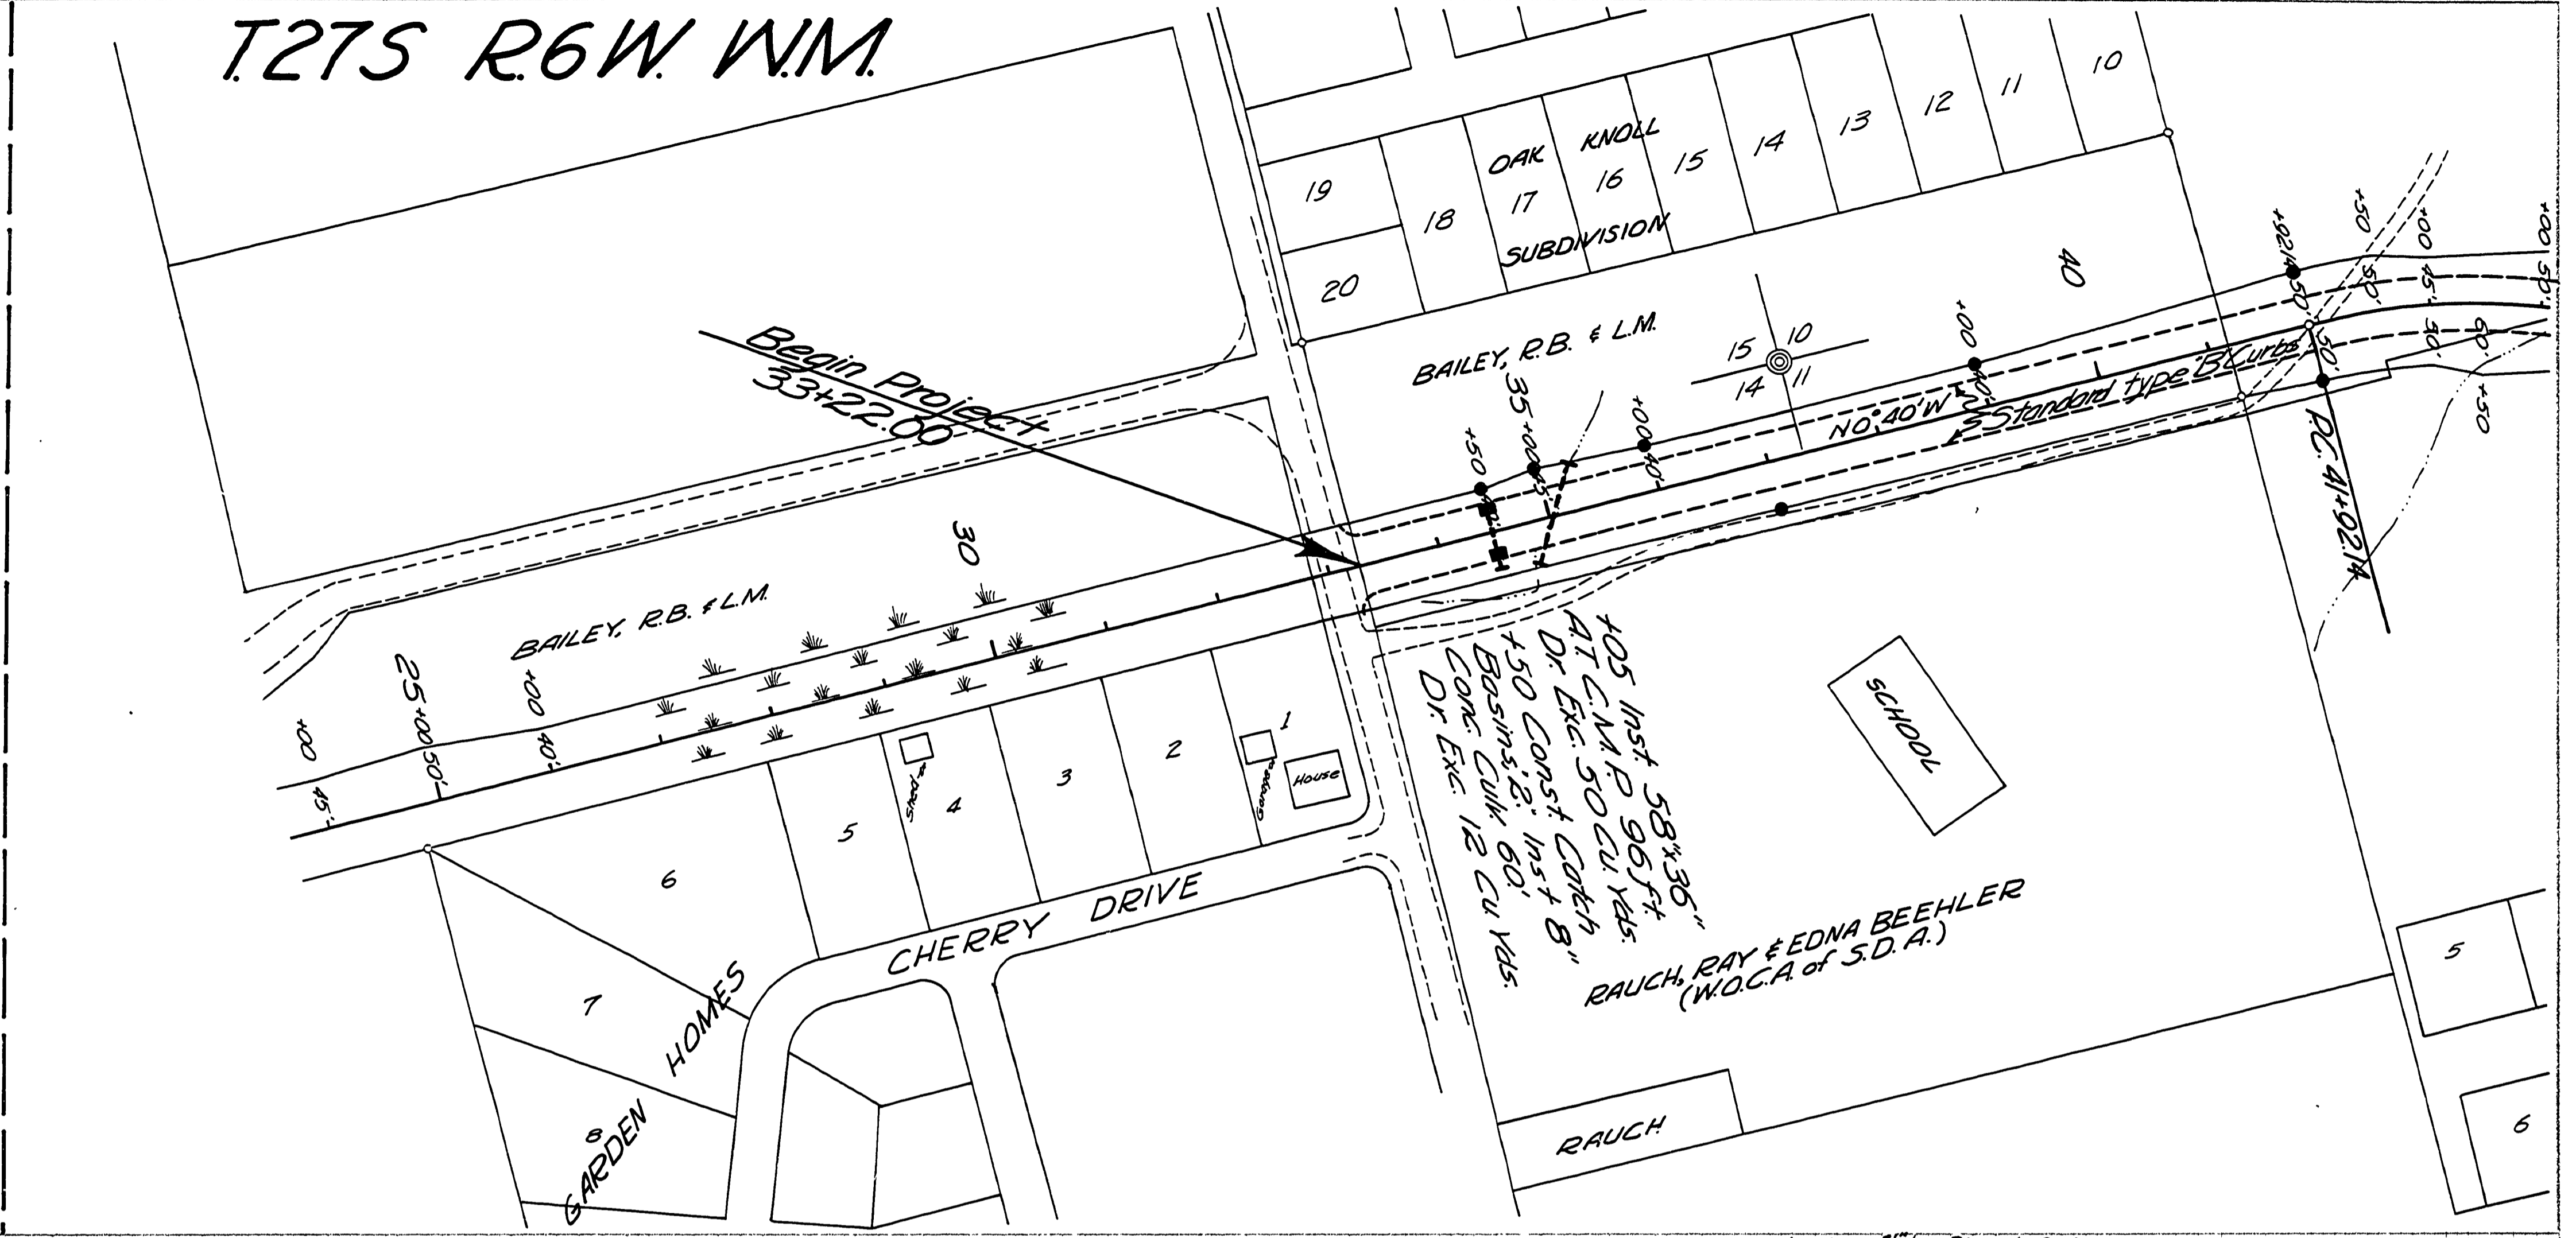


PLANNED  
SOUTH  
EAST  
WEST  
NORTH  
BY  
DATE

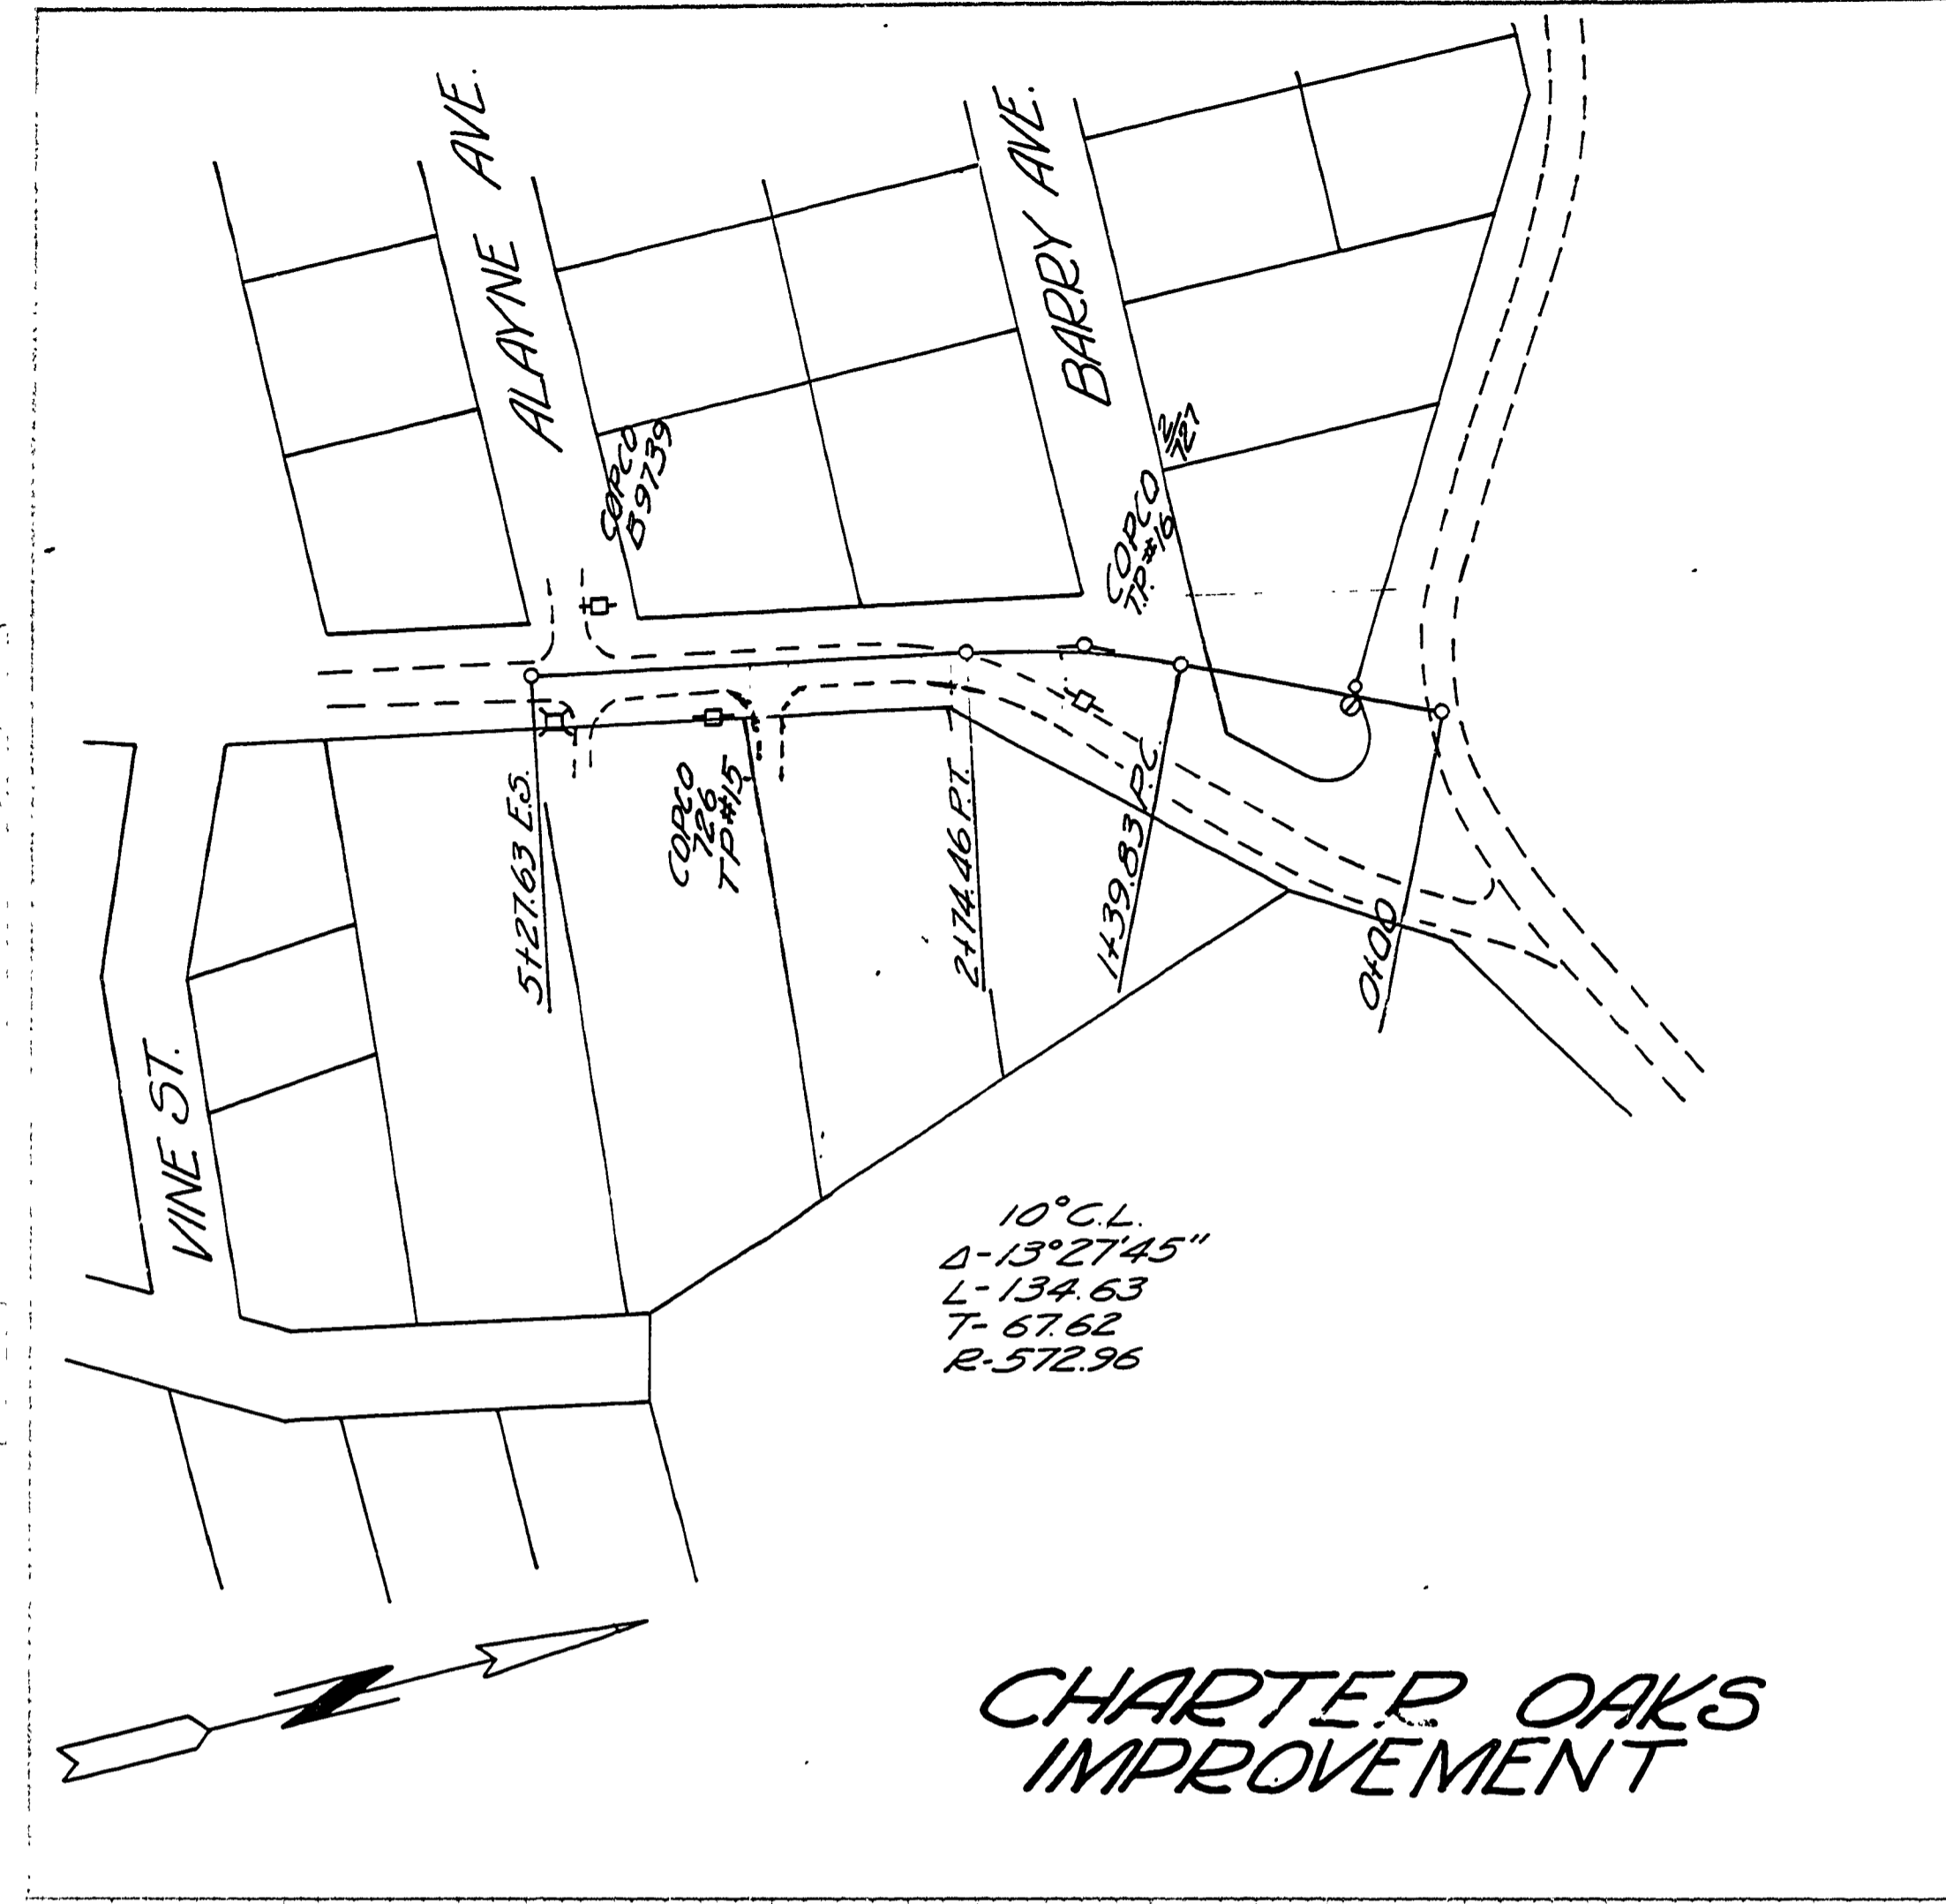

● Indicates 3/4" Iron Pins No Posts.

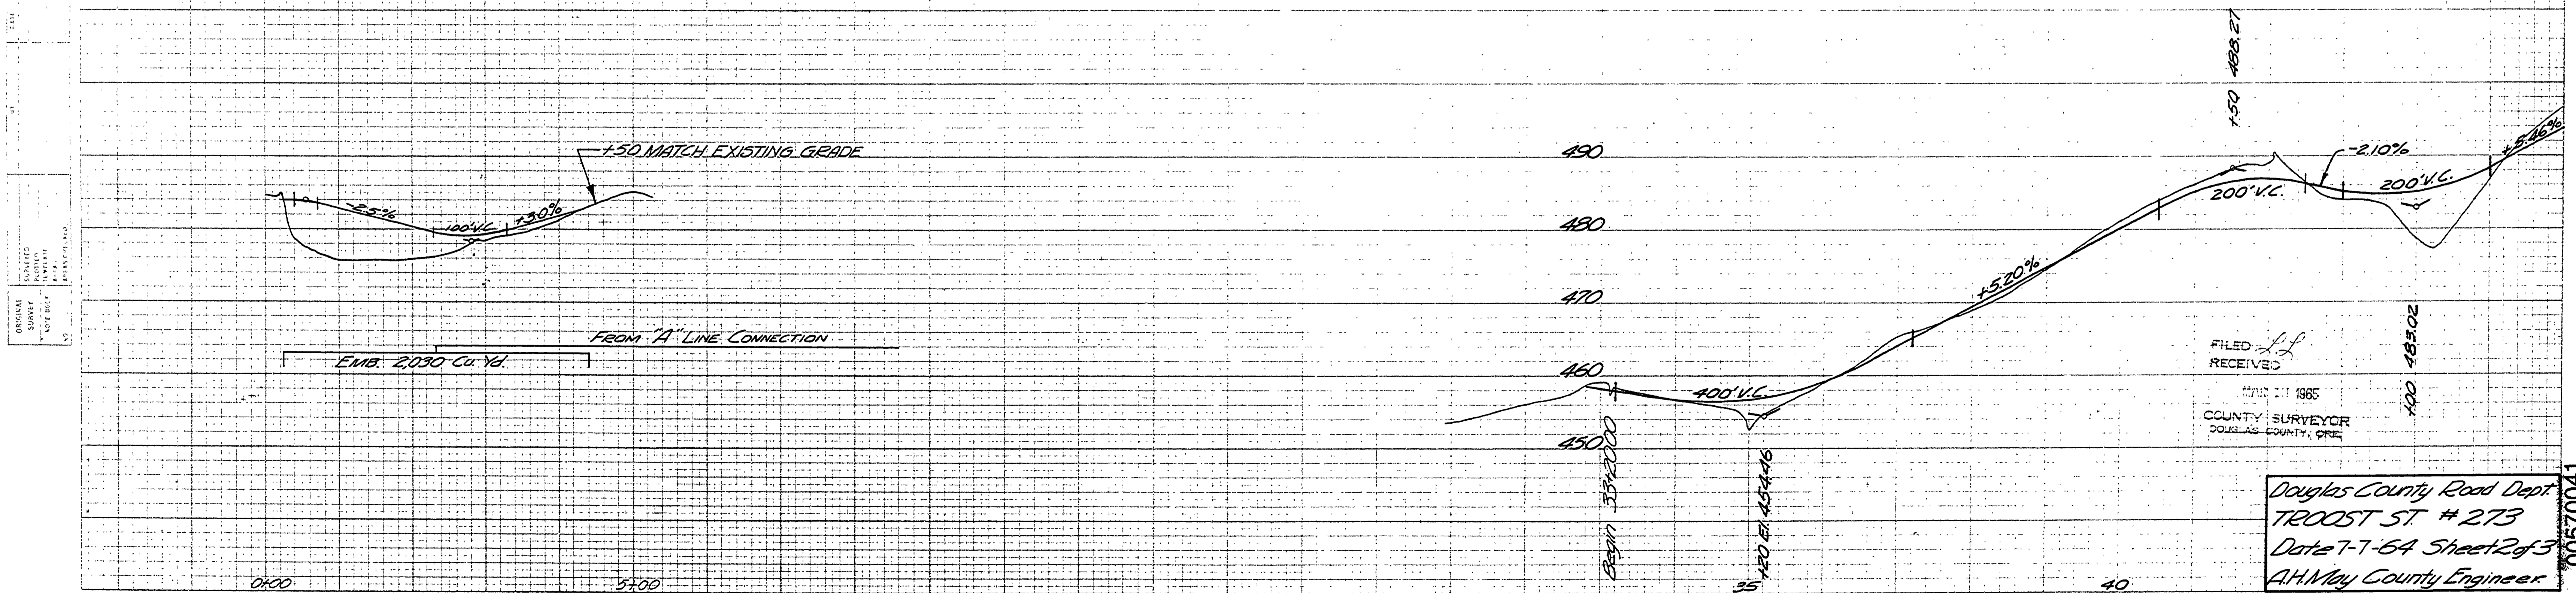

Douglas County Road Dept.  
TROOST ST. # 273  
Date 7-7-64 Sheet 2 of 3  
A.H. May County Engineer.