


# DOUGLAS COUNTY OREGON

AS CONSTRUCTED

## GRADING BOGGS ROAD

COUNTY ROAD NO. 274

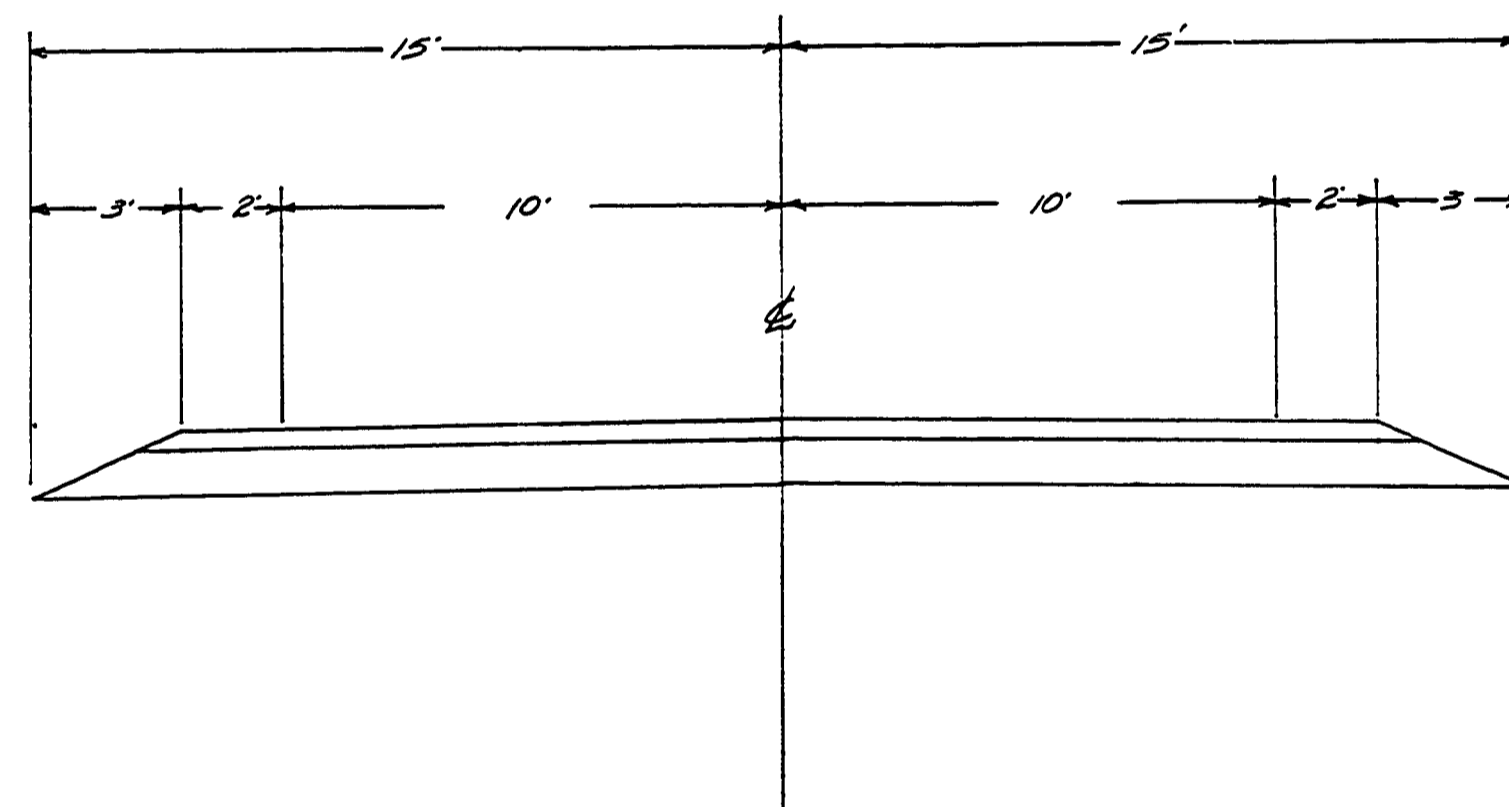

FILED  
RECEIVED

JUL 8 1964

COUNTY SURVEYOR  
DOUGLAS COUNTY, ORE.

5/4/63

G. Rd # 274

sh. 1 of 3

000001C

44