
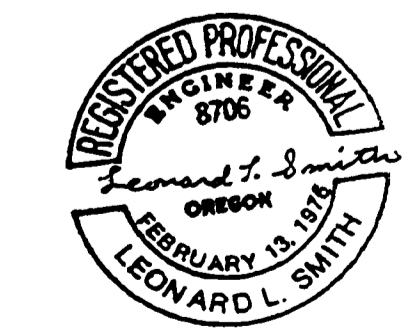


PLAN

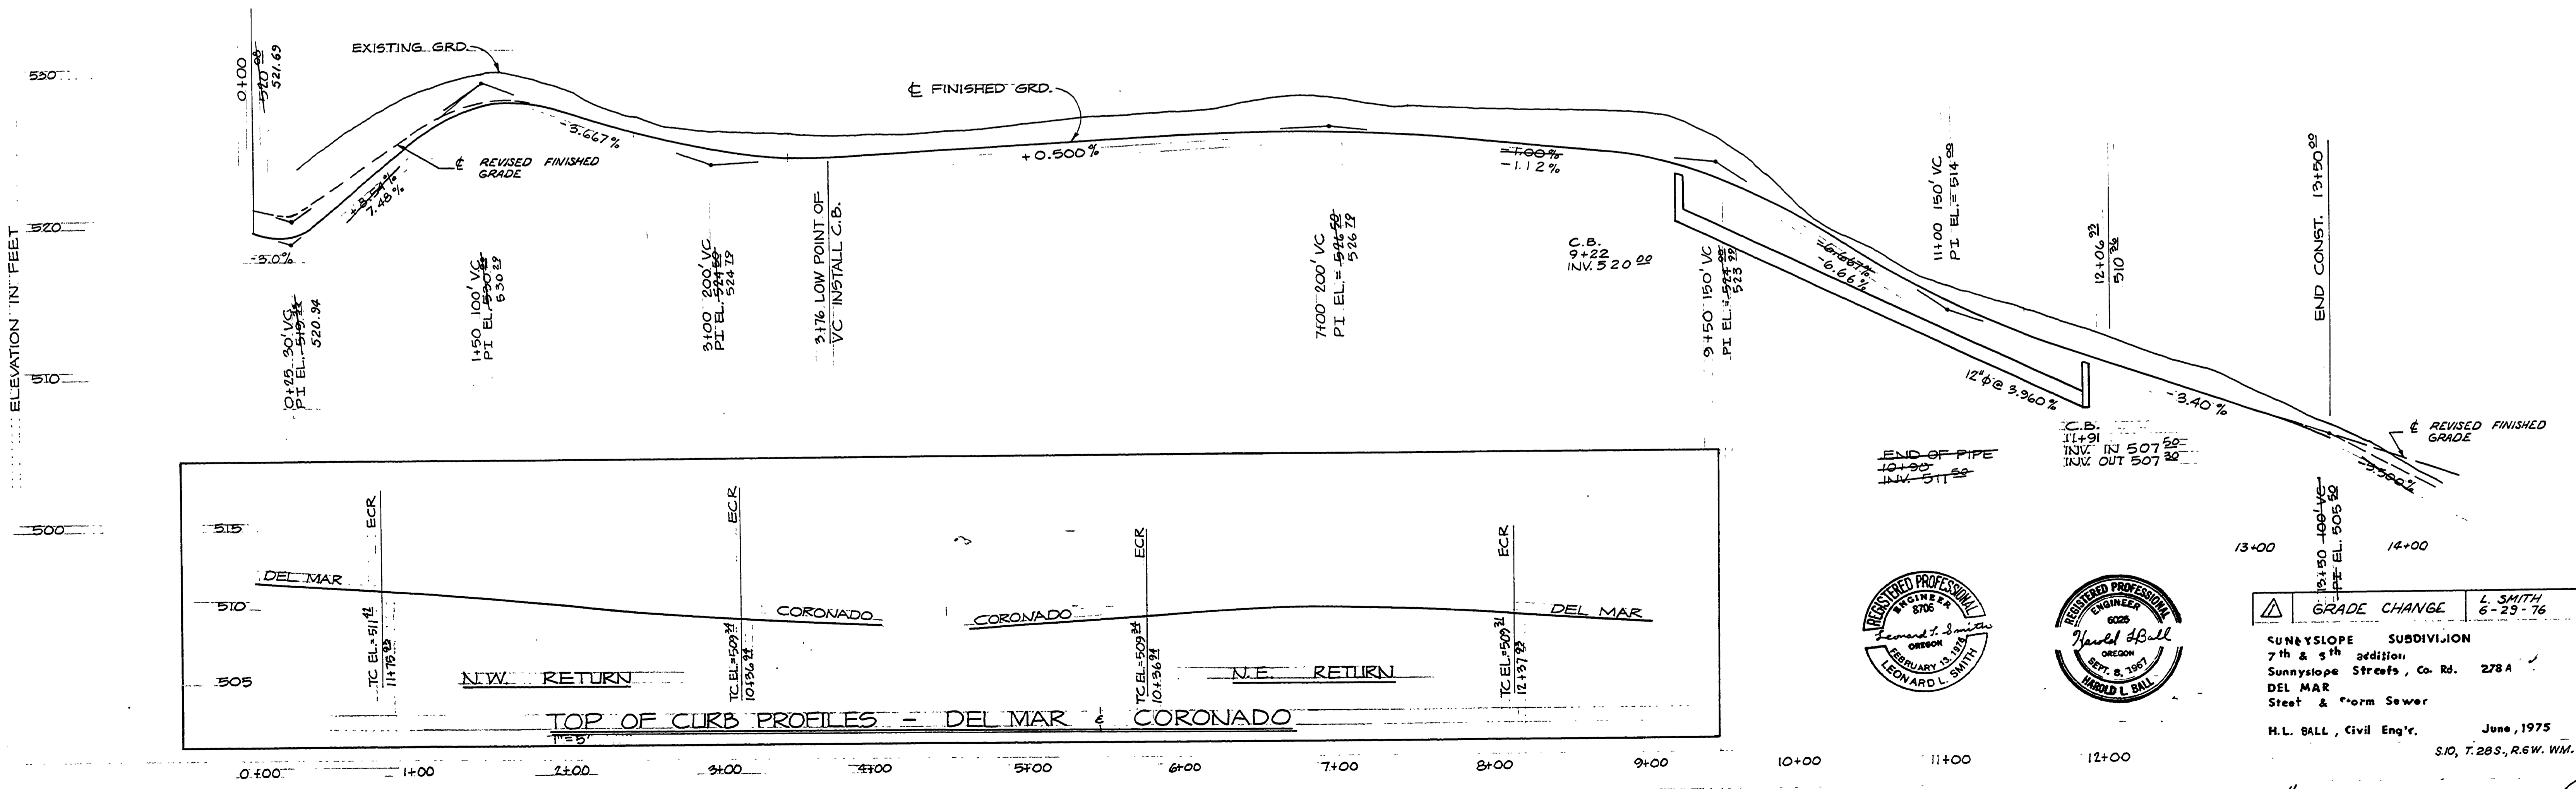

GRADE CHANGE L. SMITH 6-23-76
SUNNYSLOPE SUBDIVISION
7th & 5th addition
Sunnyslope Streets, Co. Rd. 278 A
DEL MAR
Street & Storm Sewer
H.L. BALL, Civil Eng'r. June, 1975
S.O. T. 283, R.G.W. WM.