
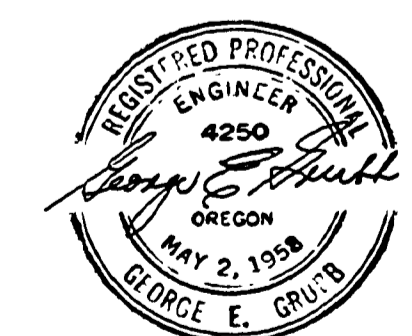
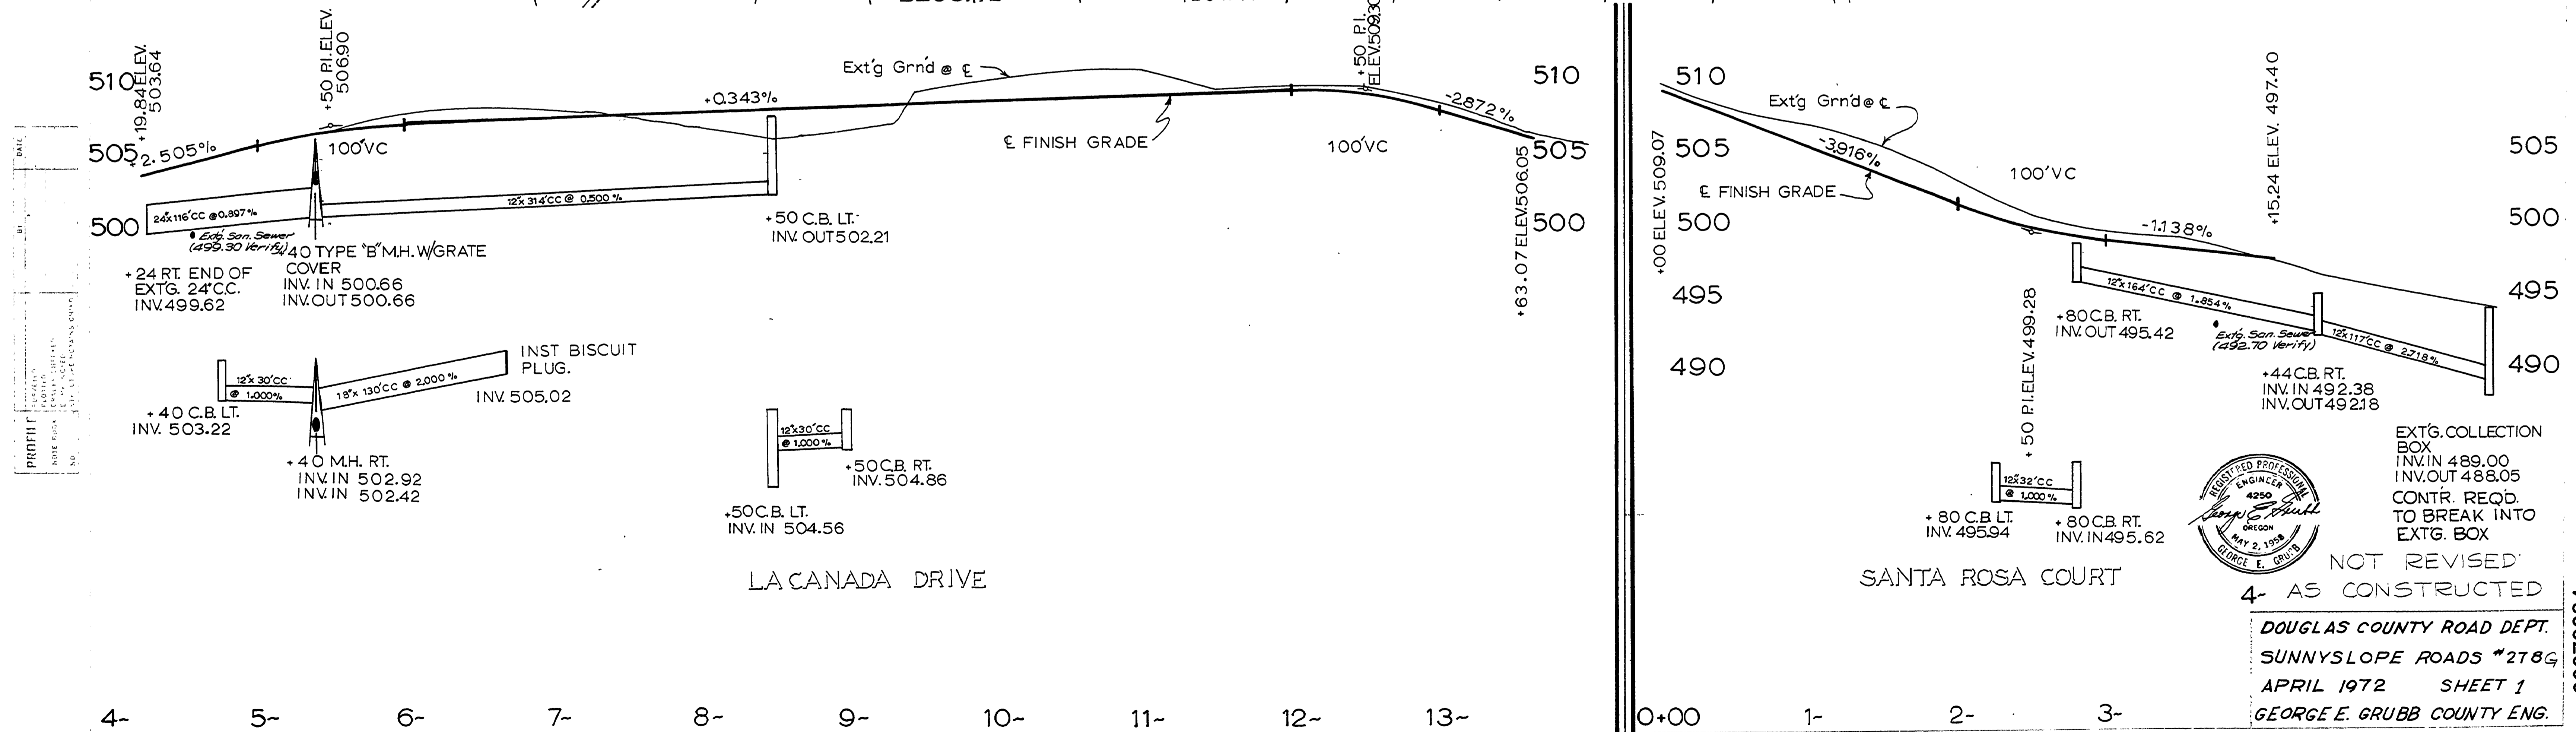
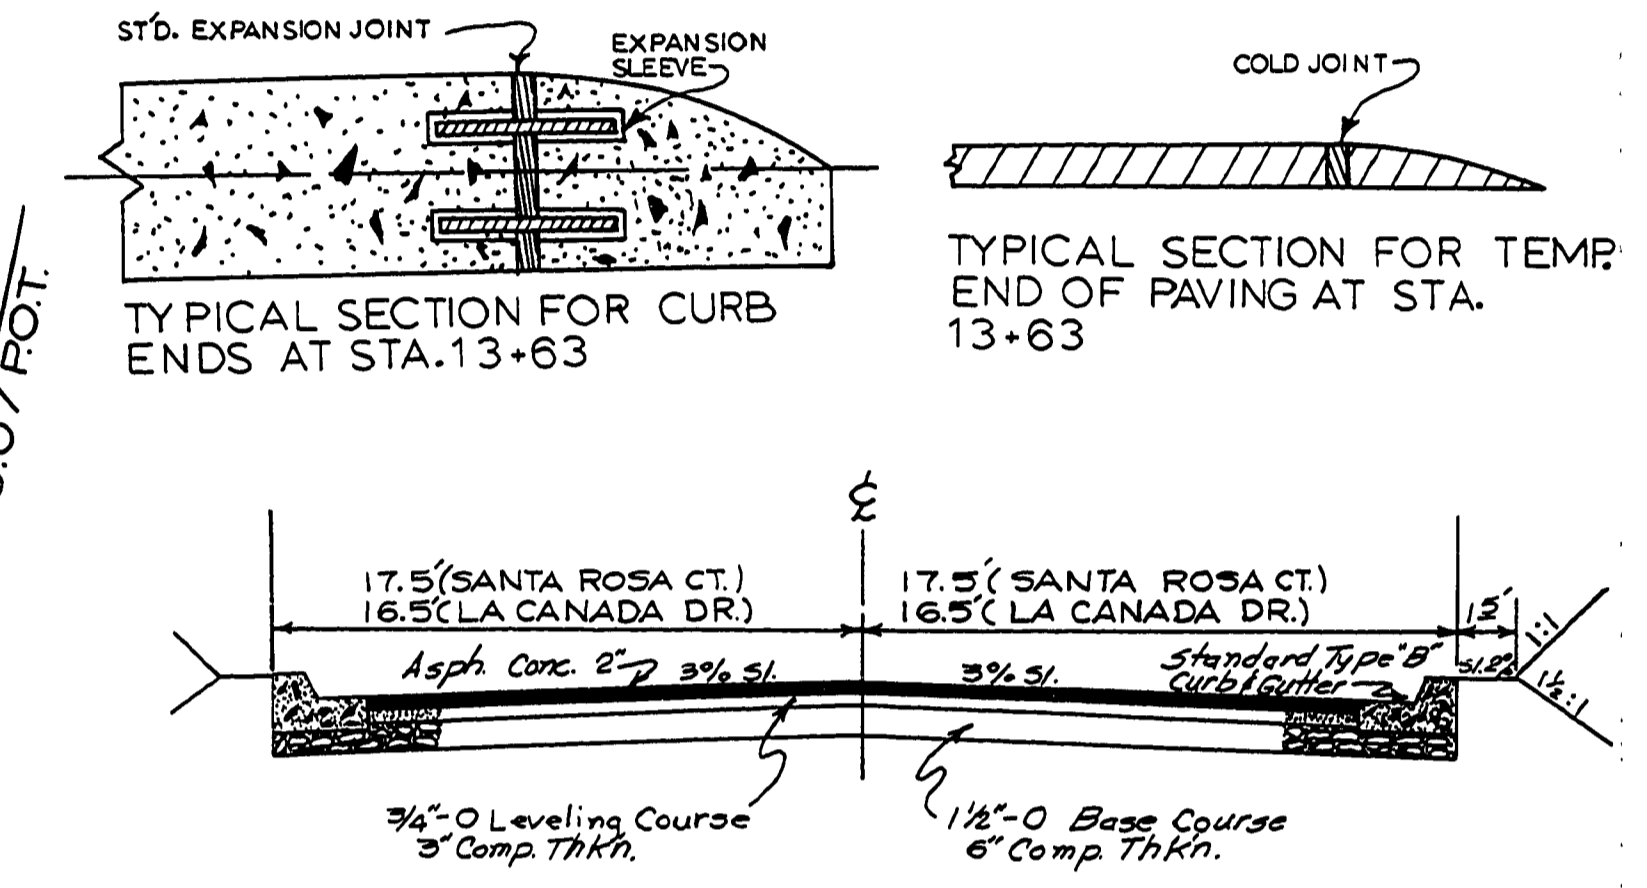


FILED  
RECORDED  
COUNTY CLERK  
CLATSOP COUNTY, OREGON

INDEX OF DRAWINGS  
SHEET

|              |                    |
|--------------|--------------------|
| 1            | ROAD & STORM SEWER |
| 2            | QUANTITY SUMMARY   |
| STD DWGS     |                    |
| 2,3,4,9 & 15 | TOTAL.....7 SHEETS |

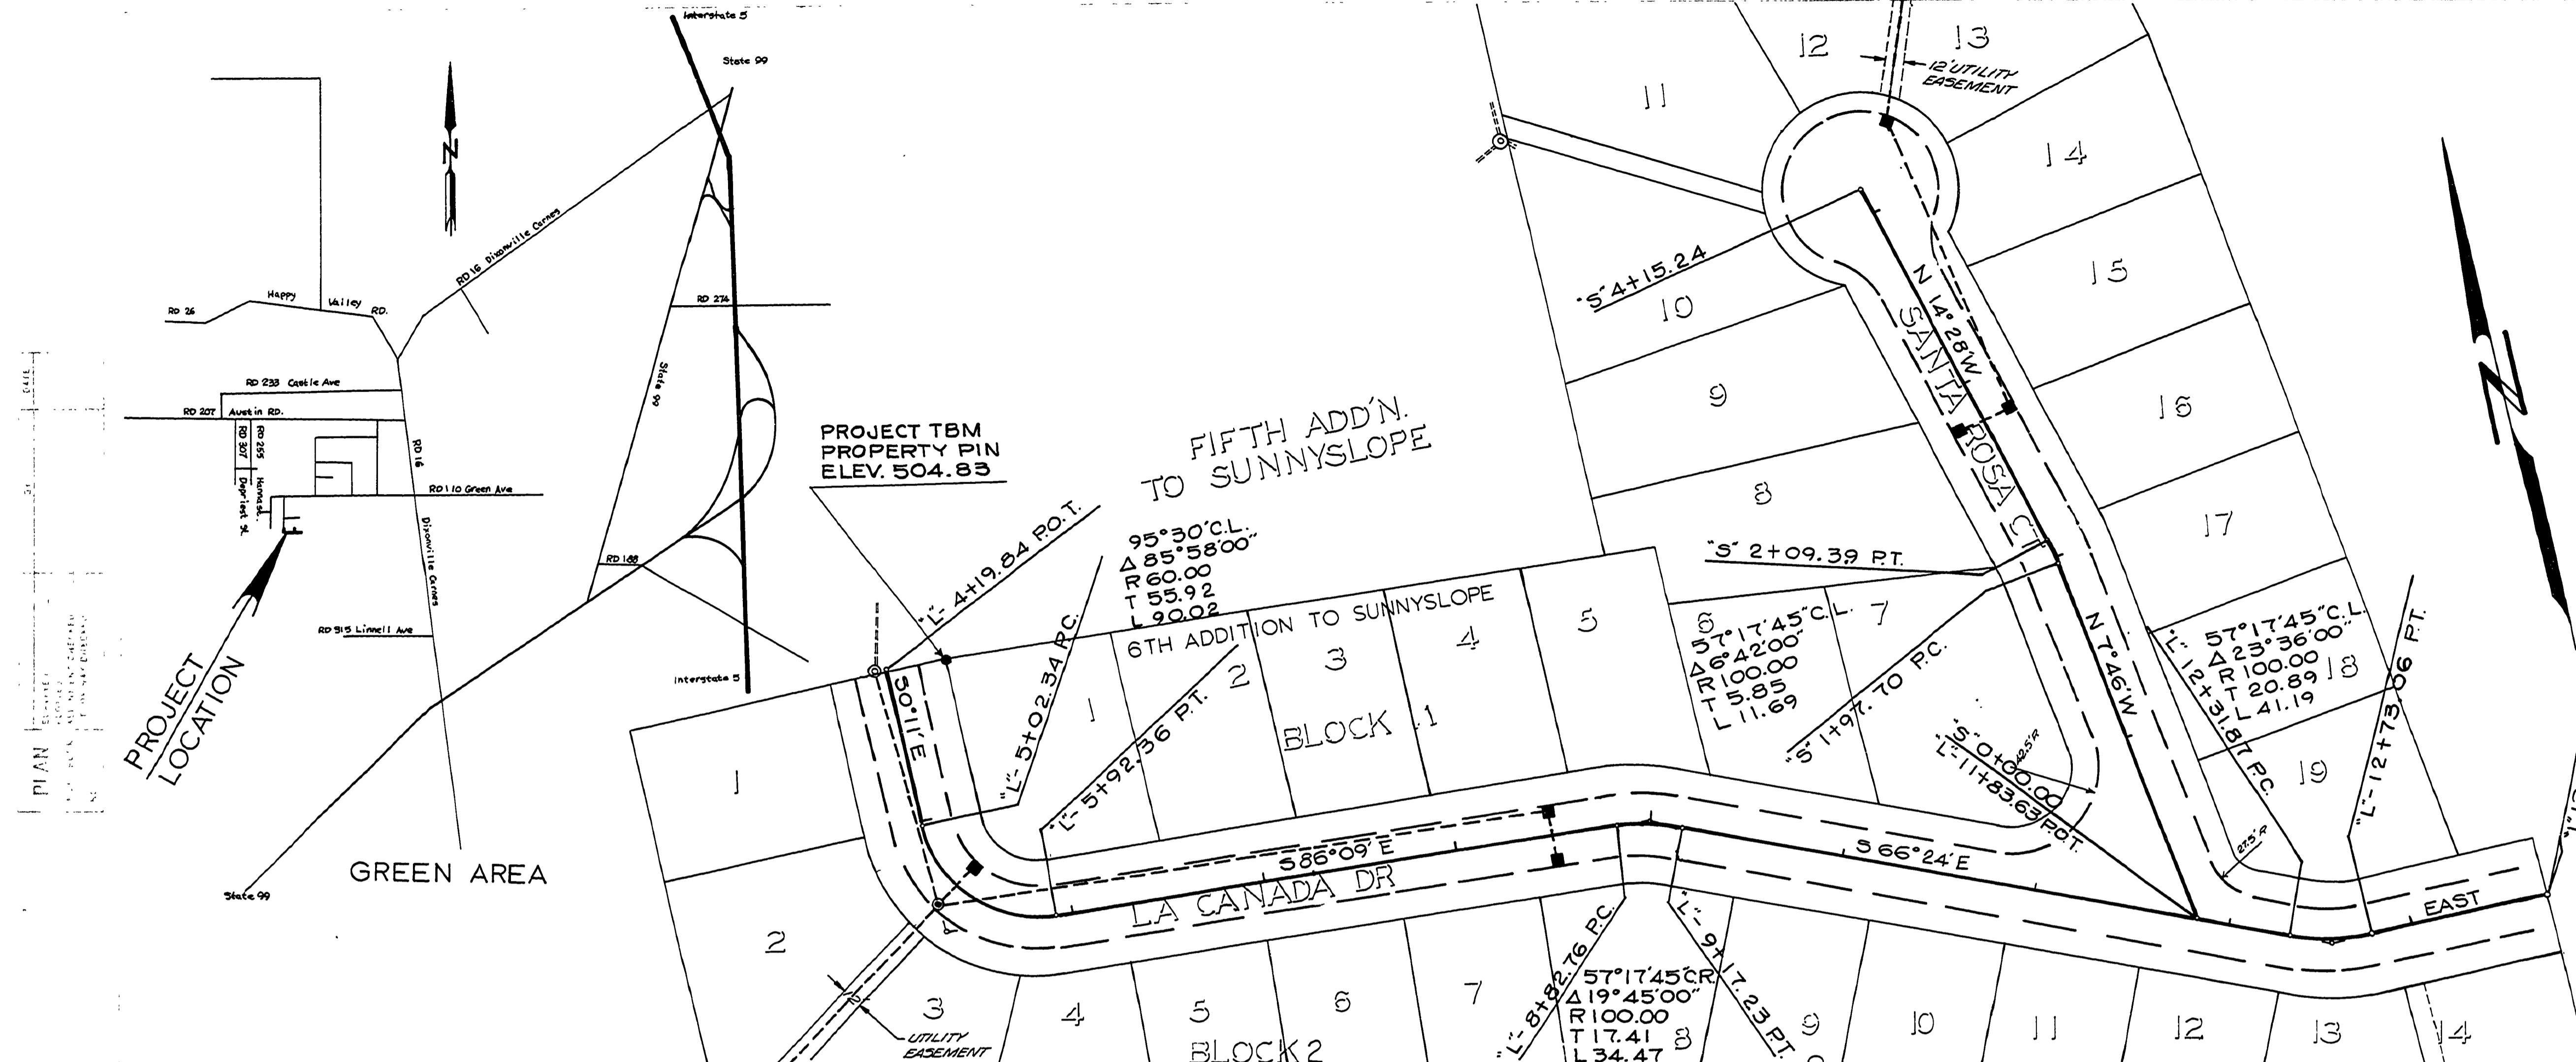

NOT REVISED  
4- AS CONSTRUCTED  
DOUGLAS COUNTY ROAD DEPT.  
SUNNYSLOPE ROADS #278G  
APRIL 1972 SHEET 1  
GEORGE E. GRUBB COUNTY ENG.

00070024