


W	R ₁	Δ ₁	L ₁	R ₂	Δ ₂	L ₂	S ₂	L ₂ '	X	AREA
33	35	46°37'59"	28.49	40	273°15'58"	20.94	16°37'59"	11.61	54.52	5.137
33	40	45°04'10"	31.46	40	270°08'20"	20.94	15°04'10"	10.52	56.64	5.217
41	35	42°16'07"	25.82	40	264°32'14"	20.94	12°16'07"	8.57	50.45	5.123
41	40	40°51'55"	28.53	40	261°43'50"	20.94	10°51'55"	7.59	52.34	5.207


AREA FIGURES ARE FOR SHADED PORTION OF CUL-DE-SAC. (F1²)

A	B	C	D	E	F	G	H	J	K	L	M	G ₁	G ₂	
487.72	-	487.83	87.75	88.08	88.21	88.23	88.21	88.08	87.75	87.83	-	487.70	88.24	88.64

THE TOP OF CURB IS 5% (0.46) HIGHER THAN THE GUTTER GRADES ABOVE
G₂ EXISTS ONLY IN THE CASE OF A VC W/GI AS THE PI.

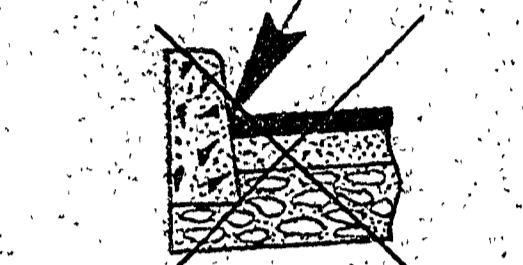


TYPE "A" CURB

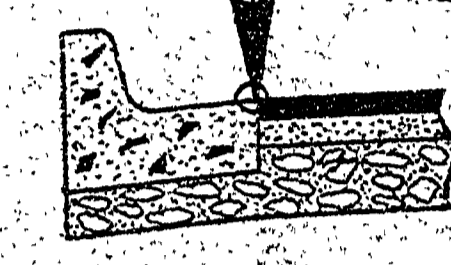

TYPE "B" CURB & GUTTER


ELEVATIONS LISTED CORRESPOND TO LOCATIONS SHOWN

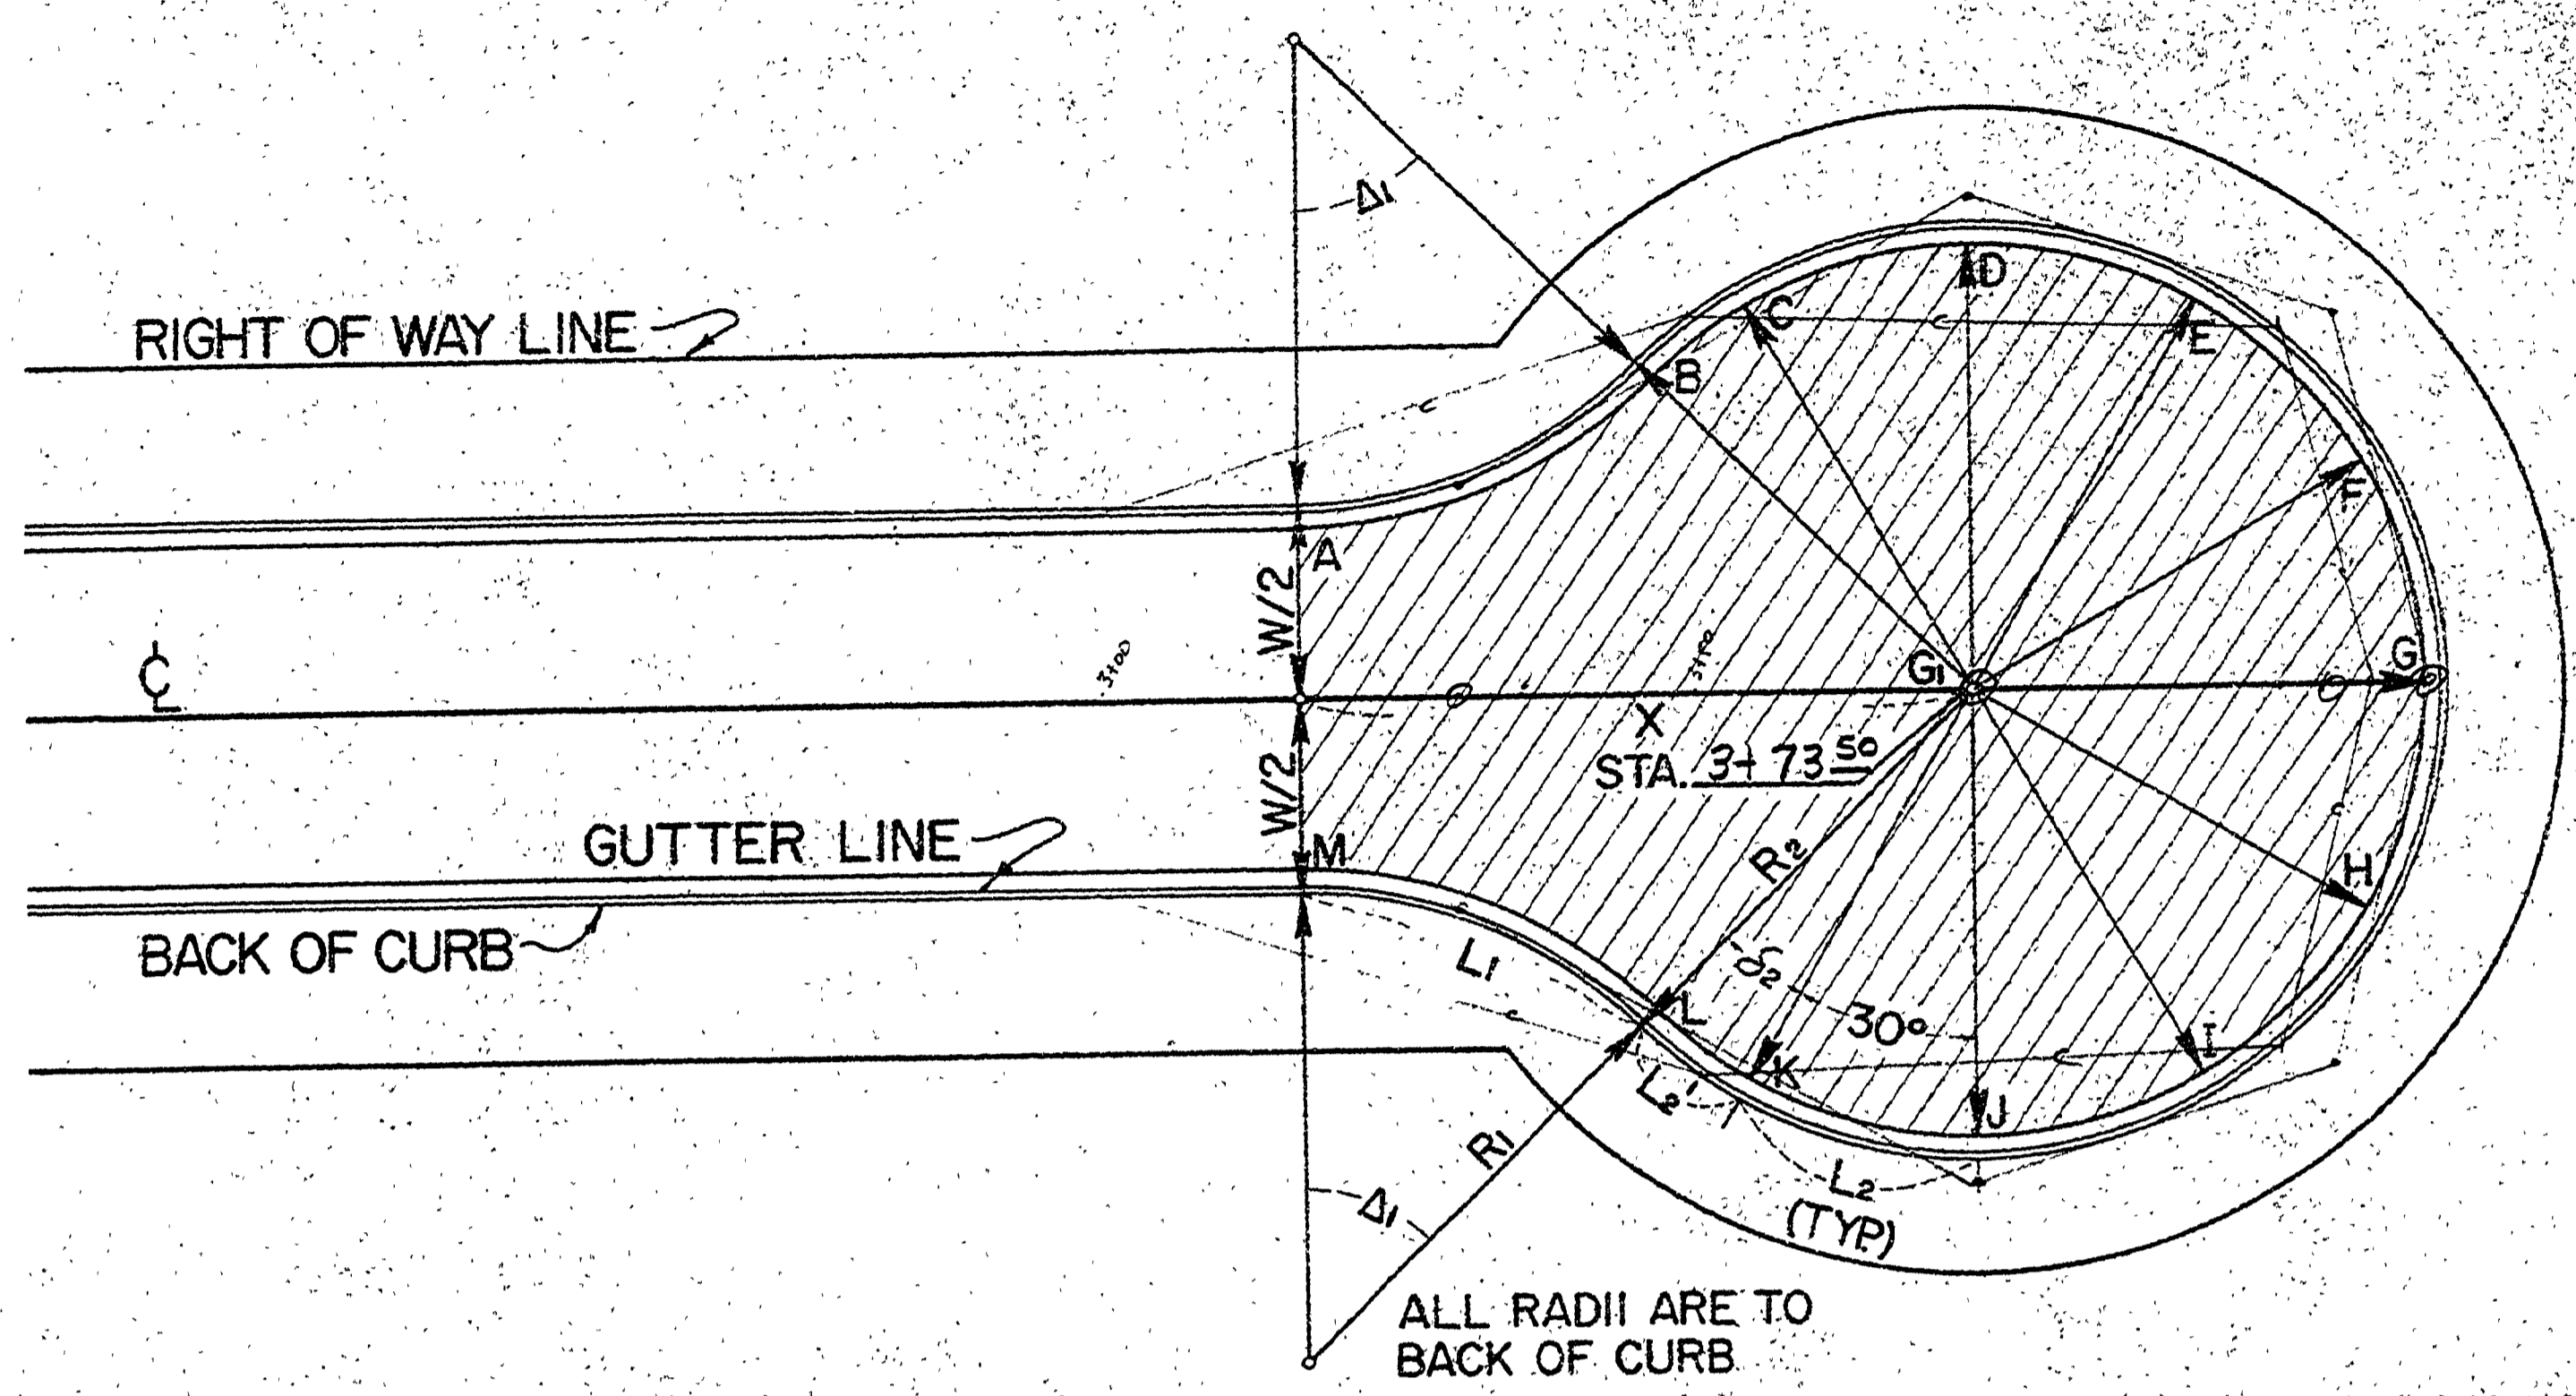

CUL-DE-SAC
0 5 10 15 30 45
PLAN SCALE

DATE
BY
CHECKED
DESIGNED
PLANNED
NOTED
STRUCTURE NOTATION
NO.

DATE
BY
CHECKED
DESIGNED
PLANNED
NOTED
STRUCTURE NOTATION
NO.

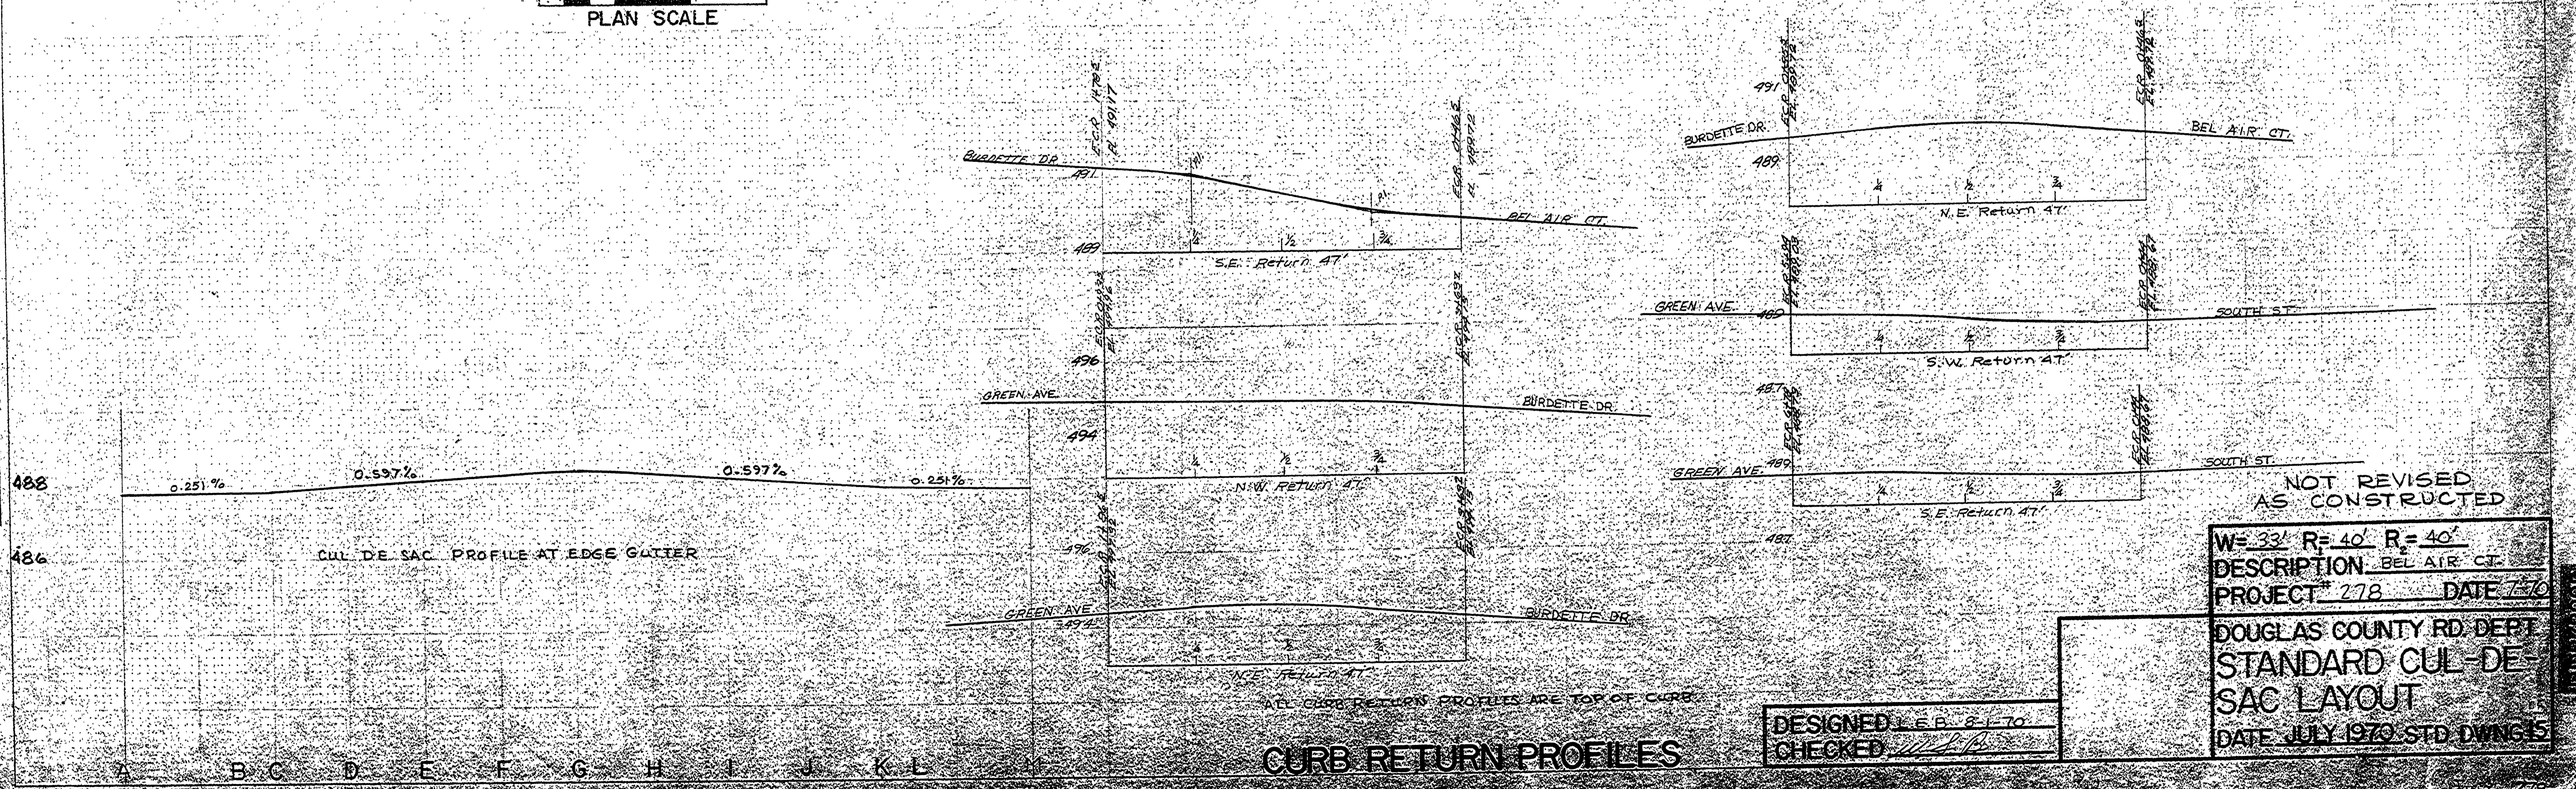

CURB RETURN PROFILES

DESIGNED L.E.B. 2-1-70
CHECKED [Signature]

NOT REVISED AS CONSTRUCTED
W=33' R=40' R=40'
DESCRIPTION BEL AIR CT.
PROJECT 278 DATE 7-70
DOUGLAS COUNTY RD. DEPT
STANDARD CUL-DE-SAC LAYOUT
DATE JULY 1970 STD DWG 15

C.R.# 228