
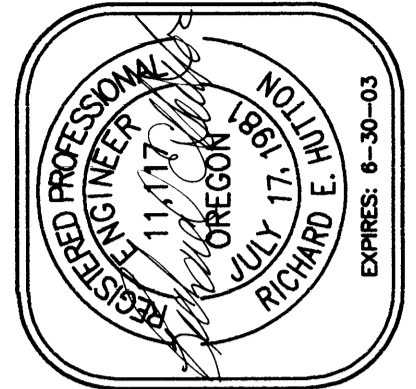
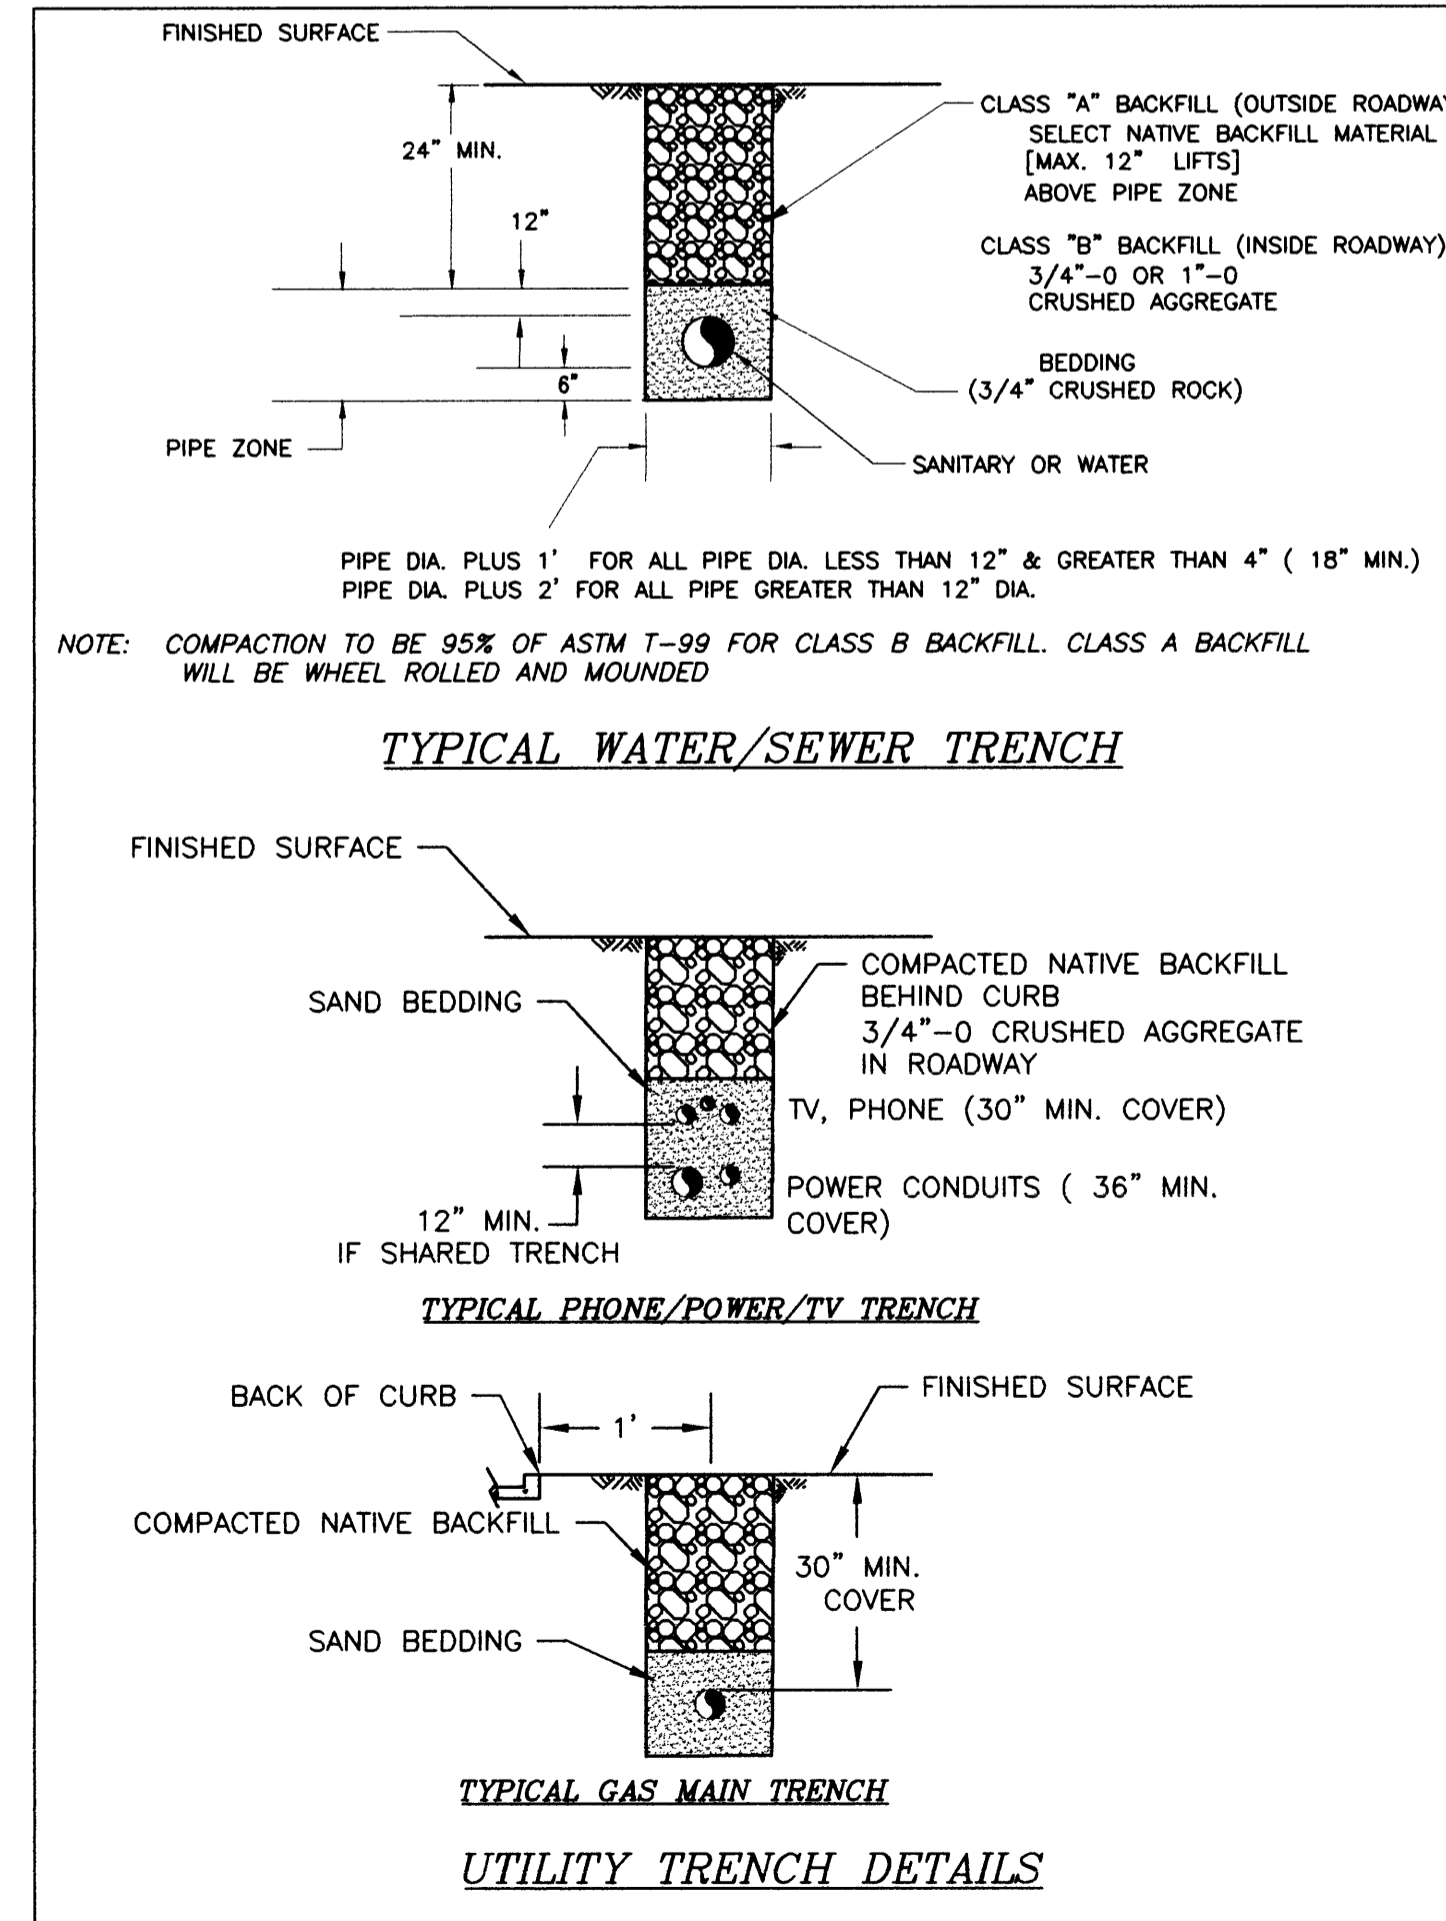


POST CONSTRUCTION DRAWINGS
 THESE DRAWINGS REPRESENT THE CONSTRUCTION WORK AS NEAR AS CAN BE DETERMINED. THEY WERE PREPARED FROM INFORMATION GATHERED DURING CONSTRUCTION ACTIVITY BY THE CONTRACTORS AND INSPECTORS AND ARE THOUGHT TO BE ACCURATE. HOWEVER NO GUARANTEE OR WARRANTY IS EXPRESSED OR IMPLIED AS TO THEIR EXACTNESS AND THEY SHOULD BE USED ONLY AS A GENERAL REPRESENTATION OF THE CONSTRUCTION WORKS.

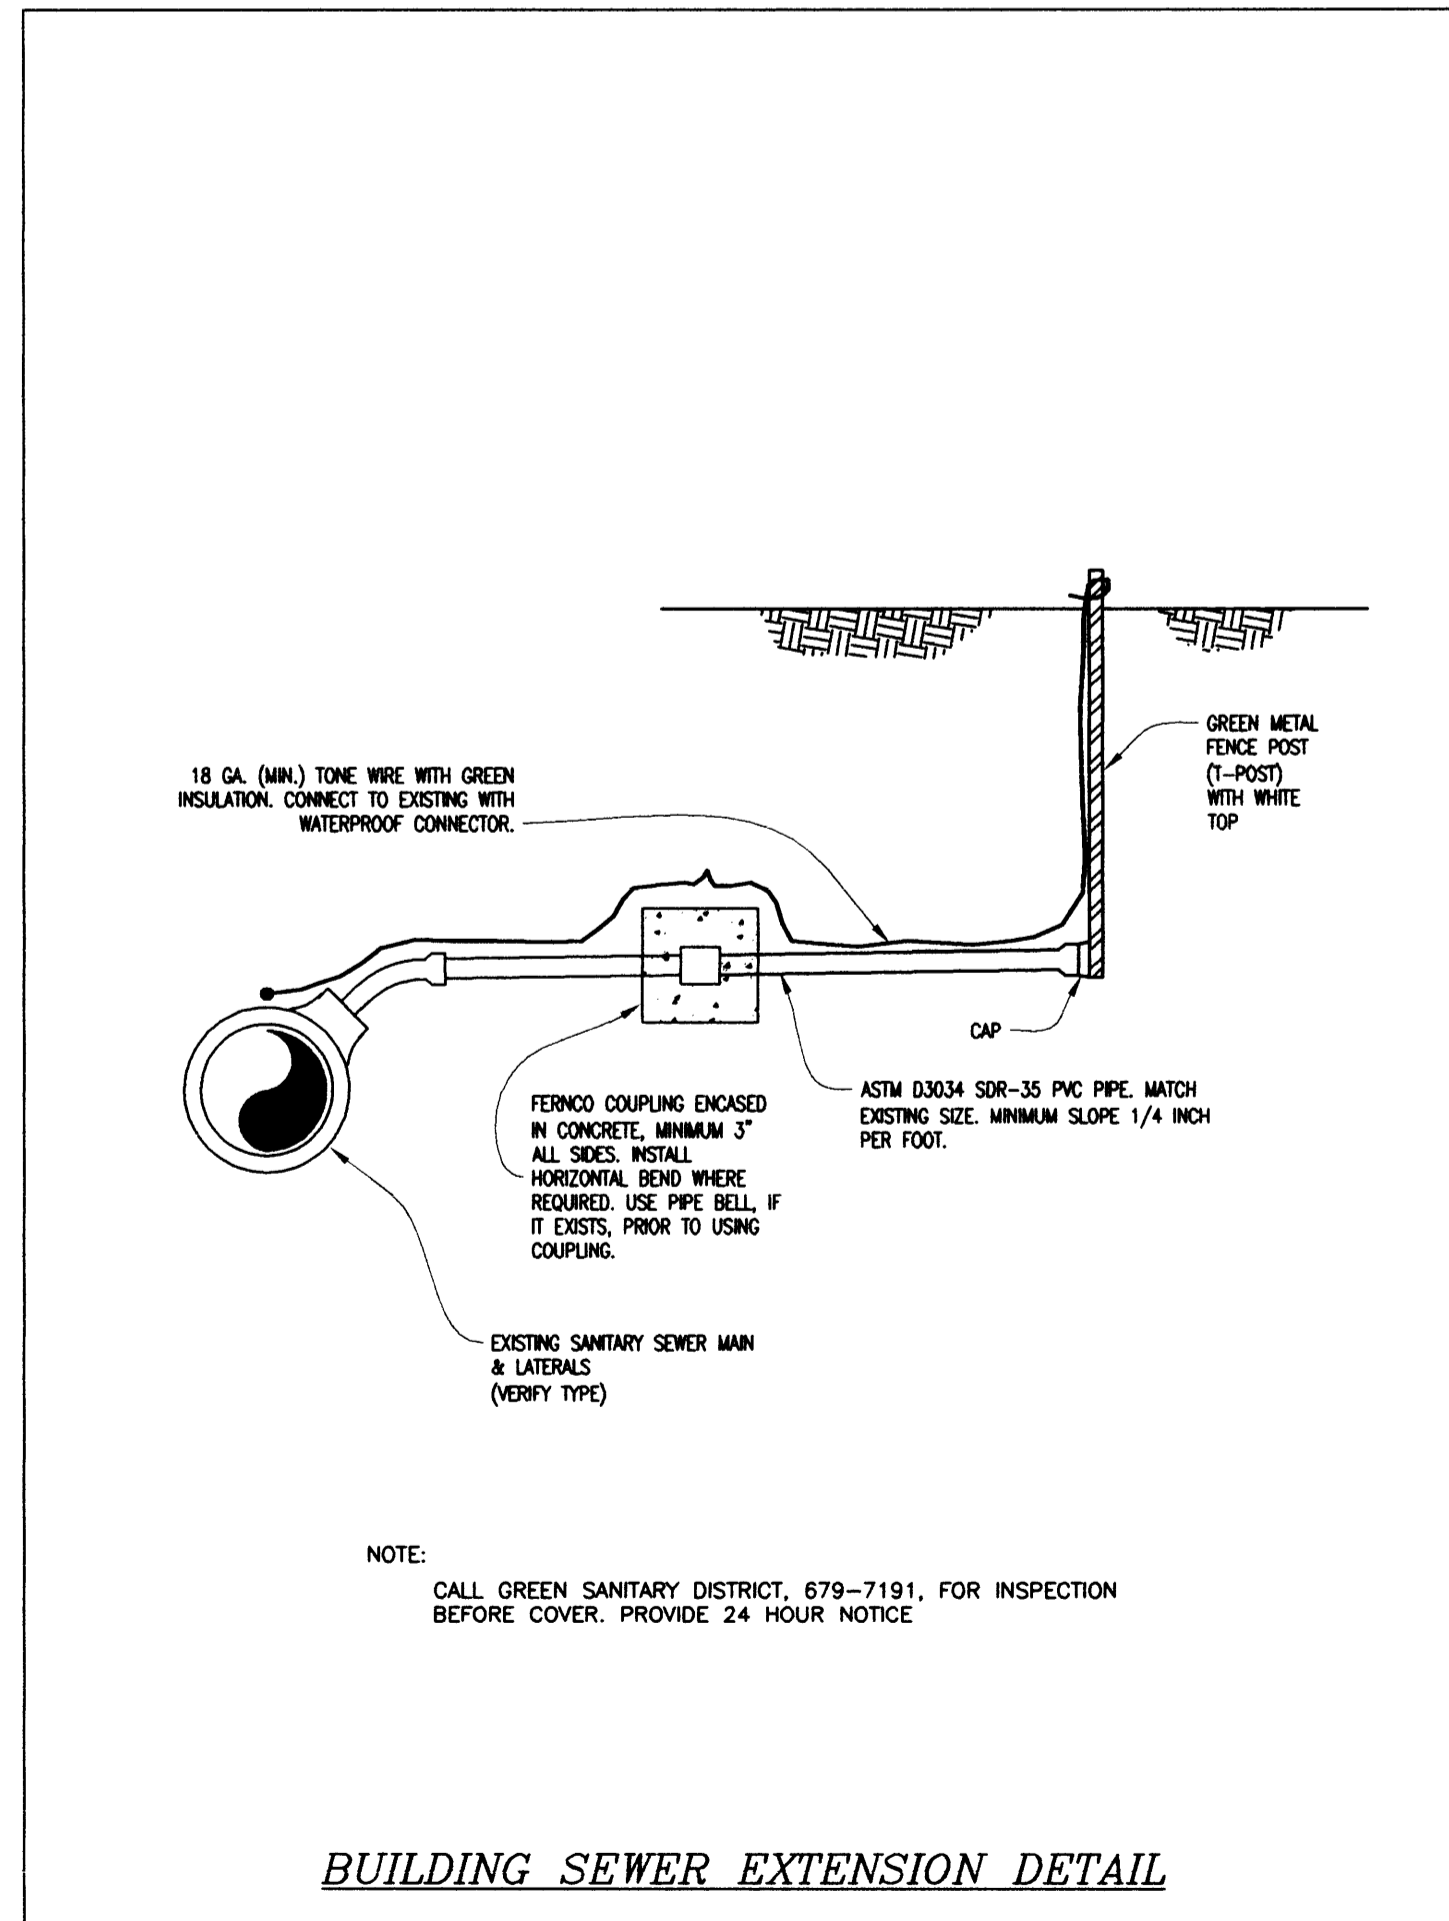

SURVEYING & ENGINEERING, INC.
 ENGINEERING • SURVEYING • PLANNING

3076 NE DIAMOND LAKE BLVD.
 ROSELBURG, OREGON 97470
 TEL: (541) 672-2086
 FAX: (541) 672-0811

AA

Revision	Date	Revision	Date

Drawn	STAFF	Design	SSS	Checked	SSS	Reviewed	

TITLE: DETAILS
 PROJECT NAME: SARGENT ESTATES SUBDIVISION

8068.01	SHT. OF	3	3
---------	---------	---	---