
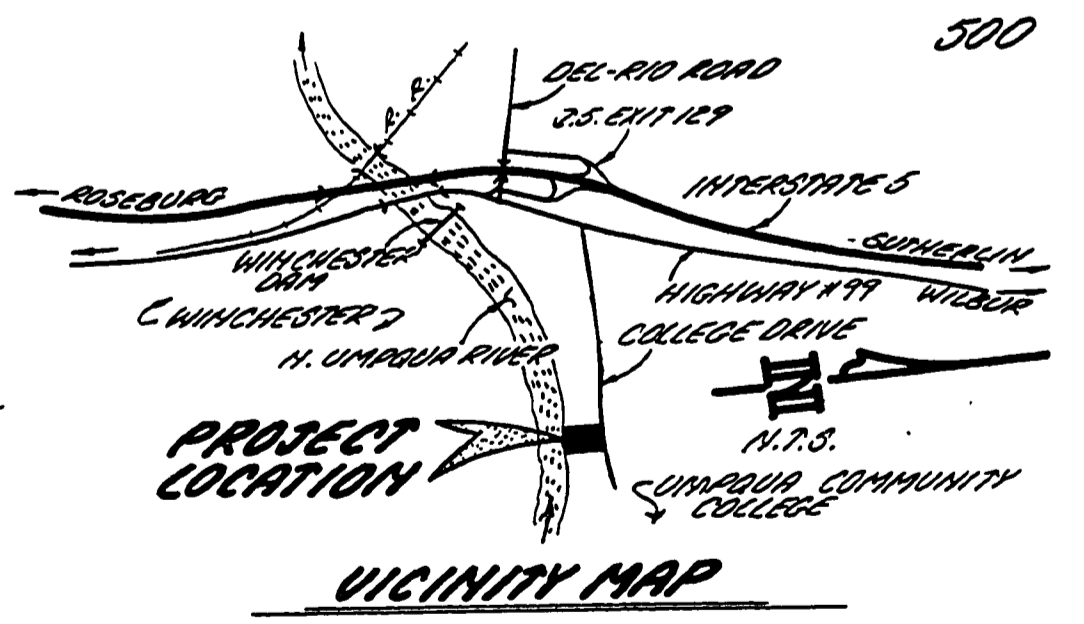
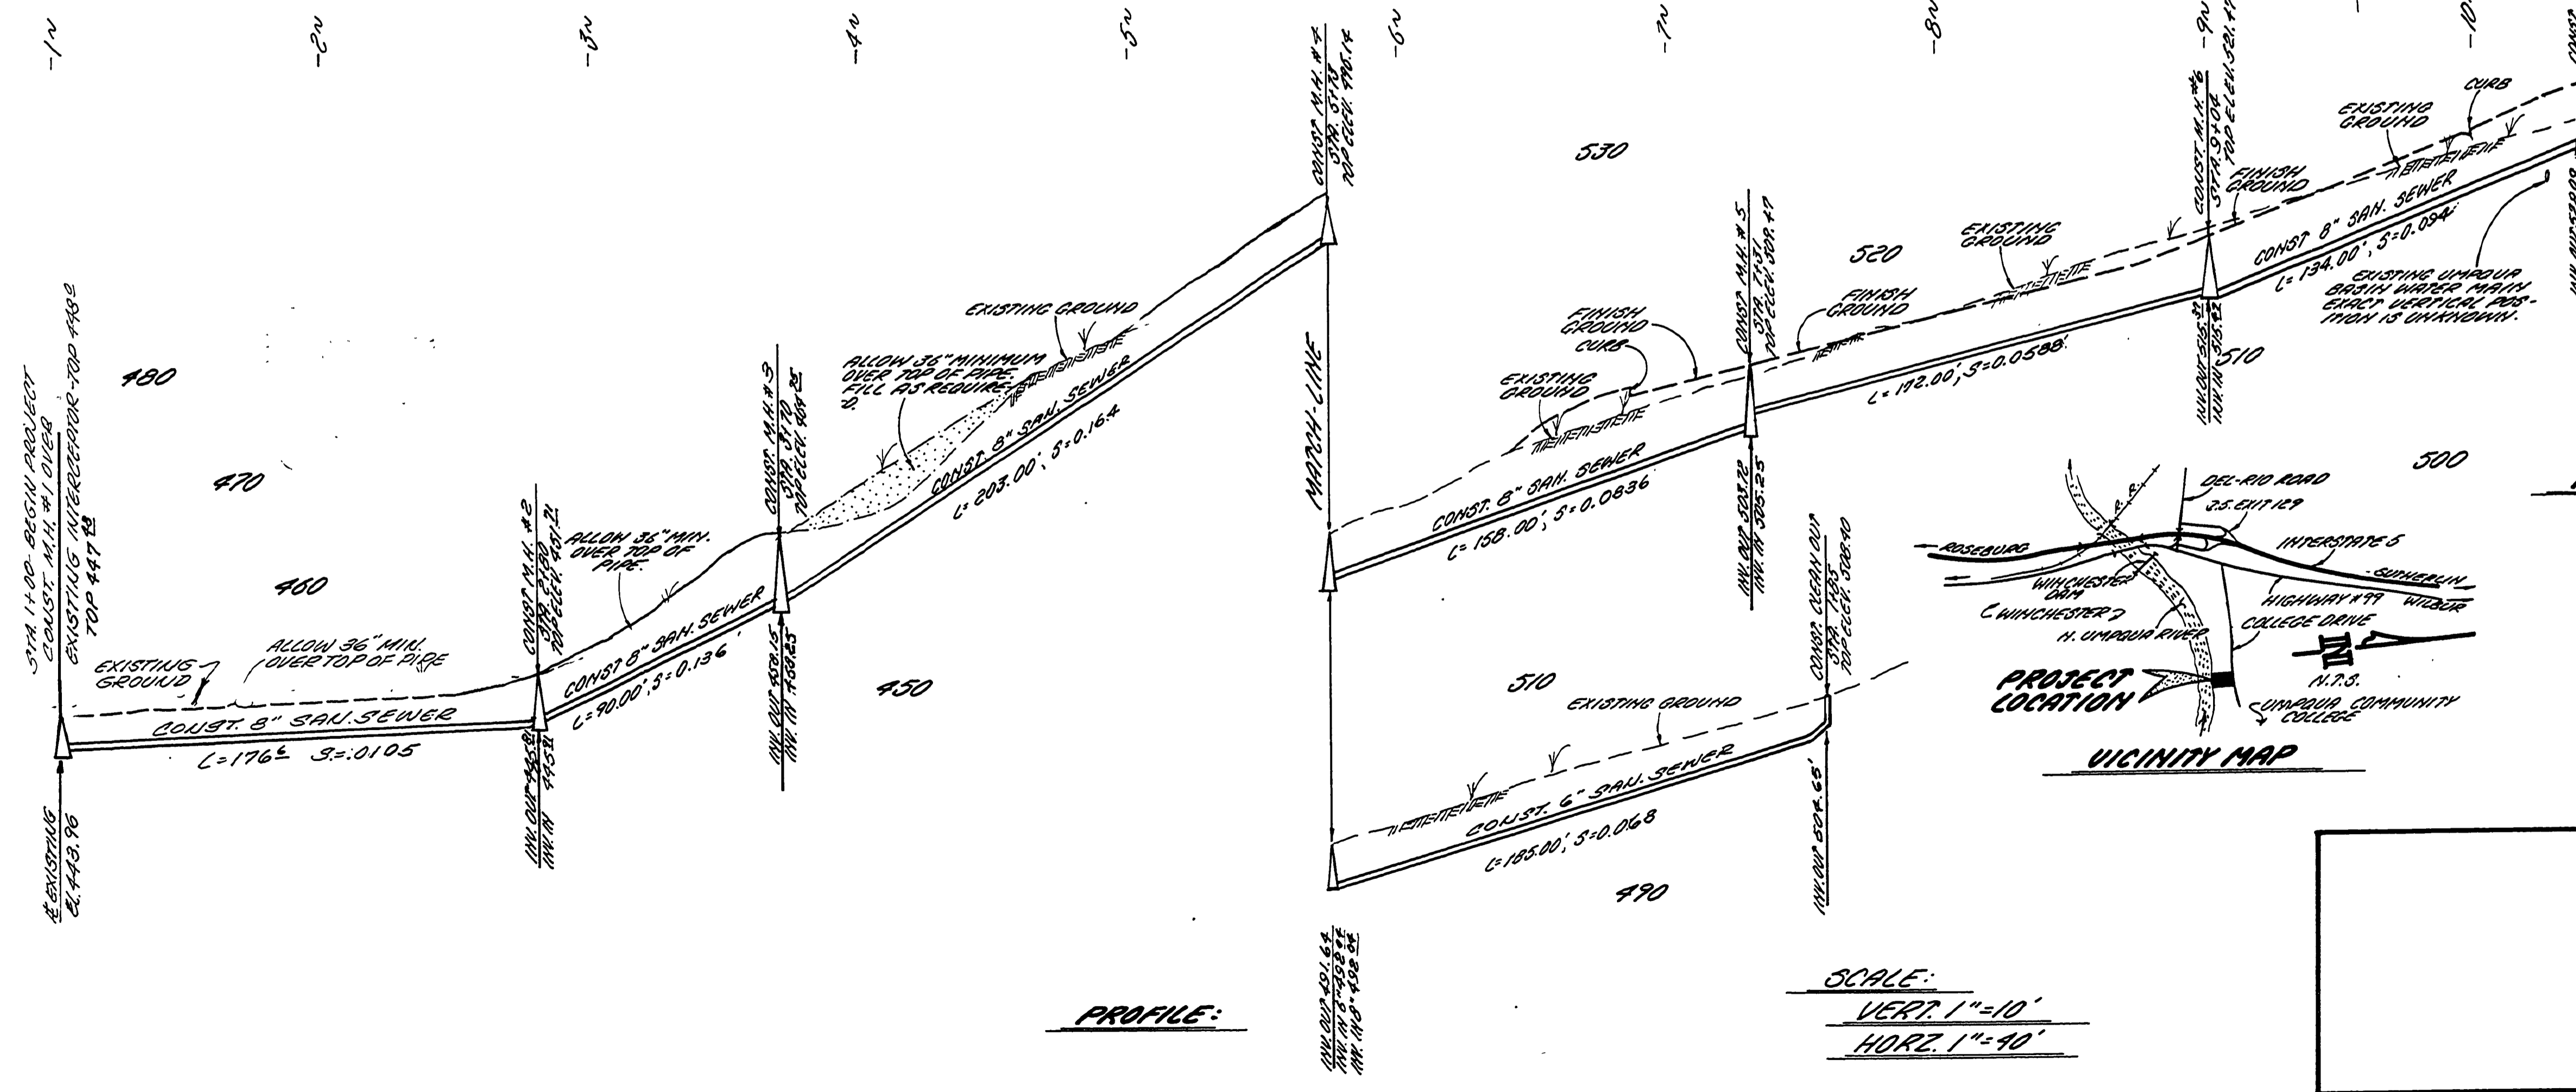


FILED *JR*
 DEC 28 1989
 COUNTY SURVEYOR
 WAGLAS COUNTY, ORE

FINAL SURVEY
 DATE: 11-11-89
 SCALE: 1"=40'

ORIGINAL SURVEY
 DATE: 11-11-89
 SCALE: 1"=40'

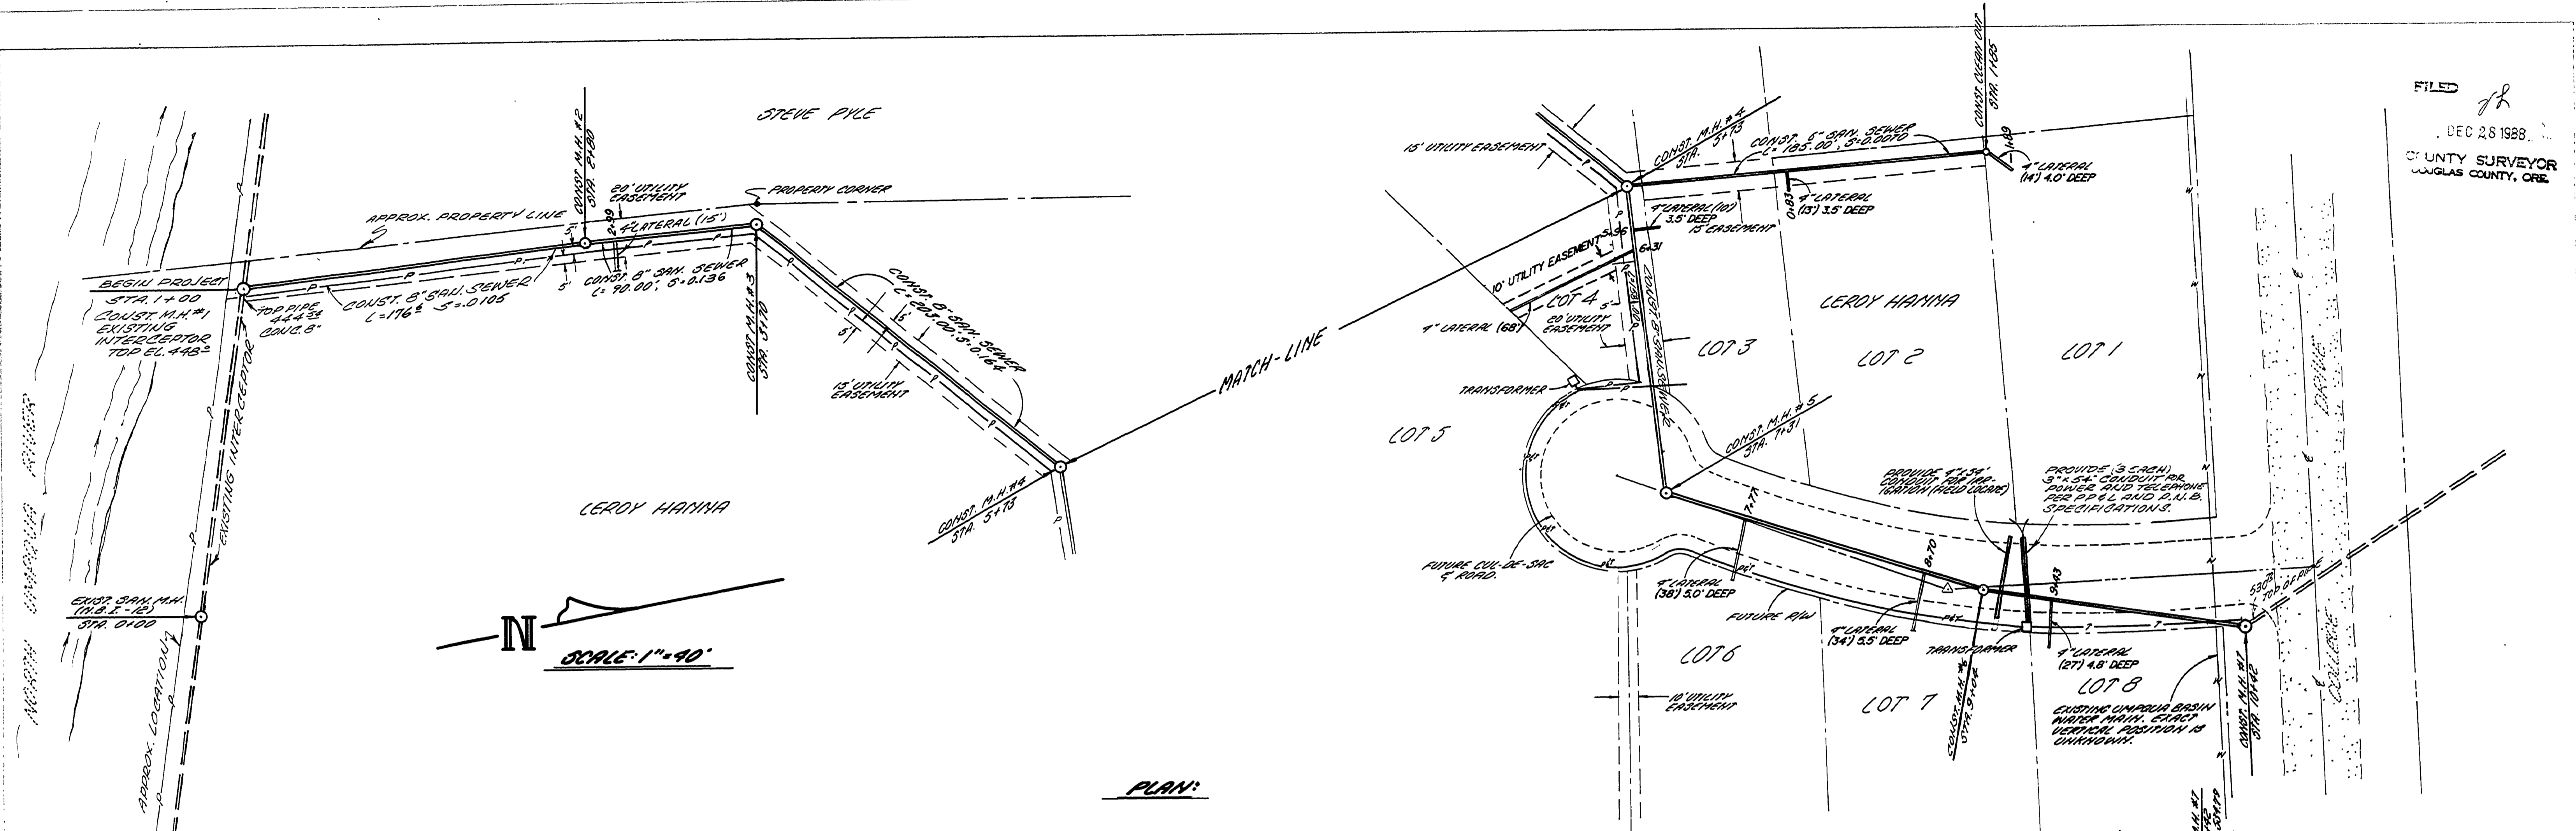

NOTES:

- ALL SANITARY SEWER CONSTRUCTION SHALL BE PER OSSEBURG URBAN SANITARY AUTHORITY (U.S.A.) SPECIFICATIONS.
- VERIFY EXISTING SANITARY SEWER ELEVATIONS PRIOR TO CONSTRUCTION.

I, JIM GOSSON HEREBY CERTIFY THAT THIS PROJECT HAS BEEN CONSTRUCTED IN SUBSTANTIAL CONFORMANCE WITH THE PLANS AND SPECIFICATIONS EXCEPT WHERE MODIFIED DURING CONSTRUCTION AND NOTED HEREON.

JIM GOSSON P.E.
 11-11-89
 DATE

DATE: 9-1987	DAVE BEITS, INC. 1205 S.W. COURT ST. ROSEBURG, ORE 97470
DRAWN: S. PARNER	LERDY HANNA SANITARY SEWER AND POWER LINES
DESIGN:	
REV: AS BUILT JUNE 1989	SHEET 2 OF 2 SHEETS

RD284A02

(95)