



DOUGLAS COUNTY OREGON
AS CONSTRUCTED
GRADING & SURFACING
VALLEY ROAD # 286
1967

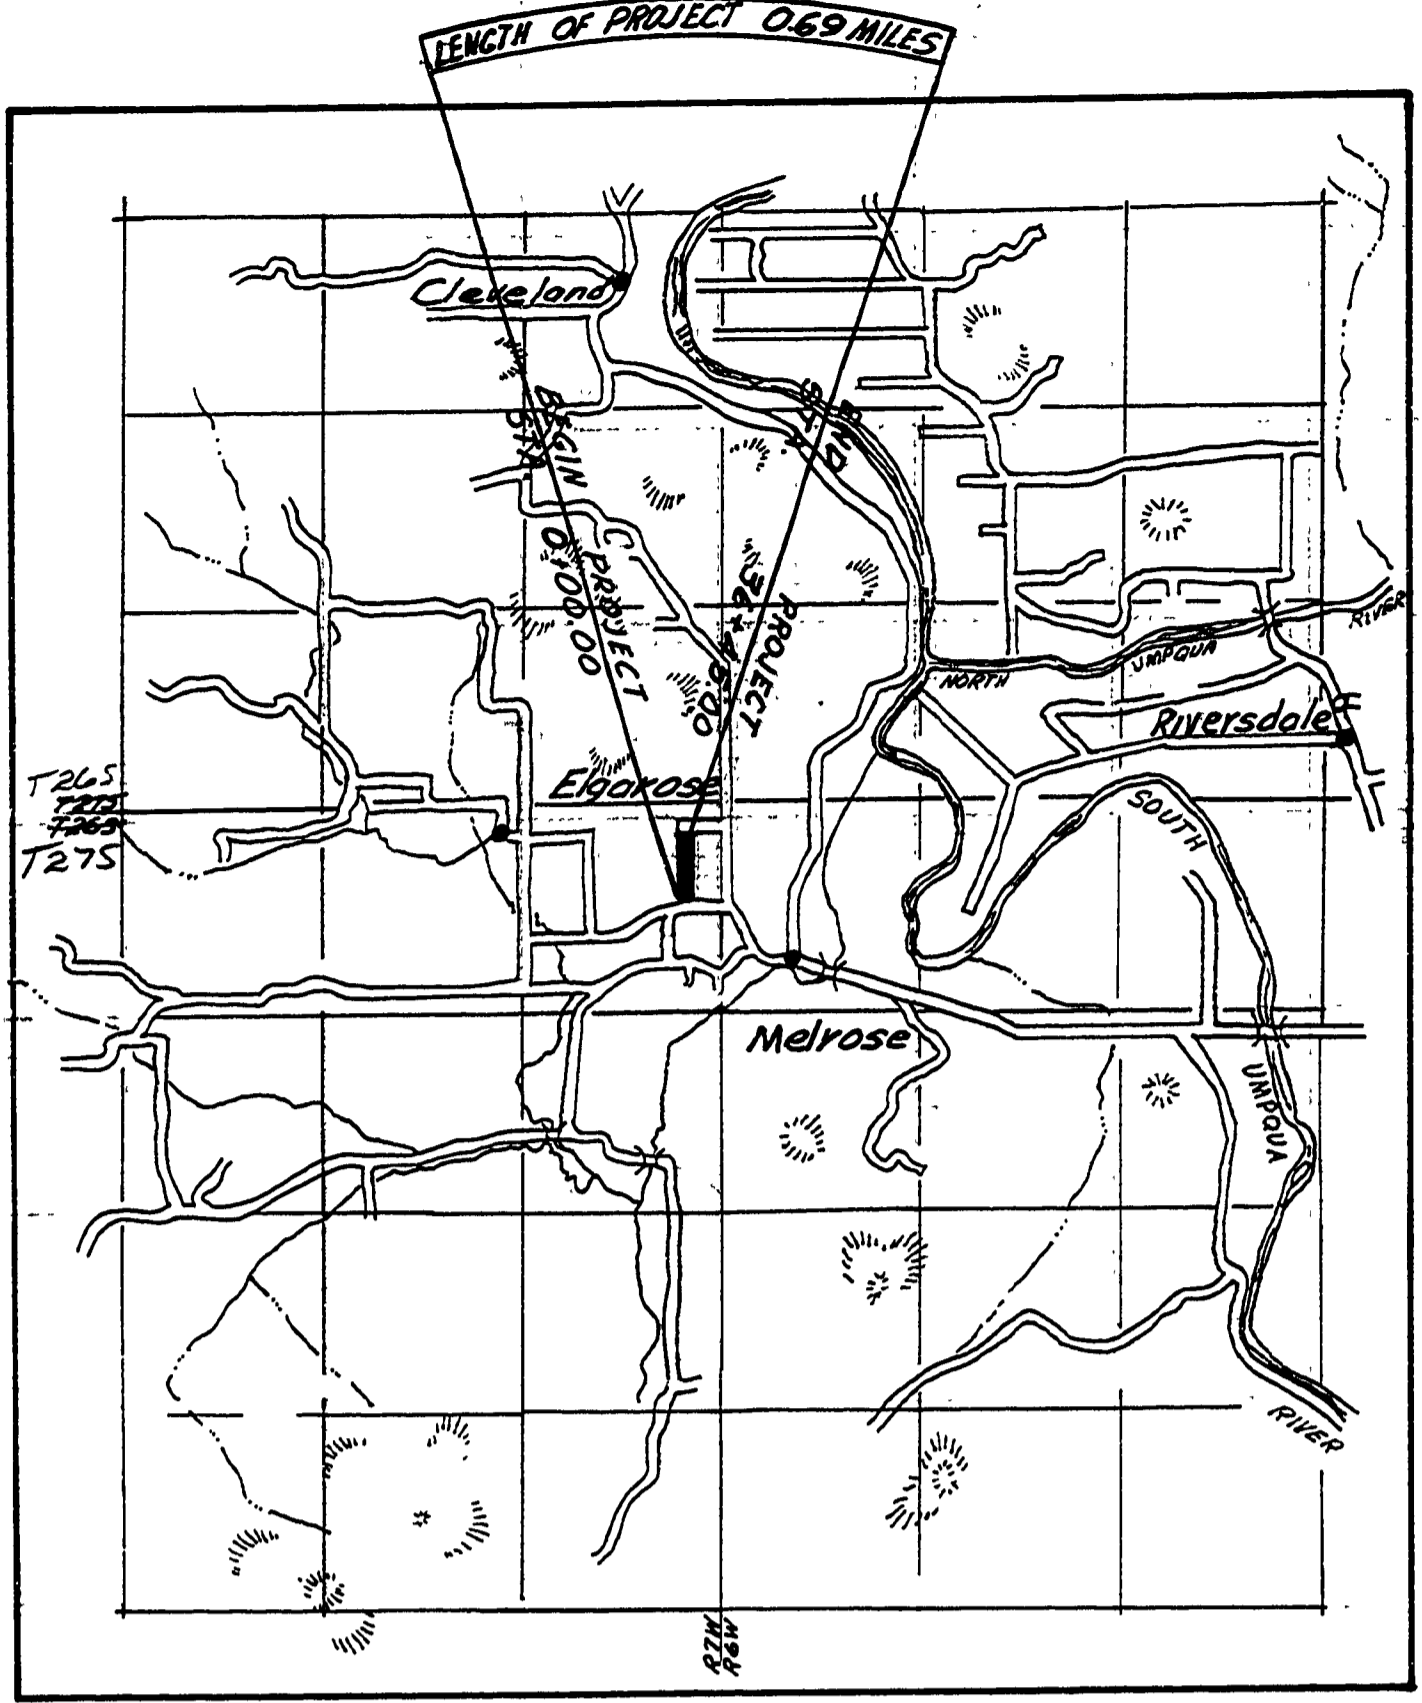

VICINITY MAP

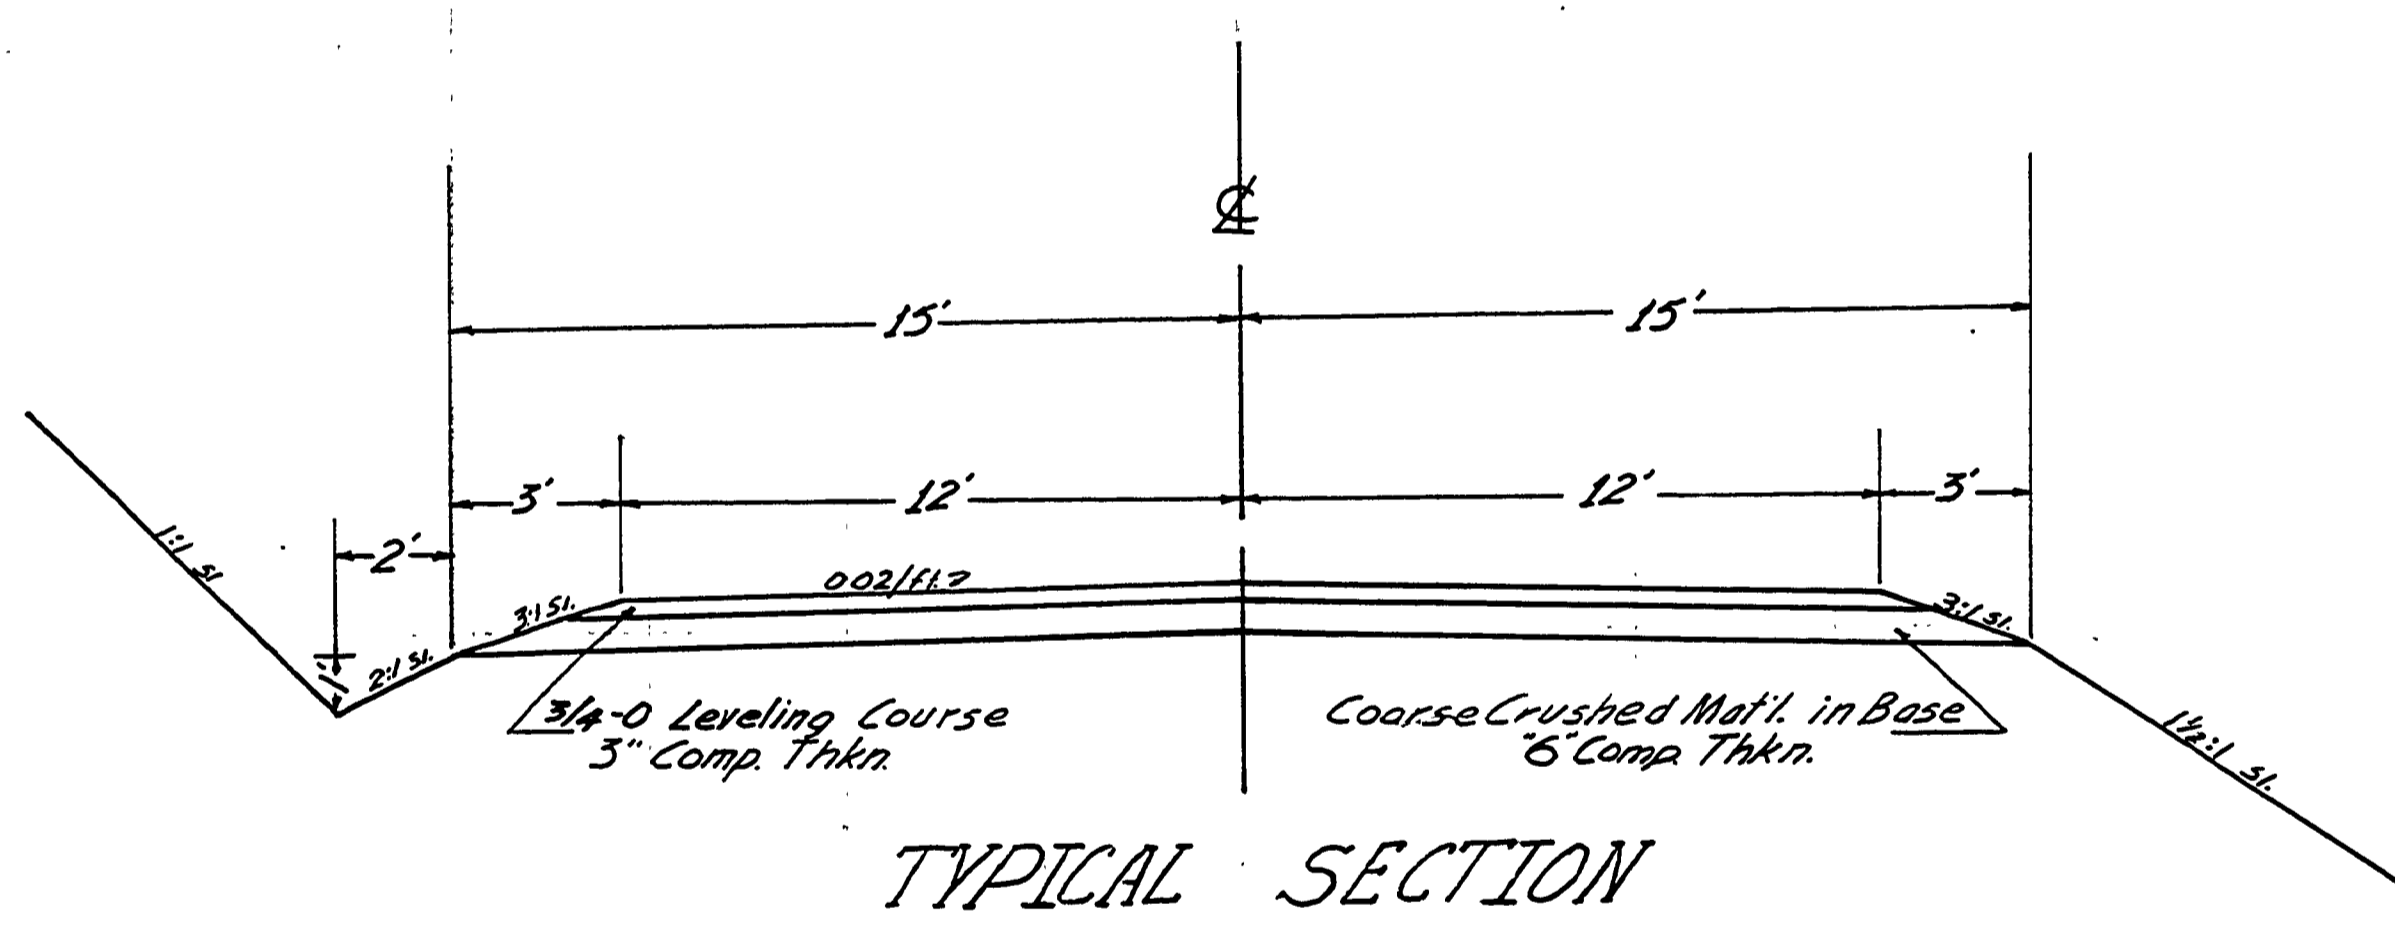

TYPICAL SECTION



Valley Road No. 286 adopted
 by resolution of the Board of
 County Commissioners shown thus ----
 Dec. 1967

Stanford Bunn Chairman
Ralph Dandekar Commissioner
Ray E. Doerner Commissioner

Approved by *George E. Grubb* Dec. 1967
 Engineer

0000007C

FILED
 RECEIVED
 JAN 3 1968
 COUNTY SURVEYOR
 DOUGLAS COUNTY, OREGON

SHEET 1 of 3