
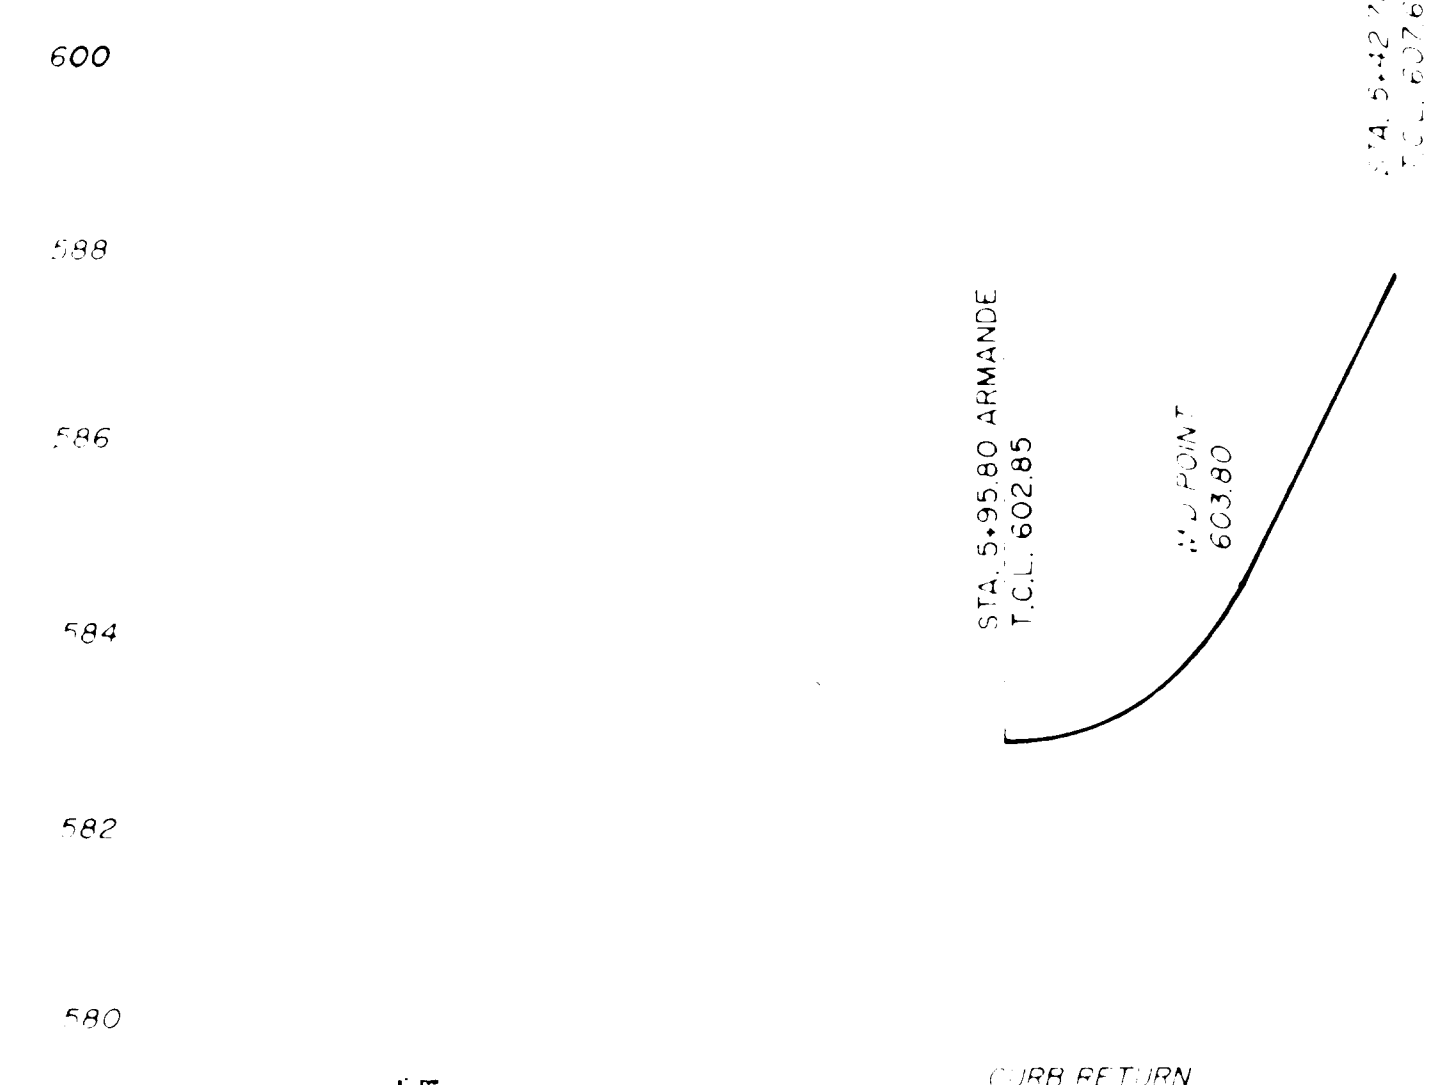


FILED
 Date: 7-11-1992 By: JP
 This survey consists of:
 Map: _____
 Narrative: _____
 Corner Rpt: _____
 DOUGLAS COUNTY
 SURVEYOR

FINAL SURVEY
 ALL INFORMATION CONTAINED HEREIN IS THE PROPERTY OF THE SURVEYOR AND IS NOT TO BE REPRODUCED OR TRANSMITTED IN ANY FORM OR BY ANY MEANS, ELECTRONIC OR MECHANICAL, INCLUDING PHOTOCOPYING, RECORDING, OR BY ANY INFORMATION STORAGE AND RETRIEVAL SYSTEM.

ORIGINAL SURVEY
 ALL INFORMATION CONTAINED HEREIN IS THE PROPERTY OF THE SURVEYOR AND IS NOT TO BE REPRODUCED OR TRANSMITTED IN ANY FORM OR BY ANY MEANS, ELECTRONIC OR MECHANICAL, INCLUDING PHOTOCOPYING, RECORDING, OR BY ANY INFORMATION STORAGE AND RETRIEVAL SYSTEM.

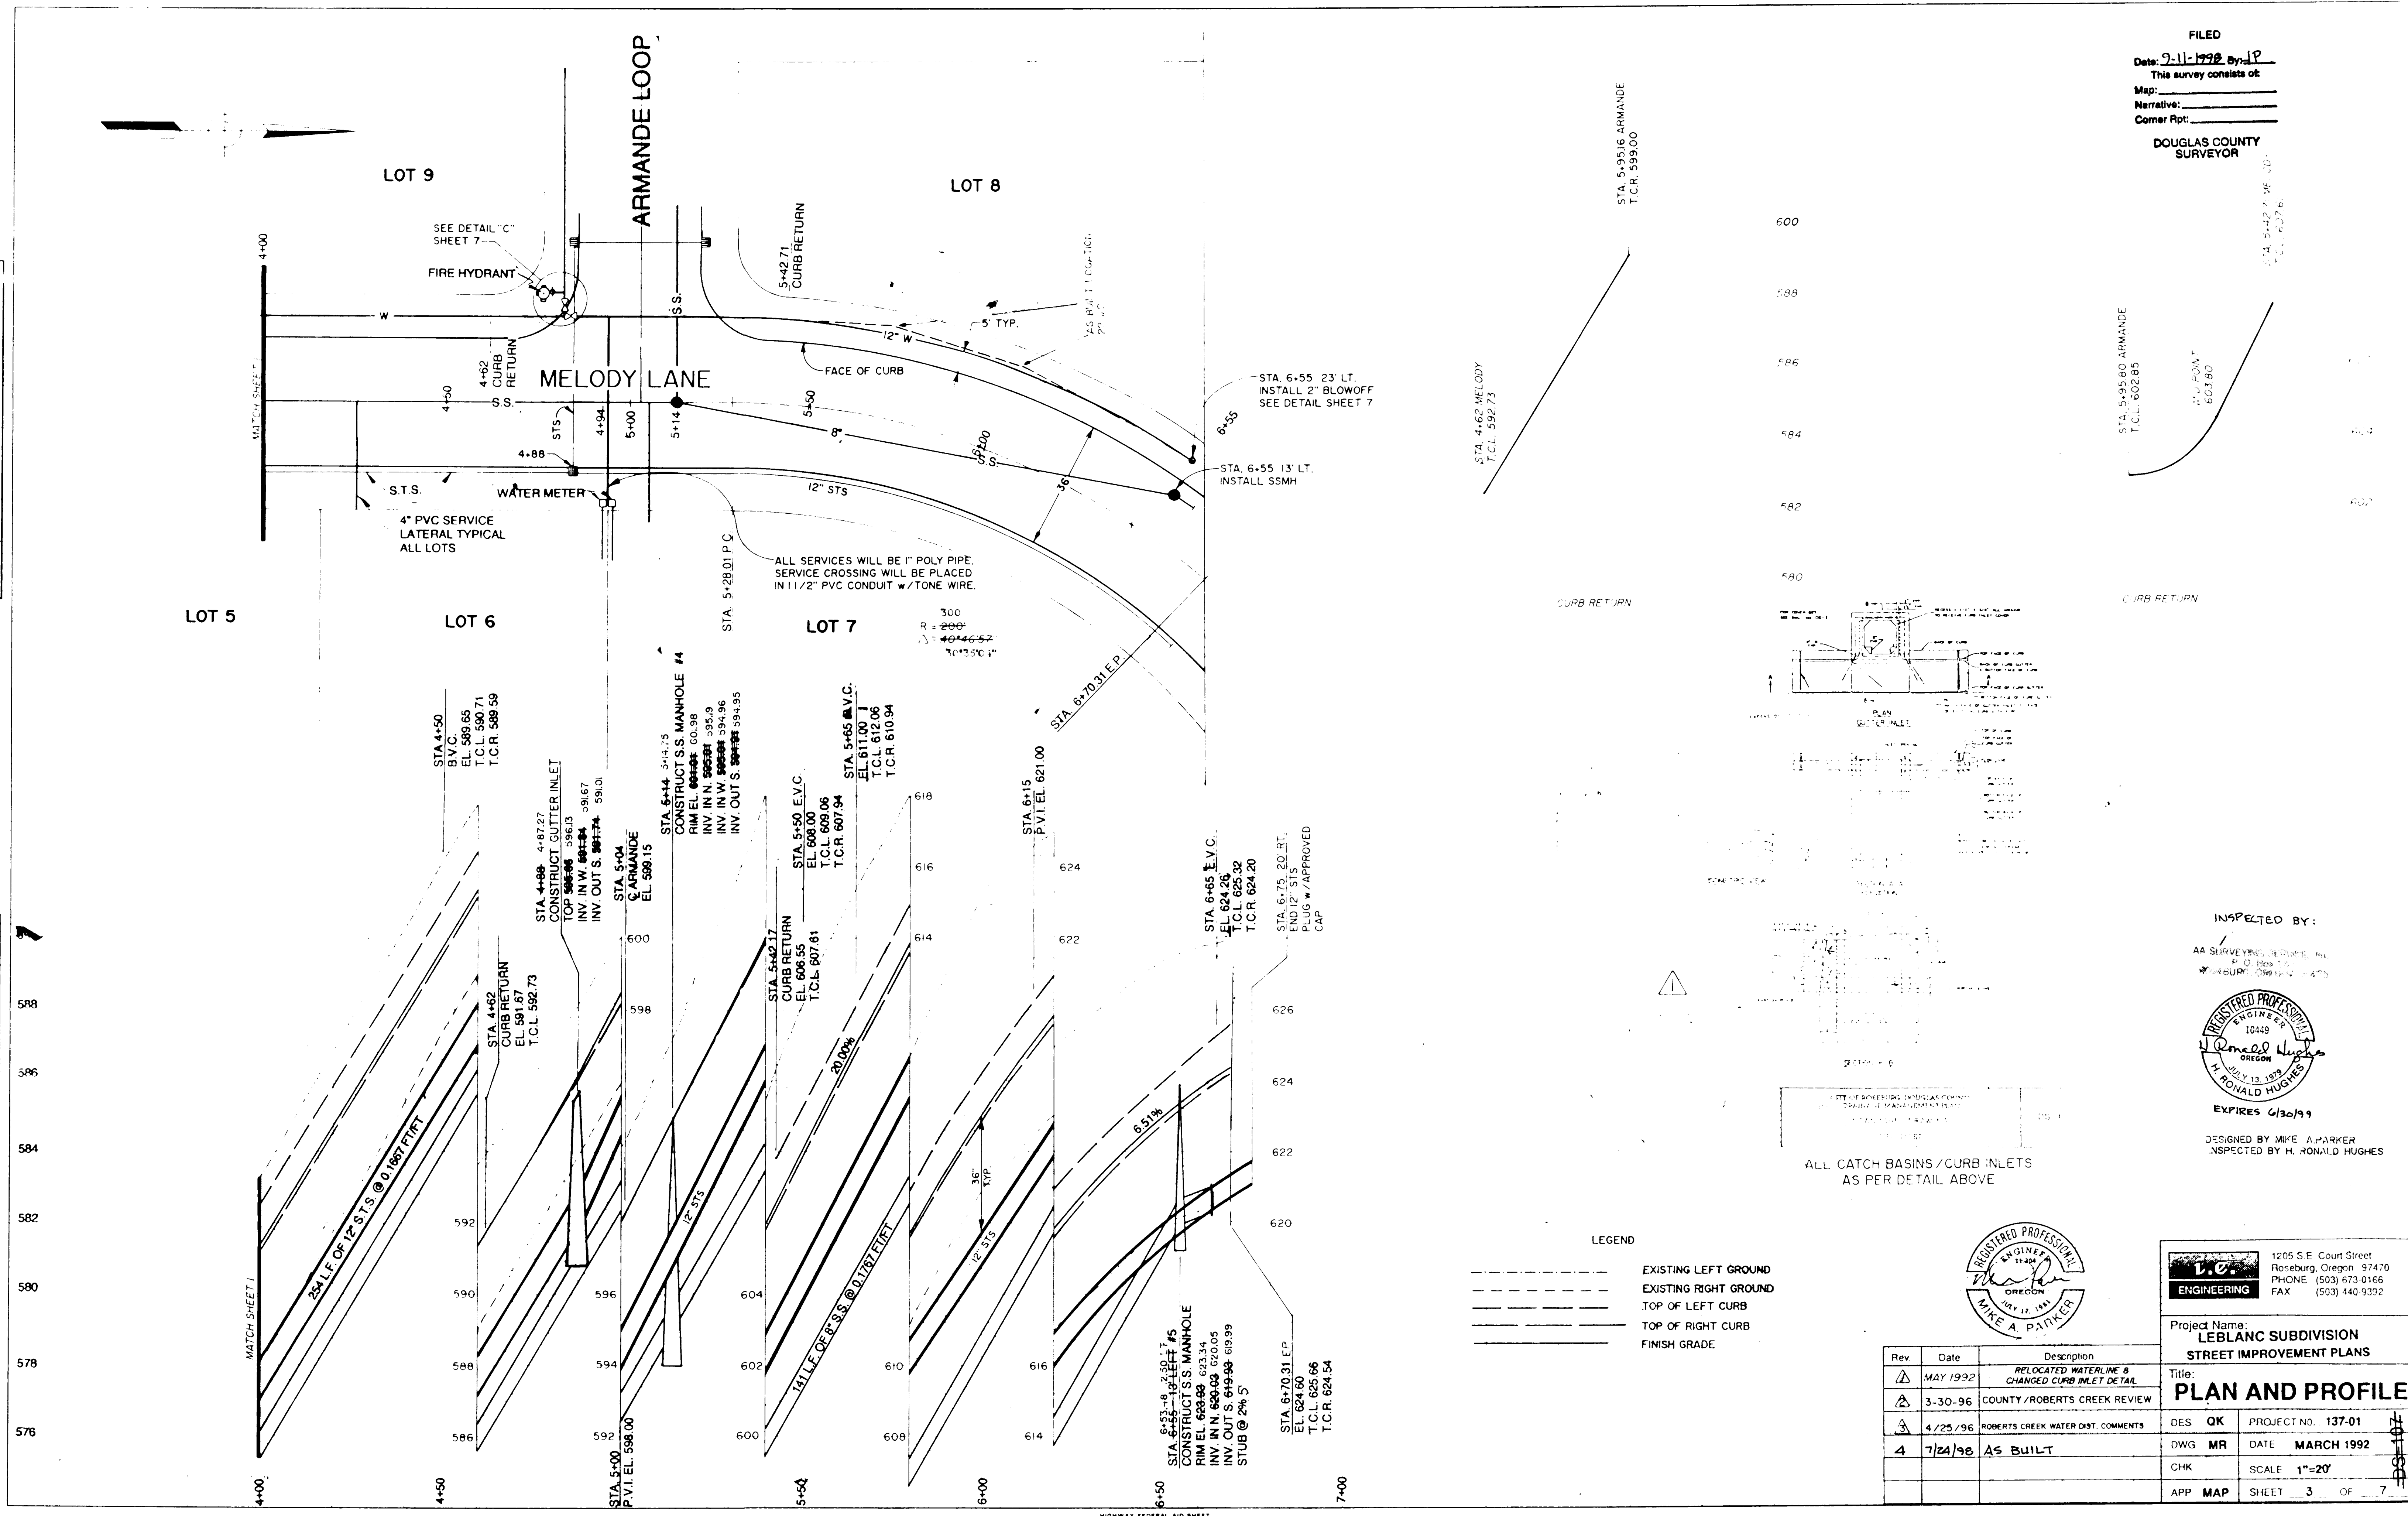

STA. 4+62 MELODY
 T.C.L. 592.73


STA. 5+95.80 ARMANDE
 T.C.L. 599.00

CURB RETURN

STA. 5+95.80 ARMANDE
 T.C.L. 602.85

INSPECTED BY:

AS SURVEYING ENGINEER
 H. RONALD HUGHES

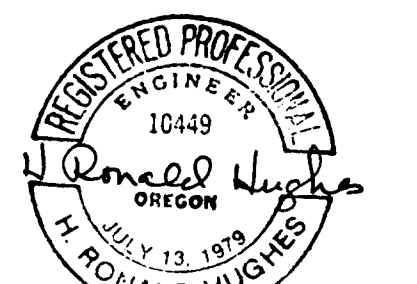

EXPIRES 6/30/99

DESIGNED BY MIKE A. PARKER
 INSPECTED BY H. RONALD HUGHES

ALL CATCH BASINS/CURB INLETS
 AS PER DETAIL ABOVE

LEGEND

- EXISTING LEFT GROUND
- EXISTING RIGHT GROUND
- TOP OF LEFT CURB
- TOP OF RIGHT CURB
- FINISH GRADE



1205 S.E. Court Street
 Roseburg, Oregon 97470
 PHONE (503) 673-0166
 FAX (503) 440-9352

Project Name:
LEBLANC SUBDIVISION
STREET IMPROVEMENT PLANS

Title:
PLAN AND PROFILE

Rev	Date	Description
1	MAY 1992	RELOCATED WATERLINE & CHANGED CURB INLET DETAIL
2	3-30-96	COUNTY/ROBERTS CREEK REVIEW
3	4/25/96	ROBERTS CREEK WATER DIST. COMMENTS
4	7/24/96	AS BUILT

DES	CHK	PROJECT NO.
DES	QK	137-01
DWG	MR	DATE
DWG	MR	MARCH 1992
APP	MAP	SHEET
APP	MAP	3 OF 7

PLATE 4-SINGLE PLAN AND CROSS SECTION FULL DOT
 PRINTED IN U.S.A.

CO. RD. # 288

00070013