


RADIUS POINT
E = 49233.90
N = 9578.96

MELODY SUBDIVISION AS-BUILTS JULY 21, 2004

NOTE: THE AS-BUILTS ARE BASED ON BEST AVAILABLE INFORMATION. LOCATIONS WERE DETERMINED BY PERIODIC OBSERVATIONS & INFO PROVIDED BY THE CONTRACTOR.

FILED
Date: 2-9-2005 By: [Signature]
Title: Survey consists of:
Name:
Corner File:
DOUGLAS COUNTY SURVEYOR

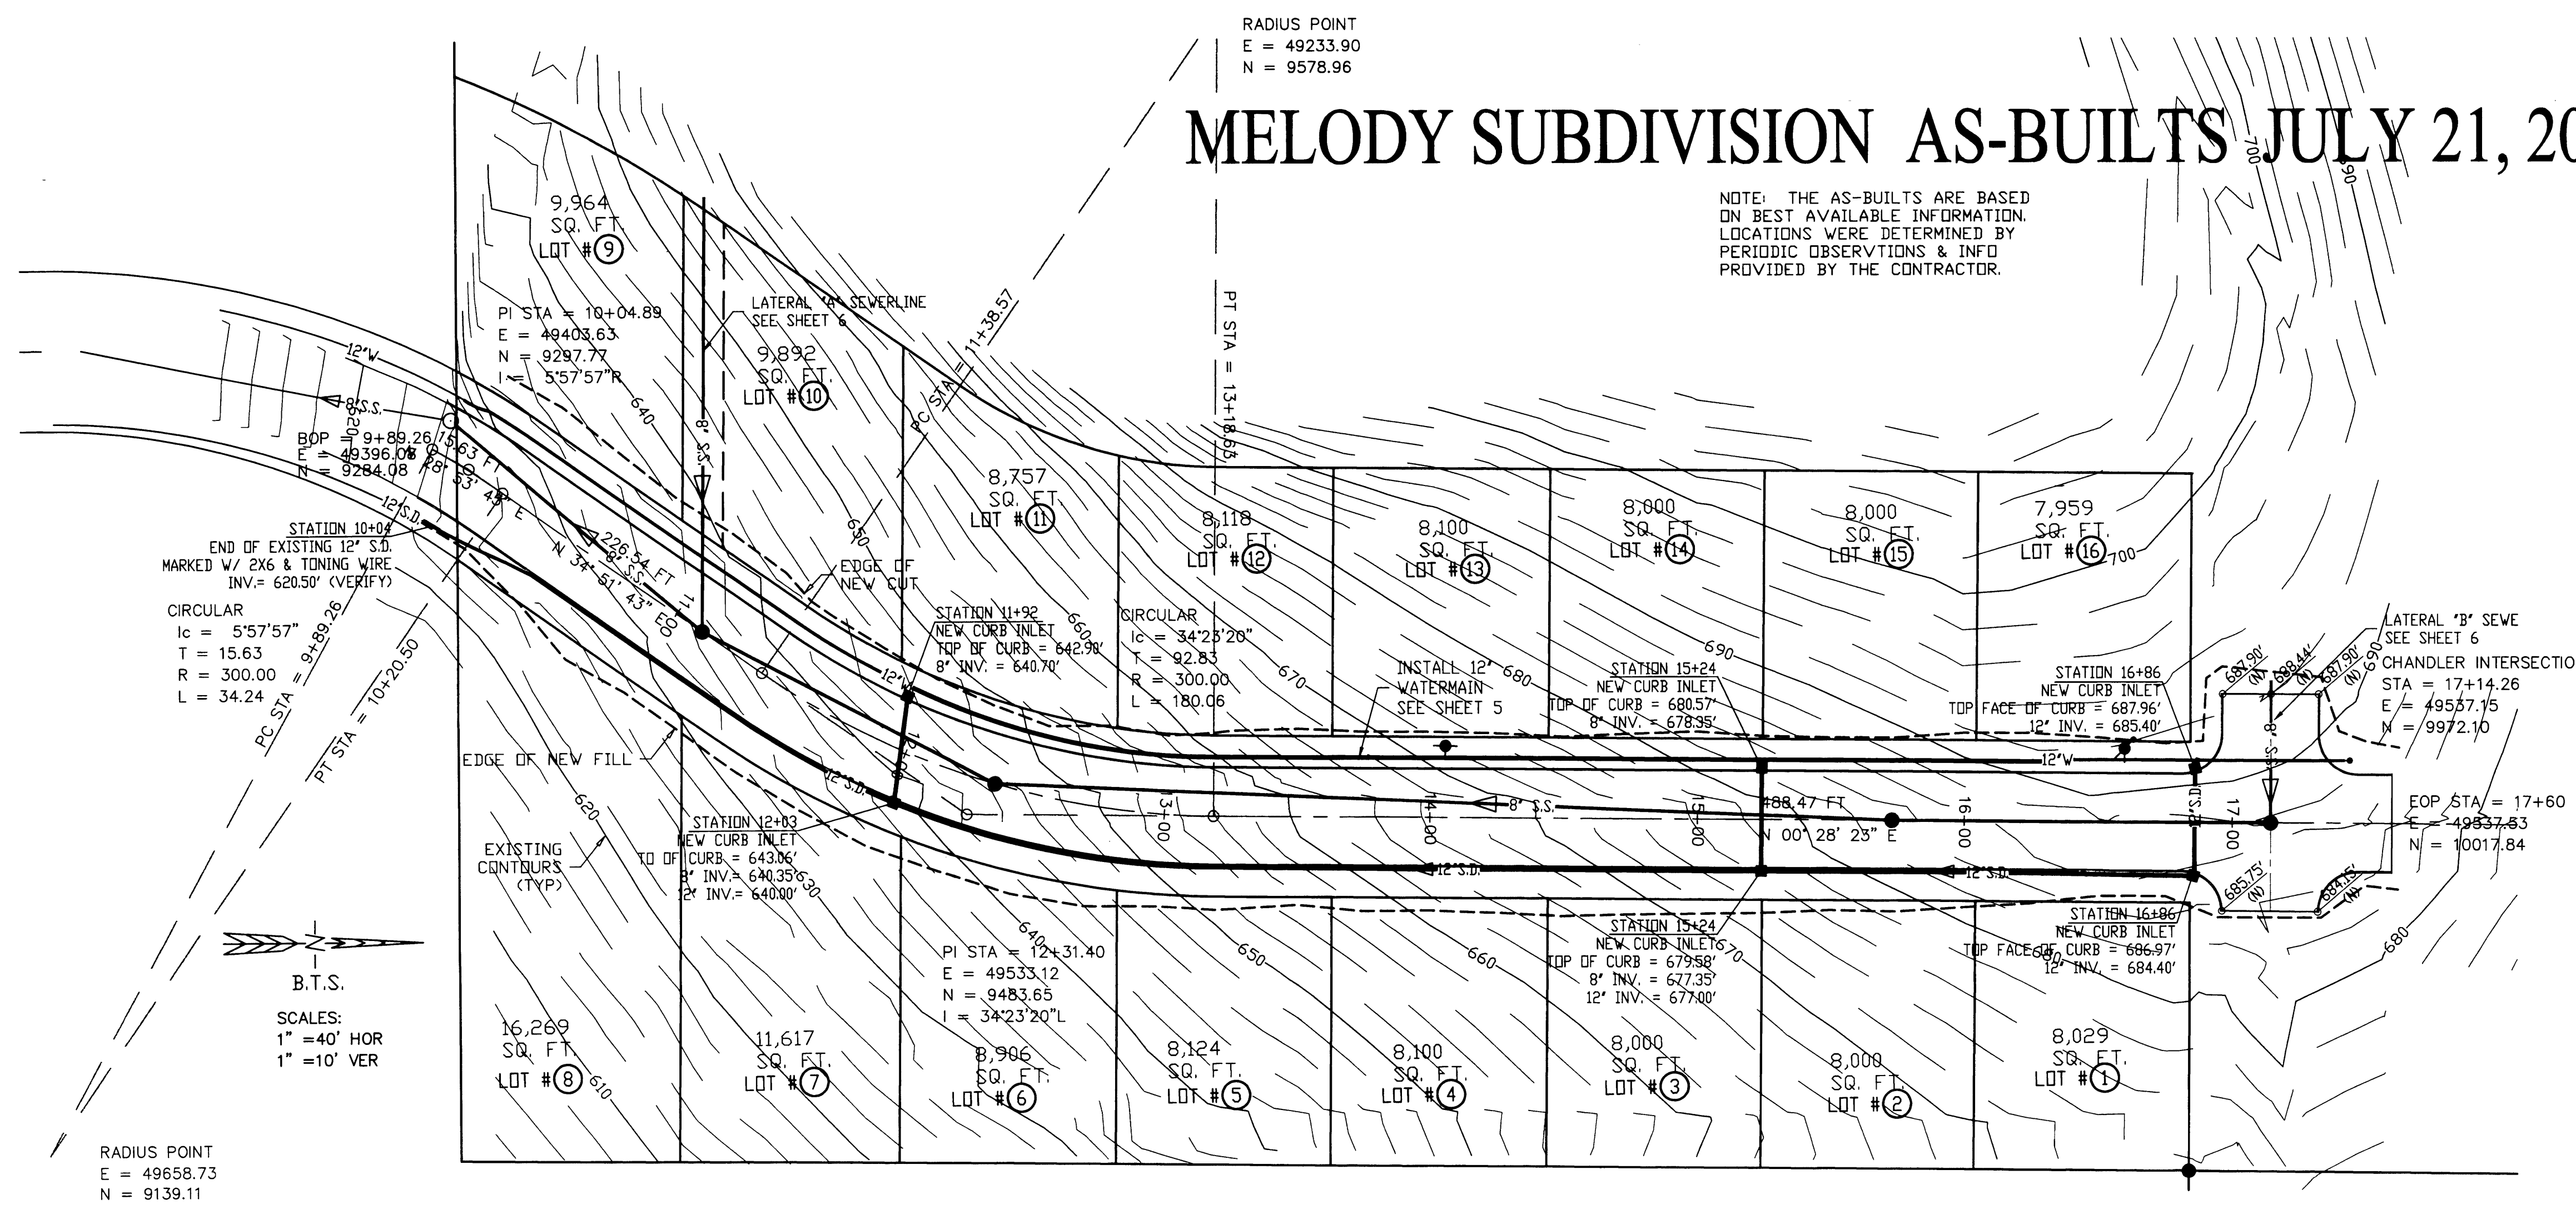


STATION 10+00
END OF EXISTING 12" S.D. MARKED W/ 2X6 & TONING WIRE
INV. = 620.50' (VERIFY)

CIRCULAR
Ic = 5'57.57"
T = 15.63
R = 300.00
L = 34.24
PC STA = 94+89.26
PT STA = 104+20.50

B.T.S.
SCALES:
1" = 40' HOR
1" = 10' VER


RADIUS POINT
E = 49658.73
N = 9139.11

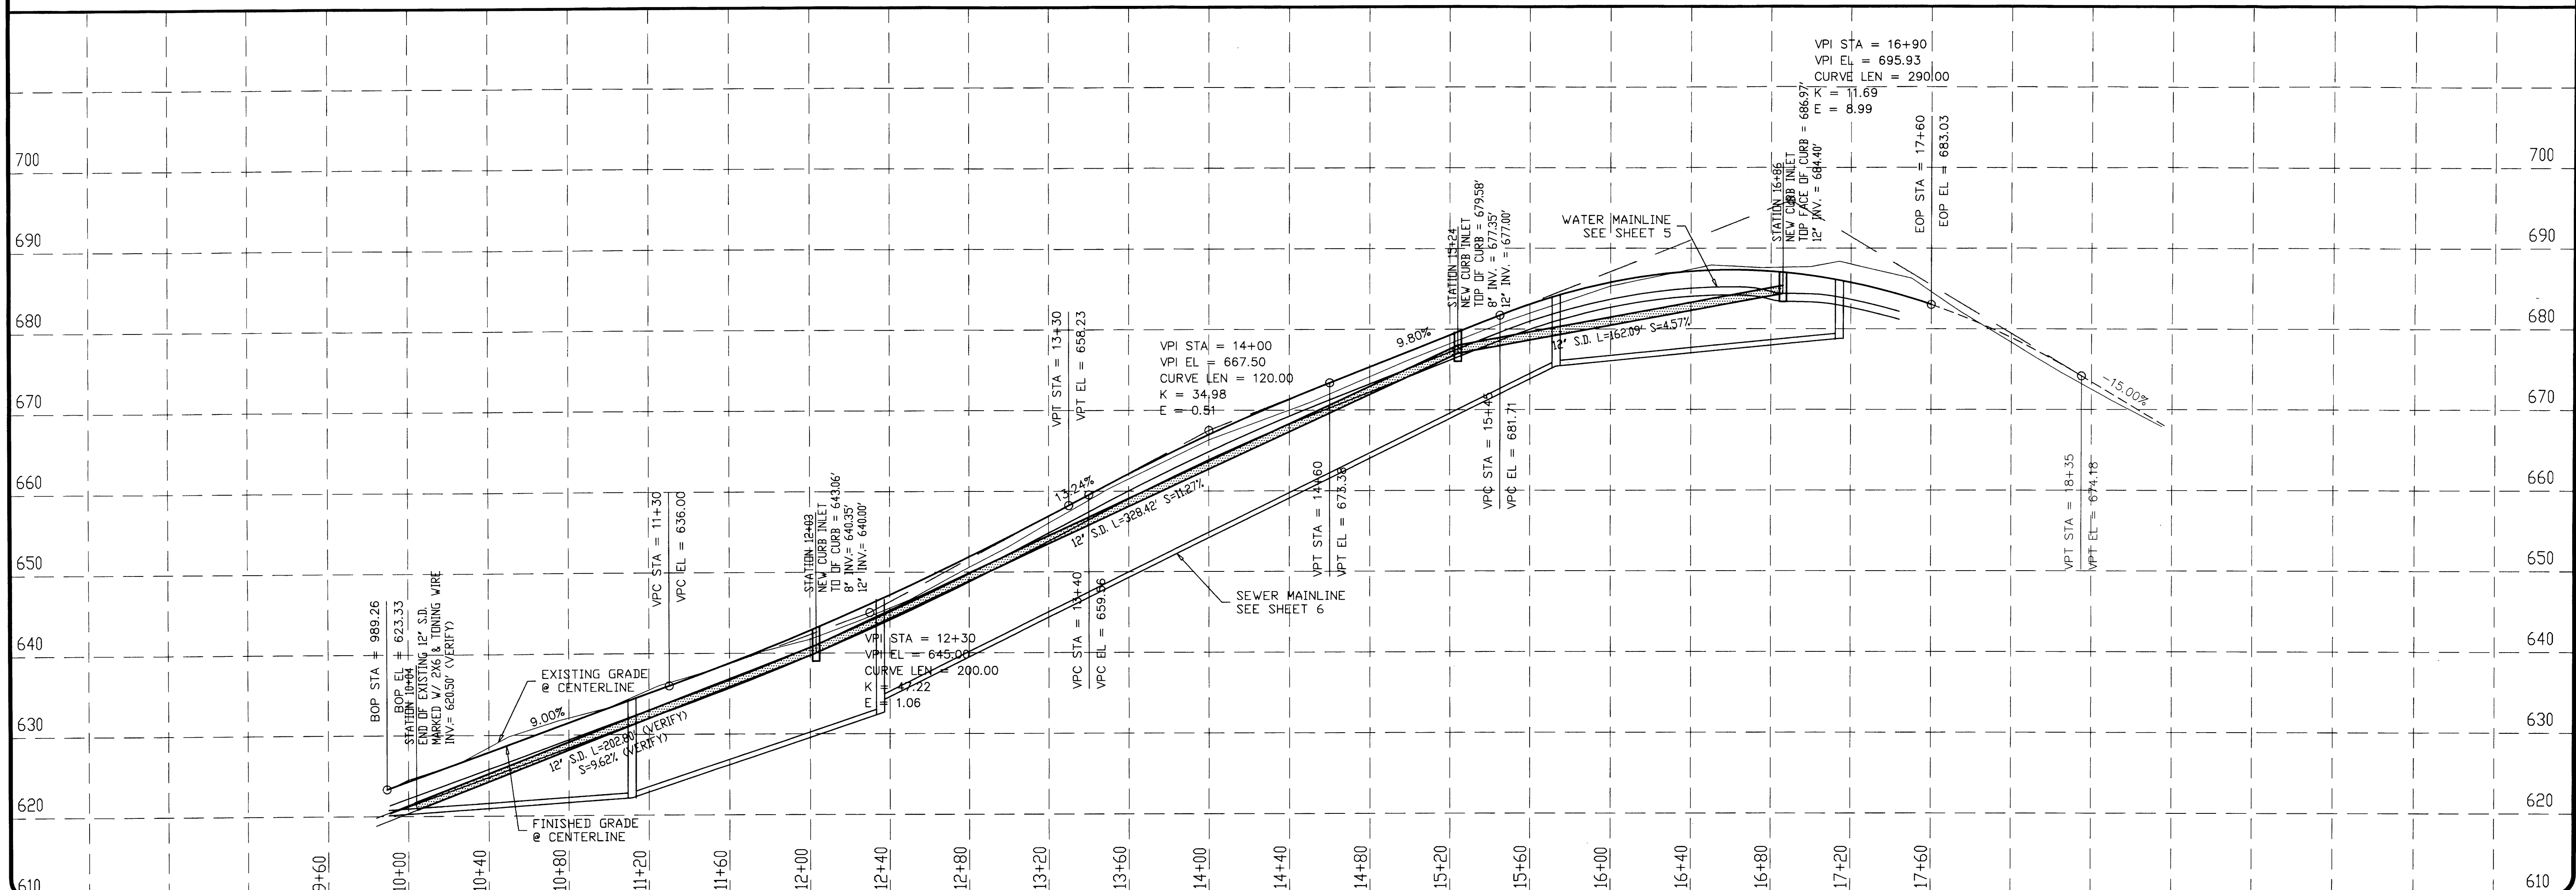

MELODY SUBDIVISION - PHASE I MELODY LN. PLAN & PROFILE

OWNER: ERIK HELLENTHAL
ENGINEERING & SURVEYING, INC.
BTS
PHONE (503) 624-6666 FAX (503) 674-0105

DATE: DECEMBER 2001
REV. #1: 2/07/2002
REV. #2: 4/01/2002
REV. #3: 6/05/02
REV. #4: -
REV. #5: -

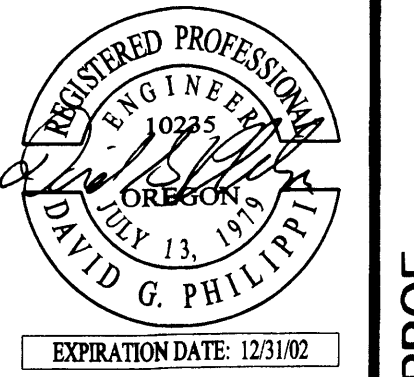

PROJ. #98-088
SHEET NO. 2 of 8