



LEBLANC SUBDIVISION

FILED
 Date: 9/1/99 By: J.P.
 This survey consists of:
 Map: _____
 Narrative: _____
 Corner Rpt: _____
 DOUGLAS COUNTY
 SURVEYOR

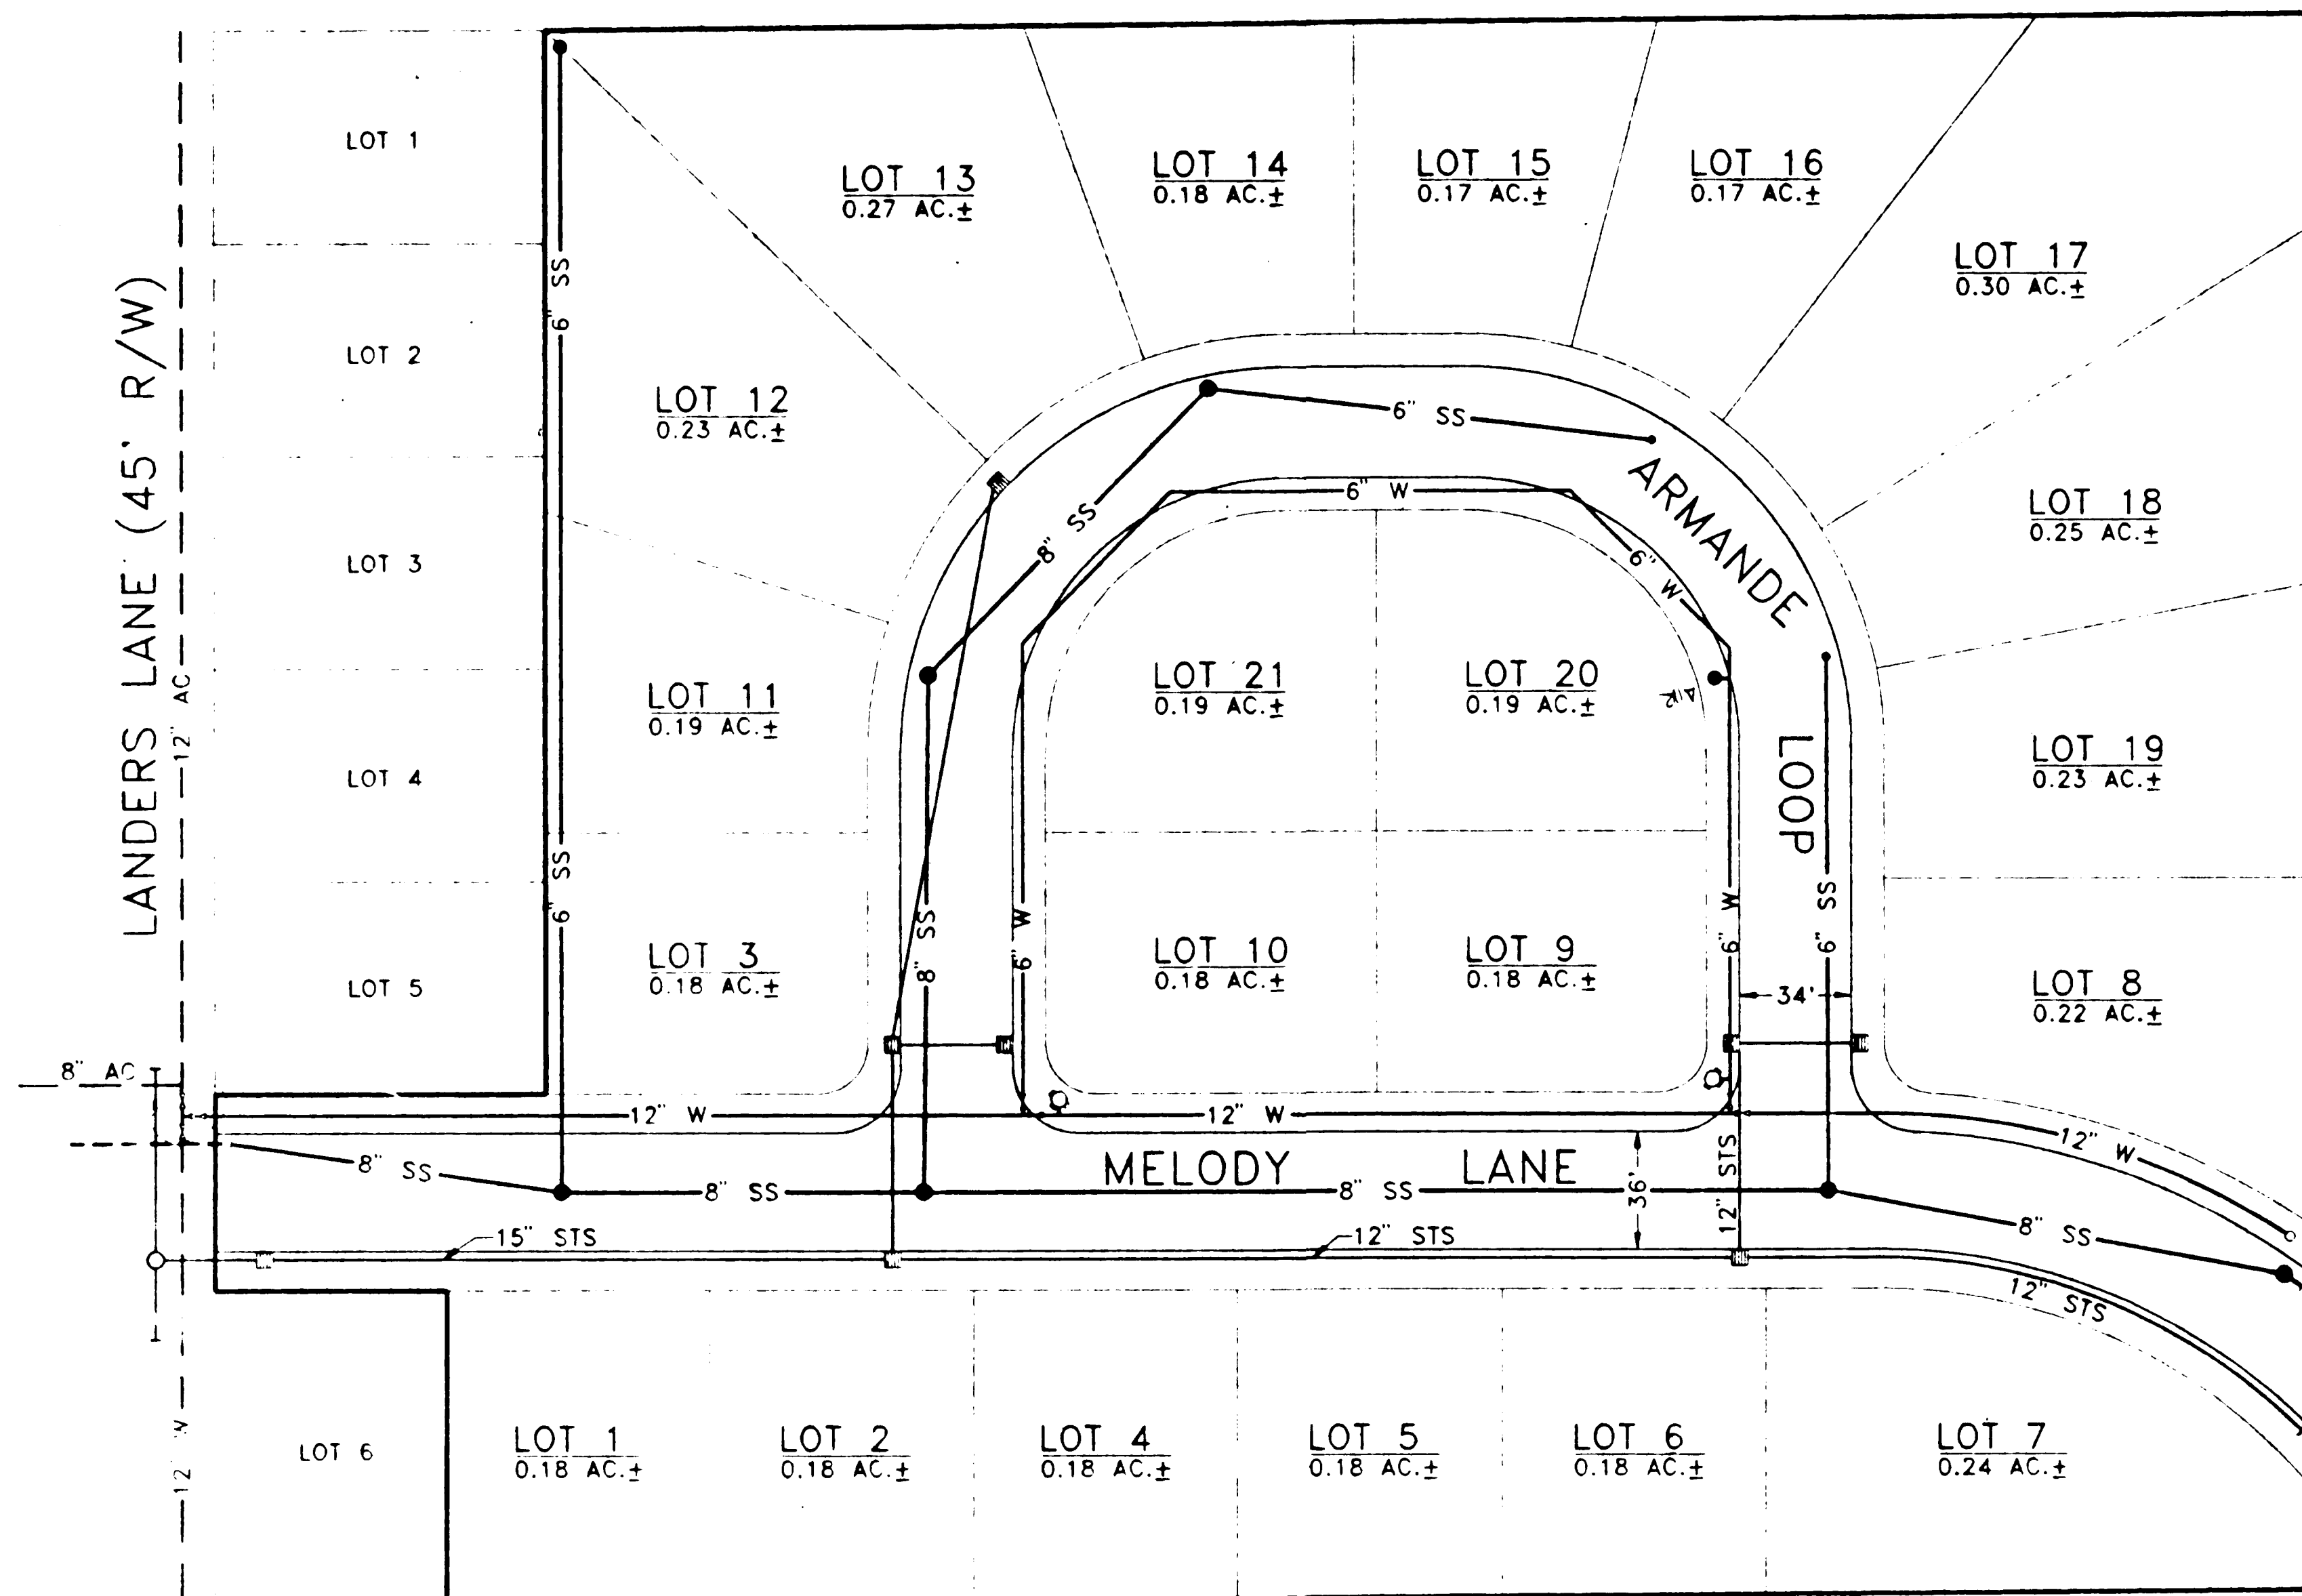

OVERALL PLAN
 SCALE: 1" = 40'

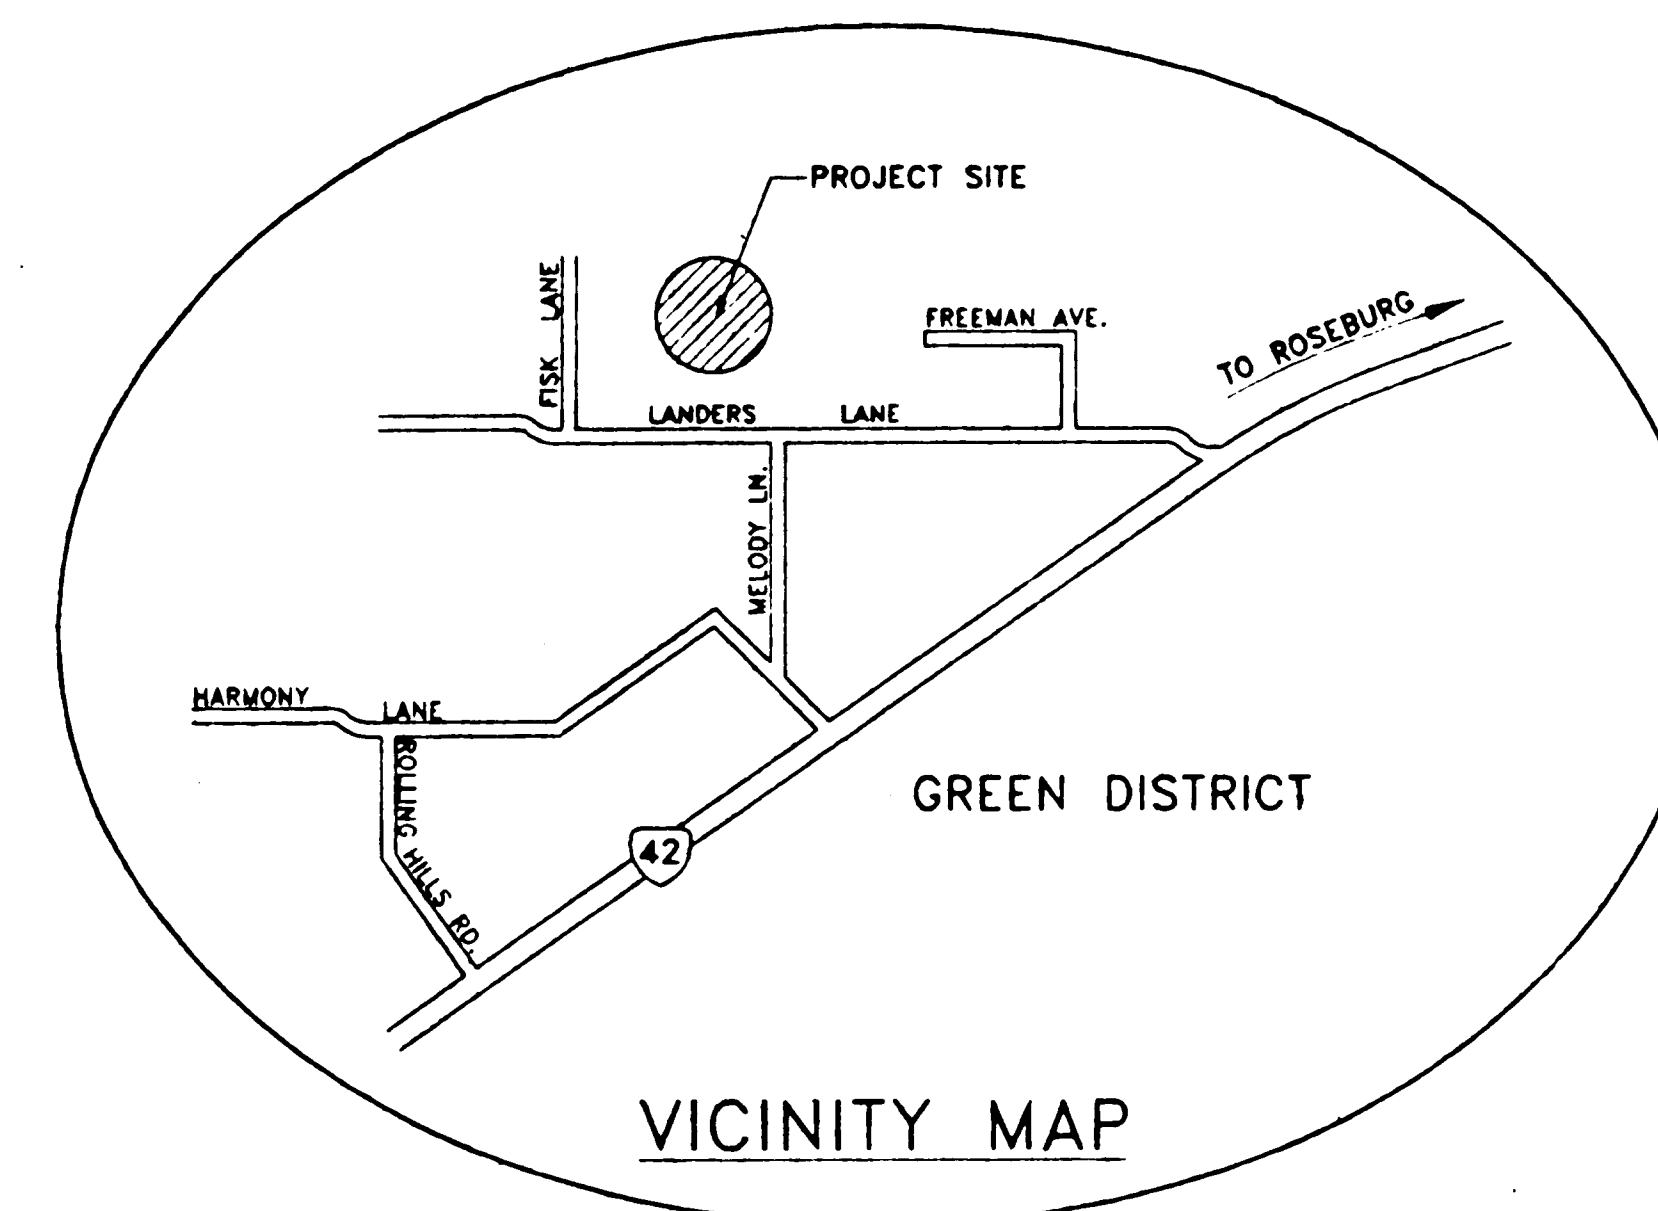

VICINITY MAP


LEGEND

- SS — PROPOSED SANITARY SEWER MAINLINE
- W — PROPOSED WATER MAINLINE
- STS — PROPOSED STORM SEWER MAINLINE
- — PROPOSED MANHOLE
- — EXISTING MANHOLE
- — PROPOSED SANITARY SEWER CLEANOUT
- ⊕ — PROPOSED FIRE HYDRANT
- ⊕ — PROPOSED WATER VALVE
- ⊕ — PROPOSED GUTTER INLET
- ⊕ — PROPOSED WATER SERVICE
- — PROPOSED 2" BLOWOFF


SHEET INDEX

- SHT. 1 COVER & OVERALL PLAN
- SHT. 2 MELODY LANE PLAN & PROFILE
- SHT. 3 MELODY LANE PLAN & PROFILE AND STD. DETAILS
- SHT. 4 ARMANDE LOOP PLAN & PROFILE AND STD. DETAILS
- SHT. 5 ARMANDE LOOP PLAN & PROFILE AND GENERAL NOTES
- SHT. 6 SANITARY SEWER PLAN & PROFILE
- SHT. 7 WATERLINE DETAILS

INSPECTED BY:
 H. RONALD HUGHES
 P. O. Box 11
 ROSEBURG, OREGON 97470

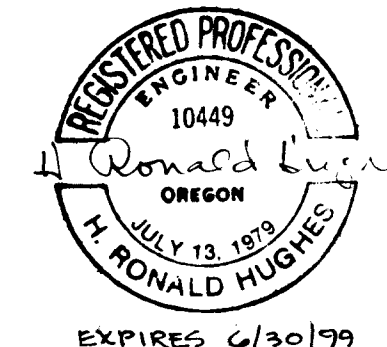

DESIGNED BY MIKE A. PARKER
 INSPECTED BY H. RONALD HUGHES

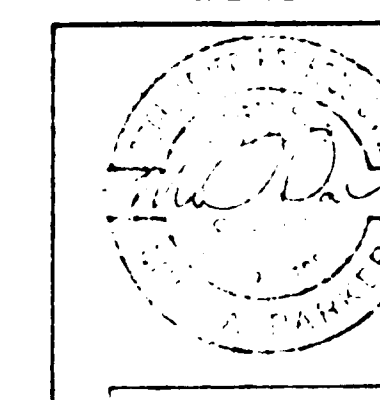

Rev.	Date	Dwg.	Description
1	3-30-98	DAF	COUNTY/ROBERTS CREEK REVIEWS
2	4/25/98	DAF	ROBERTS CREEK WATER DIST. COMMENTS
3	5/20/98	DAF	COUNTY FINAL REVIEW
4	7/24/98	HRM	As BUILT

i.e.
 546 SE Jackson Street
 Roseburg, Oregon 97470
 PHONE (541) 733-0151
 FAX (541) 442-3707

Project Name LEBLANC SUBDIVISION	
Title STREET IMPROVEMENT PLANS	
DES. GR.	PROJECT NO. 170-01
DWG. DATE	DATE: DECEMBER 1998
CHK. SN.	SCALE: 1" = 40'
APP. DATE	SHEET 1 OF 7

RD288COV